


BENCH MARK ELEV. 792.92
PK in N.E. Curb return Jones & Arlington
F.B. 704/37

-GENERAL NOTES-

1. All manholes shall be constructed per City of Riverside Standard Drawing No. 500, unless otherwise noted.
2. Ties and laterals to be located in the field.
3. Sewer laterals shall be 4" V.C.P. constructed per City of Riverside Standard Drawing No. 562.
4. Chimneys shall be constructed per City of Riverside Standard Drawing No. 561.

- QUANTITY ESTIMATE -

8" Vitrified Clay Pipe	1800 L.F.
4" Vitrified Clay Pipe	465 L.F.
4"x8" Tees	33 Ea.
Manholes Standard No. 500	6 Ea.
Pavement Replacement	2100 L.F.
Chimney Standard No. 561	10 L.F.

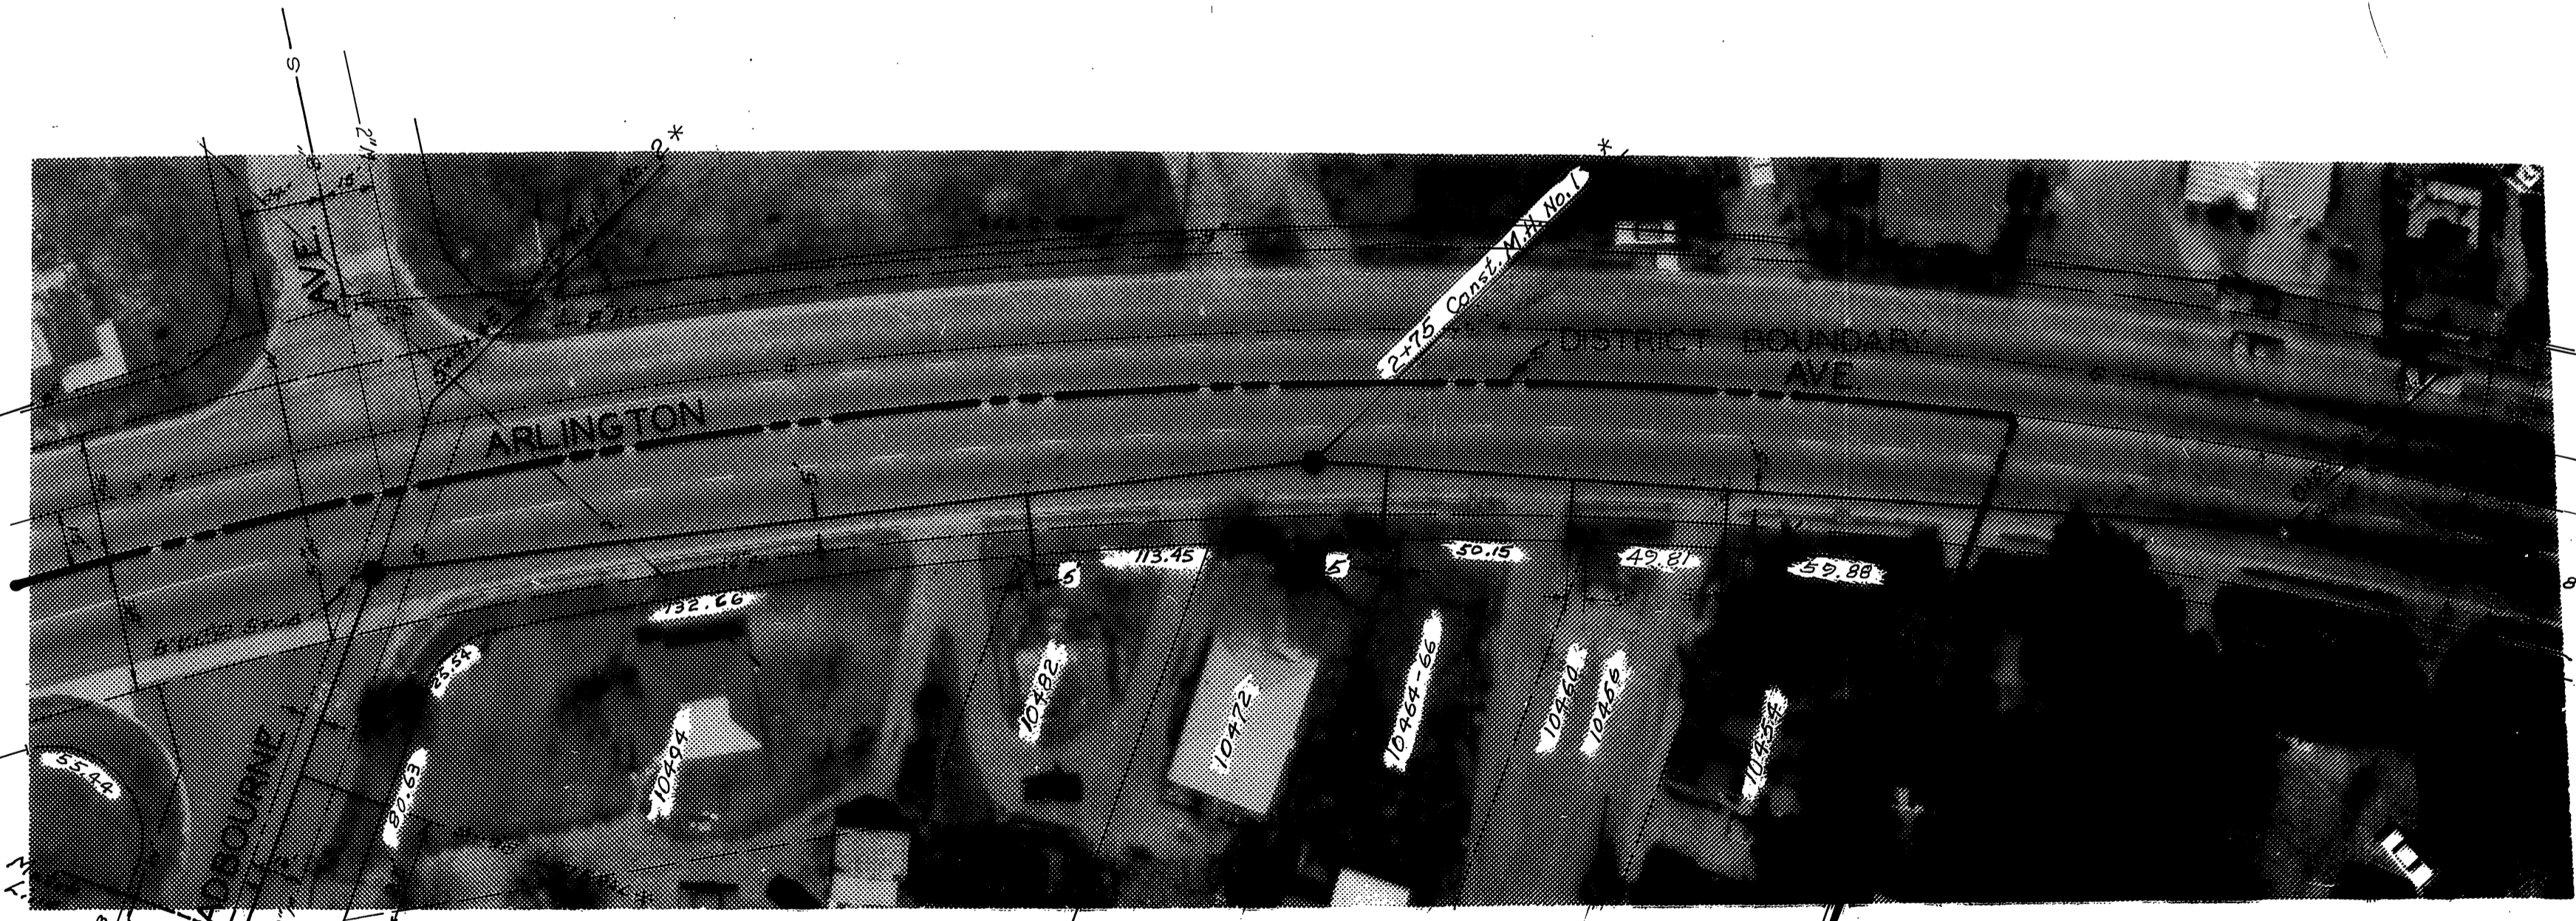

*6-35 Tee





CHADBOURNE HEIGHTS

*AS BUILT 8-25-68 K.F. 32

F.B. - 701/54


CITY OF RIVERSIDE, CALIFORNIA DEPARTMENT OF PUBLIC WORKS		CHADBOURNE AVE. ASSESSMENT DISTRICT		ACCOUNT NO. 8073
APPROVED BY: <i>[Signature]</i> SENIOR ENGINEER		APPROVED BY: <i>[Signature]</i> DIRECTOR OF PUBLIC WORKS		INDEXED R/S S-692 SHEET 1 OF 2
TRAFFIC DIVISION		DATE 12-19-67		
DESIGNED BY: <i>[Signature]</i>		DRAWN BY: <i>[Signature]</i>		HORIZ. SCALE: 1" = 40' VERT. SCALE: 1" = 4'
CHECKED BY: <i>[Signature]</i>		DATE 12-19-67		
REVISIONS		APPR. DATE		S.S. PROJECT NO.

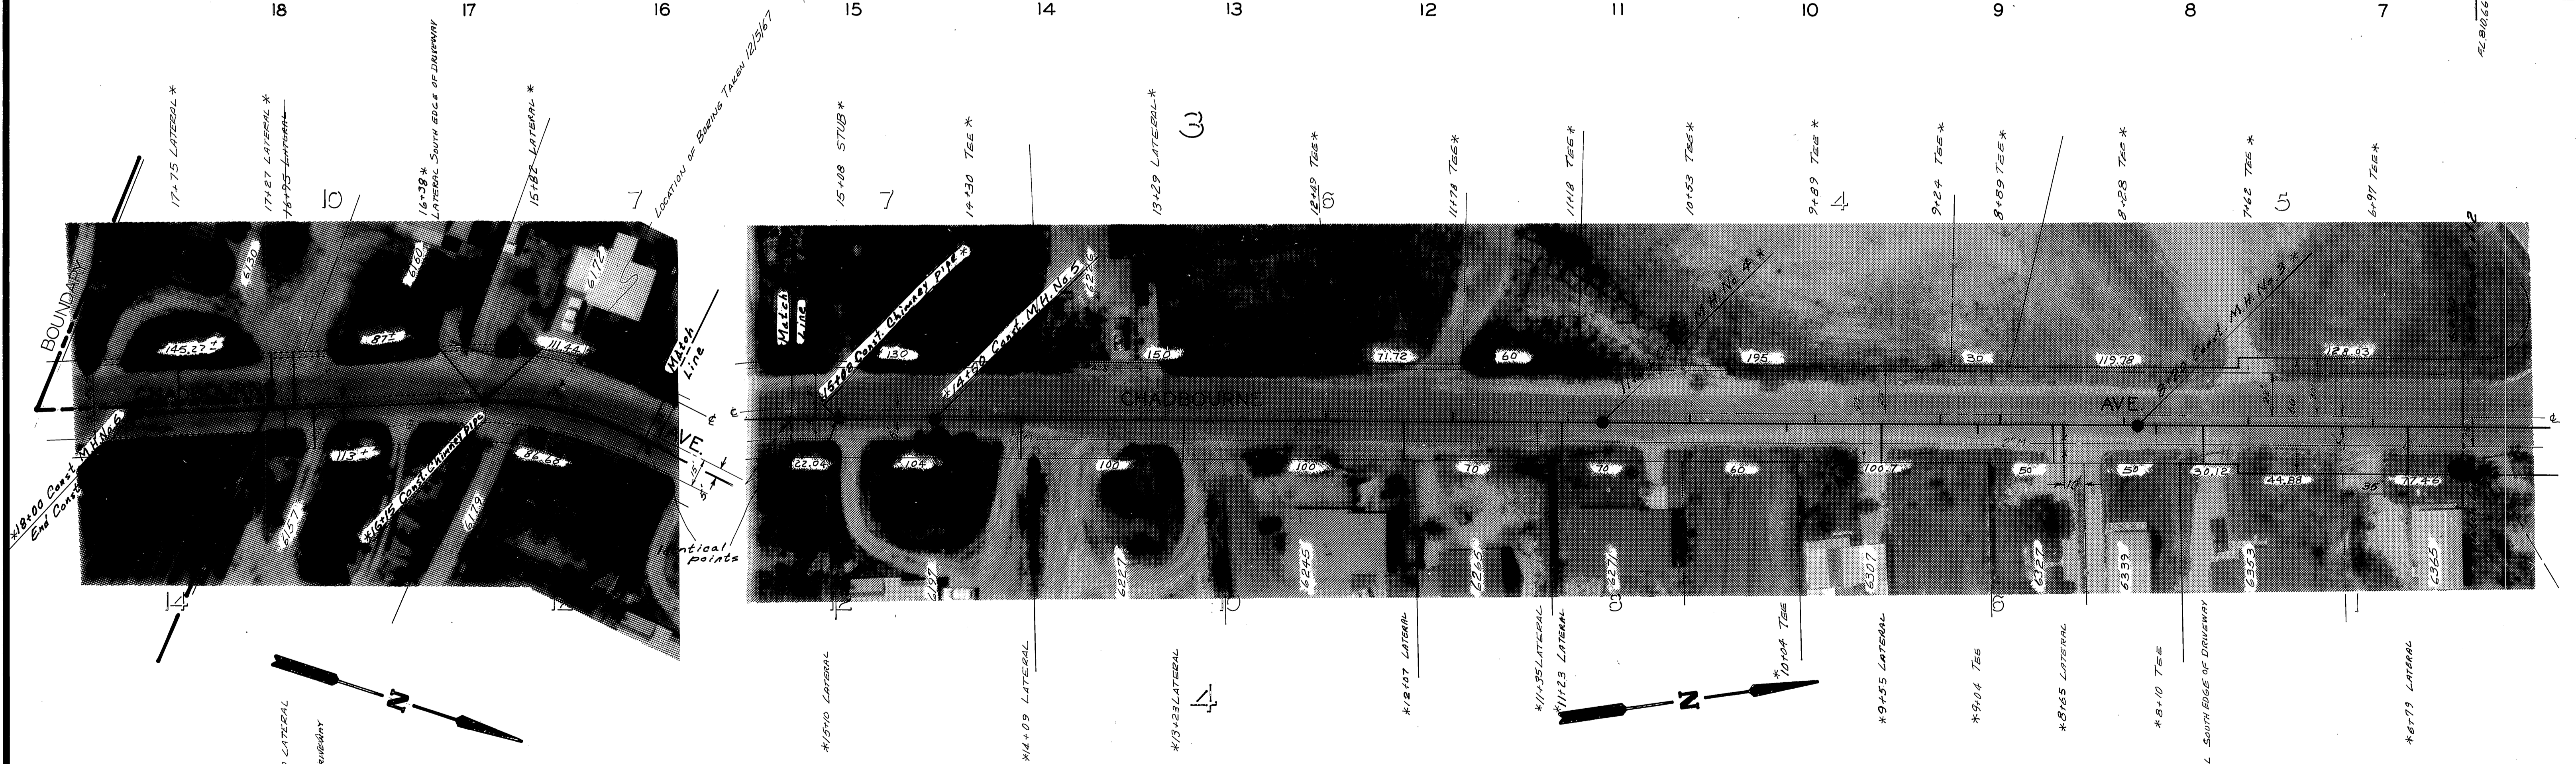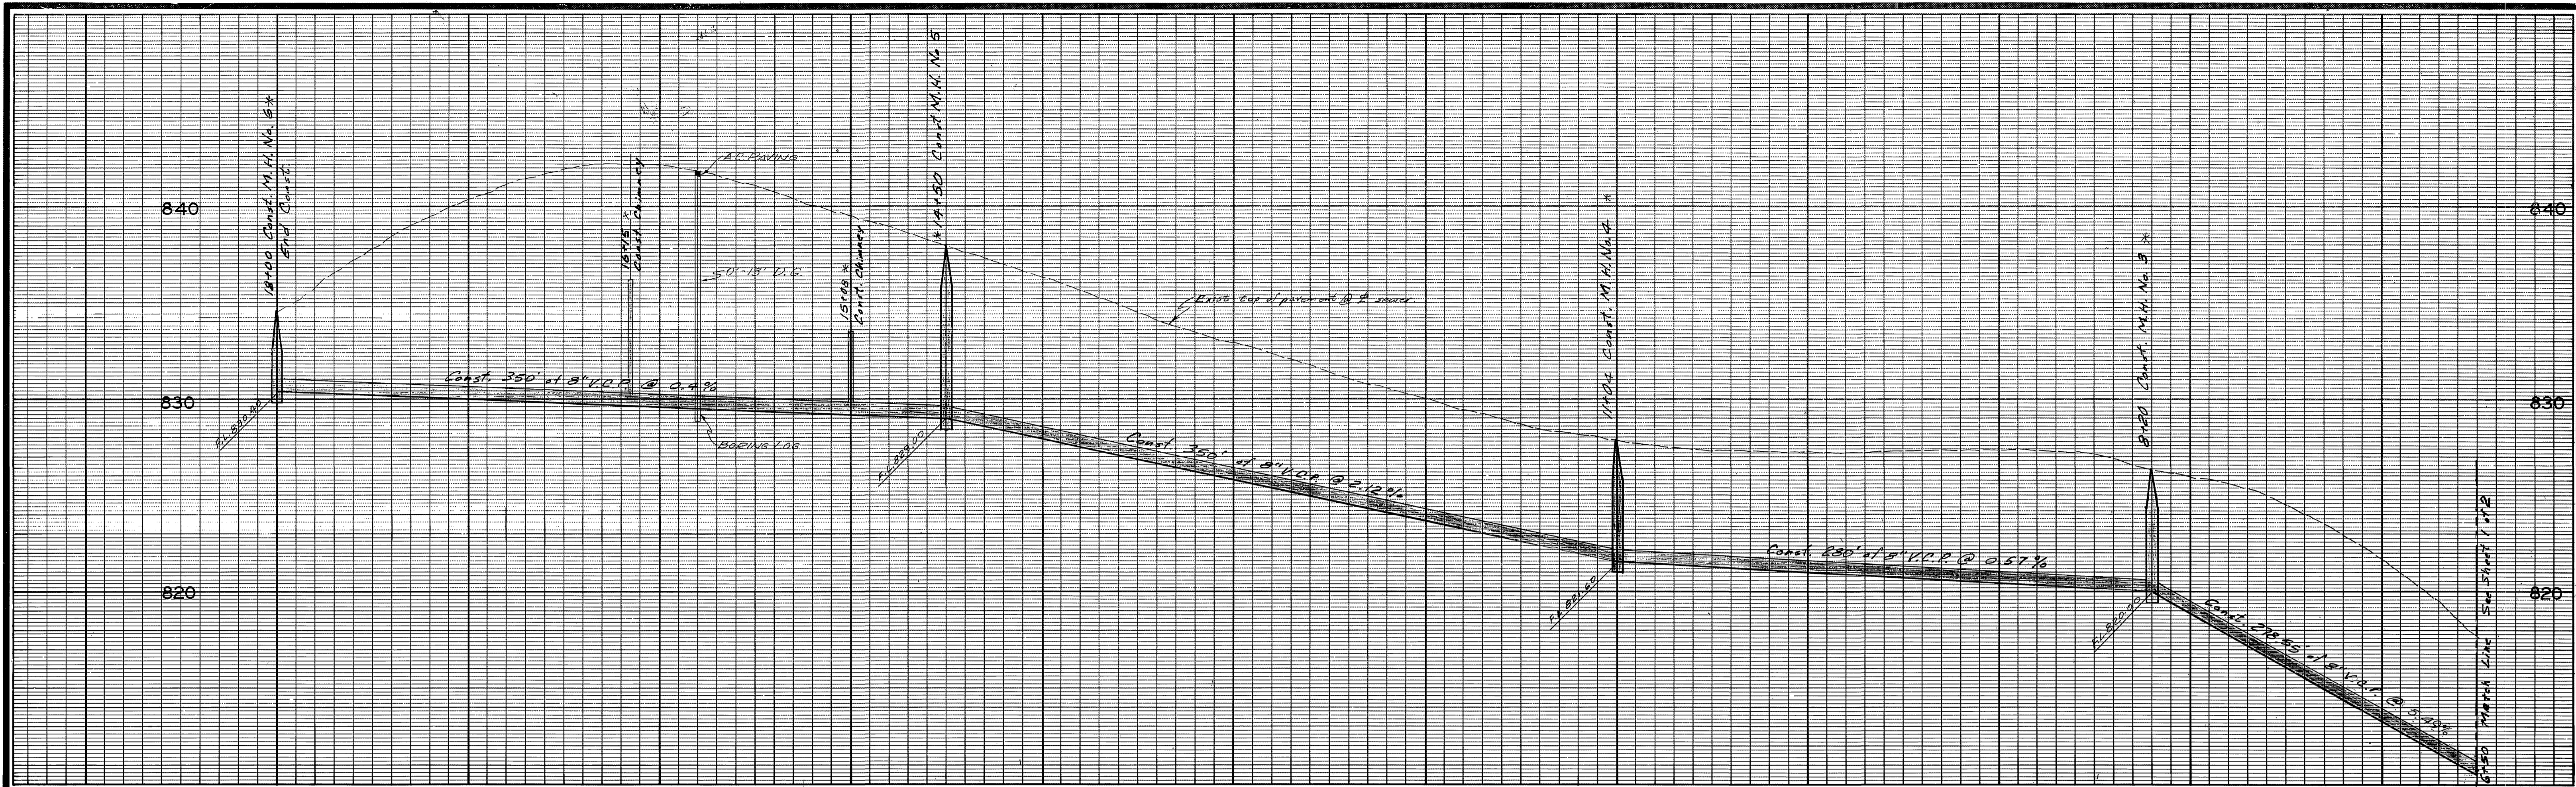

CHADBOURNE

HEIGHTS

CITY OF RIVERSIDE, CALIFORNIA DEPARTMENT OF PUBLIC WORKS				CHADBOURNE AVE. ASSESSMENT DISTRICT		ACCOUNT NO. 6073
APPROVED BY		BY	DATE	APPROVED BY		S-692
SENIOR ENGINEER		10/26	10/26	DIRECTOR OF PUBLIC WORKS		
TRAFFIC DIVISION						
DESIGNED BY		DRAWN BY		CHECKED BY		SHEET 2 OF 2
DATE 12-19-67		HORIZ. SCALE: 1" = 40'		VERT. SCALE: 1" = 4'		S.S. PROJECT NO.

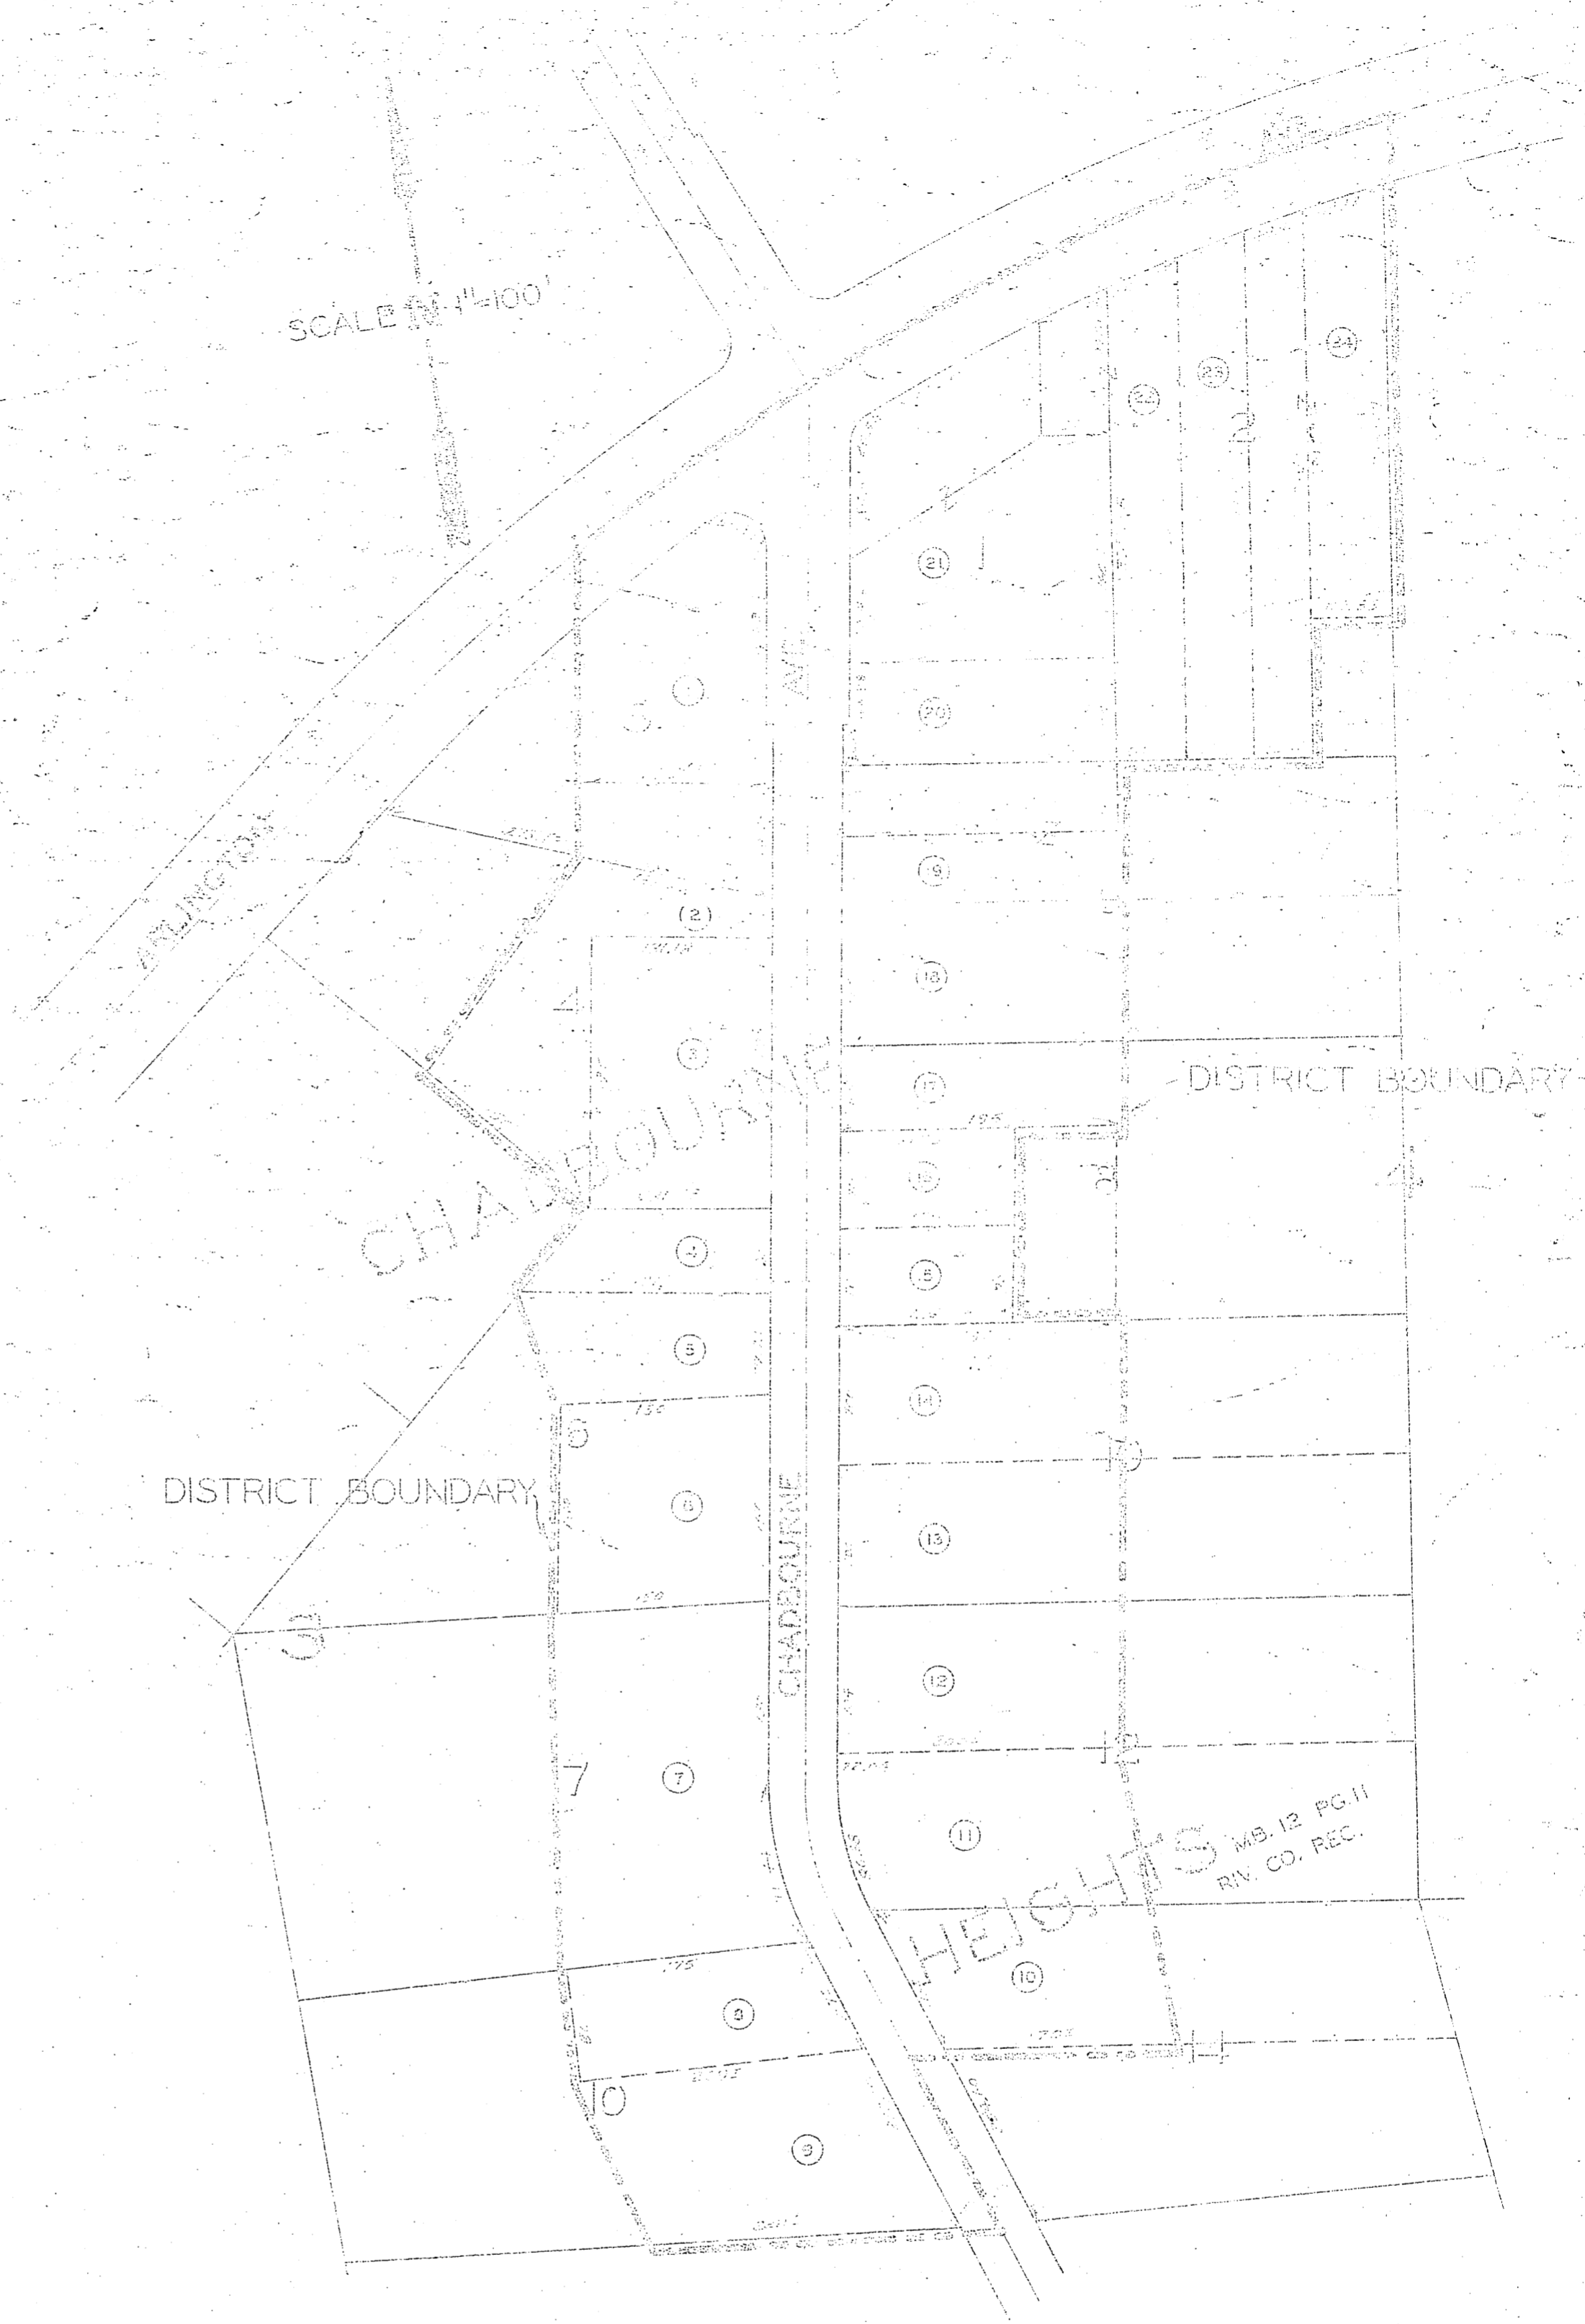

SCALE 1/4"=100'

DISTRICT BOUNDARY

DISTRICT BOUNDARY

HEIGHS MB. 12 PG. 11
RIV. CO. REC.

LEGEND


- INDICATES PORTIONS OF DIFFERENT LOTS TO BE ASSESSED TOGETHER.
- Ⓢ CIRCLED NUMBER INDICATES PROPOSED ASSESSMENT PARCEL NUMBERS.

DIAGRAM OF THE PROPERTY AFFECTED OR BENEFITED BY THE WORK IN THE CHADBOURNE AVENUE SANITARY SEWER DISTRICT.

REVISIONS		CITY OF RIVERSIDE, CALIFORNIA DEPARTMENT OF PUBLIC WORKS
MARK	DATE	
		CHADBOURNE AVENUE SANITARY SEWER DISTRICT

S-692 B

2 2

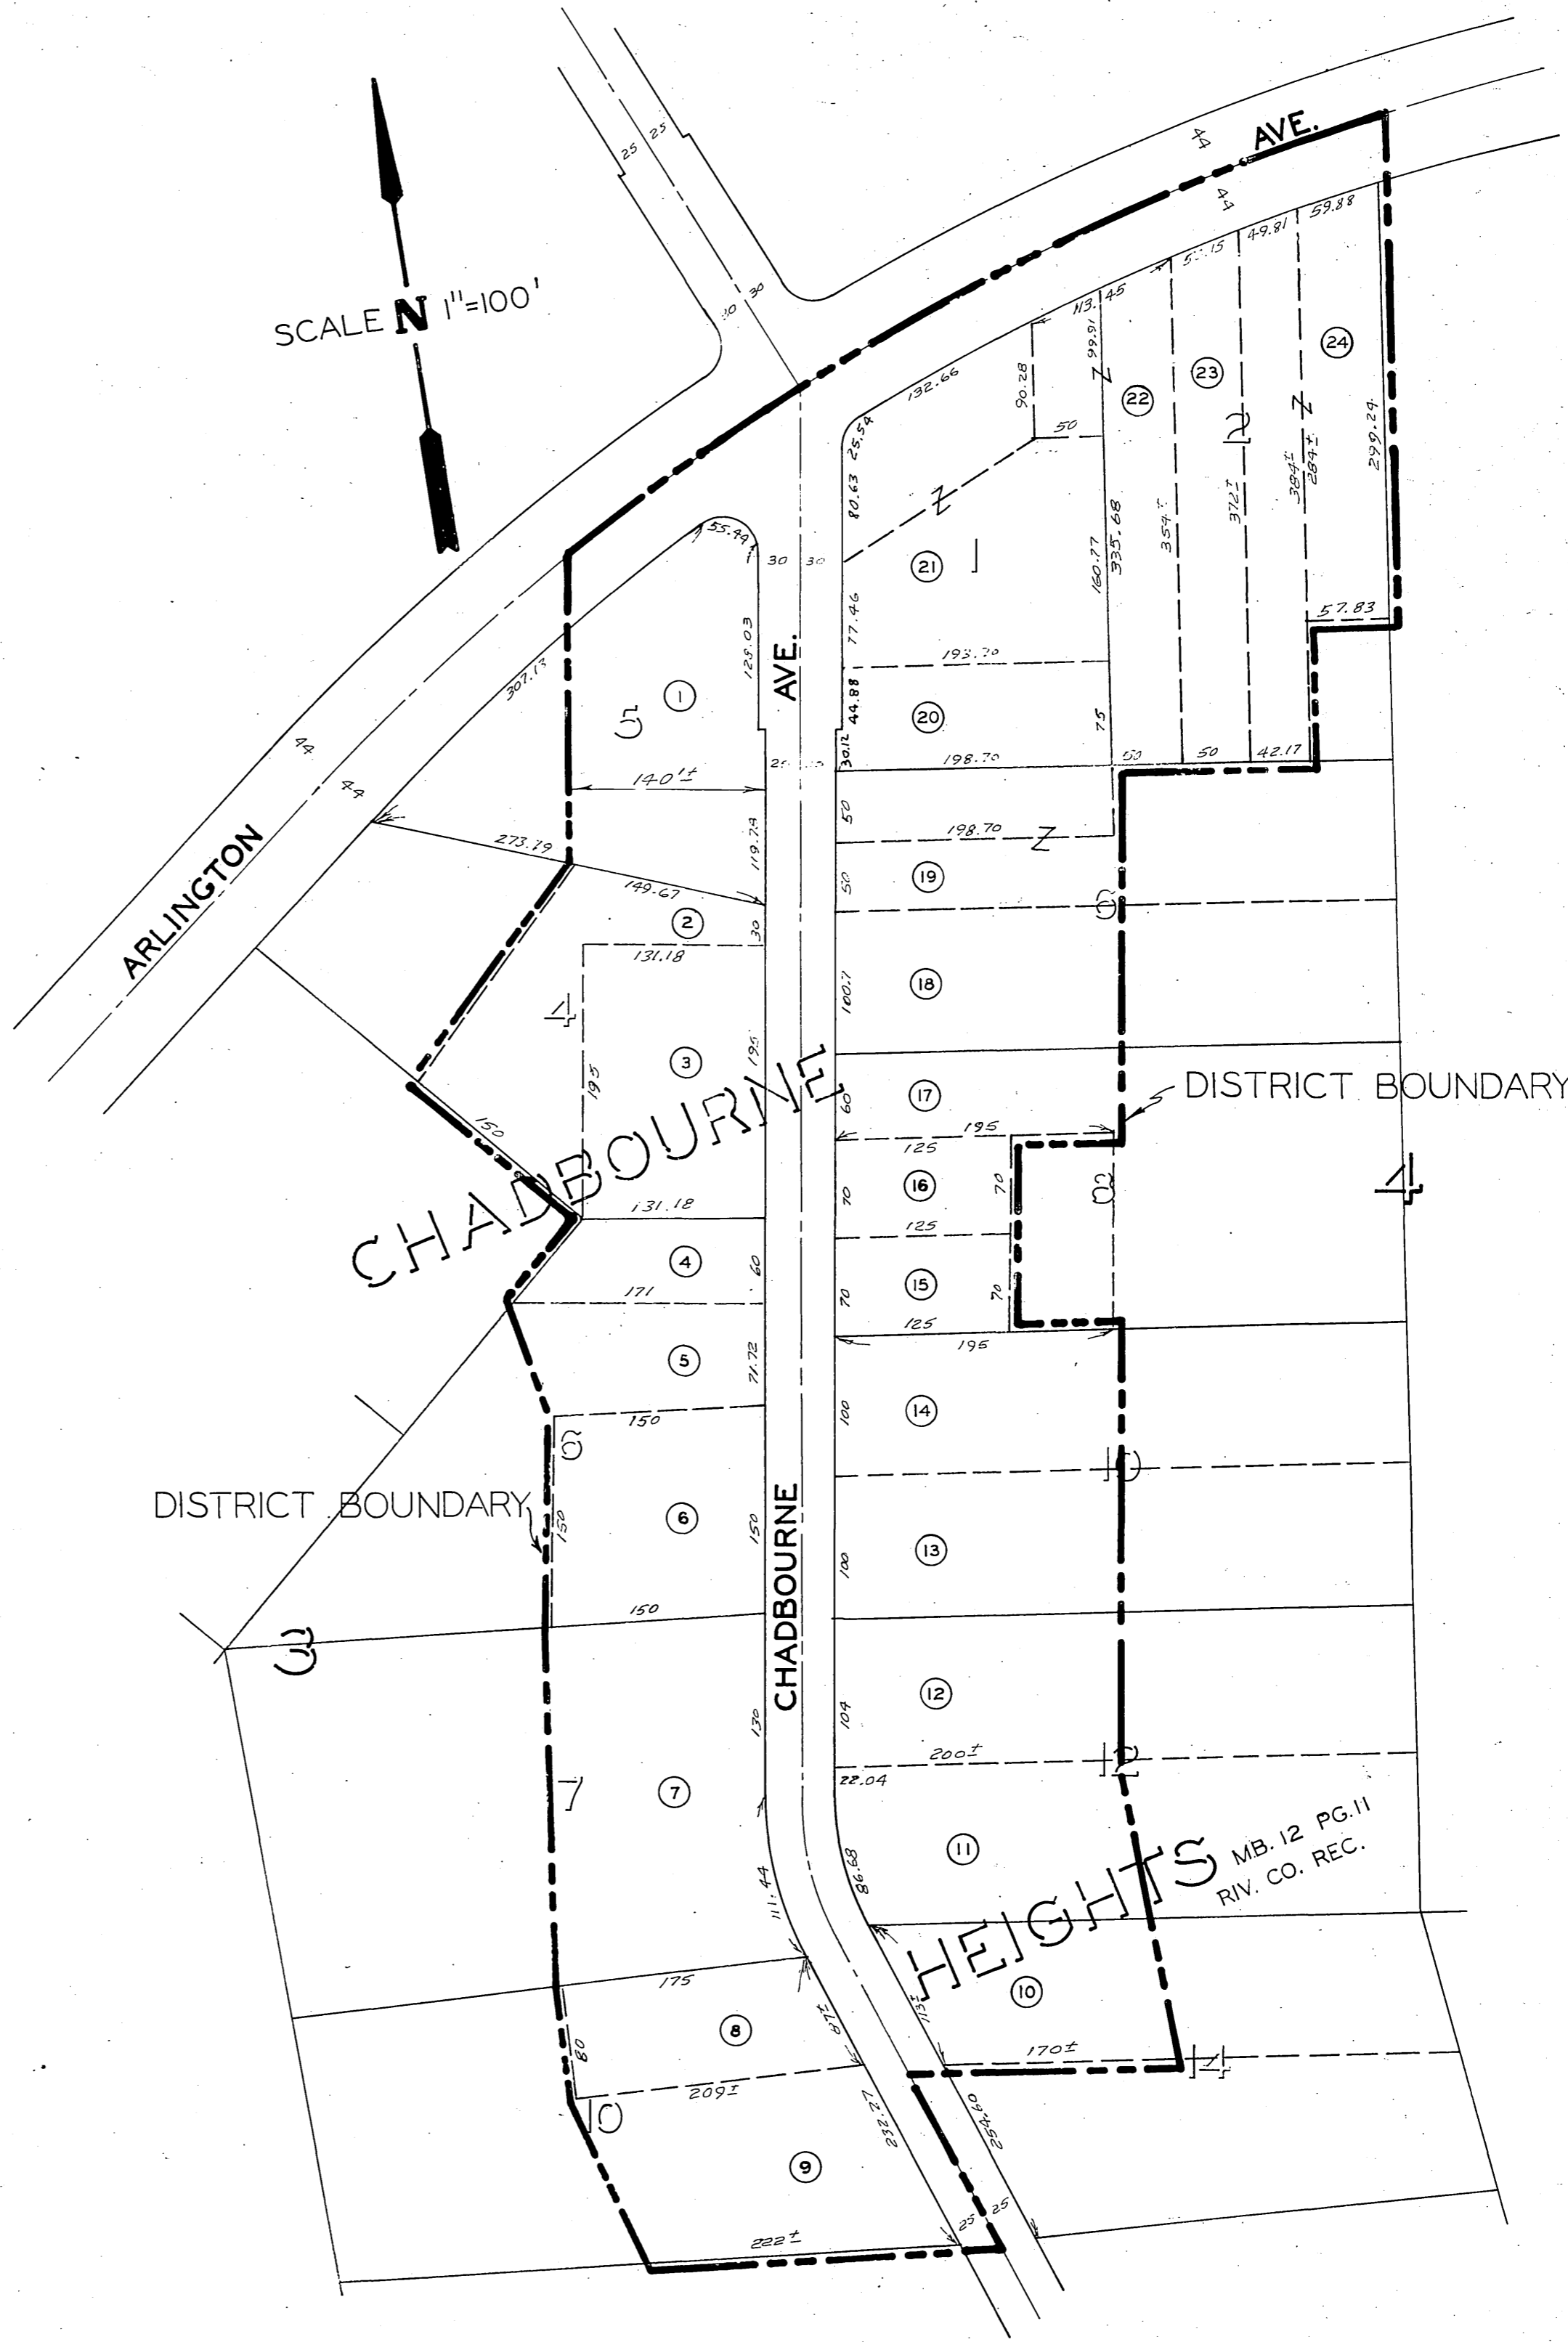

SCALE **N** 1"=100'

ARLINGTON AVE.
 CHADBOURNE AVE.
 DISTRICT BOUNDARY

HEIGHTS MB. 12 PG. 11
 RIV. CO. REC.

LEGEND
 Z-----INDICATES PORTIONS OF DIFFERENT LOTS TO BE ASSESSED TOGETHER.
 (22)-----CIRCLED NUMBER INDICATES PROPOSED ASSESSMENT PARCEL NUMBERS.

DIAGRAM OF THE PROPERTY AFFECTED OR BENEFITED BY THE WORK IN THE CHADBOURNE AVENUE SANITARY SEWER DISTRICT.

REVISIONS			CITY OF RIVERSIDE, CALIFORNIA DEPARTMENT OF PUBLIC WORKS	
MARK	DATE	DESCRIPTION		
			CHADBOURNE AVENUE SANITARY SEWER DISTRICT	
DESIGNED BY	SUBMITTED BY		APPROVED BY	PROJ. NO. 6073
DRAWN BY <i>Dur</i>	PARK DEPT.	TRAFFIC DIV.	_____ DIRECTOR OF PUBLIC WORKS	S-692-B SHEET 2 OF 2
CHECKED BY	RECOMMENDED BY			