


PROFILE	DATE
NO.	
DATE	

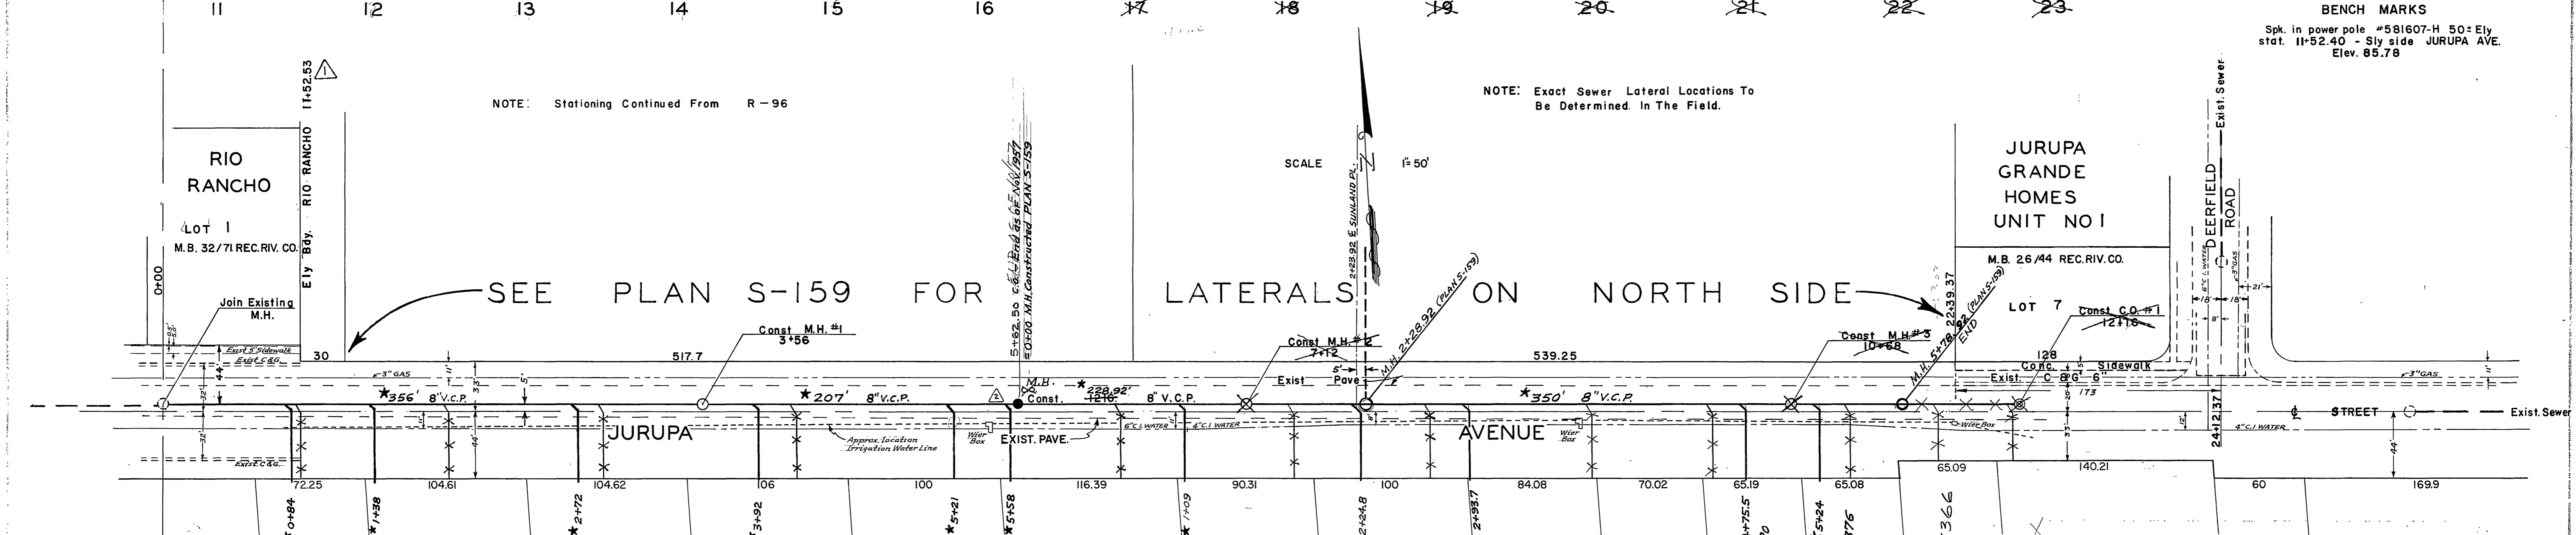

NOTE: Stationing Continued From R-96

NOTE: Exact Sewer Lateral Locations To Be Determined In The Field.

BENCH MARKS
Spk. in power pole #581607-H 50± Ely stat. 11+52.40 - Sly side JURUPA AVE. Elev. 65.76

PLAN	DATE
NO.	
DATE	

REVISIONS		CITY OF RIVERSIDE CALIFORNIA DEPARTMENT OF PUBLIC WORKS
MARK	DATE	
△	4-26-57	JURUPA AVENUE SANITARY SEWER WEST OF DEERFIELD ROAD
△	8-12-57	
△	9-23-59	

Participated in Construction

Participated in construction; NO ASSESSMENT

Reimb. Contr. # 26

S-76

SHEET 1 OF 1