


POTHOLE TO BE LOCATED
IN P.C.C. DRIVEWAY APPR.
REPLACE P.C.C. WITH A.C.

⊗ POTHOLE LOCATIONS

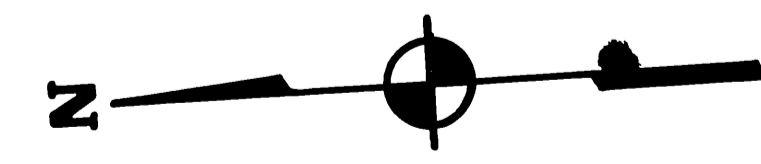

* AS BUILT 10-7-85

CITY OF RIVERSIDE, CALIFORNIA PUBLIC WORKS DEPARTMENT		ARLINGTON PLAZA PUMP STATION RELIEF		ACCOUNT NO. 32-577-572
APPROVED BY _____ BY _____ DATE _____		APPROVED BY _____		DRAWING NUMBER
PRINCIPAL ENGINEER		DIRECTOR OF PUBLIC WORKS		S-767A
PARK DEPARTMENT		DATE _____		
TRAFFIC DIVISION		DATE _____		SHEET 1 OF 1
CHIEF PUB. WKS. ENGR.		DATE _____		HORIZ. SCALE: 1" = 40' VERT. SCALE: 1" = 4'
MARK	REVISIONS	APPR. DATE	DESIGNED BY	DRAWN BY
				CHECKED BY