


GENERAL NOTES -

1. Construction shall be in accordance with the City of Riverside, Department of Public Works, Standard Specifications No. 401 and Standard Drawings.
2. It shall be the responsibility of the contractor to clear the right of way in accordance with the provisions of the law as it affects such utility including irrigation lines and appurtenances and of no cost to the City.
3. Joints shall be in conformance to A.S.T.M. Specification C-200-64 Type 1 or 3 or to A.S.T.M. Specification C-394-66T (head seal) with certain exceptions or modifications in file with the City Eng.
4. Pipe shall be bedded per Case 1 Standard Drawing No. 482 unless otherwise shown.
5. All manholes to be constructed per Standard Drawing No. 500 unless otherwise shown.
6. Location of "Trees" and "Laterals" will be determined in the field by the owner or his representative.
7. Prior to trenching the contractor is to uncover existing sewer pipe and contact the engineer to verify the existing elevation.
8. It shall be the contractor's responsibility to familiarize himself with the jobsite and any underground facilities shown or not shown on these plans. The engineer will not be responsible for any damage to underground facilities.

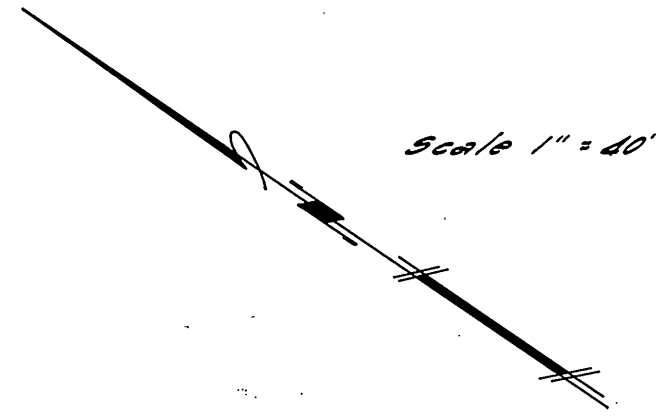

GARNER, TEE, TRACADAS & TROY INC. CIVIL ENGINEERING - LAND SURVEYING 357 West Second Street San Bernardino, California Phone TU5-0266 DATE 12/15/70 FRANK TRACADAS R.C.E. 11447	APPROVED BY <i>Howard L. Crusan</i> Chief Public Utilities Engineer Date 1-28-71	* AS BUILT 8/10/71 norm	CITY OF RIVERSIDE, CALIFORNIA DEPARTMENT OF PUBLIC WORKS SANDBERG STREET TRACT NO. 4121 PROJECT NO. S-825 SHEET 1 OF 1 FILE NO.
	DESIGNED BY <i>Frank Tracadas</i> DRAWN BY CHECKED BY <i>BT</i>	APPROVED BY <i>William D. Doreman</i> DIRECTOR OF PUBLIC WORKS DATE 2/2/71	