

PIPE CURVE DATA

$\Delta = 5^{\circ}21'$	$R = 2134'$
$T = 100'$	$L = 186.72'$
$\Delta = 5^{\circ}23'22''$	$R = 2124.49'$
$T = 100.00'$	$L = 200.22'$

- AS BUILT NOTES \*
- EXISTING STREET TOP 1" LOWER THAN SHOWN ON PLAN.
  - LOWERED STEEL CASING TO CLEAR R.C.B. FOUNDATION.

CONSTRUCTION NOTES



- CONSTRUCT SEWER MANHOLES PER CITY STANDARD DRAWING NO. 500 MOD.
- PIPE BEDDING SHALL BE PER CITY STD. DWG. NO. 452, CASE I.
- THE CONTRACTOR SHALL NOTIFY THE GAS CO. BEFORE STARTING ANY WORK IN THE VICINITY OF THE HIGH PRESSURE GAS MAIN - TEL. 714-845-2617.
- ALL CONSTRUCTION SHALL BE IN ACCORDANCE WITH STANDARD SPECIFICATIONS FOR PUBLIC WORKS CONSTRUCTION, 1970 EDITION, AND CITY OF RIVERSIDE STANDARD DRAWINGS.
- NO WORK SHALL BE STARTED WITHIN THE STREET RIGHT OF WAY OR ON CITY PROPERTY UNTIL THE CONTRACTOR HAS OBTAINED THE NECESSARY PERMITS.
- THE CONTRACTOR SHALL BE RESPONSIBLE FOR LOCATING ALL UNDERGROUND FACILITIES, SHOWN ON THE PLAN OR OTHERWISE, BEFORE BEGINNING ANY EXCAVATION WORK.

\* AS BUILT 11-7-71 JAW (FOR NEW CONSTRUCTION SEE S-1211)

LIMITS OF PRESENT CONSTRUCTION FOR BUCHANAN ST. SEWER EXT. NO. 2

DEREK WHITE & ASSOC. 3682 PROVINCETOWN AVENUE SANTA ANA, CALIFORNIA 92705 714-644-0903		CITY OF RIVERSIDE, CALIFORNIA DEPARTMENT OF PUBLIC WORKS		SEWER PLAN AND PROFILE IN BUCHANAN STREET MAGNOLIA TO AVENUE 1030' NORTHLY C-48-690		PROJECT NO. <b>S-835</b>
DESIGNED BY: DEREK H. WHITE DRAWN BY: [Signature] CHECKED BY: [Signature]		APPROVED BY: [Signature] OFFICE ENGINEER PARK DEPARTMENT TRAFFIC DIVISION ASSISTANT CITY ENG.		APPROVED BY: [Signature] DIRECTOR OF PUBLIC WORKS		SHEET 1 OF 2 FILE NO.
DATE: 3/5/71 R.C.E. 16,058		DATE: 5/27/71		HORIZ. SCALE: 1" = 40' VERT. SCALE: 1" = 4'		



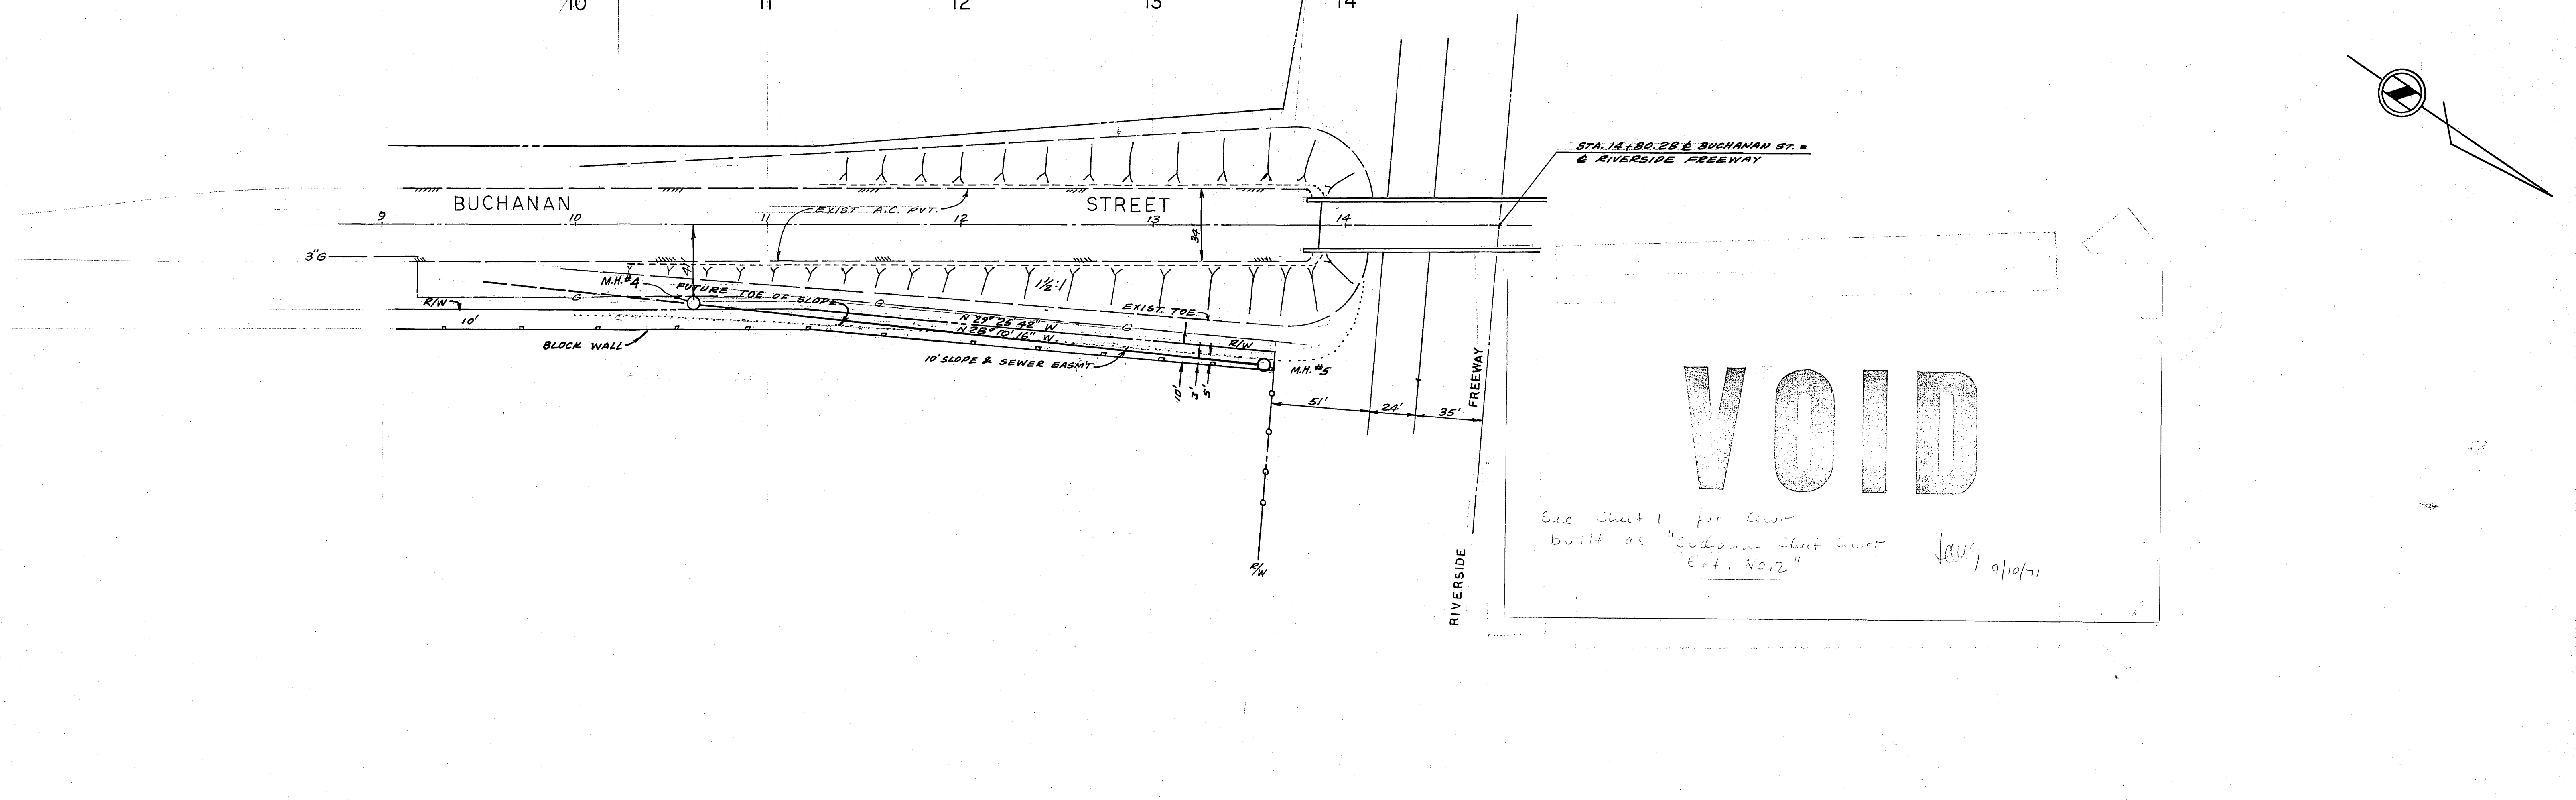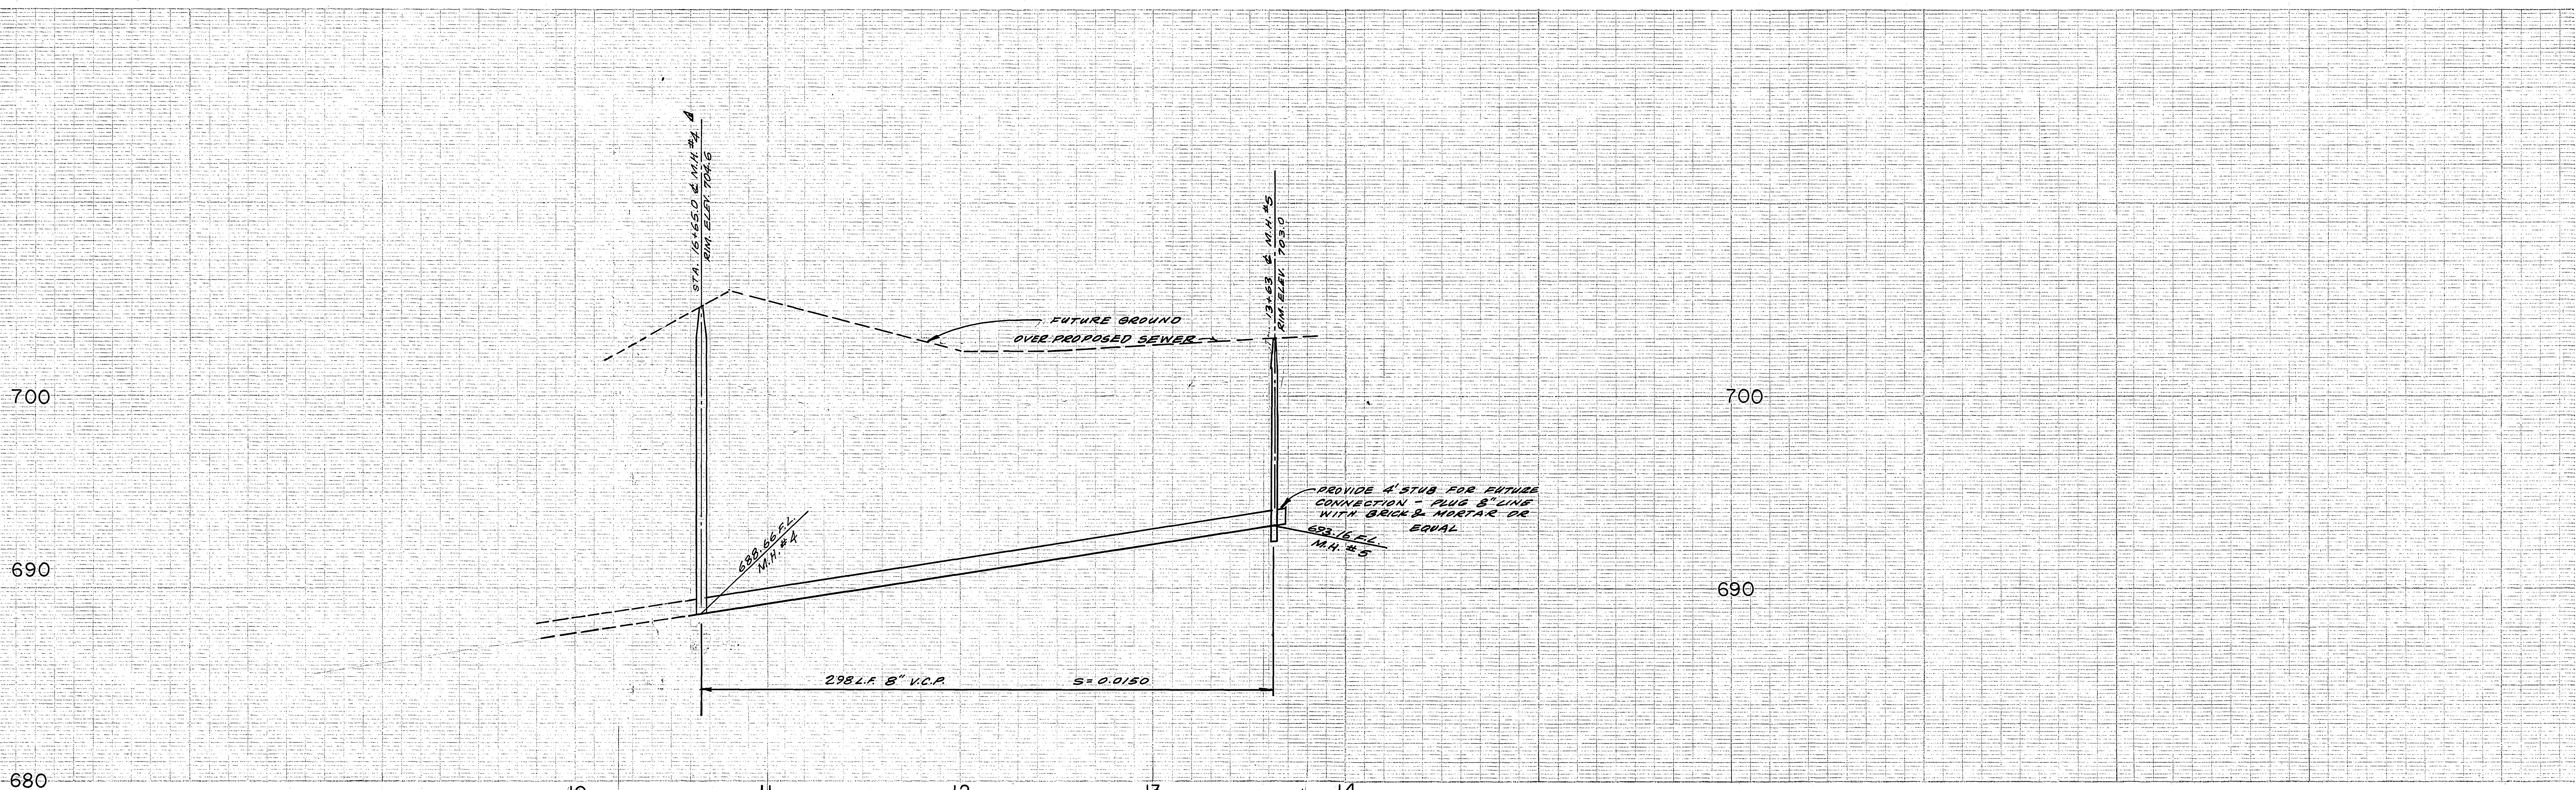

DEREK WHITE & ASSOC.  
 3682 PROVINCETOWN AVENUE  
 SANTA ANA, CALIFORNIA, 92705  
 714-557-8760 714-832-8374  
 DEREK H WHITE 3/15/71 R.C.E. 16,058

DESIGNED BY	DRAWN BY	CHECKED BY	DATE
			5/27/71

CITY OF RIVERSIDE, CALIFORNIA  
 DEPARTMENT OF PUBLIC WORKS  
 APPROVED BY: [Signature]  
 OFFICE ENGINEER: [Signature]  
 PARK DEPARTMENT: [Signature]  
 TRAFFIC DIVISION: [Signature]  
 ASSISTANT CITY ENG.: [Signature]

SEWER PLAN AND PROFILE  
 IN  
 BUCHANAN STREET  
 STA. 10+24 TO FWY.  
 C-48-690  
 HORIZ. SCALE: 1" = 40' VERT. SCALE: 1" = 4'

PROJECT NO.  
**S-835**  
 SHEET **2** OF **2**  
 FILE NO.