



SCALE

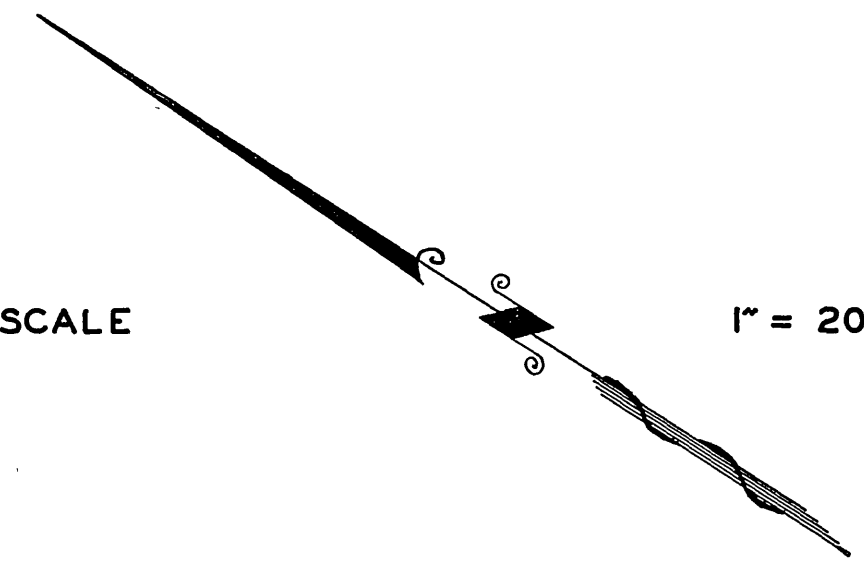

1" = 200'

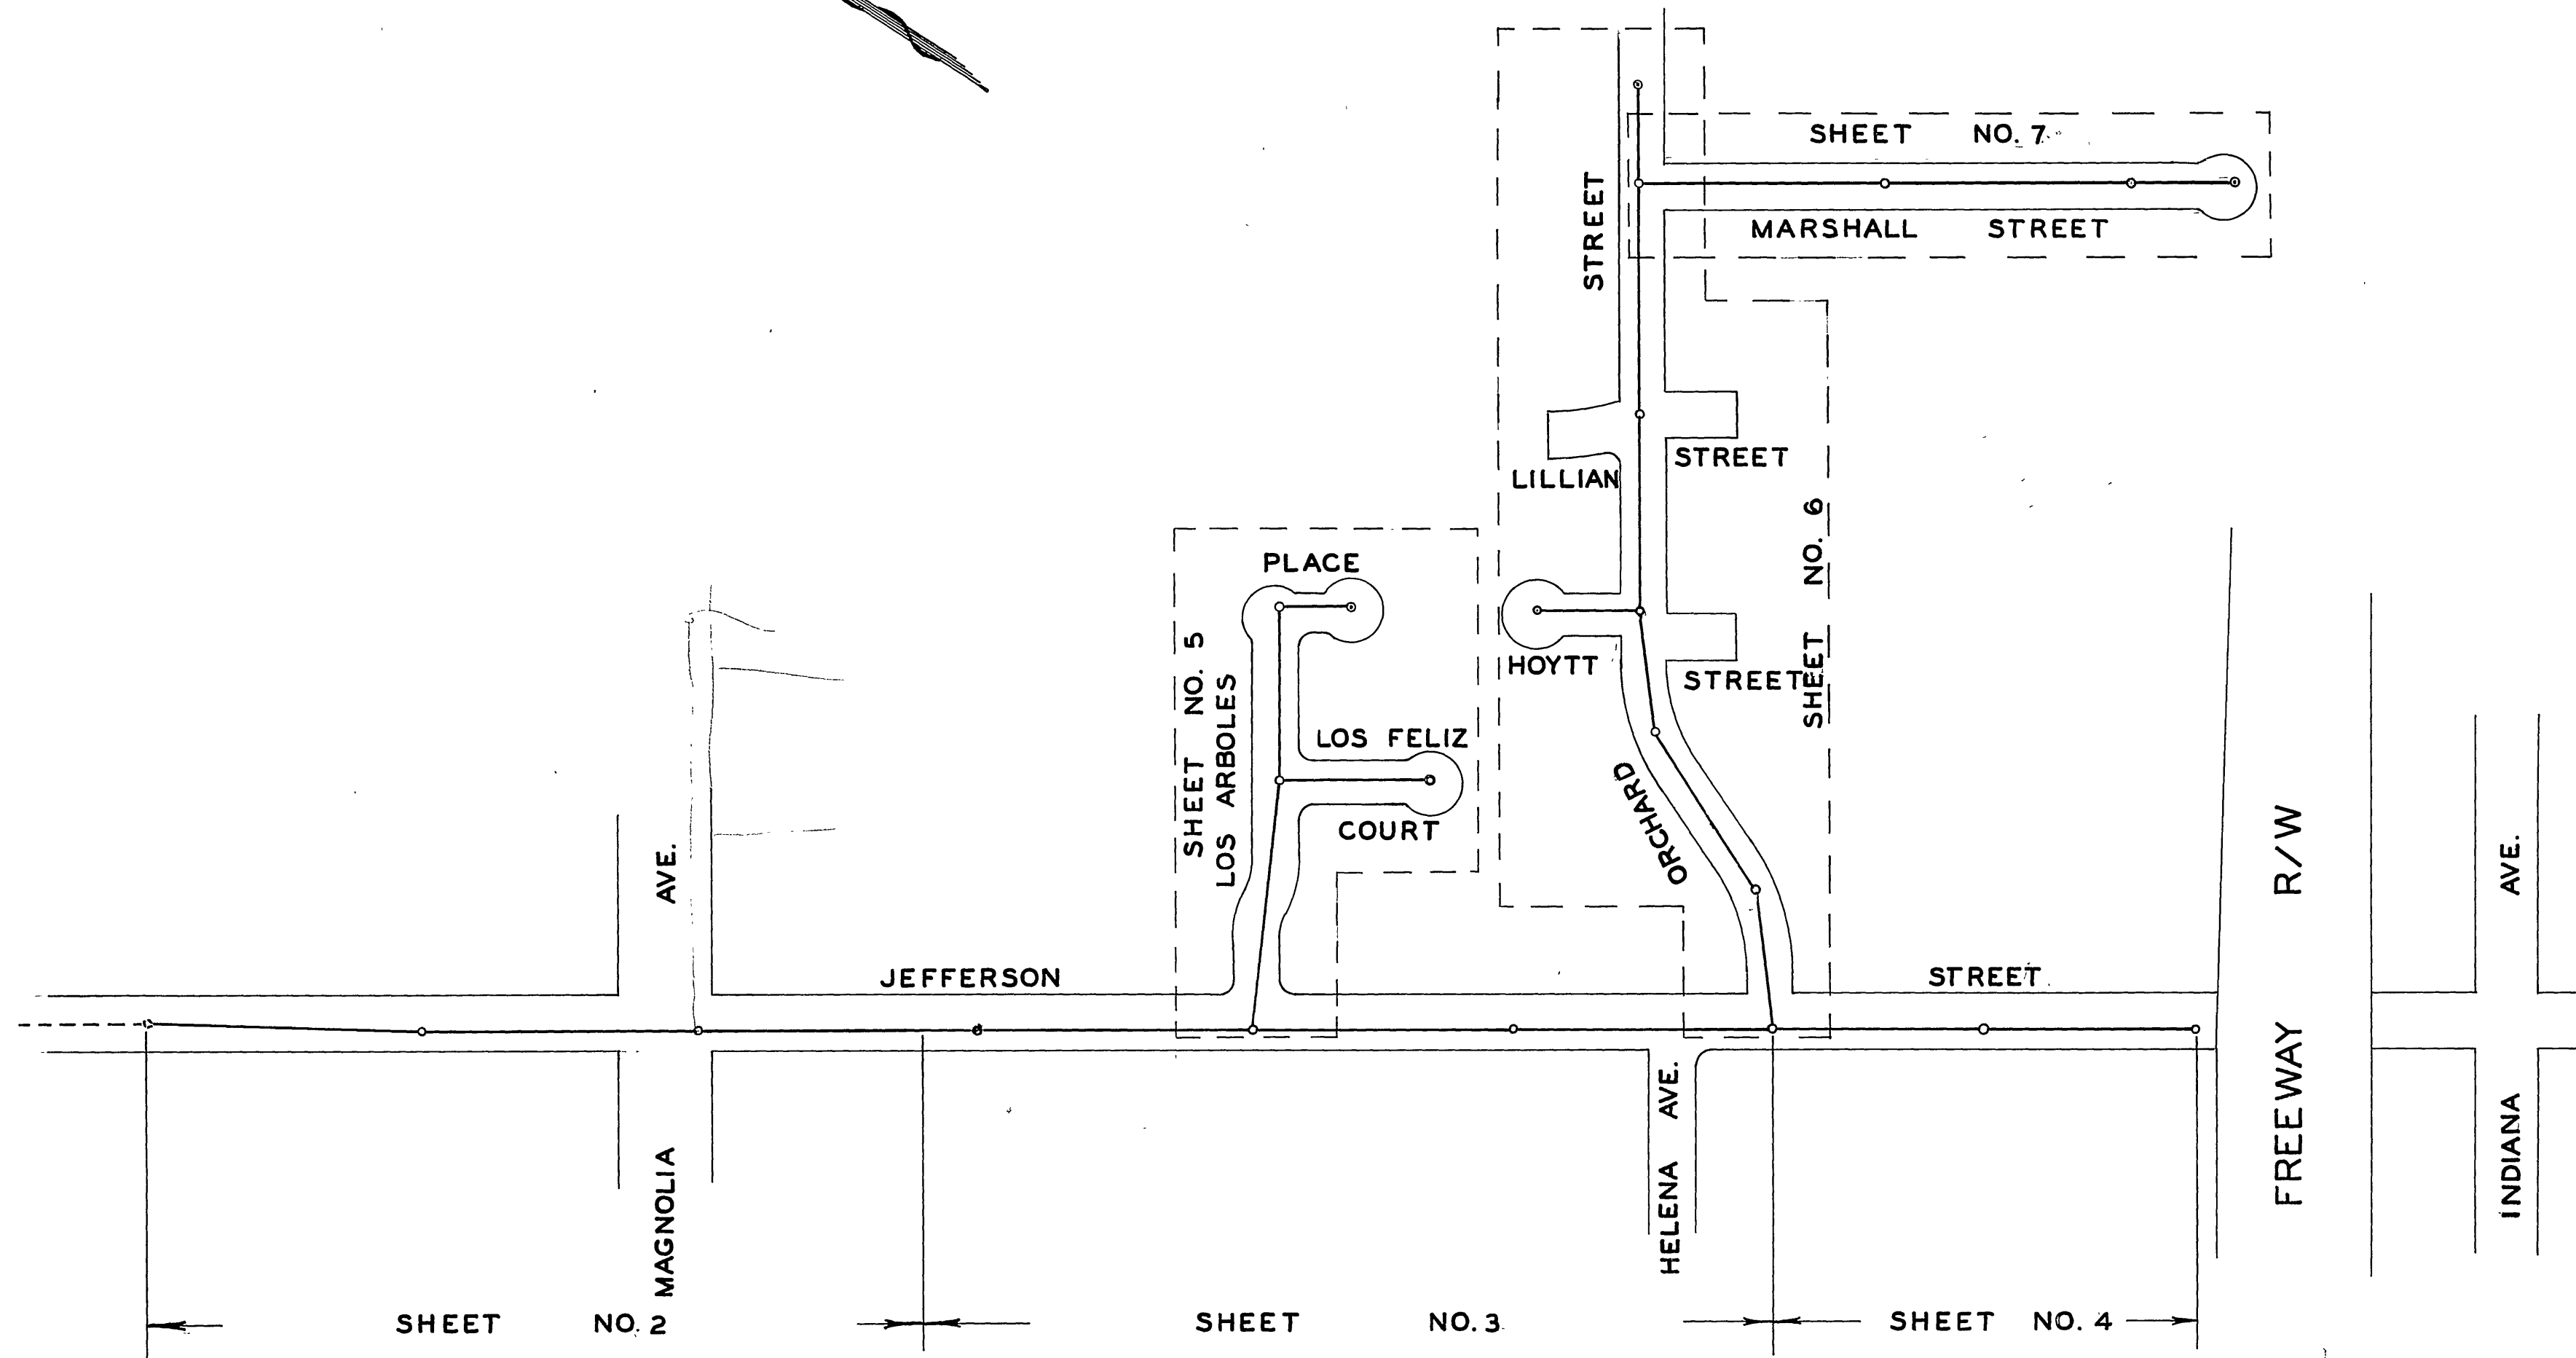


LEGEND:

- TRUNK SEWER TO BE CONSTRUCTED
- EXISTING SEWERS
- MANHOLES
- CLEANOUTS
- HOUSE CONNECTIONS
- WYE

NOTE: IT SHALL BE THE RESPONSIBILITY OF THE CONTRACTOR TO CLEAR THE RIGHT-OF-WAY IN ACCORDANCE WITH THE PROVISIONS OF LAW AS IT EFFECTS EACH UTILITY, INCLUDING IRRIGATION LINES AND APPURTENANCES, AND AT NO EXTRA COST TO THE CITY.


REVISIONS			CITY OF RIVERSIDE, CALIFORNIA DEPARTMENT OF PUBLIC WORKS
MARK	DATE	DESCRIPTION	
			JEFFERSON - ORCHARD SANITARY SEWER DISTRICT INDEX SHEET
DESIGNED BY	W.D.G.	CHECKED BY	APPROVED BY
DRAWN BY	G.S.	MB	
RECOMMENDED BY		ASSISTANT CITY ENGINEER	DIRECTOR OF PUBLIC WORKS
			DATE: Sept 3, 1957

S-85
SHEET 1 OF 7

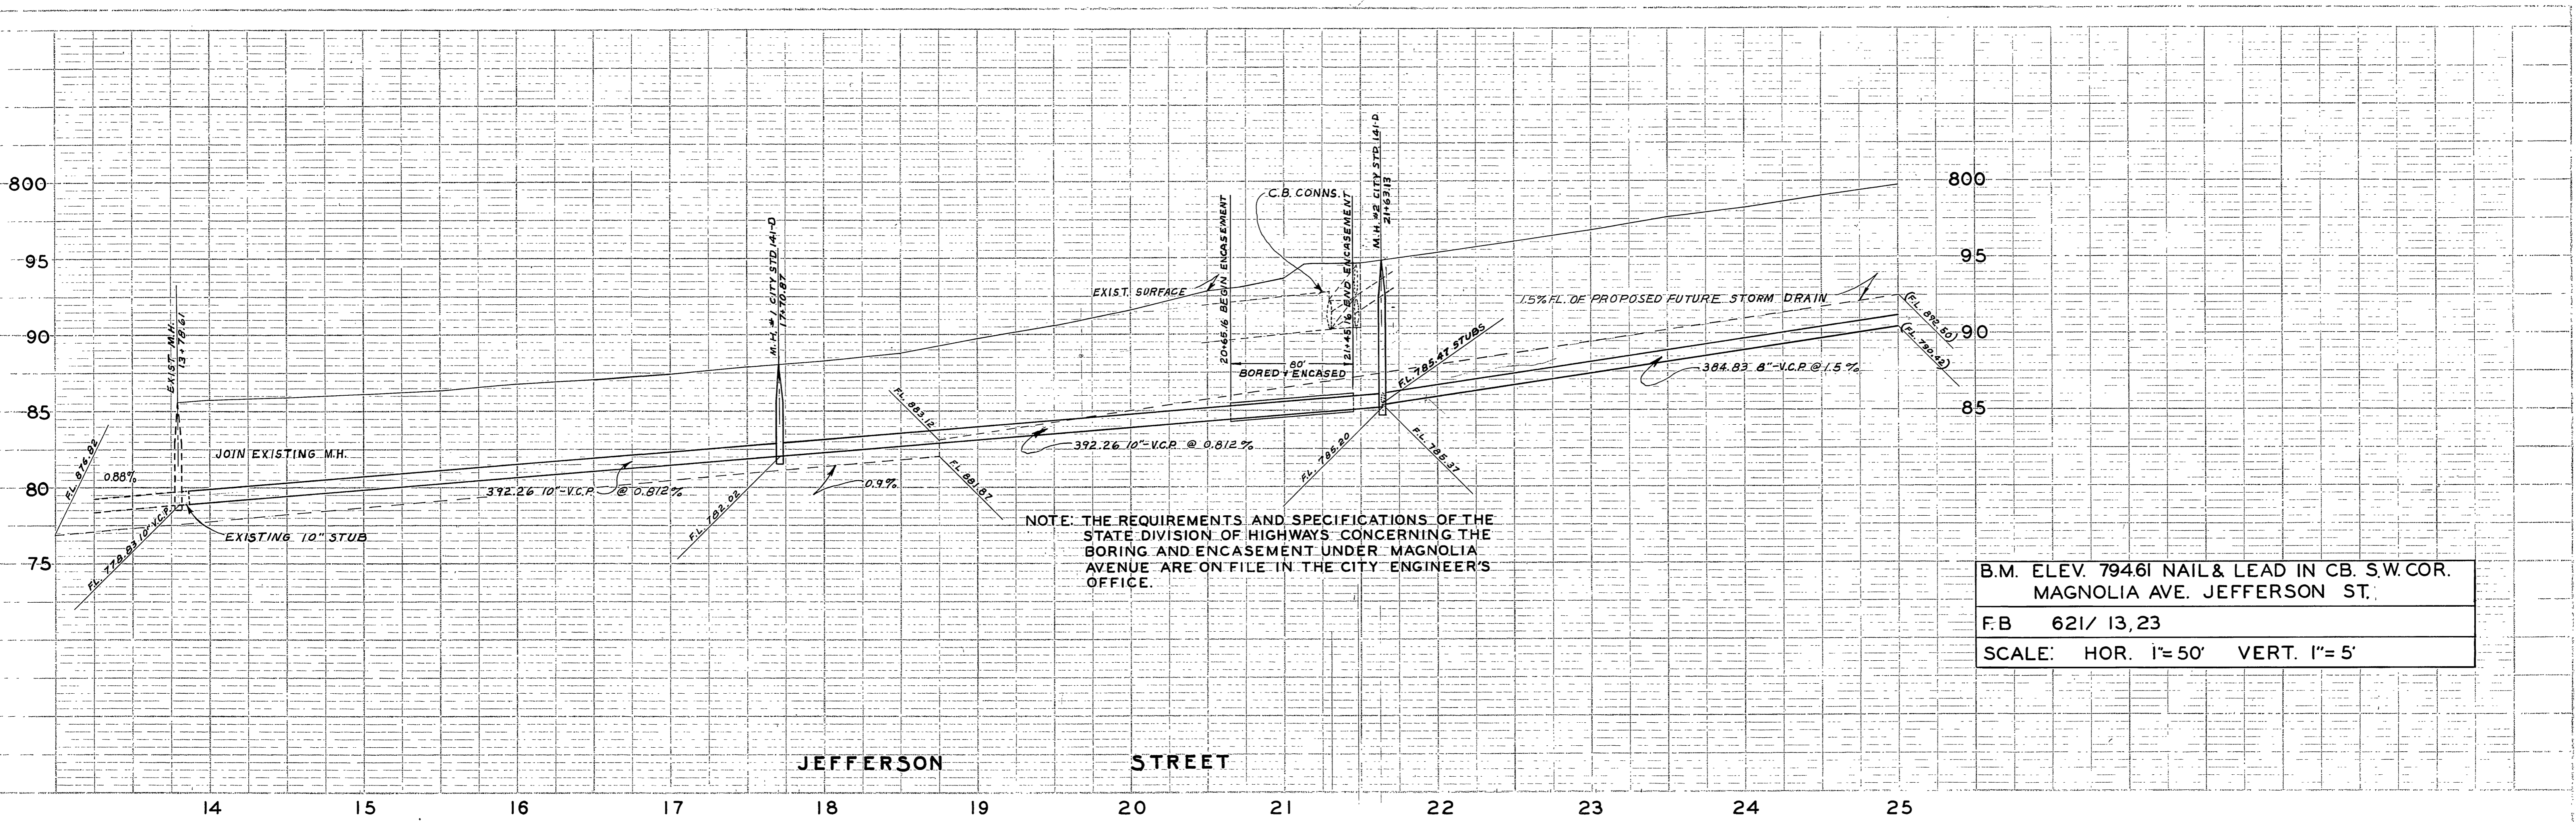


B.M. ELEV. 794.61 NAIL & LEAD IN CB. S.W. COR.
MAGNOLIA AVE. JEFFERSON ST.
F.B. 621/ 13, 23
SCALE: HOR. 1"=50' VERT. 1"=5'

PROFILE	REVISIONS	DATE
1	AS BUILT	

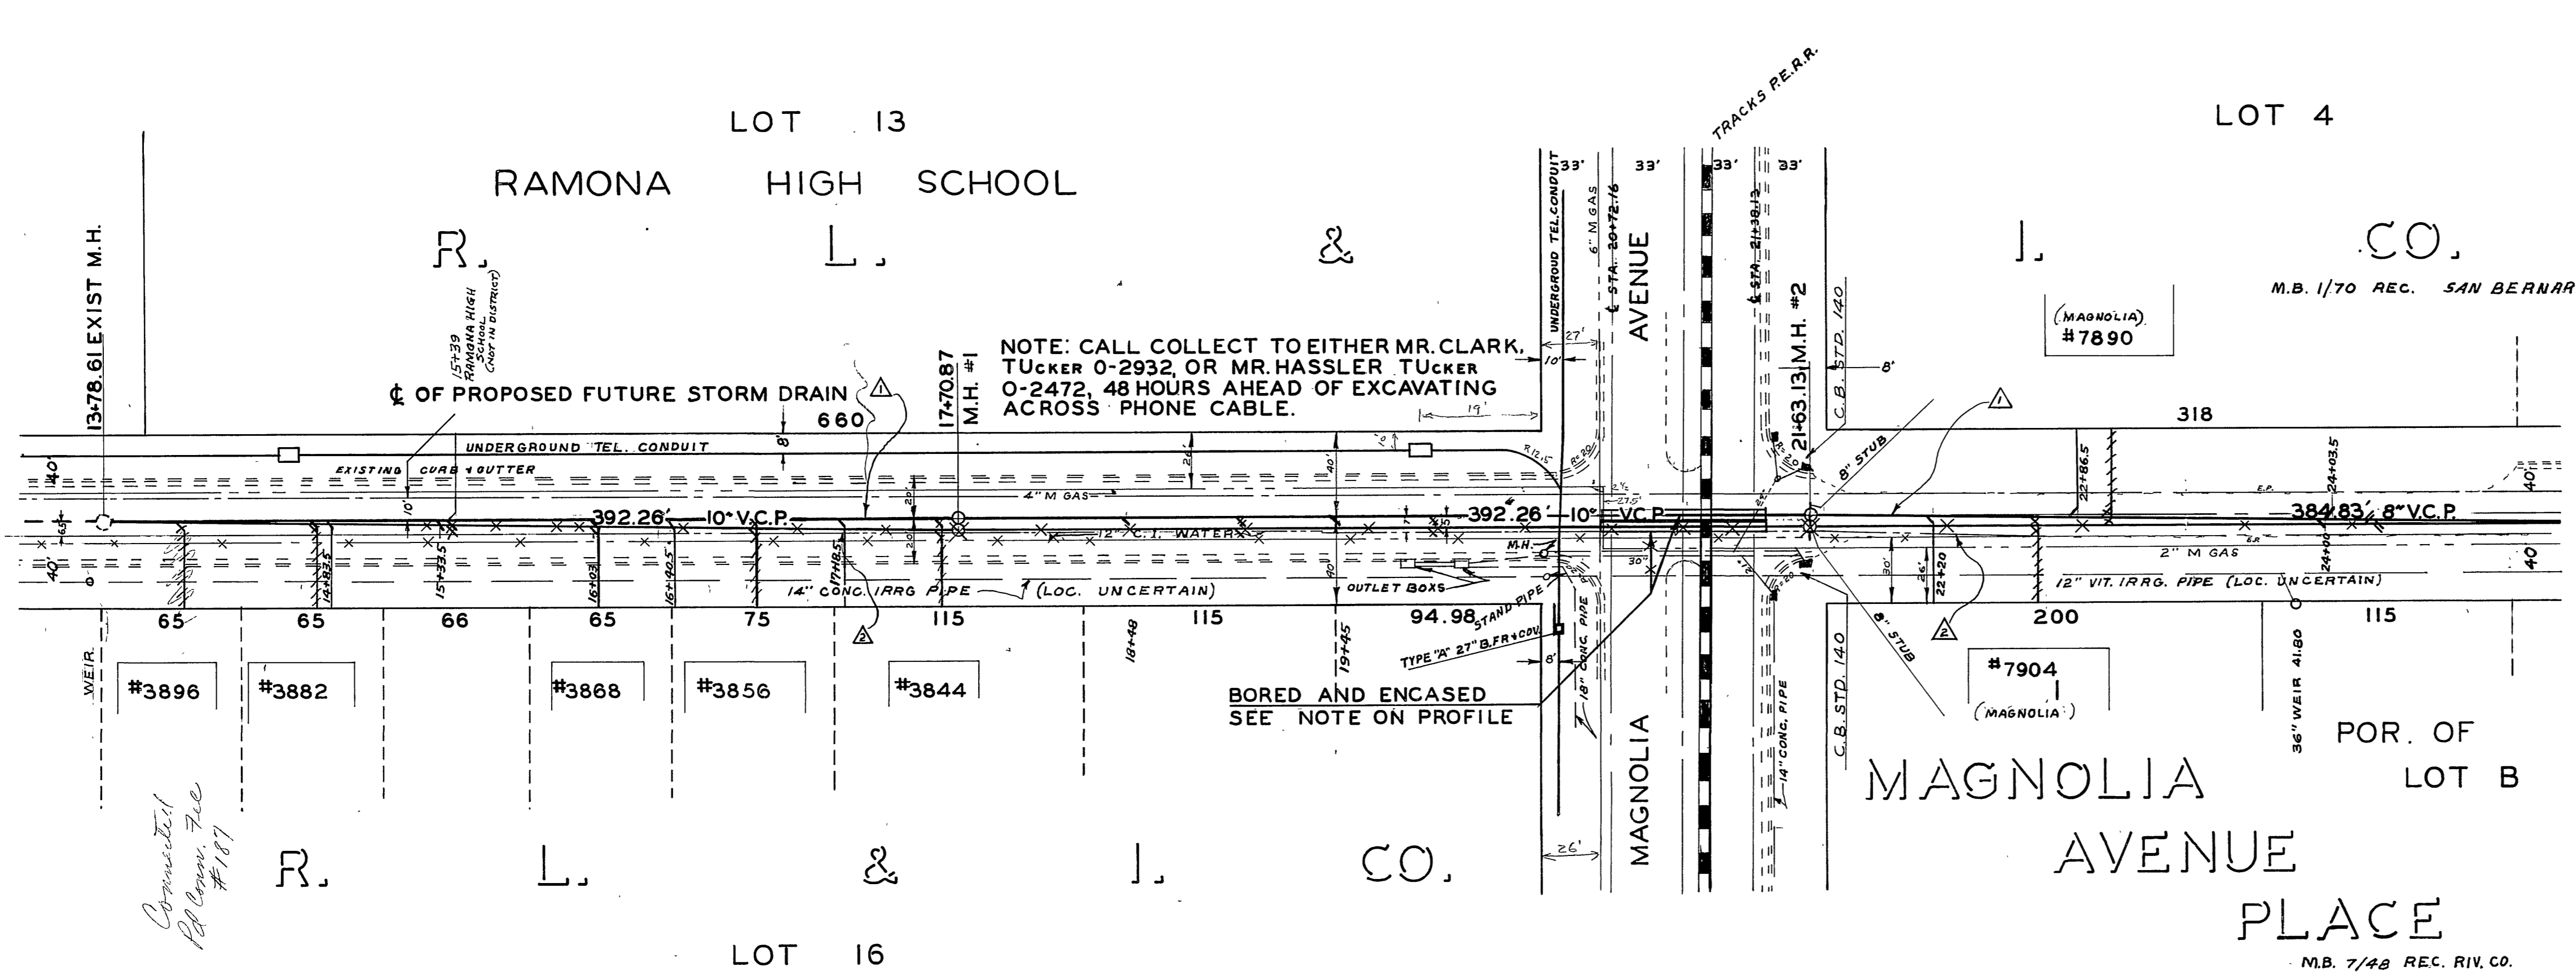

NOTE: LATERALS TO BE LAYED FLAT ON EASTERLY SIDE IN JEFFERSON STREET TO FACILITATE CONSTRUCTION OF PROPOSED STORM DRAIN.

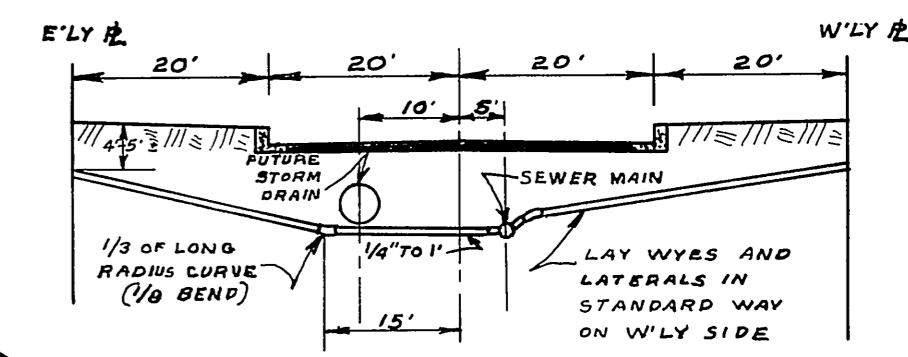


SCALE 1"=50'

SEE SHEET NO. 3

NOTE: EXACT LOCATION OF HOUSE CONNECTIONS TO BE DETERMINED IN THE FIELD.


PLAN	REVISIONS	DATE
1	AS BUILT	

REVISIONS			CITY OF URSIDE CALIFORNIA DEPARTMENT OF PUBLIC WORKS	
MARK	DATE	DESCRIPTION	JEFFERSON - ORCHARD SANITARY SEWER DISTRICT JEFFERSON STREET	
▲	11/4/57	REALIGNMENT TO MISS WATER LINE.		
▲	12/4/57	CORRECT LOCATION OF WATER LINE.		
▲	3/14/58	AS BUILT HOUSE CONNECTIONS AND WYES		
DESIGNED BY	W.D.G.	CHECKED BY	APPROVED BY	S-85 SHEET 2 OF 7
DRAWN BY	W.D.G.	DATE	DATE	

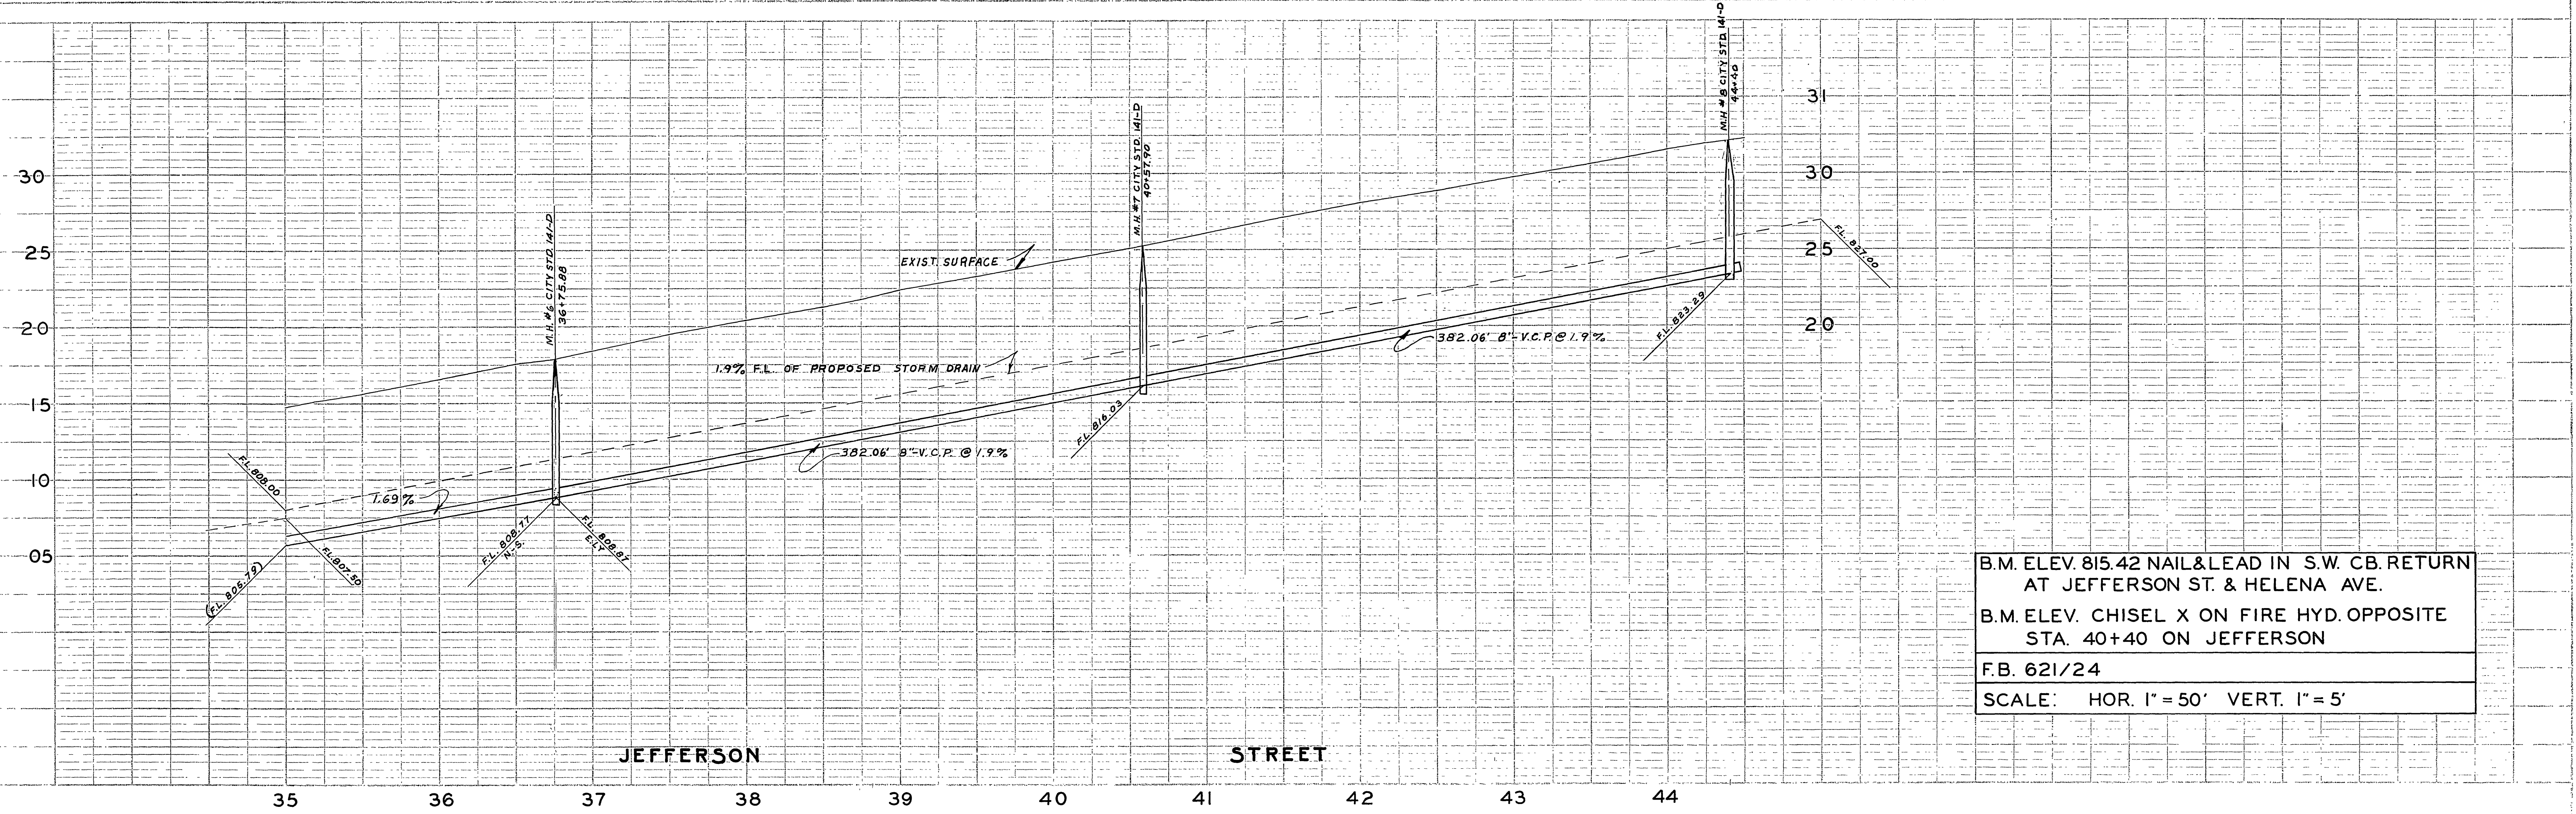

B.M. ELEV. 815.42 NAIL & LEAD IN S.W. CB. RETURN AT JEFFERSON ST. & HELENA AVE.
 B.M. ELEV. CHISEL X ON FIRE HYD. OPPOSITE STA. 40+40 ON JEFFERSON
 F.B. 621/24
 SCALE: HOR. 1" = 50' VERT. 1" = 5'

PROFILE	DATE
SHEET NO.	
DATE	

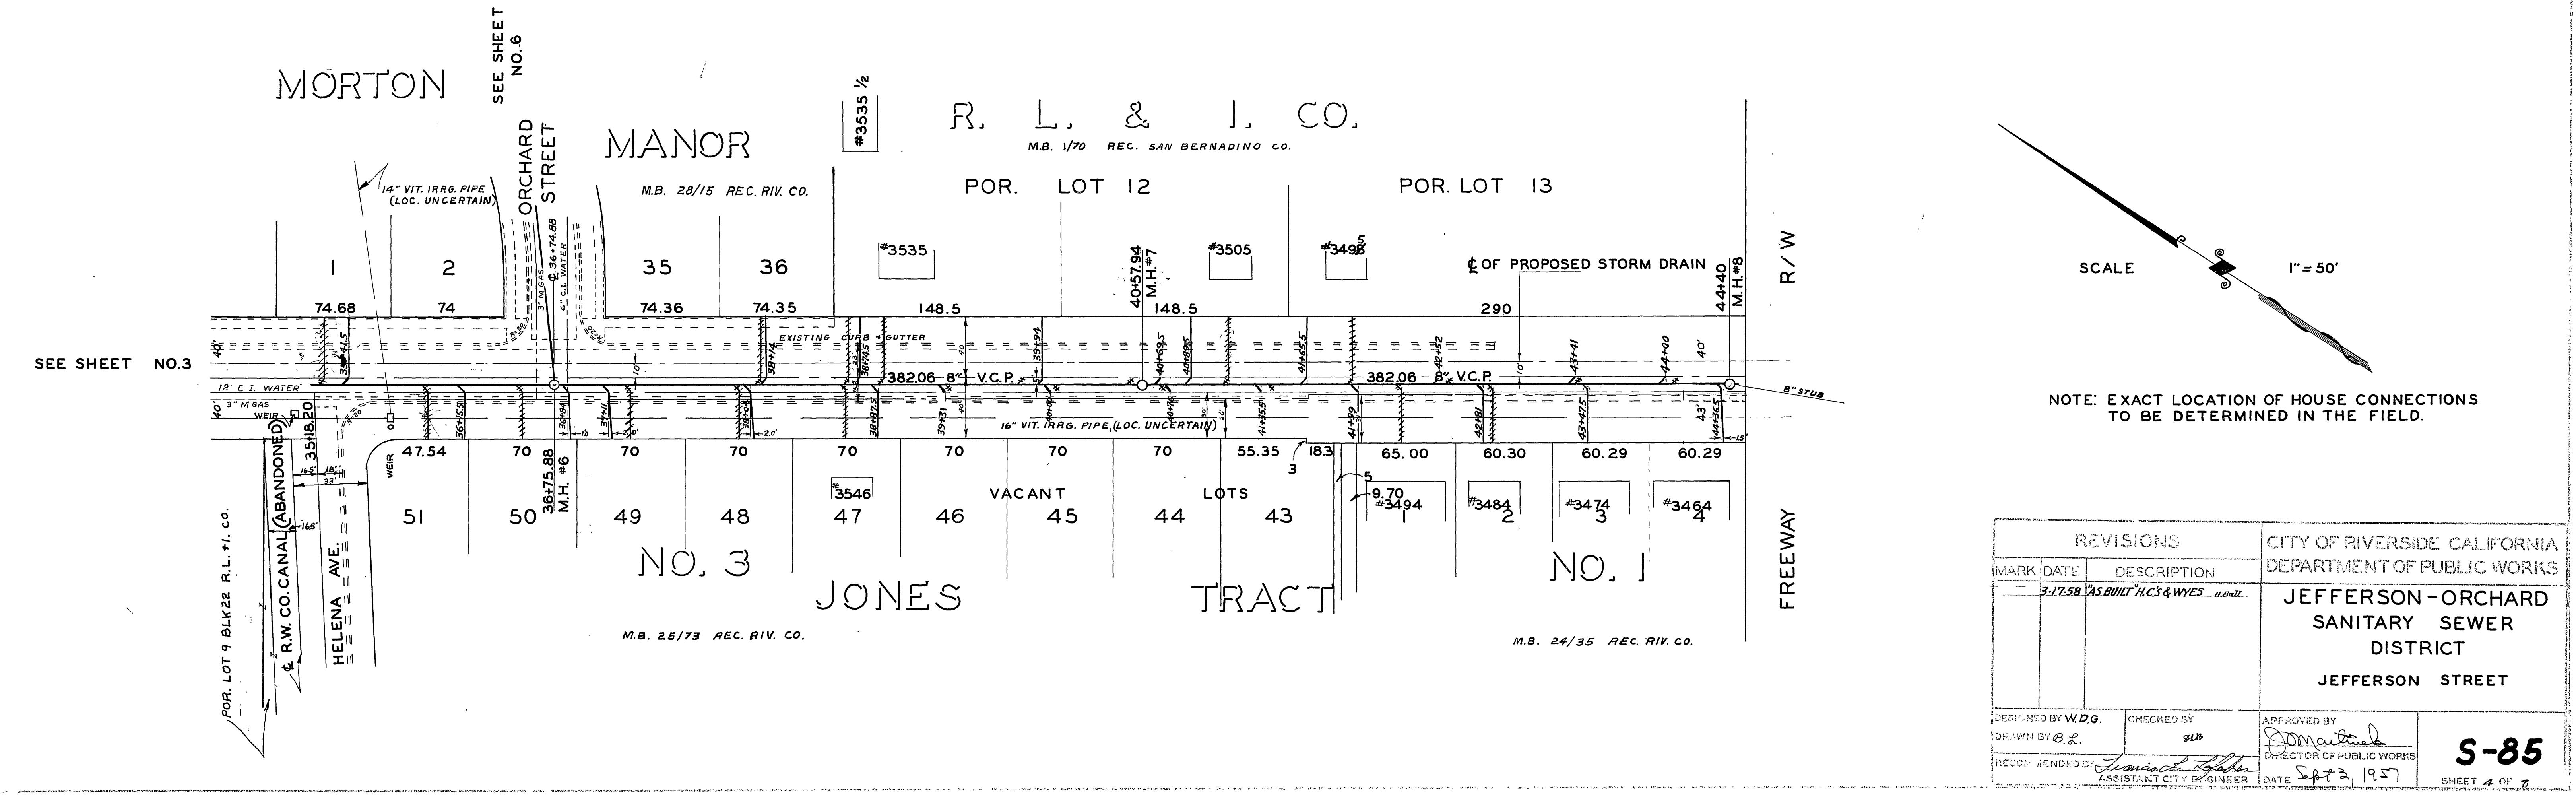


SCALE 1" = 50'
 NOTE: EXACT LOCATION OF HOUSE CONNECTIONS TO BE DETERMINED IN THE FIELD.

PLAN	DATE
SHEET NO.	
DATE	

REVISIONS			CITY OF RIVERSIDE CALIFORNIA DEPARTMENT OF PUBLIC WORKS
MARK	DATE	DESCRIPTION	
	3-17-58	AS BUILT H.C.S. & WYES	




DESIGNED BY W.D.G.	CHECKED BY <i>glt</i>	APPROVED BY <i>Domestich</i>
DRAWN BY B.L.		DIRECTOR OF PUBLIC WORKS
RECOMMENDED BY <i>James C. Walker</i>	ASSISTANT CITY ENGINEER	DATE <i>Sept 2, 1957</i>

S-85
SHEET 4 OF 7

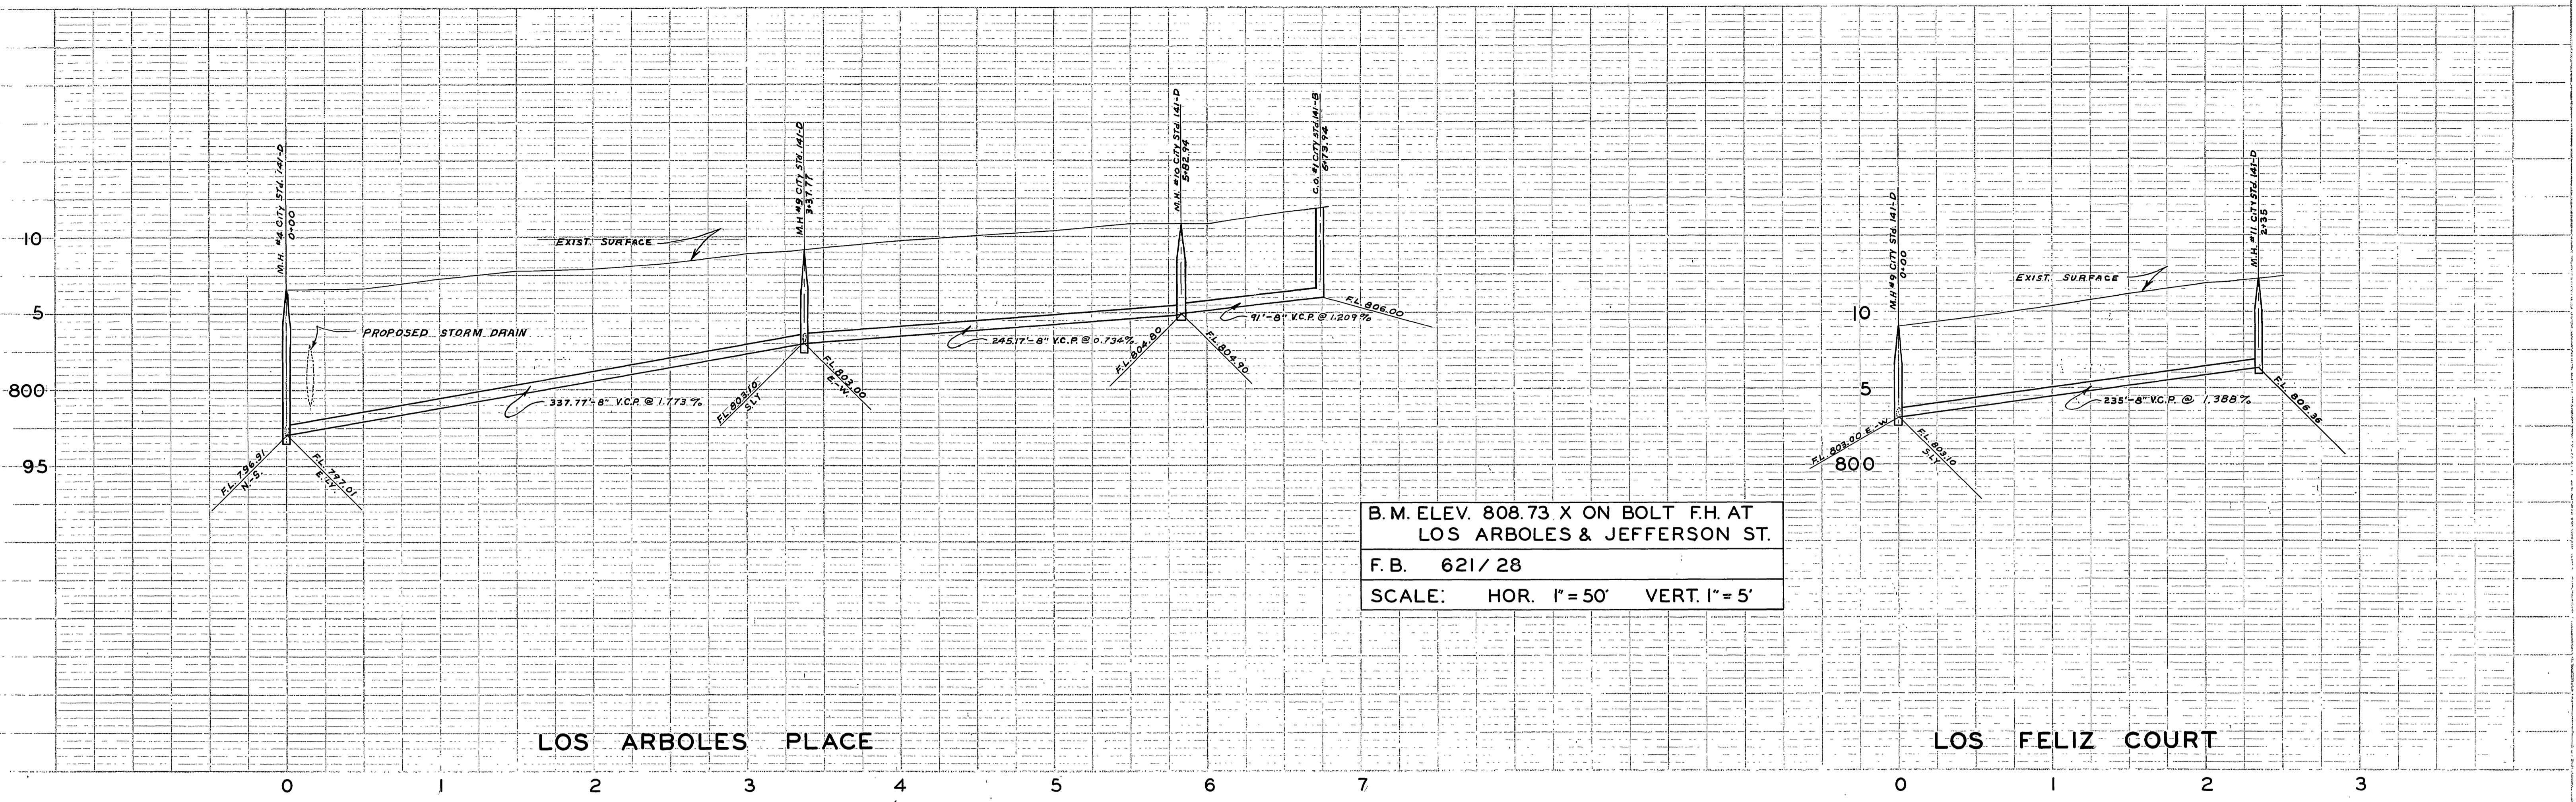

B.M. ELEV. 808.73 X ON BOLT F.H. AT
LOS ARBOLES & JEFFERSON ST.
F.B. 621/28
SCALE: HOR. 1" = 50' VERT. 1" = 5'

PROFILE	SURVEY	DATE
PLOTTED		
NO. 8	8	
STRUCTURE KNIP	NS	CHIBD.

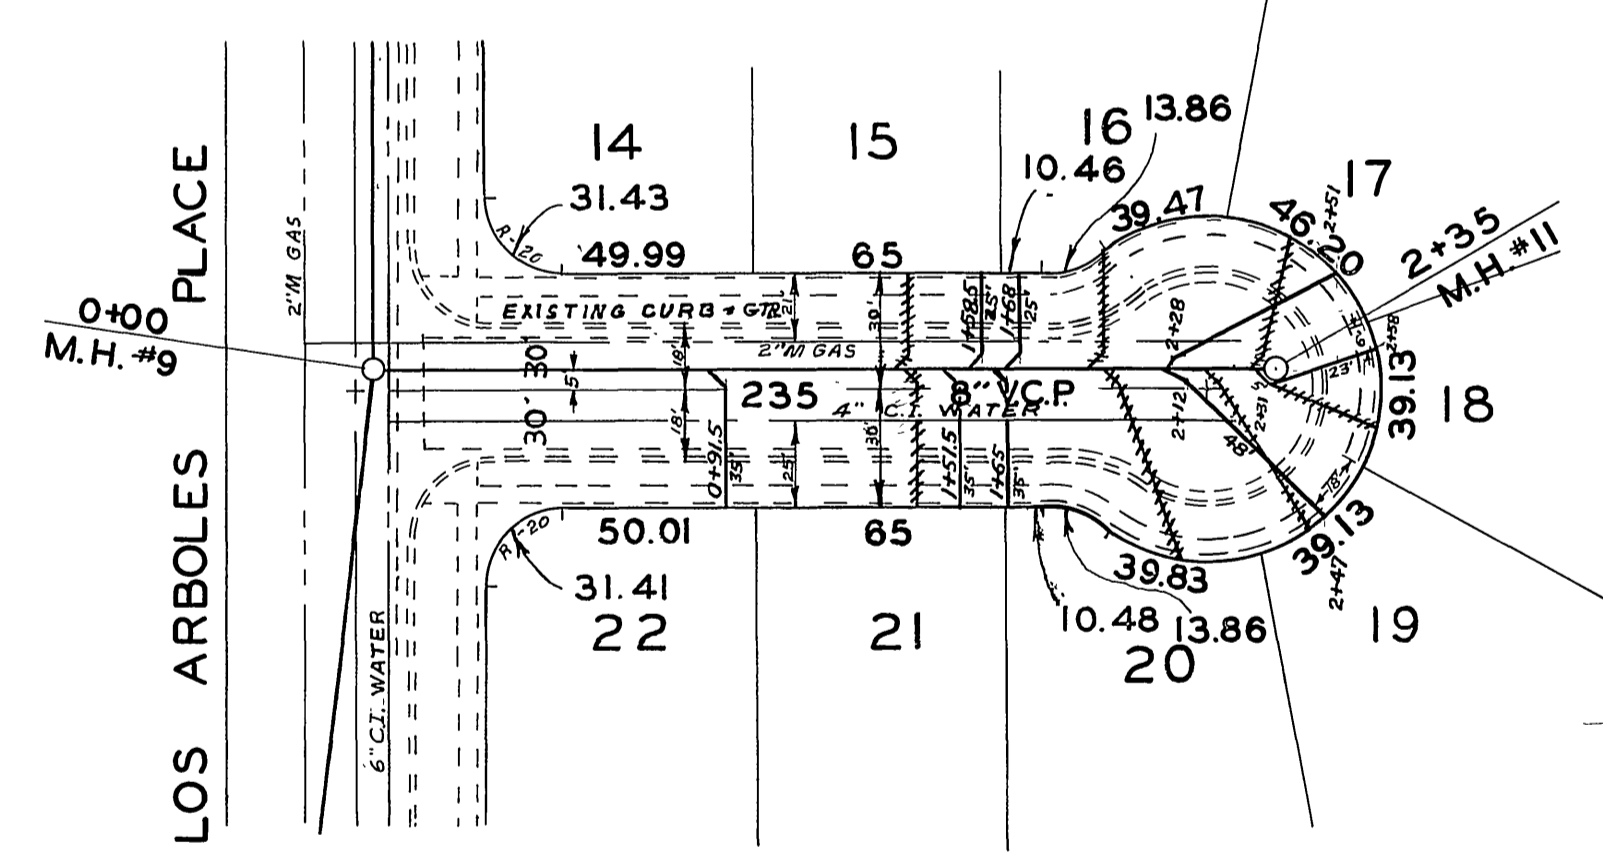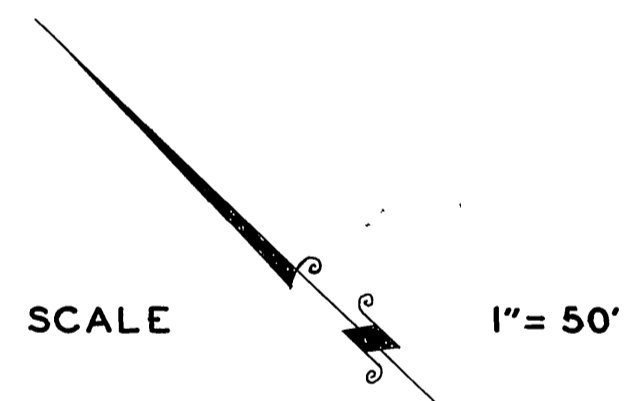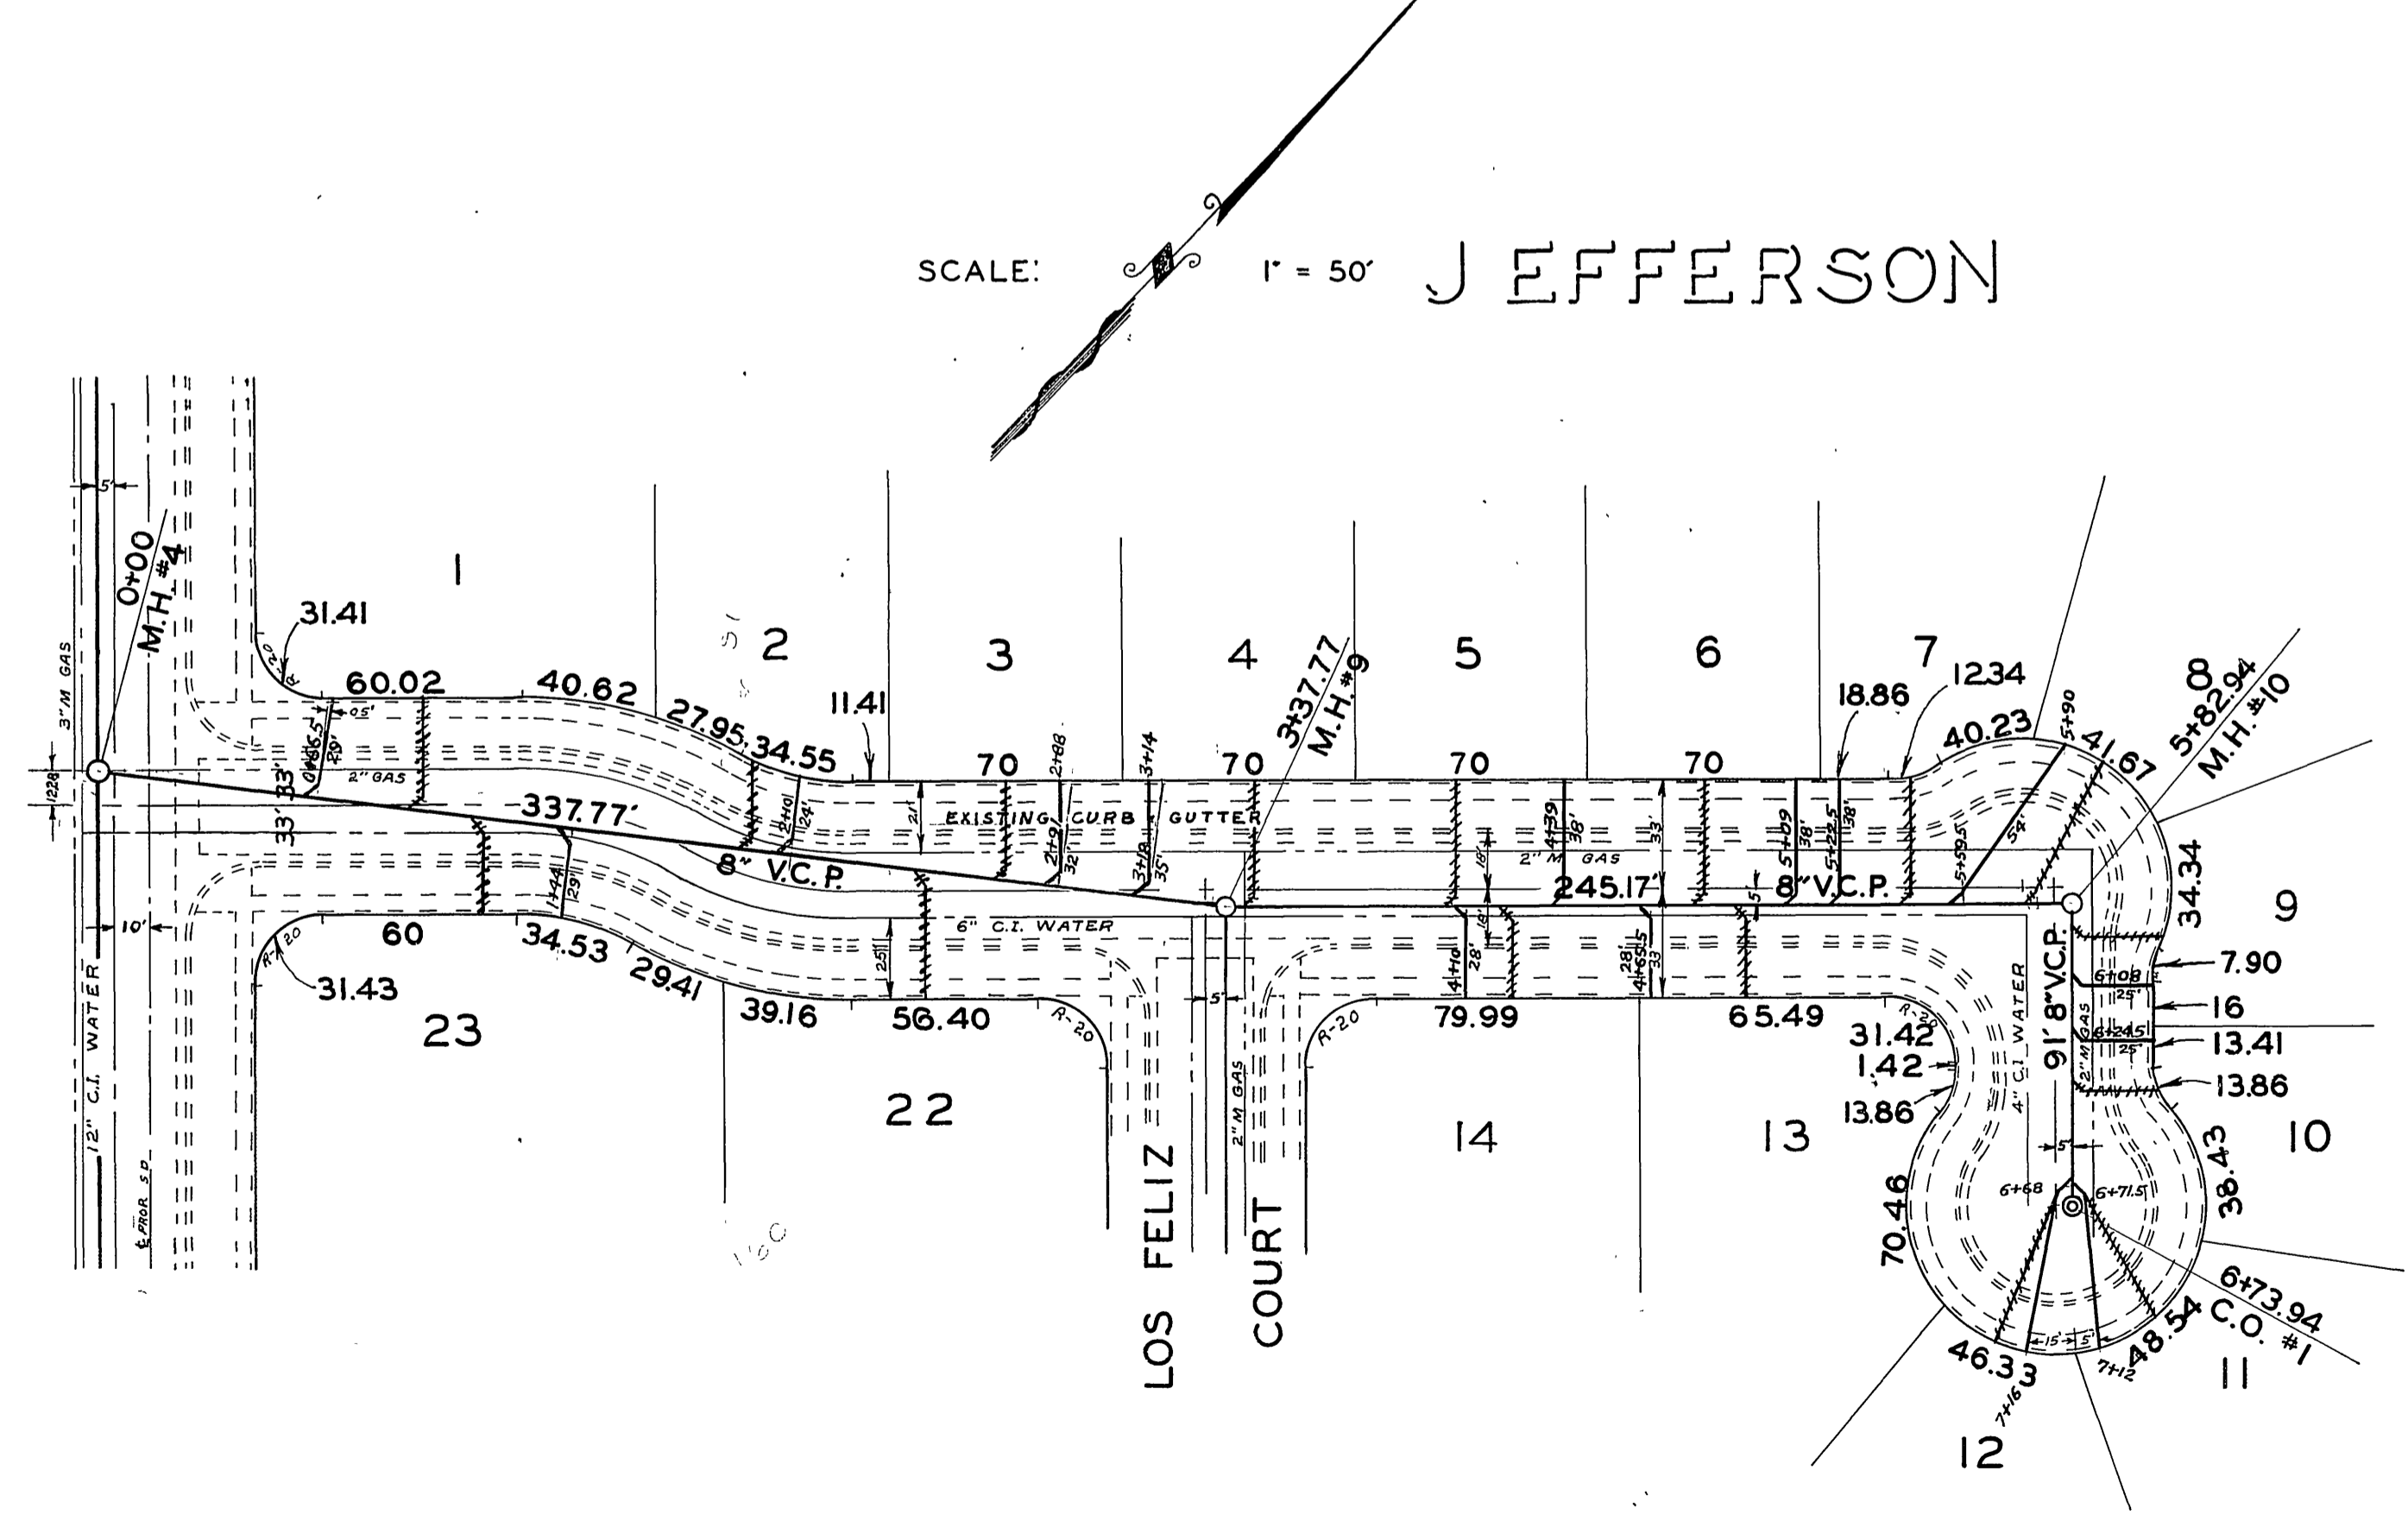


NOTE: EXACT LOCATION OF HOUSE CONNECTIONS TO BE DETERMINED IN THE FIELD.

PLAN	SURVEY	DATE
PLOTTED		
NO. 8	8	
STRUCTURE KNIP	NS	CHIBD.


REVISIONS			CITY OF RIVERSIDE CALIFORNIA DEPARTMENT OF PUBLIC WORKS	
MARK	DATE	DESCRIPTION		
	3-17-58	AS BUILT HOUSE CONNECTIONS, HAND		
			JEFFERSON - ORCHARD SANITARY SEWER DISTRICT LOS ARBOLES PLACE AND LOS FELIZ COURT	
DESIGNED BY	W.D.G.	CHECKED BY	APPROVED BY	
DRAWN BY	B.L.		 DIRECTOR OF PUBLIC WORKS	
RECOMMENDED BY		ASSISTANT CITY ENGINEER	DATE	Sept 3, 1957
			S-85	SHEET 5 OF 7

GROVE
M.B. 27/76 REC. RIV. CO.

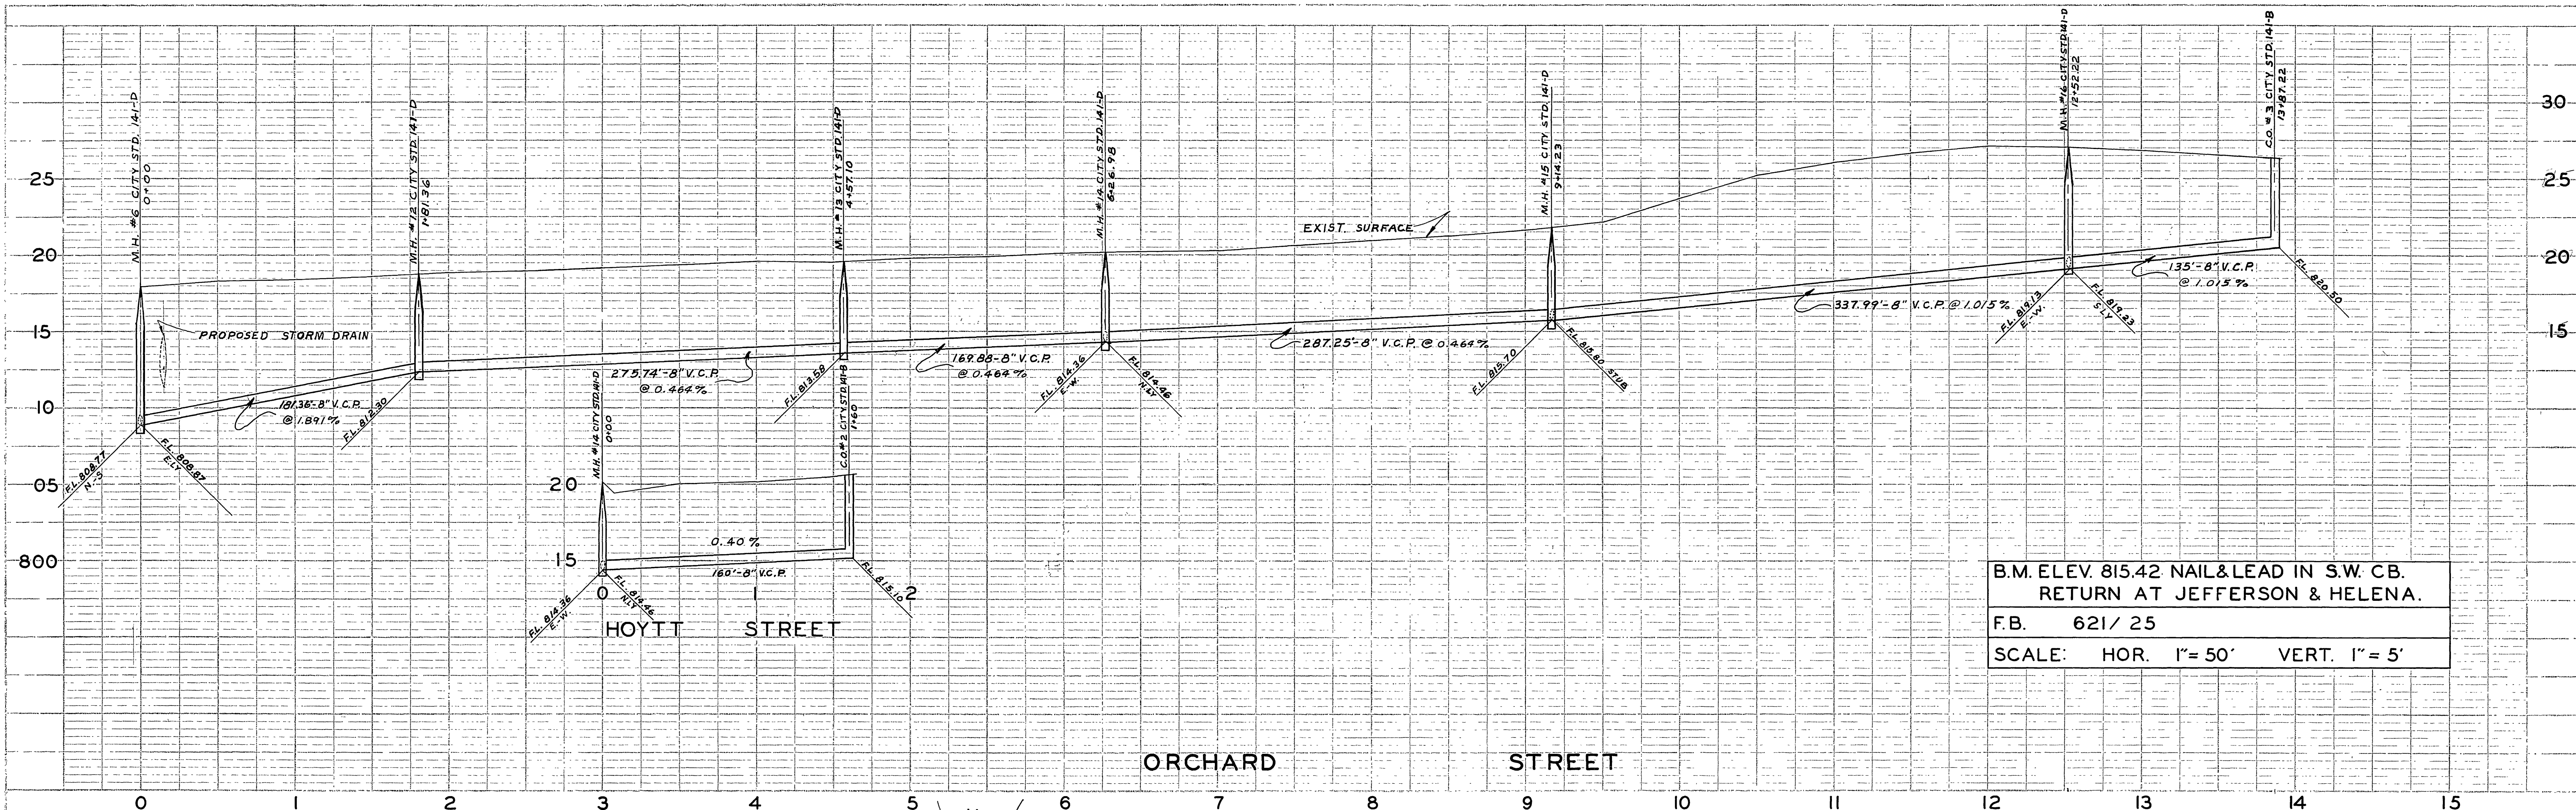

B.M. ELEV. 815.42 NAIL & LEAD IN S.W. CB.
 RETURN AT JEFFERSON & HELENA.
 F.B. 621/25
 SCALE: HOR. 1" = 50' VERT. 1" = 5'

PROFILE	DATE
PLOTTED	
NOTED	
STRUCTURE NO. 14-B	

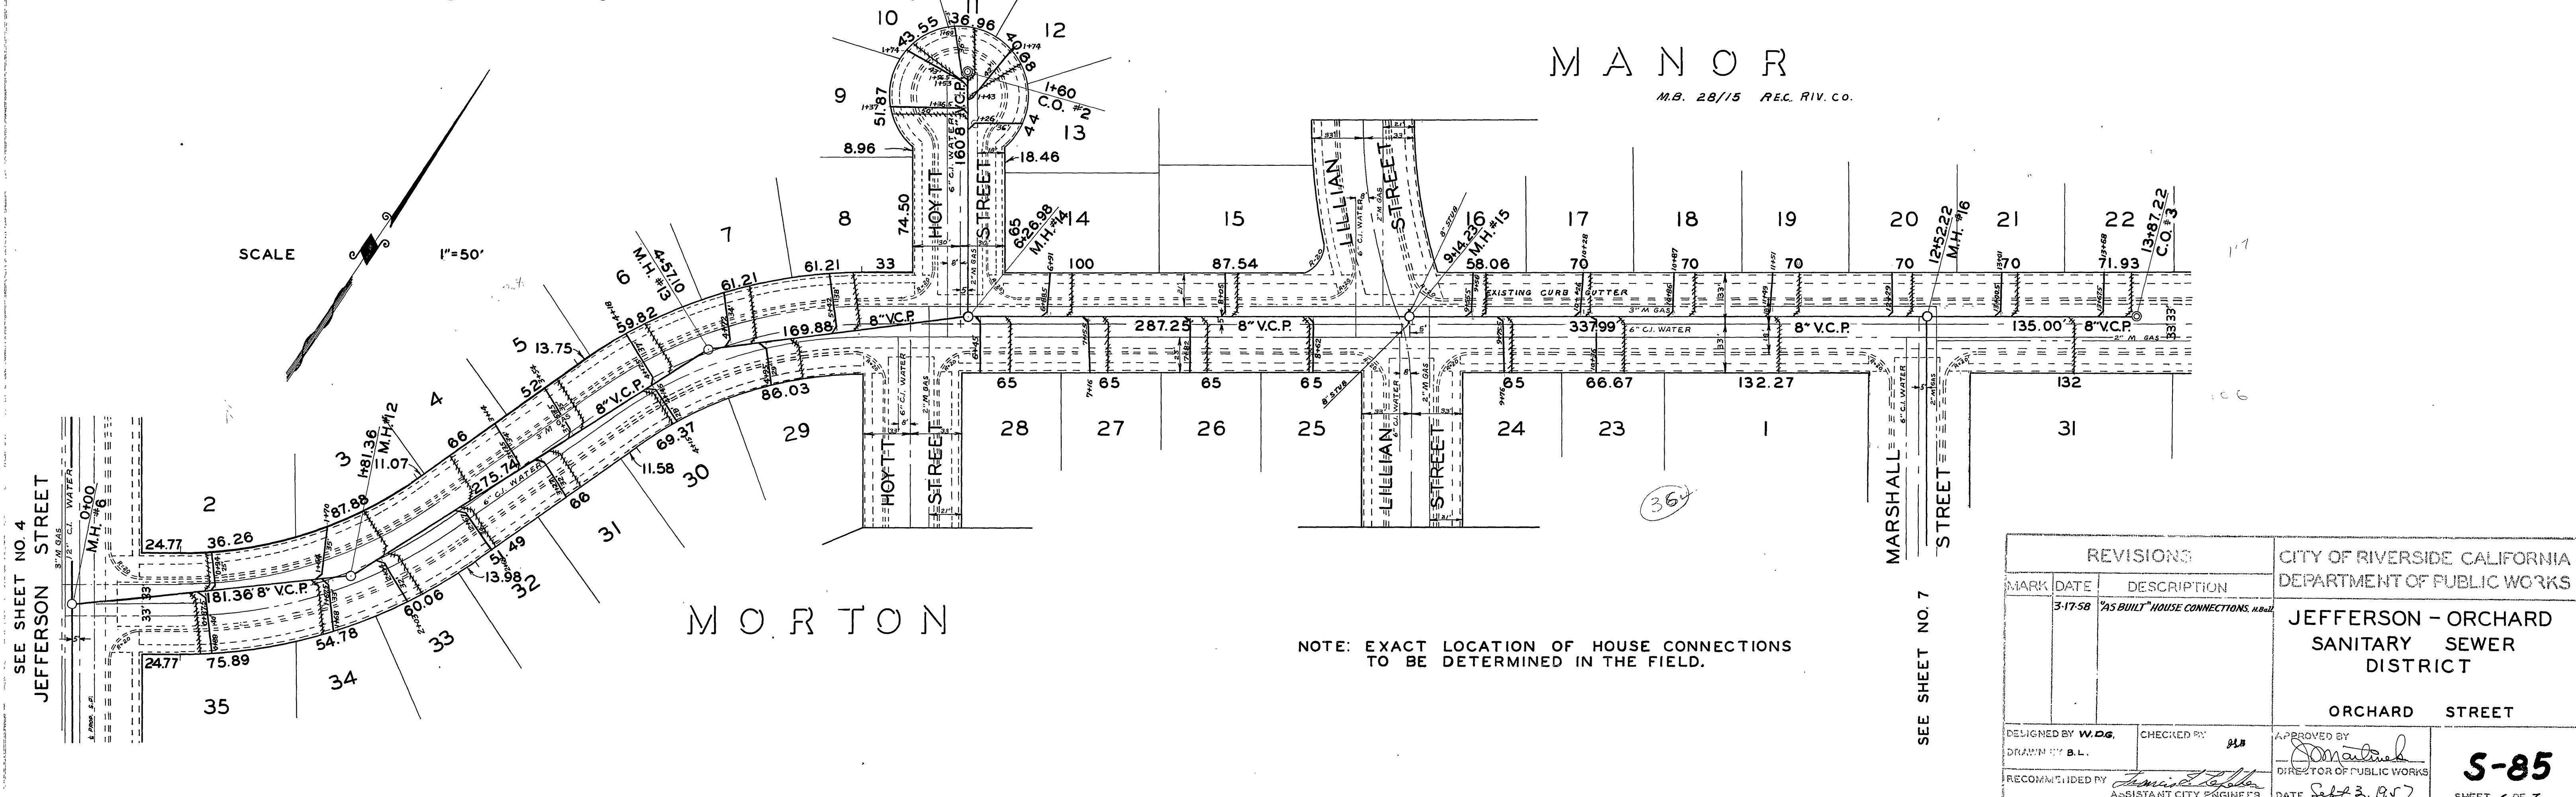

PLAN	DATE
PLOTTED	
NOTED	
STRUCTURE NO. 14-B	

REVISIONS			CITY OF RIVERSIDE CALIFORNIA DEPARTMENT OF PUBLIC WORKS
MARK	DATE	DESCRIPTION	
	3-17-58	"AS BUILT" HOUSE CONNECTIONS, n.p.d.	JEFFERSON - ORCHARD SANITARY SEWER DISTRICT

ORCHARD STREET


DESIGNED BY W.D.G.	CHECKED BY <i>W.D.G.</i>	APPROVED BY <i>W.D.G.</i>
DRAWN BY B.L.		DIRECTOR OF PUBLIC WORKS
RECOMMENDED BY <i>W.D.G.</i>	ASSISTANT CITY ENGINEER	DATE Sept 23, 1957

S-85
SHEET 6 OF 7

NOTE: EXACT LOCATION OF HOUSE CONNECTIONS TO BE DETERMINED IN THE FIELD.

SEE SHEET NO. 4
JEFFERSON STREET



SEE SHEET NO. 7

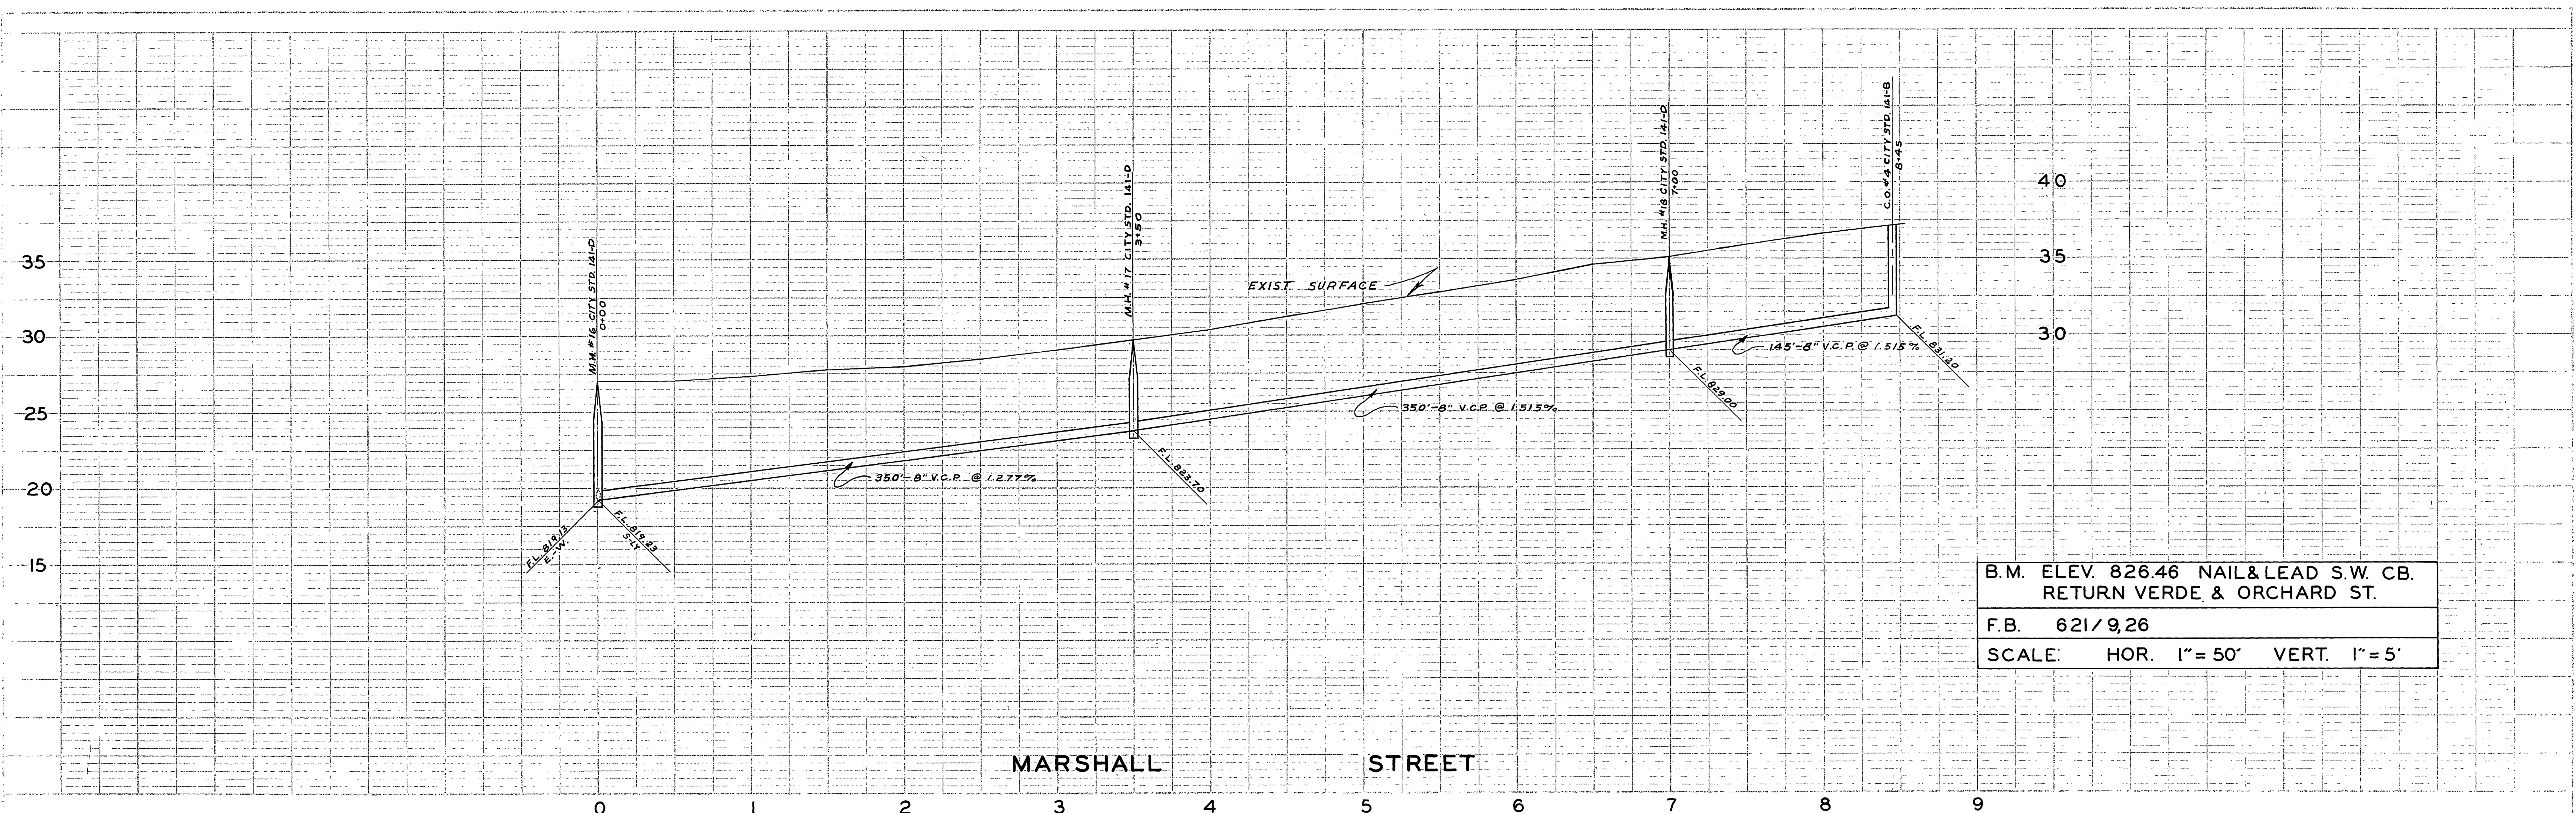

B.M. ELEV. 826.46 NAIL & LEAD S.W. CB.
RETURN VERDE & ORCHARD ST.
F.B. 621/9.26
SCALE: HOR. 1" = 50' VERT. 1" = 5'

MARSHALL STREET



G A L E T A

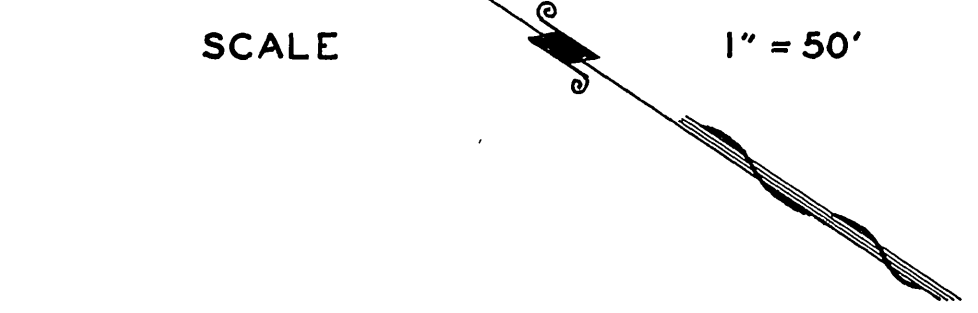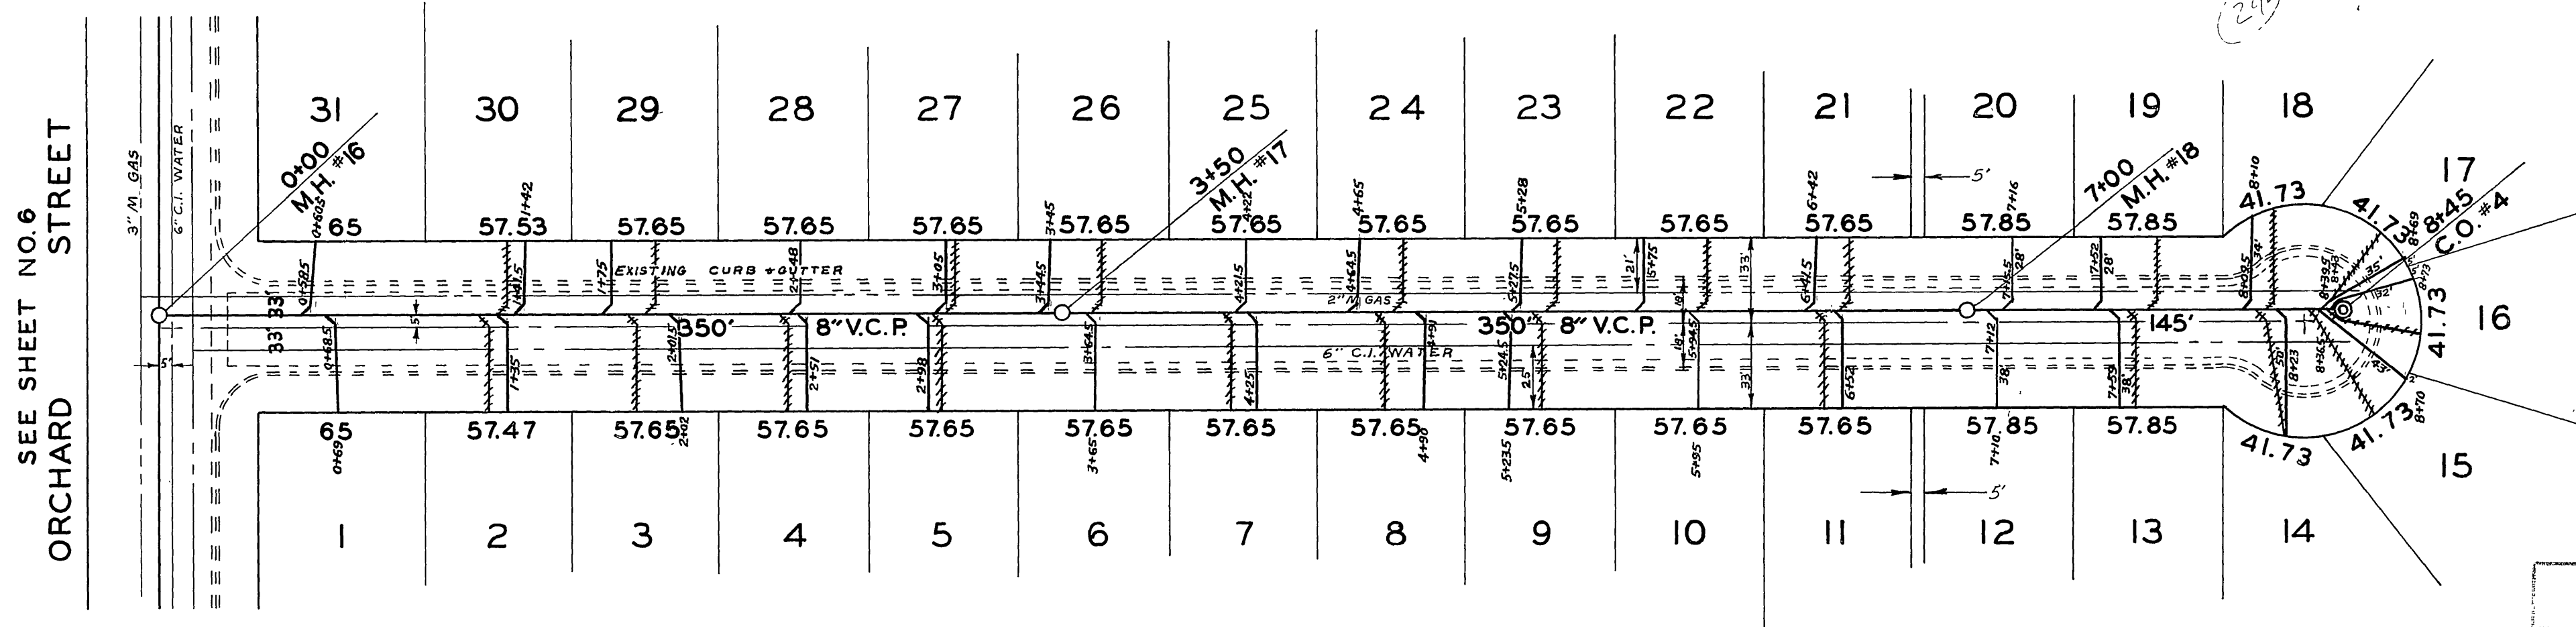

NOTE: EXACT LOCATION OF HOUSE CONNECTIONS TO BE DETERMINED IN THE FIELD.

M A N O R

M.B. 26/29 REC. RIV. CO.

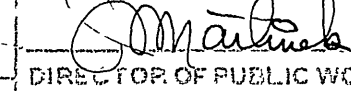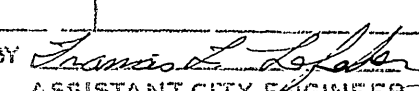REVISIONS			CITY OF RIVERSIDE CALIFORNIA DEPARTMENT OF PUBLIC WORKS
MARK	DATE	DESCRIPTION	
	3-17-58	"AS BUILT" HOUSE CONNECTIONS. H.B.M.	JEFFERSON-ORCHARD SANITARY SEWER DISTRICT MARSHALL STREET
DESIGNED BY	W.D.G.	CHECKED BY	
DRAWN BY	B.L.	APPROVED BY	 DIRECTOR OF PUBLIC WORKS
RECOMMENDED BY	 ASSISTANT CITY ENGINEER	DATE	3/23/1957 SHEET 7 OF 7

S-85

PROFILE	DESIGNED	DATE
NOTE BOOK	PLOTTED	
NO.	BY	
STRUCTURE NO.	DATE	

PLAN	DESIGNED	DATE
NOTE BOOK	PLOTTED	
NO.	BY	
STRUCTURE NO.	DATE	