


BENCH MARK:
 City B.M. 601-26-68. Bronze disk in concrete post 52' NE of Tyler & 65.5' SE of Magnolia. Elev. = 742.24

T.B.M. (This project only)
 Chiseled "□" MOC T.C. SE curb return Tyler & Hole. Elev. = 739.70

T.B.M. (This project only)
 Chiseled "□" T.C. 4' E W'ly of E'ly line Parcel 1, R.S. 21/66, 5'ly side Hole. Elev. = 747.06

* NOTE: 5" A.C. REPLACEMENT OVER NATIVE.

NOTE: All underground utilities or structures reported by the owner or others and those shown on the records examined are indicated with their approximate location and extent. The owner by accepting these plans or proceeding with improvements pursuant thereto agrees to assume liability and to hold undersigned harmless for any damages resulting from the existence of underground utilities or structures not reported to the undersigned; not indicated on the public records examined; located at variance with that reported or shown on records examined.

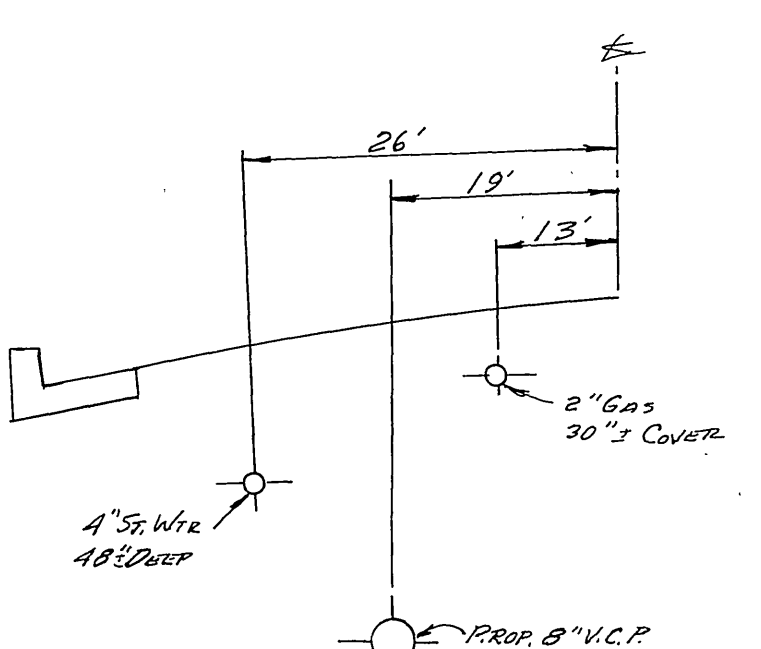

- CAUTION -
PACIFIC TELEPHONE CABLES UNDERGROUND
 BEFORE EXCAVATING

CALL COLLECT

After Hours
 7:30 A.M. to 5 P.M. & Holidays

Orange County 714-633-0811 714-547-6606
 Riverside County 714-684-0071 714-547-6606
 Inyo County 714-684-0071 714-547-6606
 San Bernardino County 714-684-0071 714-547-6606
 Los Angeles County 213-621-3111
 Ventura County 213-621-3111
 San Diego County 714-798-0595 714-232-0027

FOR FREE CABLE LOCATING SERVICE

J.F.D. REFERENCE
 SEWER PLAN # 2737

J. F. DAVIDSON ASSOCIATES
 CIVIL ENGINEERS - SURVEYORS - PLANNERS
 RIVERSIDE, CALIFORNIA

APPROVED BY: *Robert S. Davidson* DATE: 4-27-72
 R.E. No. 13623 11

W.O. 3300 FOR DAVID JAMESON F.S. 10/2/72

CITY OF RIVERSIDE, CALIFORNIA
 DEPARTMENT OF PUBLIC WORKS

APPROVED BY: *David Jameson* DATE: 5-23-72
 OFFICE ENGINEER
 PARK DEPARTMENT
 TRAFFIC DIVISION
 ASSISTANT CITY ENGINEER

DATE: May 15, 1972

SEWER PLAN & PROFILE
 HOLE AVENUE
 SEWER EXTENSION

From Tyler Street to 640' Easterly

C-29-712

HORIZ. SCALE: 1" = 40' VERT. SCALE: 1" = 4'

PROJECT NO. S-881
 SHEET 1 OF 1
 FILE NO. 4429

* AS BUILT KARL 12/15/72