


GENERAL NOTES

1. CONSTRUCTION SHALL BE IN ACCORDANCE WITH THE STANDARD SPECIFICATIONS FOR PUBLIC WORKS CONSTRUCTION, 1970 EDITION AND STANDARD DRAWINGS.
2. IT SHALL BE THE RESPONSIBILITY OF THE CONTRACTOR TO CLEAR THE RIGHT OF WAY IN ACCORDANCE WITH THE PROVISIONS OF THE LAW AS IT AFFECTS EACH UTILITY INCLUDING IRRIGATION LINES & APPURTENANCES AT NO COST TO THE CITY.

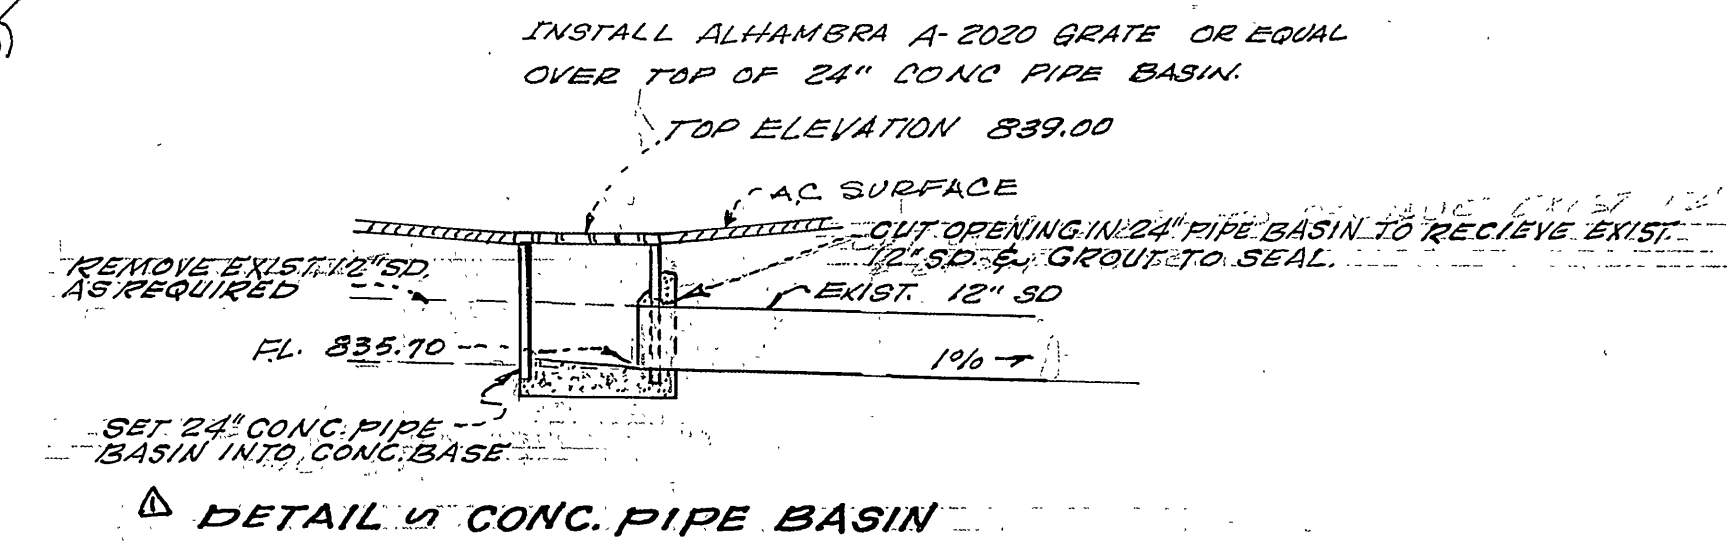

BENCH MARK 16-G
 F.P. BRASS DISK STAMPED "16-G" CAPPED AT THE
 INTERSECTION OF MARKET ST. & 14TH ST.
 F.B. 735/68 ELEV. 834.134

HAWKINS, ROBERTSON & ASSOC. ENGINEERS & SURVEYORS RIVERSIDE, CALIFORNIA <i>Charles E. Robertson</i> R.C.E. 15016 DATE 4-28-72		CITY OF RIVERSIDE, CALIFORNIA DEPARTMENT OF PUBLIC WORKS APPROVED BY: <i>William B. Dandrea</i> OFFICE ENGINEER PARK DEPARTMENT TRAFFIC DIVISION ASSISTANT CITY ENG.		SEWER PLAN & PROFILE ALLEY (REVISION) FROM 13TH ST. TO 12TH ST. BETWEEN MAIN ST. & ORANGE ST. PROJECT NO. 5-884 SHEET 1 OF 1 DATE 11/7/72 HORIZ. SCALE: 1" = 40' VERT. SCALE: 1" = 4'	
FOR: A SERVICE GARAGE FOR COUNTY OF RIVERSIDE DESIGNED BY G.H. DRAWN BY G.H. CHECKED BY LL.		APPROVED BY: <i>William B. Dandrea</i> DIRECTOR OF PUBLIC WORKS DATE 11/7/72		FILE NO. 72-2231	