

Scale:  
 Horiz. 1" = 40'  
 Vert. 1" = 4'

LOT 1 BLOCK 75  
 ARLINGTON HEIGHTS  
 M.B. 11/20-21



LOT 3 BLOCK 75  
 ARLINGTON HEIGHTS  
 M.B. 11/20-21

LOT 8  
 TRACT NO. 2564  
 M.B. 45/73-74

LOT 4 BLOCK 75  
 ARLINGTON HEIGHTS  
 M.B. 11/20-21

**GENERAL NOTES**

1. Construction Shall Be In Accordance With The Standard Specifications For Public Works Construction, 1970 Edition And Standard Drawings.
2. Pipe Shall Be Bedded Per Case I Standard Drawing No. 452.
3. All Manholes To Be Constructed Per Standard Drawing No. 500.
4. Prior To Trenching, The Contractor Is To Uncover Existing Sewer Pipe And Contact The Engineer To Verify The Existing Elevation.

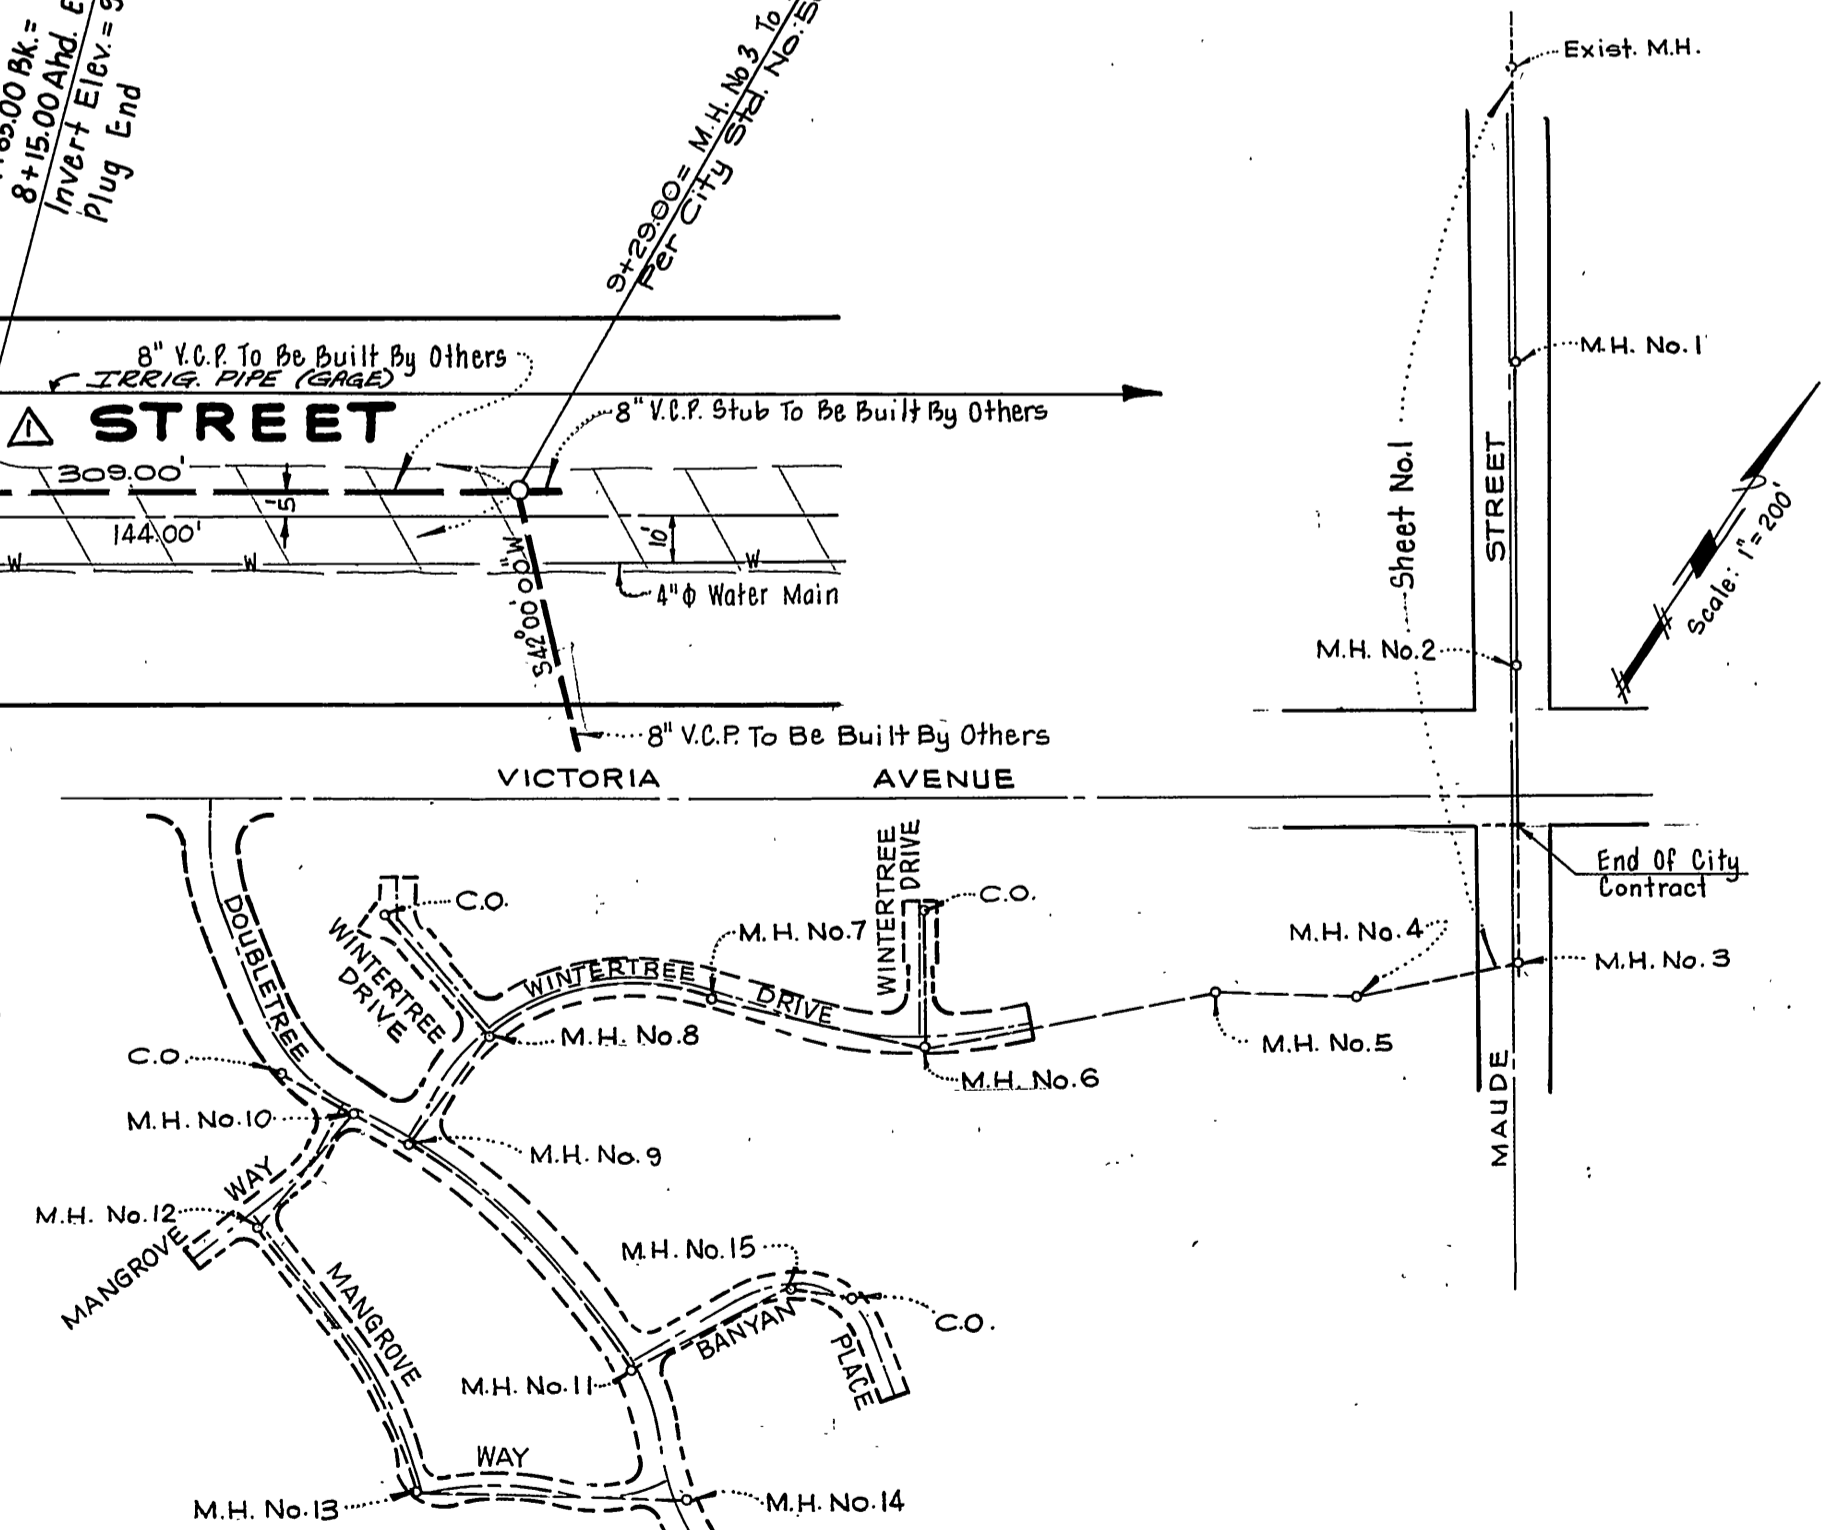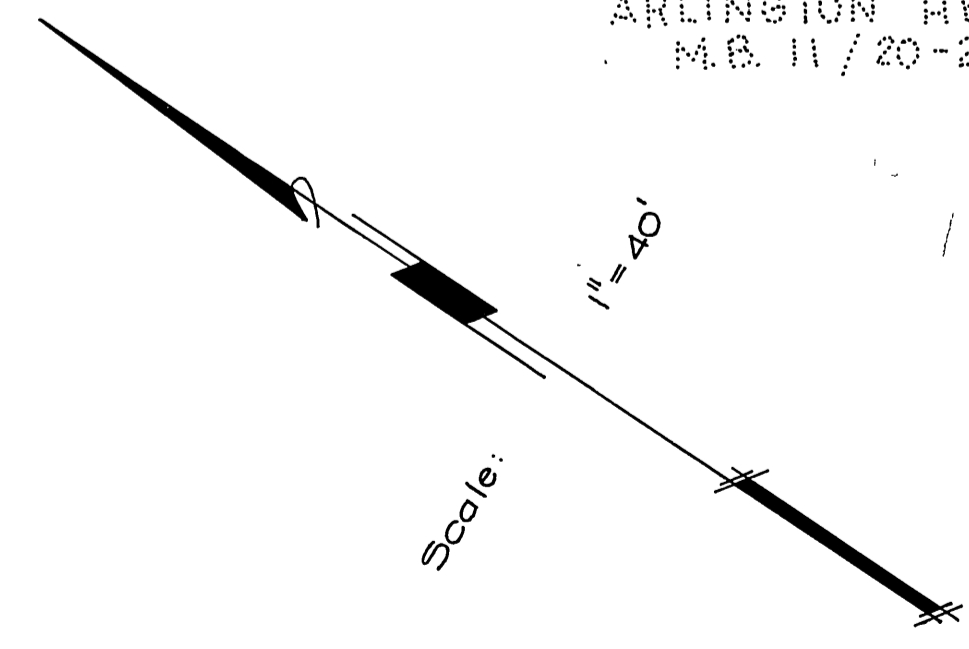

APPROVED BY  
*Howard P. ...* 3-14-73  
 CHIEF WATER UTILITY ENGINEER

FRANK TRACADAS R.C.E. 11447

CORNER, TRACADAS & TROY INC  
 CIVIL ENGINEERING  
 LAND SURVEYING  
 357 WEST SECOND STREET  
 SAN BERNARDINO, CALIFORNIA

MARK	REVISIONS	DATE
Δ	BASE CANAL ...	4-24-73
Δ	...	...
Δ	...	...

CITY OF RIVERSIDE, CALIFORNIA  
 DEPARTMENT OF PUBLIC WORKS

APPROVED BY  
 OFFICE ENGINEER  
 PARK DEPARTMENT  
 TRAFFIC DIVISION  
 ASSIST. CITY ENG.

SEWER PLAN & PROFILE  
 MAUDE STREET  
 SEWER EXTENSION  
 FOR TRACT NO. 4702-1

HORIZ. SCALE: 1" = 40' VERT. SCALE: 1" = 4'

PROJECT NO.  
 5-926

SHEET 1 OF 1

FILE NO.