



F.B. 967-43
 ELEV. 742.23
 B.M. 63-A-32. DISK STAMPED
 63-A AT INTERSECTION OF
 VAN BUREN AND COLORADO

GENERAL NOTES


1. CONSTRUCTION TO BE IN ACCORDANCE WITH STANDARD SPECIFICATIONS FOR PUBLIC WORKS CONSTRUCTION 1973 EDITION.
2. THE FOLLOWING STANDARD DRAWINGS APPLY:
 NO. 500 FOR MANHOLES
 NO. 540 FOR FRAME AND COVER
 NO. 452 FOR PIPE BEDDING
 NO. 453 FOR TRENCH BACKFILL
 NO. 562 FOR SEWER LATERALS
3. THIS PLAN SHOWS ONE LATERAL FOR EACH LOT. CONTRACTOR SHALL DETERMINE EXACT LOCATION OF ALL AFFECTED LATERALS.

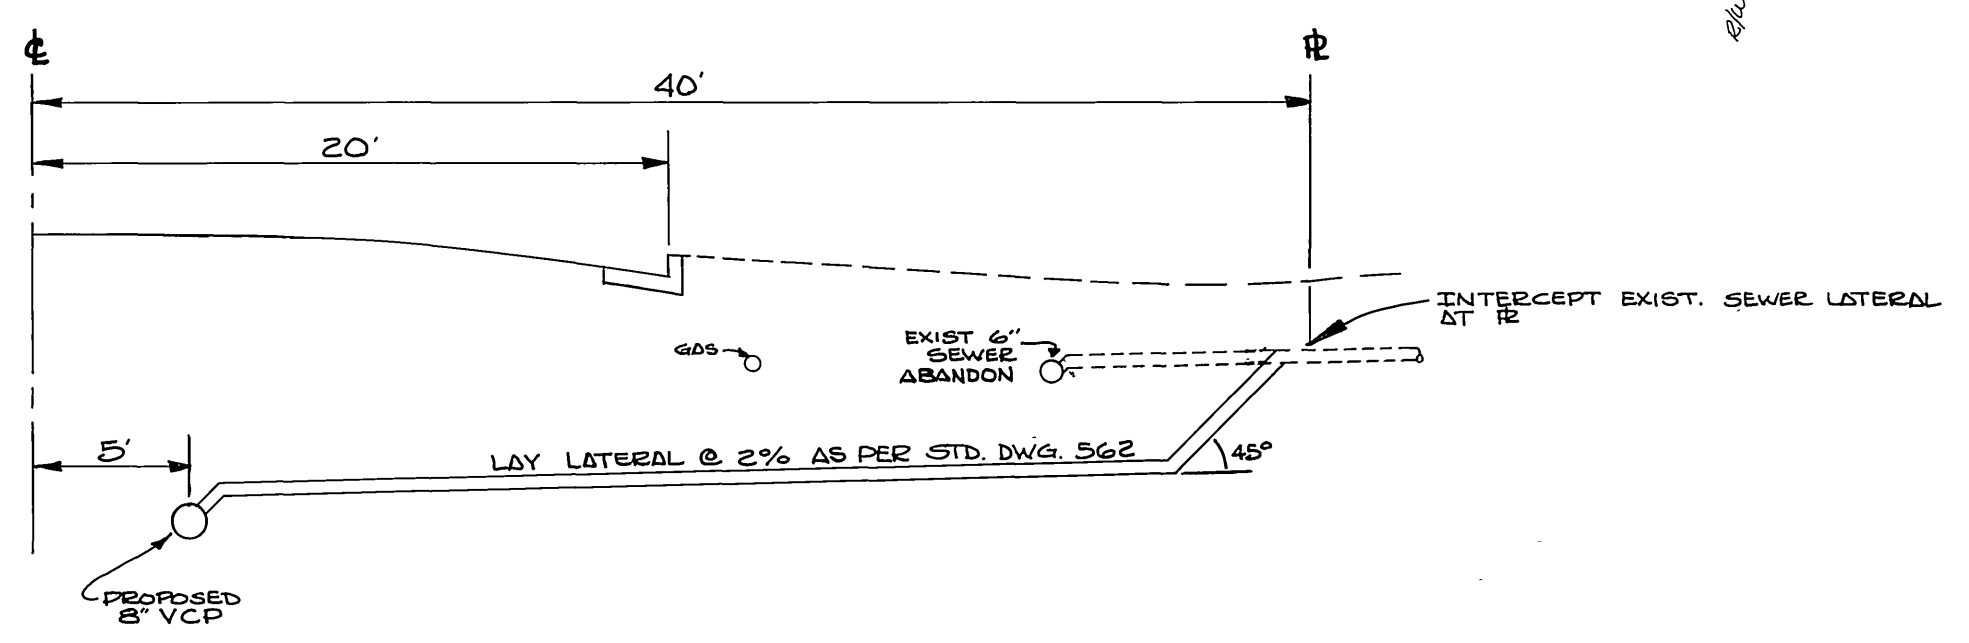

TYPICAL LATERAL CONSTRUCTION
 SCALE - 1" = 6'

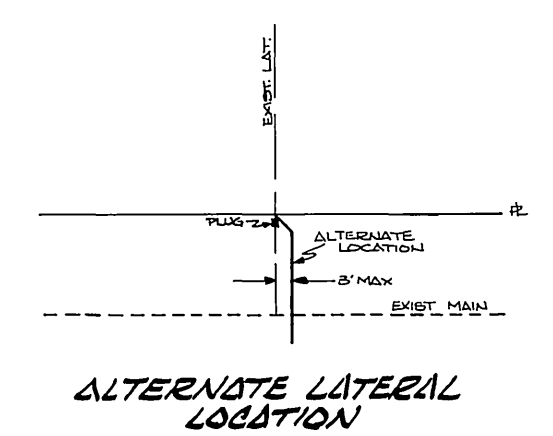


CITY OF RIVERSIDE, CALIFORNIA PUBLIC WORKS DEPARTMENT		PHILBIN AVENUE SEWER CORWIN LANE (SOUTH) TO MONTGOMERY STREET (NORTH)		ACCOUNT No. 32-577-590 DRAWING NUMBER 5-944 SHEET 1 OF 1
DESIGNED BY: <i>lms</i> DRAWN BY: <i>zab</i> CHECKED BY:	REVISIONS APPR. DATE	APPROVED BY: <i>[Signature]</i> PRINCIPAL ENGINEER PARK DEPARTMENT TRAFFIC DIVISION CHIEF PUB. WKS. ENGR.	BY DATE: 9/13 DATE: 10-16-73	HORIZ. SCALE: 1" = 20' VERT. SCALE: 1" = 2'

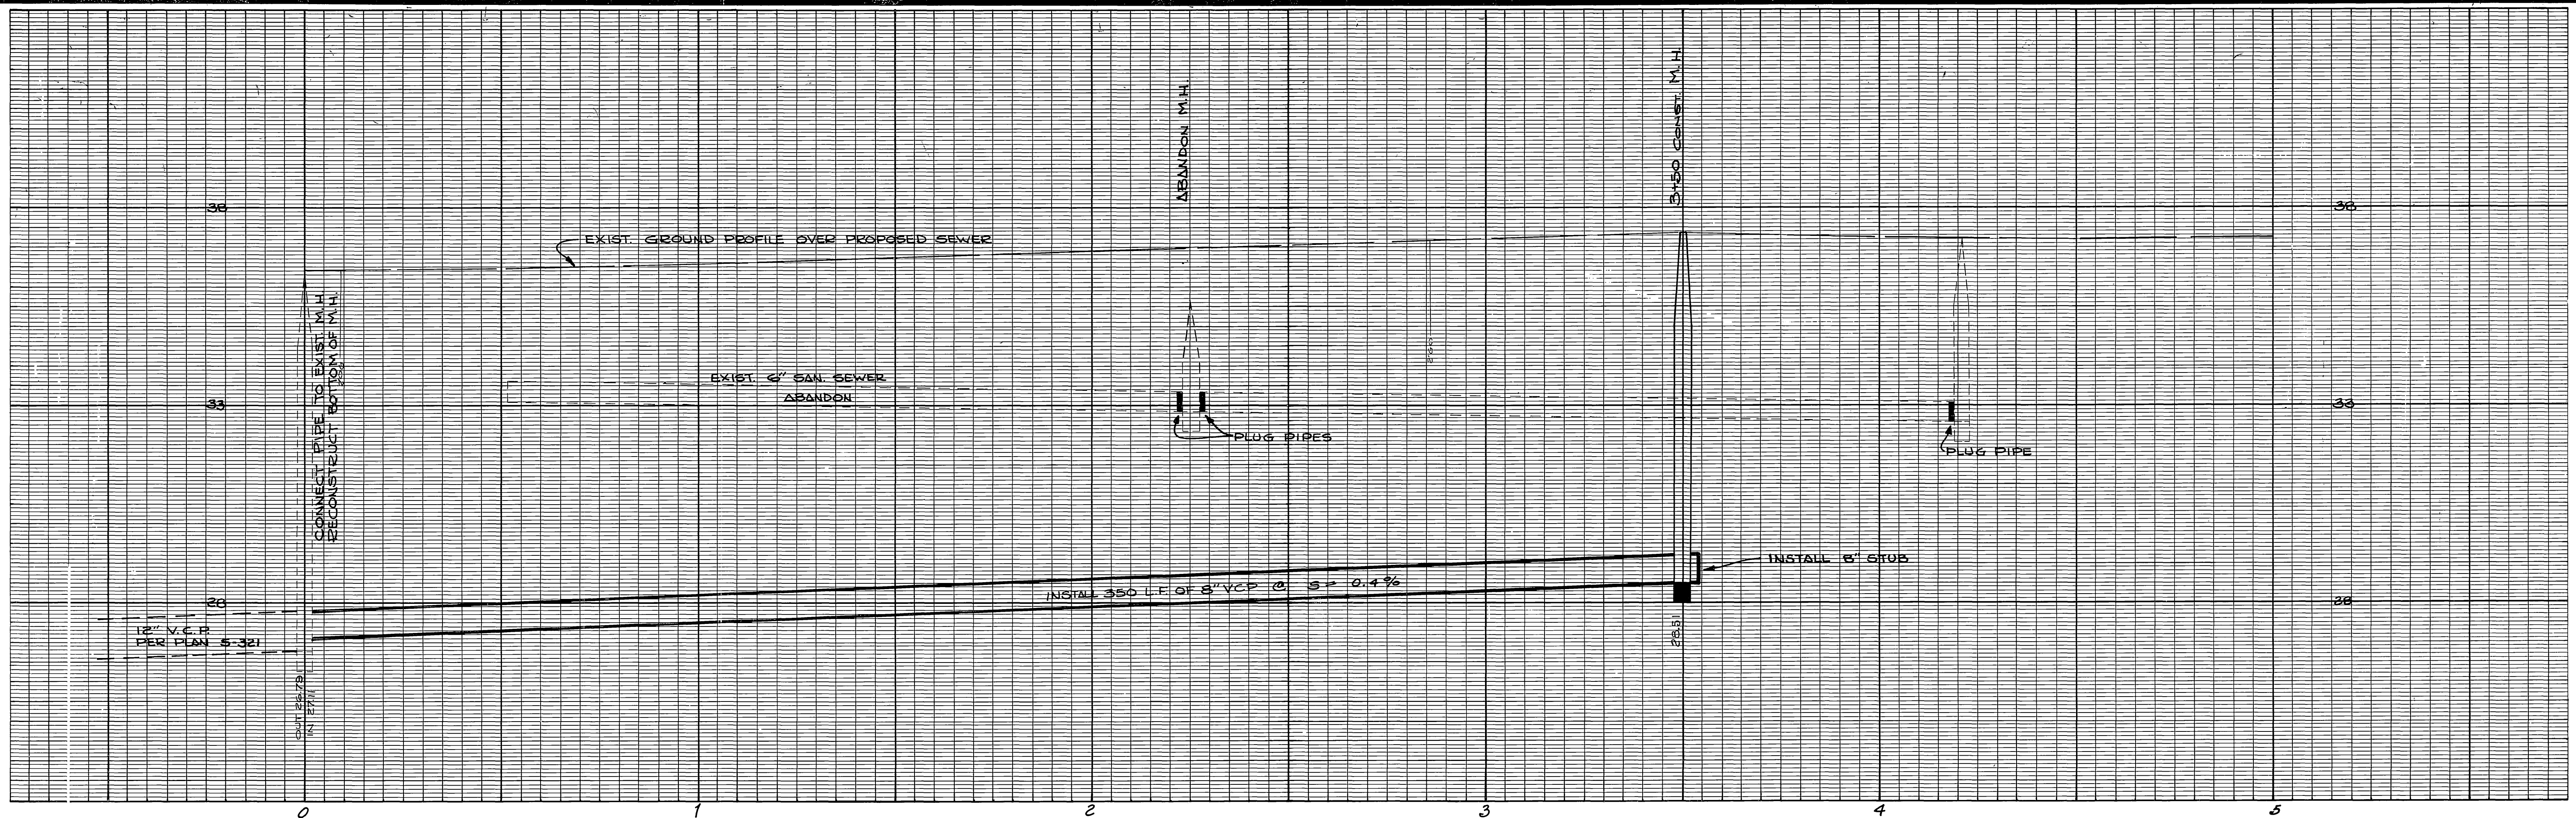


FB. 567-43
 ELEV. 742.23
 B.M. 63-A BE. DISK STAMPED
 63-A AT INTERSECTION OF
 VAN BUREN AND COLORADO

GENERAL NOTES

- CONSTRUCTION TO BE IN ACCORDANCE WITH STANDARD SPECIFICATIONS FOR PUBLIC WORKS CONSTRUCTION 1973 EDITION.
- THE FOLLOWING STANDARD DRAWINGS APPLY:
 NO. 500 FOR MANHOLES
 NO. 540 FOR FRAME AND COVER
 NO. 452 FOR PIPE BEDDING
 NO. 453 FOR TRENCH BACKFILL
 NO. 562 FOR SEWER LATERALS
- THIS PLAN SHOWS ONE LATERAL FOR EACH LOT. CONTRACTOR SHALL DETERMINE EXACT LOCATION OF ALL AFFECTED LATERALS.

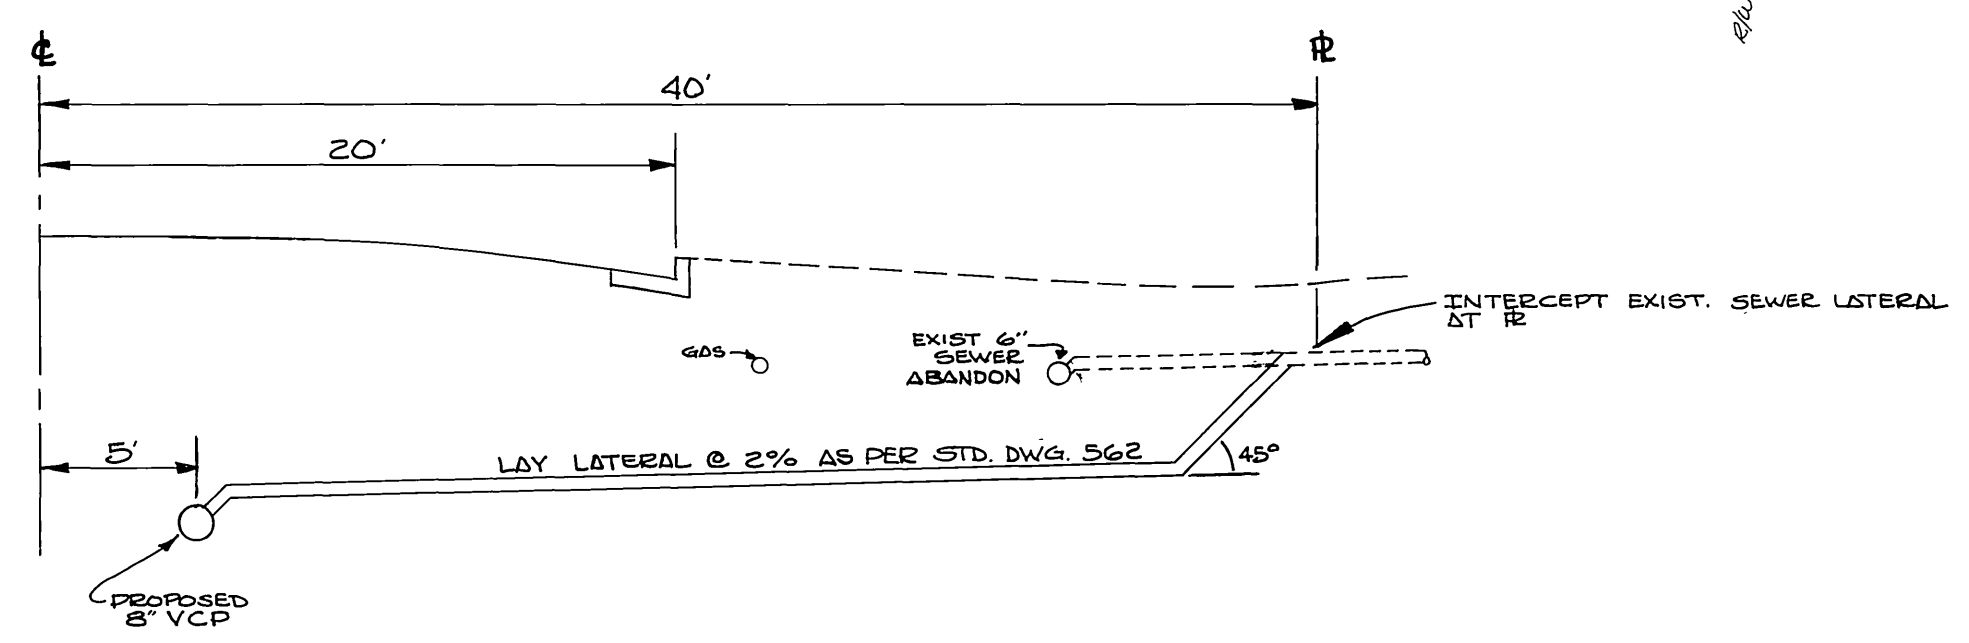

TYPICAL LATERAL CONSTRUCTION
 SCALE - 1" = 6'

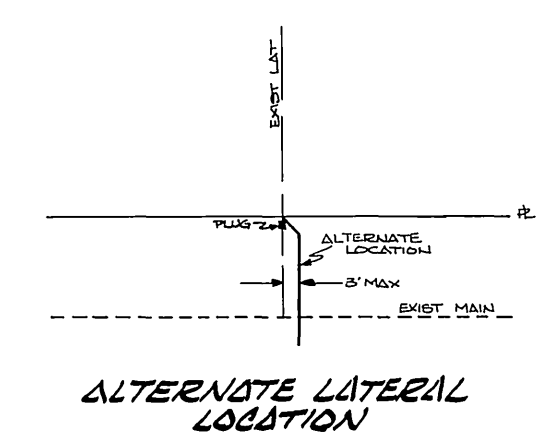

ALTERNATE LATERAL LOCATION *AS BUILT LBS 1-74

CITY OF RIVERSIDE, CALIFORNIA PUBLIC WORKS DEPARTMENT		PHILBIN AVENUE SEWER		ACCOUNT No. 32-577-590
APPROVED BY: [Signature] DATE: 10/13/73		APPROVED BY: [Signature] DATE: 10-16-73		DRAWING NUMBER: S-944
PRINCIPAL ENGINEER		DIRECTOR OF PUBLIC WORKS		SHEET 1 OF 1
TRAFFIC DIVISION		DATE: 10-16-73		HORIZ. SCALE: 1" = 20'
DESIGNED BY: [Signature]		DRAWN BY: [Signature]		VERT. SCALE: 1" = 2'

