
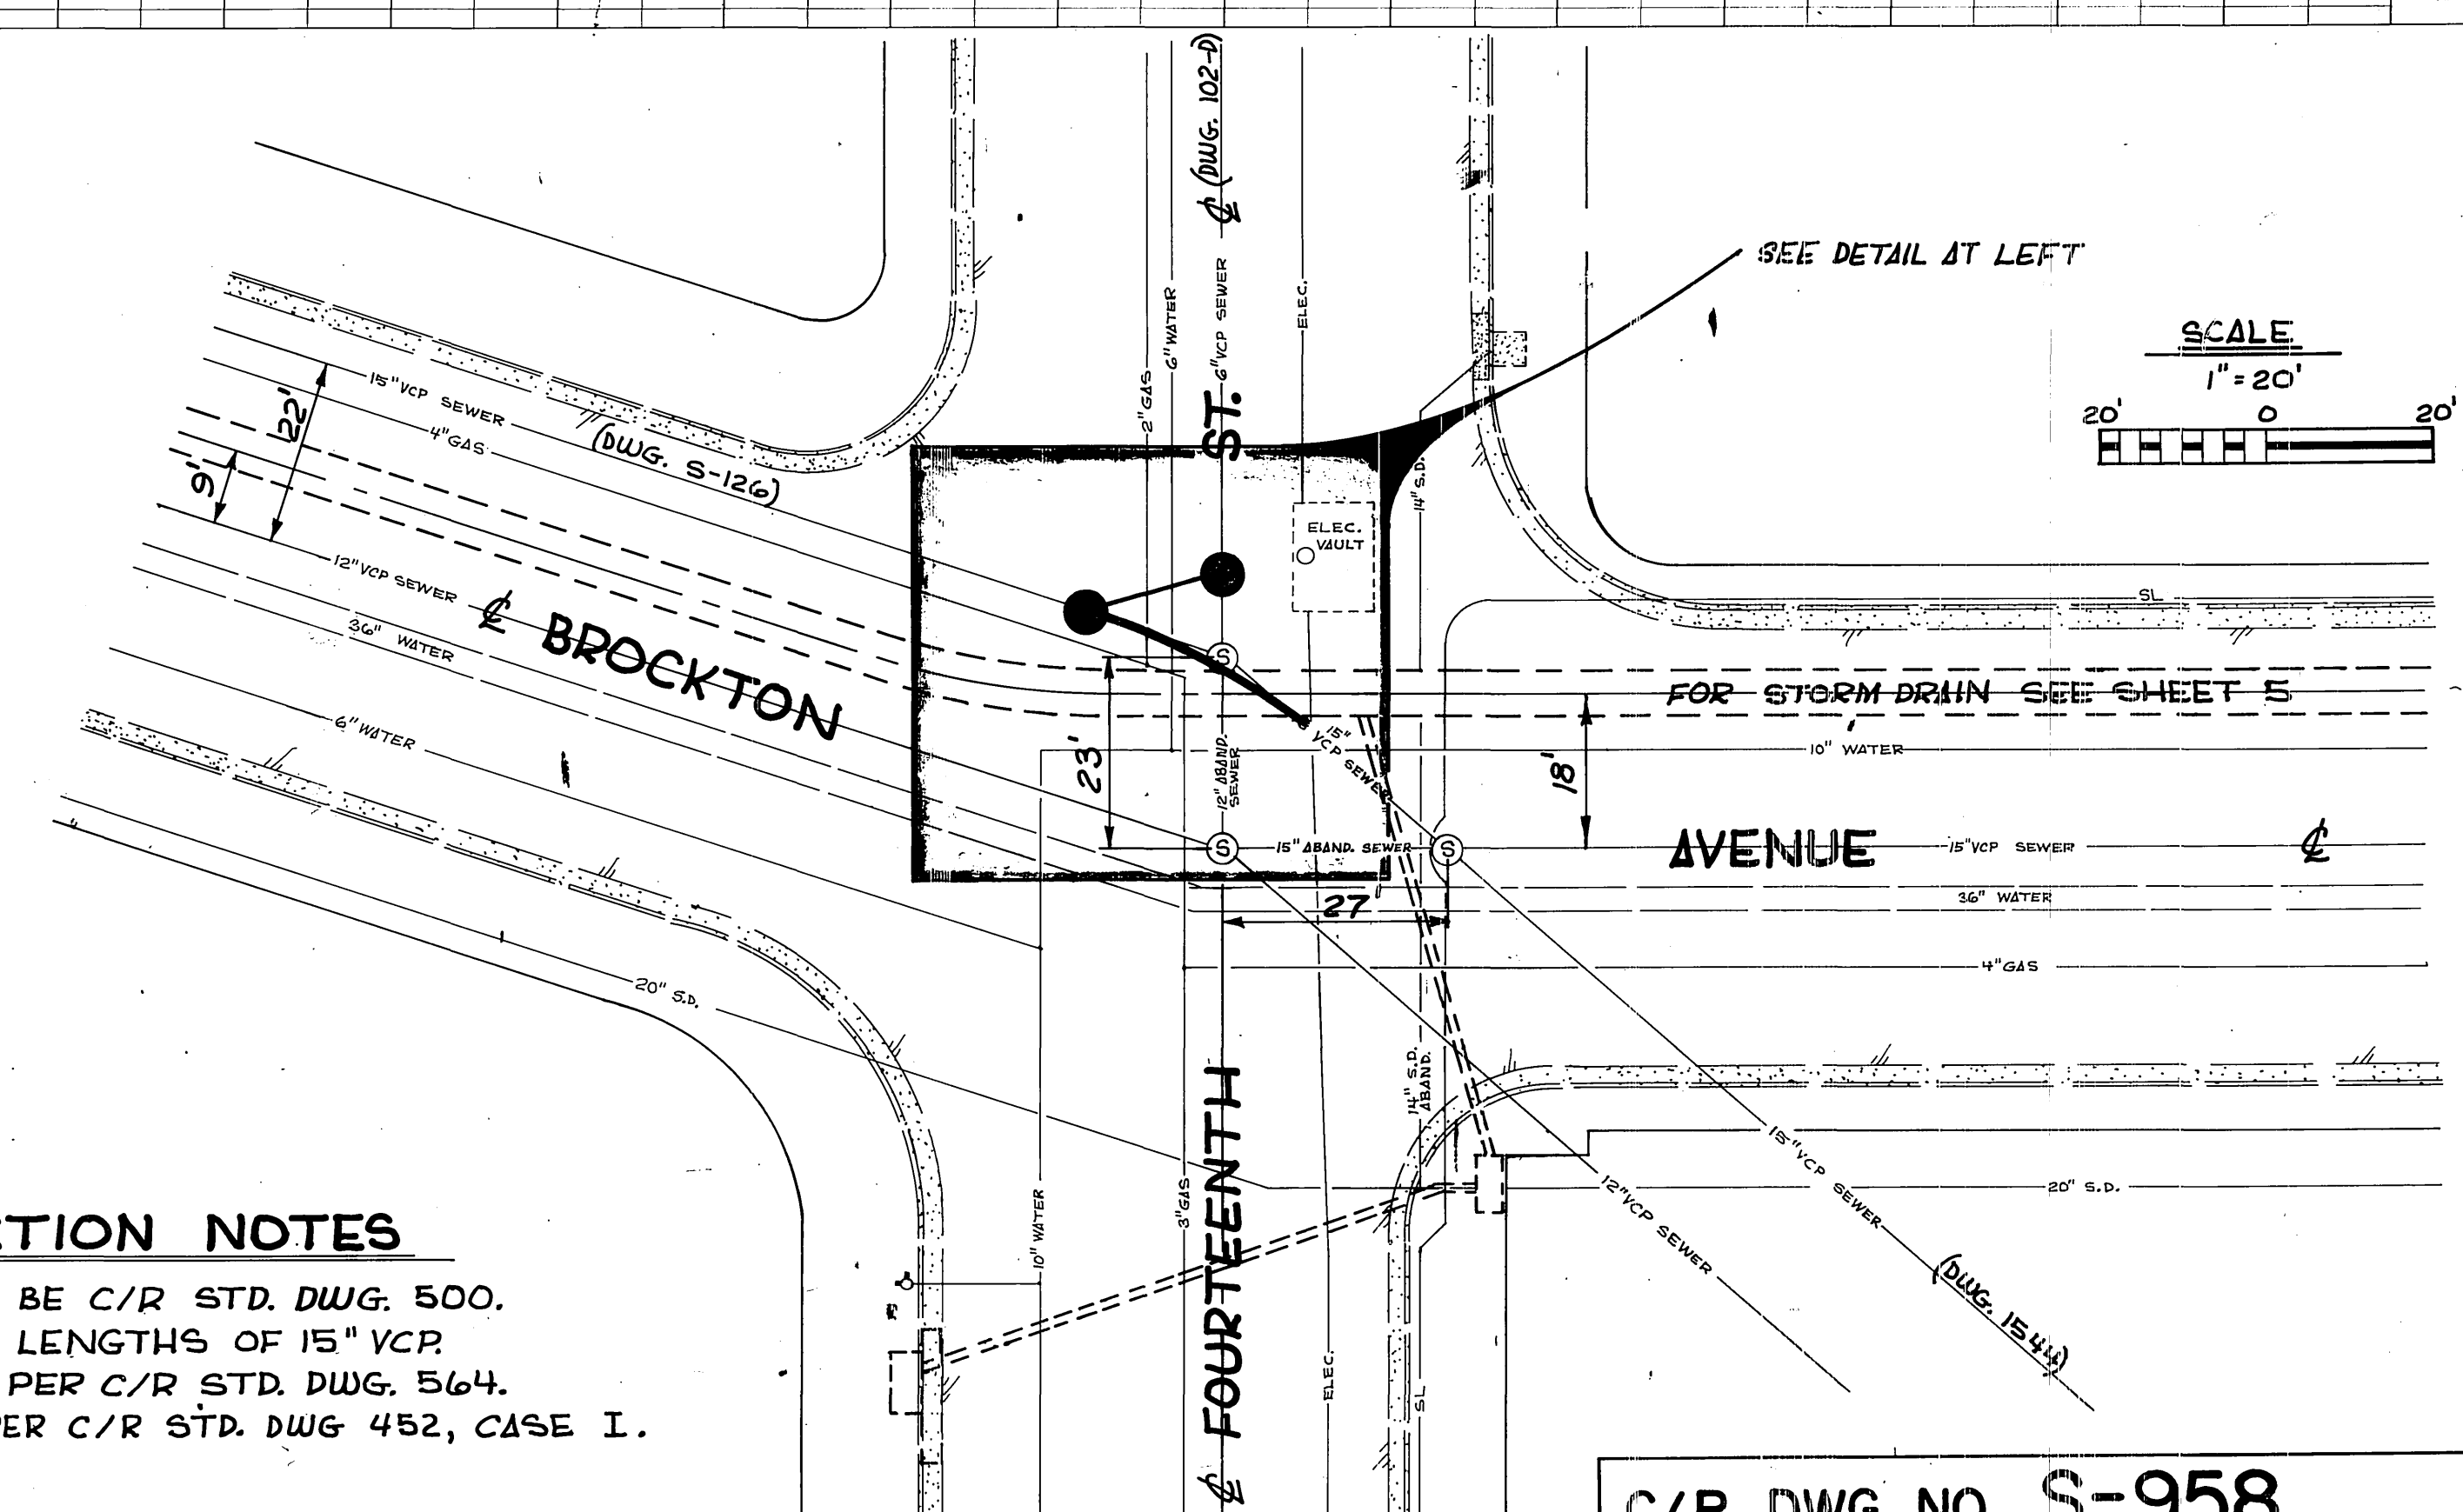


CURVE DATA

R =	86.00'
Δ =	22°18'
T =	16.95'
L =	33.48'

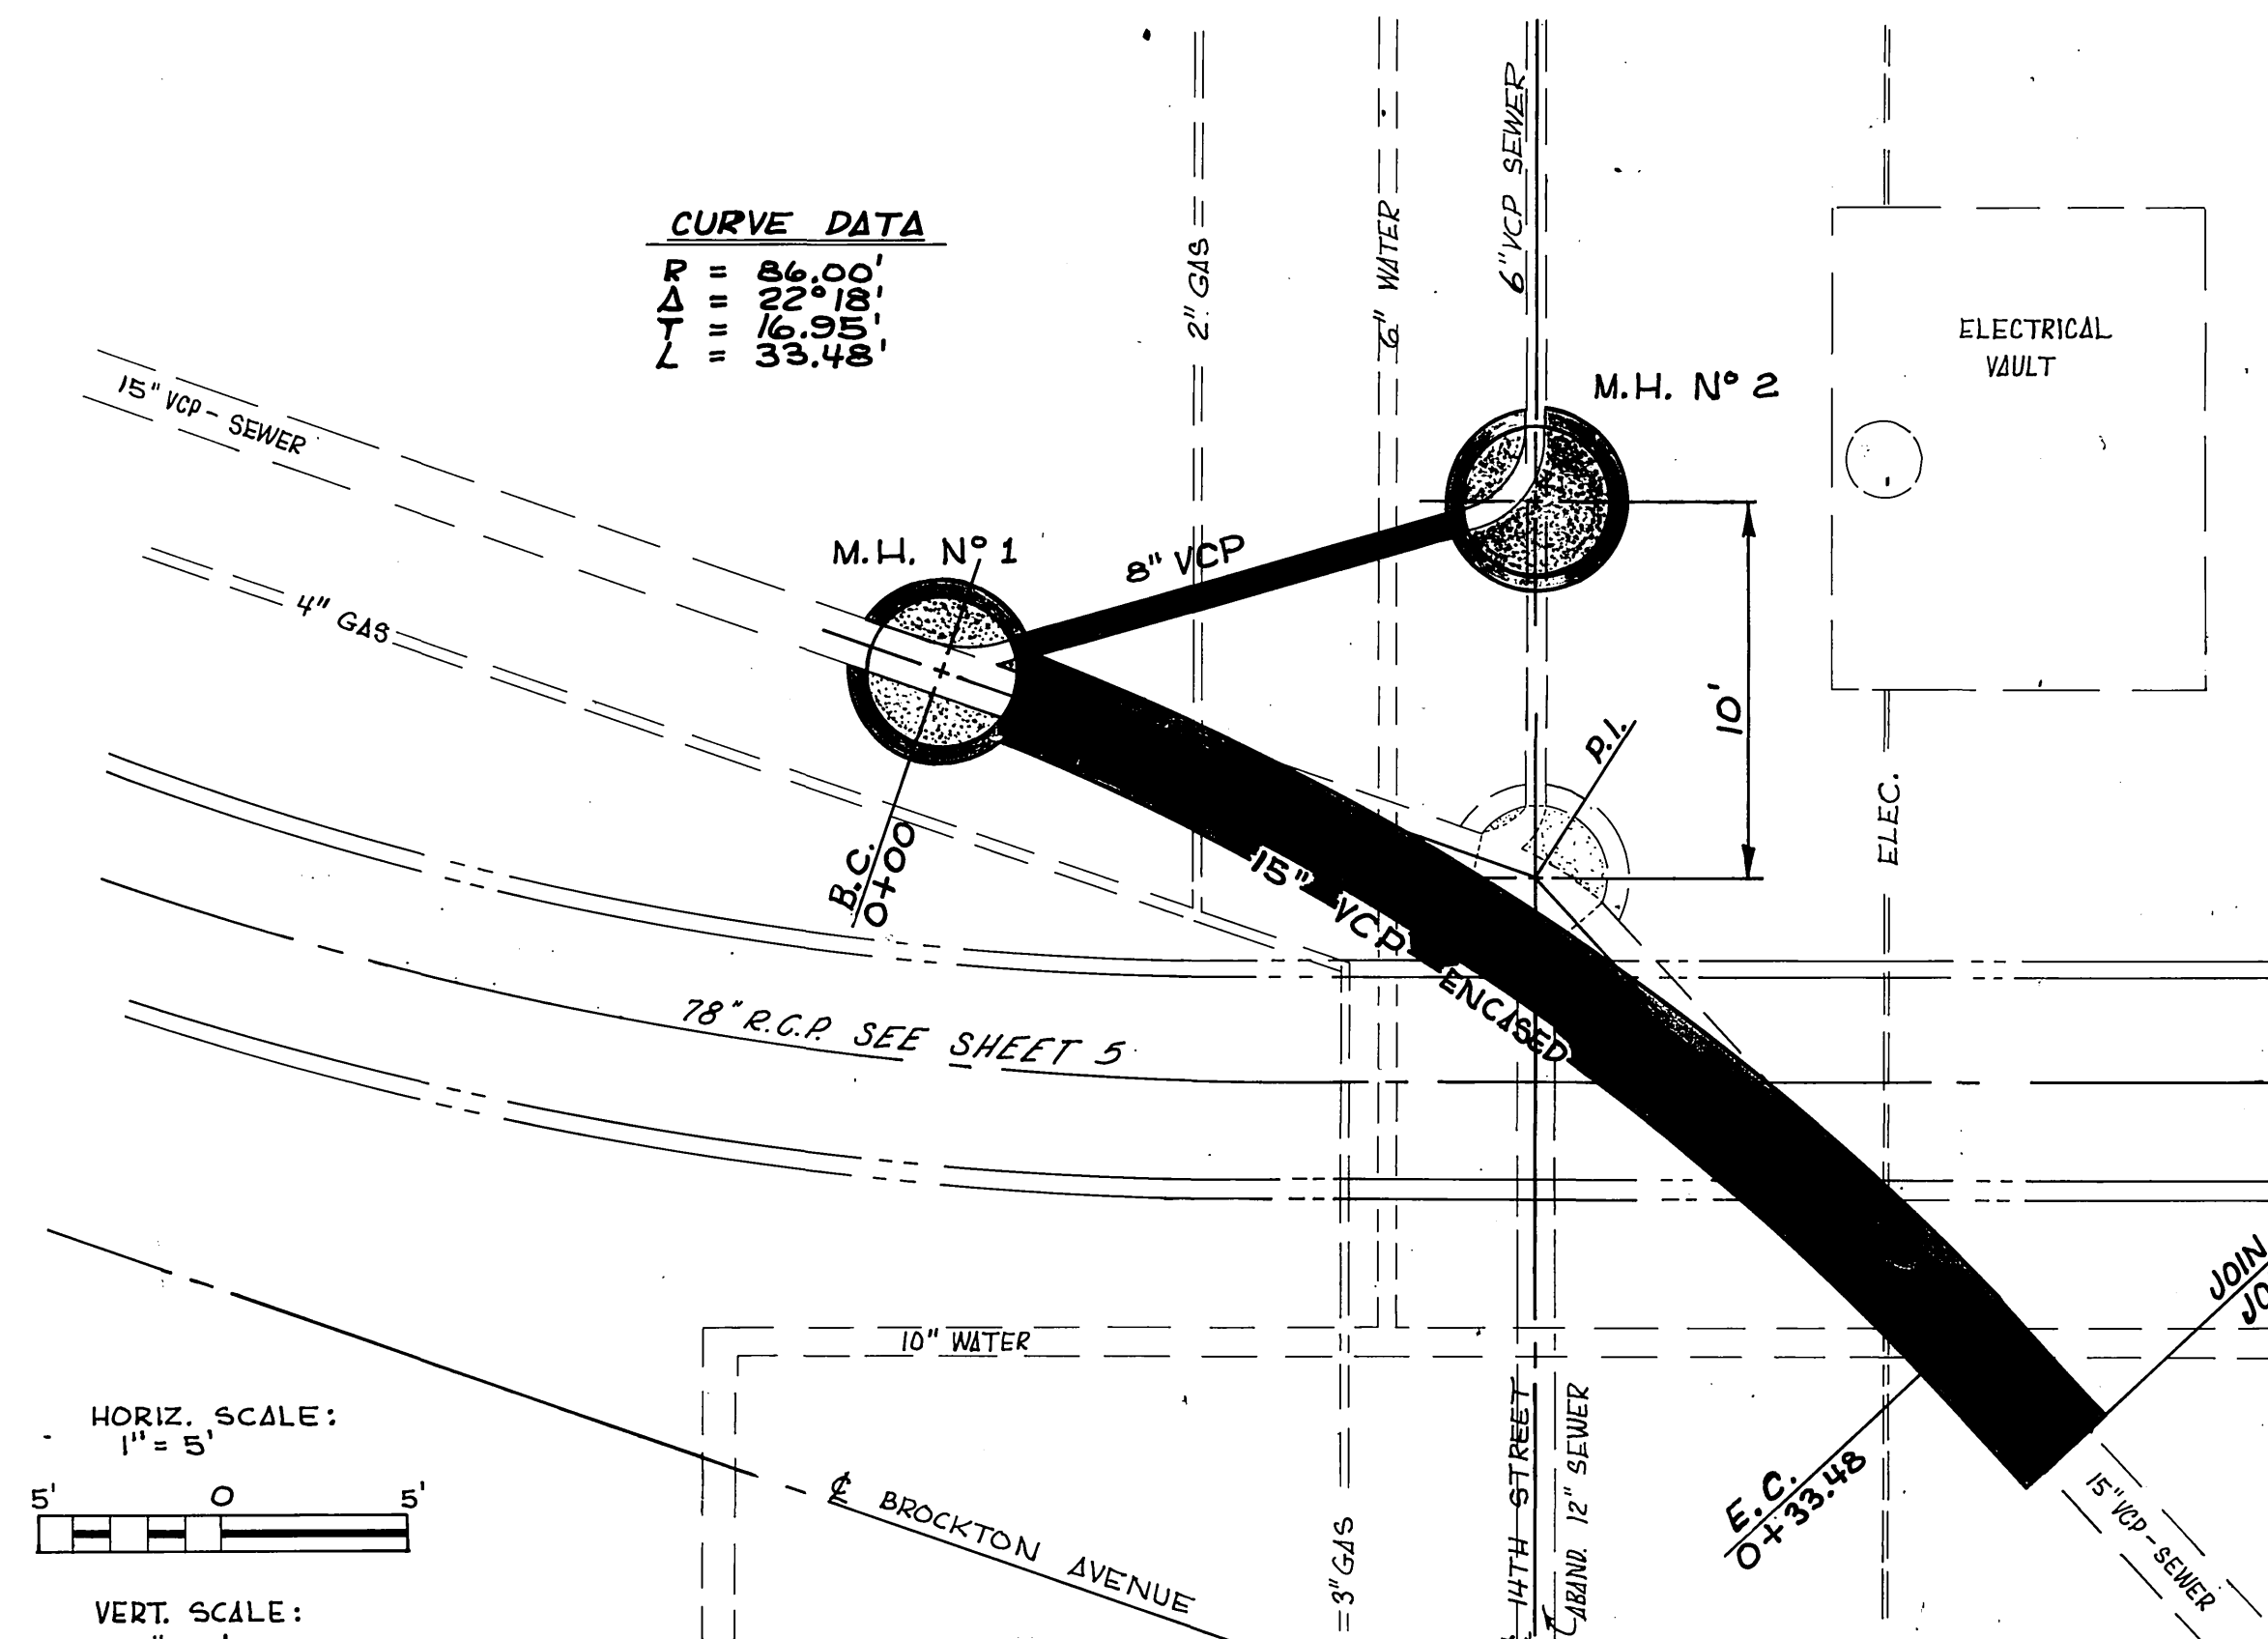

- CONSTRUCTION NOTES**
1. MANHOLES SHALL BE C/R STD. DWG. 500.
 2. USE 3' MAXIMUM LENGTHS OF 15" VCP.
 3. ENCASE 15" VCP PER C/R STD. DWG. 564.
 4. INSTALL 8" VCP PER C/R STD. DWG 452, CASE I.

HORIZ. SCALE:
1" = 5'

VERT. SCALE:
1" = 5'

SCALE
1" = 20'

BENCH MARK: C.R. 61 TOP OF CONC. MON. IN WELL AT NORTH R/W OF FOURTEENTH AND BROCKTON, DOWN 1.13'. ELEV. 793.475.

SCALE: AS SHOWN

DATE: SEPT. 1973

NO.	DESCRIPTION	DATE

REF.	DESCRIPTION	APPR. DATE

RIVERSIDE COUNTY FLOOD CONTROL AND WATER CONSERVATION DISTRICT

DESIGNED BY: *RWS*

DRAWN BY: *R.W. B...*

DATE DRAWN: 10-73

CHECKED BY: *DCA*

APPROVED BY: *John W. Bryant*
CHIEF ENGINEER R.E. NO. 8822

DATE: 6-27-64

BOX SPRINGS DRAIN STAGE II

SEWER RELOCATION
BROCKTON AVE. AT 14TH ST
1970 STORM DRAIN BOND ISSUE PROJECT NO. 5

PROJECT NO. 1-0-220

DRAWING NO. 1-291

SHEET NO. 36 OF 71

AS BUILT