
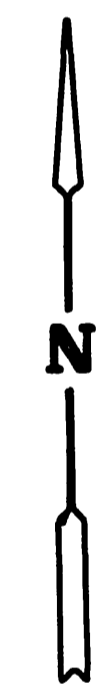


BENCH MARK Elev. 776.683
 R.R. spike RR # 201685 @ the N.E. corner Jones & Campbell, C.R. # 70460

GENERAL NOTES

1. Construction shall be in accordance with the Standard Specifications for Public Works construction, 1973 edition, and City of Riverside Standard Drawings.
2. Location of wyes and laterals to be determined at the direction of the owner.
3. ~~Appropriated wyes to be set.~~
 Manhole frames and covers to be set to meet existing paving grade.
4. It shall be the responsibility of the contractor to clear the right of way in accordance with the provisions of law as it affects each utility including irrigation lines and appurtenances.
5. A plug shall be installed and will remain in place where the new sewer connects with the existing sewer until such time that the new sewer is accepted by the City.

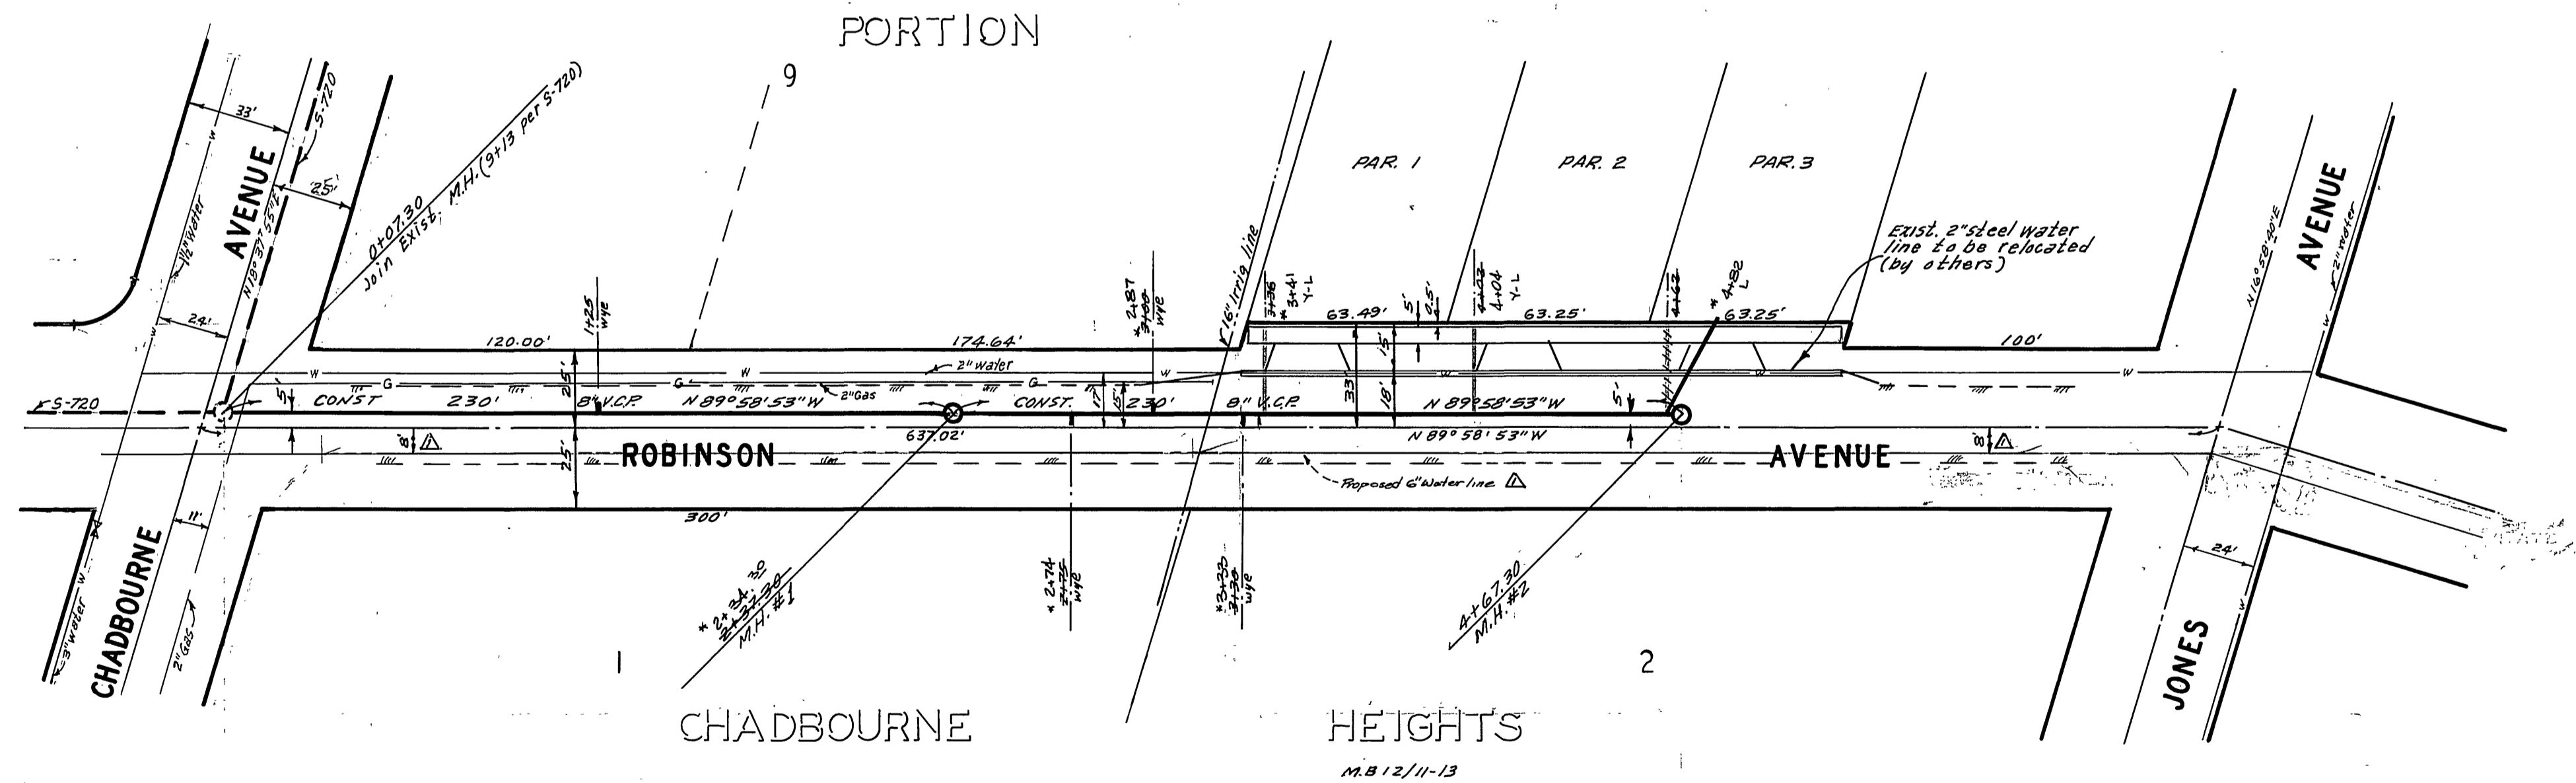

ALBERT A. WEBB ASSOCIATES
 CIVIL ENGINEERS
 RIVERSIDE, CALIFORNIA

APPROVED BY: *L.A. Weaver* DATE: *West*
 R.E. No. 16056

W.O. 74-229 FOR: Tom W. Dixon F.S. 10 35

DESIGNED BY: <i>B.E.L.</i>	DRAWN BY: <i>B.E.L.</i>	CHECKED BY: <i>[Signature]</i>
DATE: <i>1-13-75</i>	DATE: <i>1-13-75</i>	DATE: <i>1-13-75</i>

Approved By: *[Signature]* 1-7-75
 Chief Water Utility Engineer Date

CITY OF RIVERSIDE, CALIFORNIA
 PUBLIC WORKS DEPARTMENT

APPROVED BY: *[Signature]*
 PRINCIPAL ENGINEER
 PARK DEPARTMENT
 TRAFFIC DIVISION
 CHIEF PUB. WKS. ENGR.

SEWER PLAN AND PROFILE
 ROBINSON AVENUE
 SEWER EXTENSION
 Between Chadbourne Ave. & Jones Ave.
 PARCEL MAP 205

ACCOUNT No. 32-577-655
 DRAWING NUMBER
5-993
 SHEET 1 OF 1
 74-229-B