


TYPICAL SECTION



Note: TC elevations BY 4' 11" Curb Face to follow exist

Note: TC elevations to follow exist AC elevation, 2' Curb Face

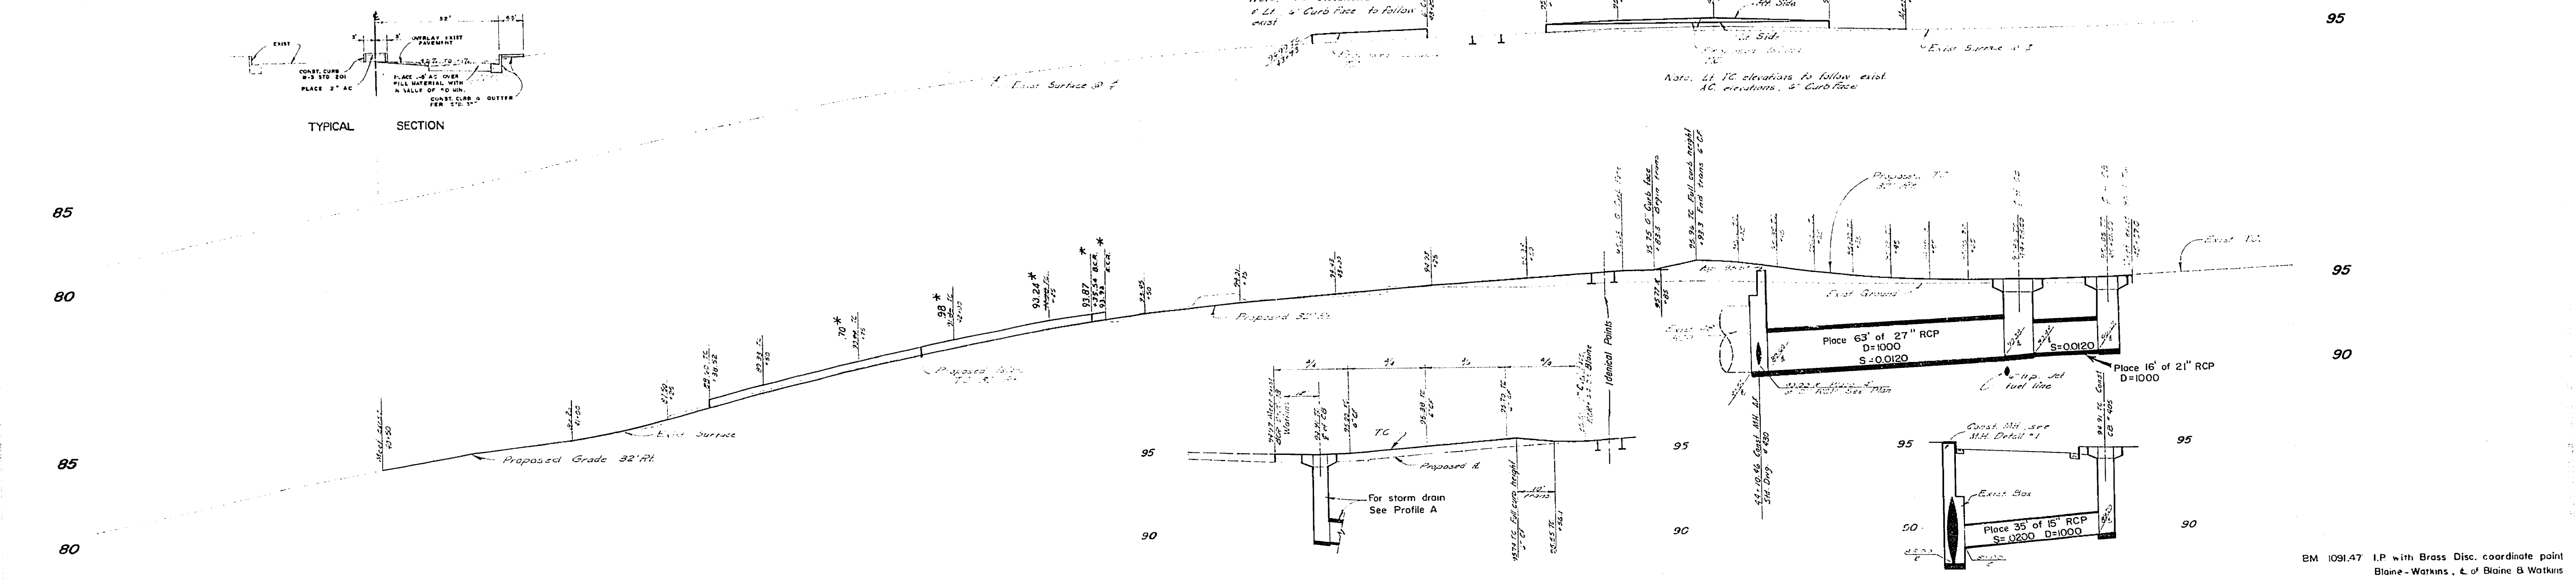

Curb Return Profile

Profile A

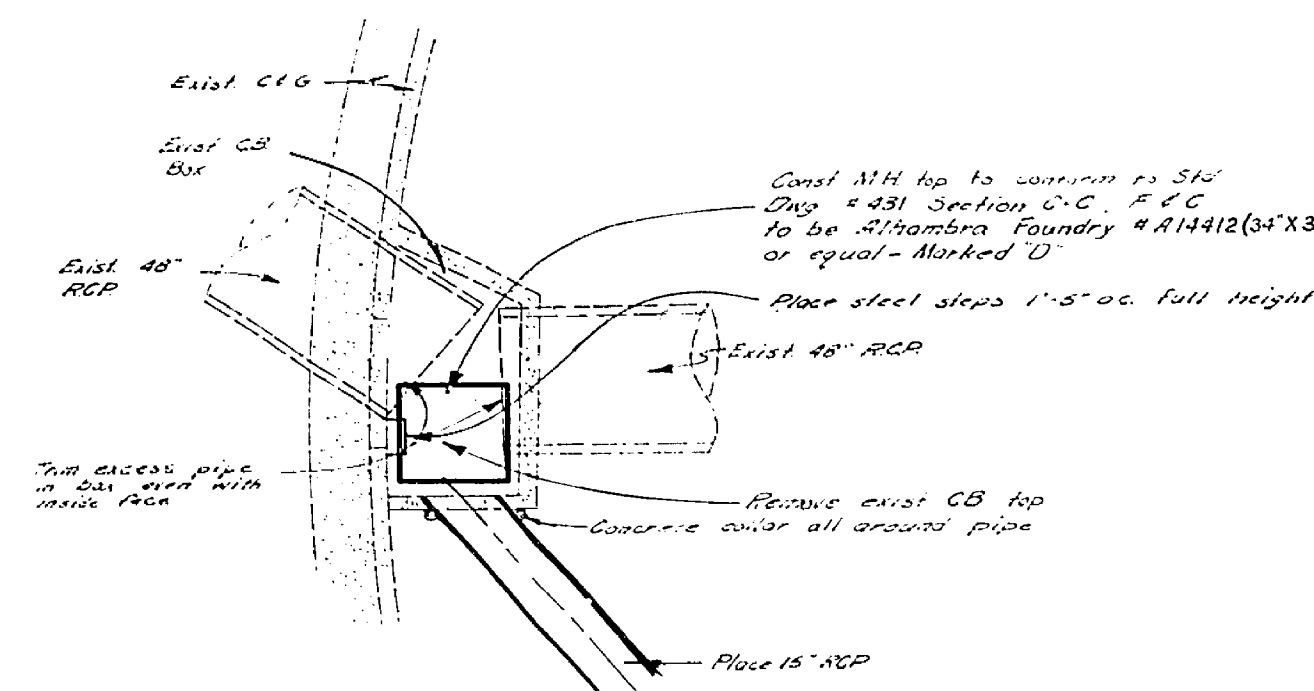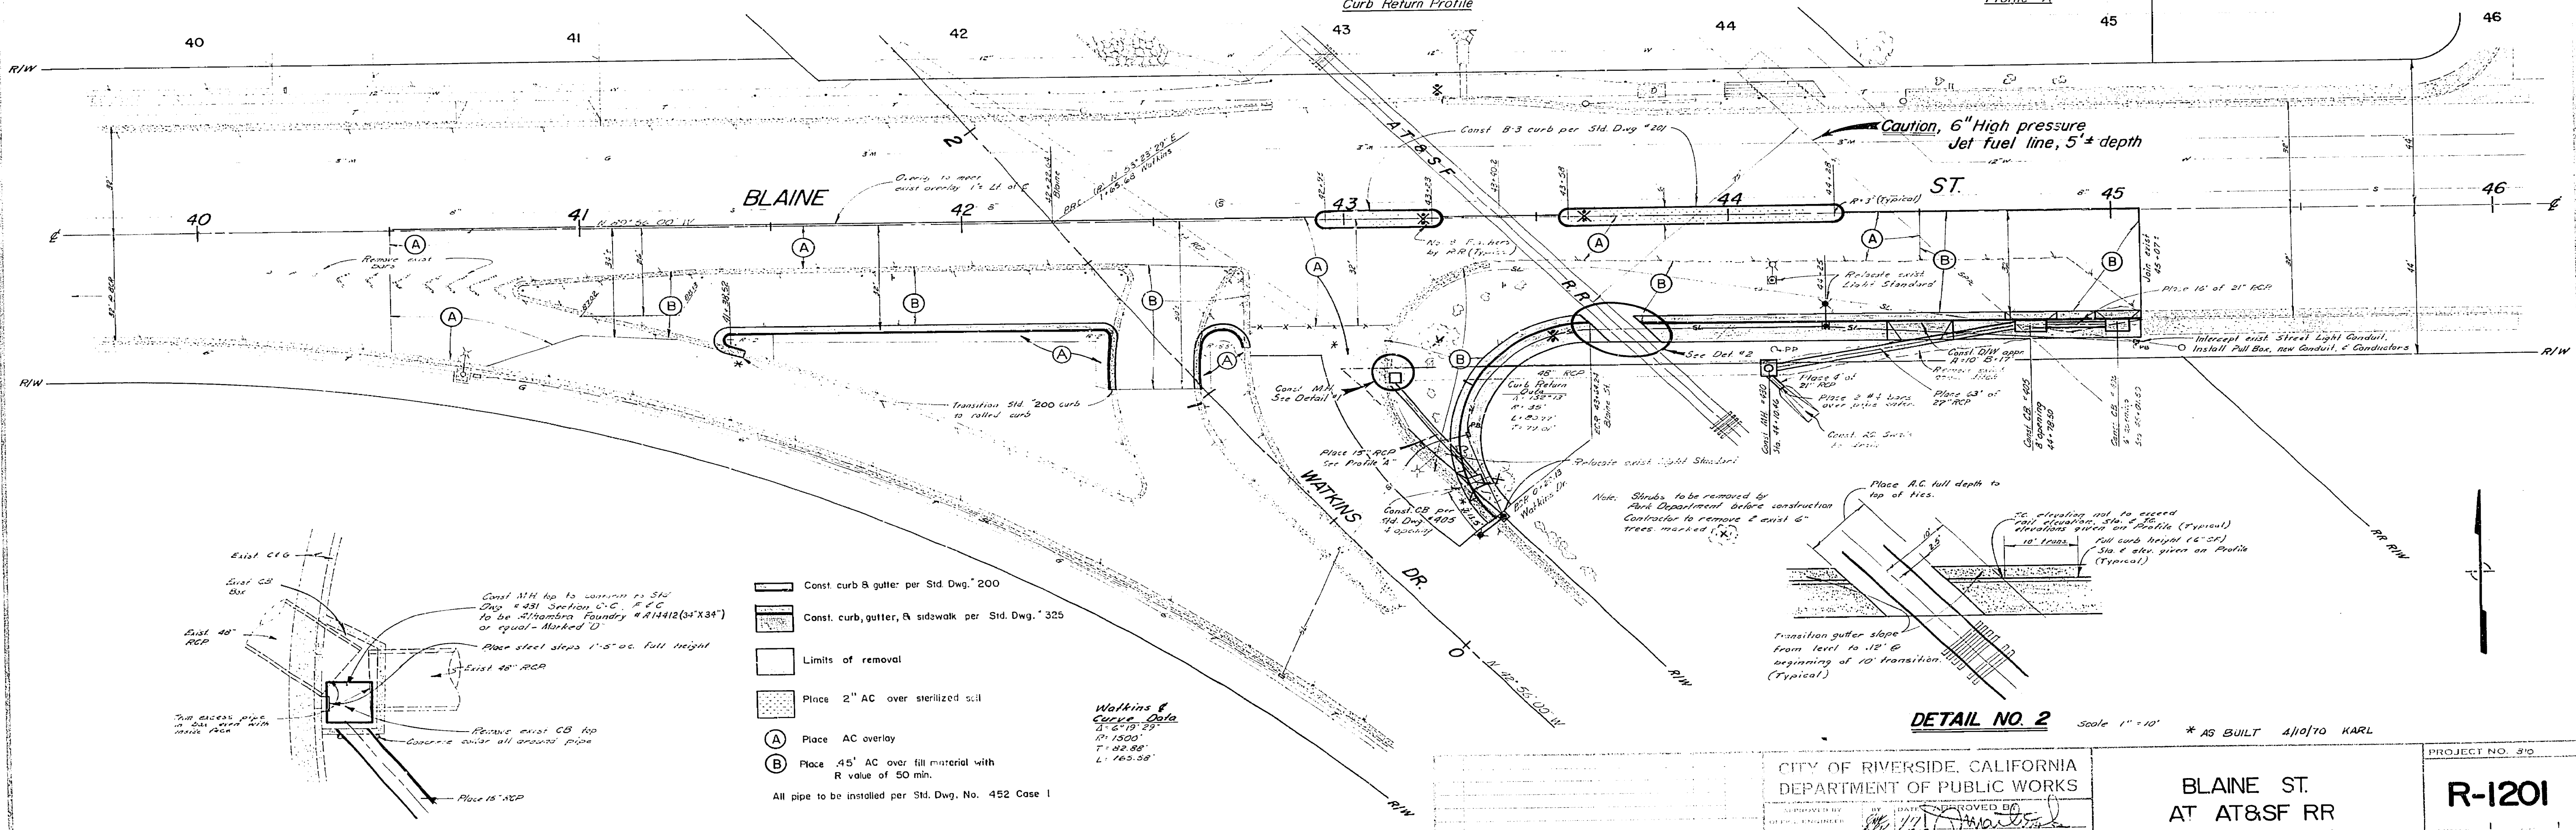

DETAIL NO. 1 Scale 1" = 5'

DETAIL NO. 2 Scale 1" = 10'

* AS BUILT 4/10/70 KARL

Watkins & Curves Data
 1-5-19-29
 1-13-00
 7-12-88
 1-16-58

CITY OF RIVERSIDE, CALIFORNIA
 DEPARTMENT OF PUBLIC WORKS

APPROVED BY: [Signature]
 DATE: 3-6-69

PROJECT NO. 310

BLAINE ST.
 AT 8th ST & RR
 CROSSING NO. 2X2.7

R-1201

HORIZ. SCALE: 1" = 20' VERT. SCALE: 1" = 4'