


BROCKTON HEIGHTS


BROCKTON HEIGHTS NO. 4
M.B. 30/63,64 REC. RIV. CO.

NO. 5
M.B. 31/31,32

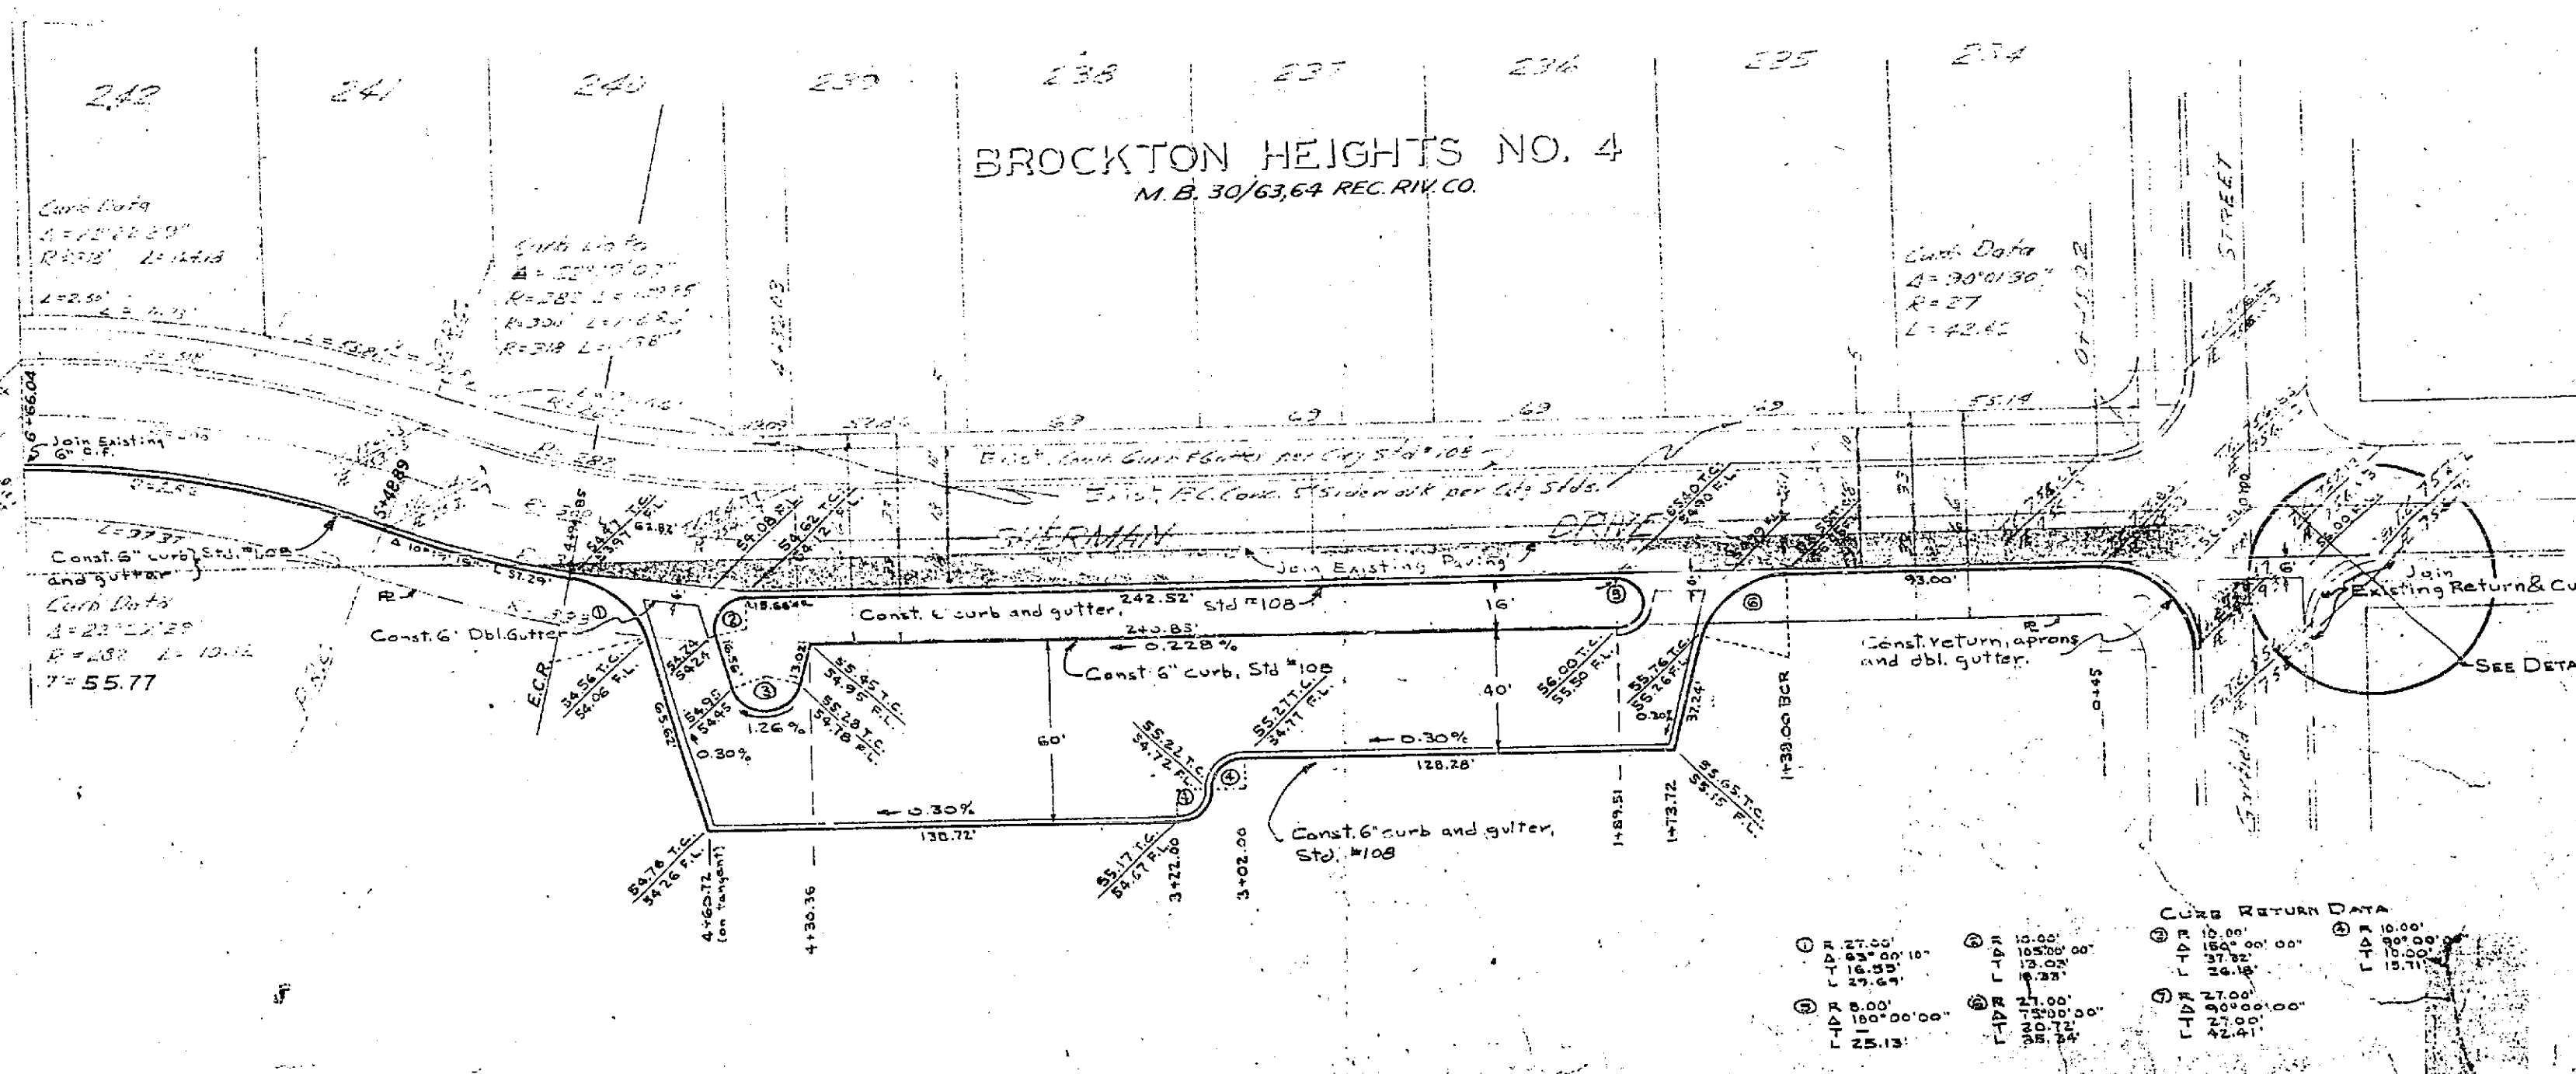

B.M. EL. 756.98 ON S&L IN SW CURB RETURN
SHERMAN & GARFIELD.

F.B. 593/56, 606/10

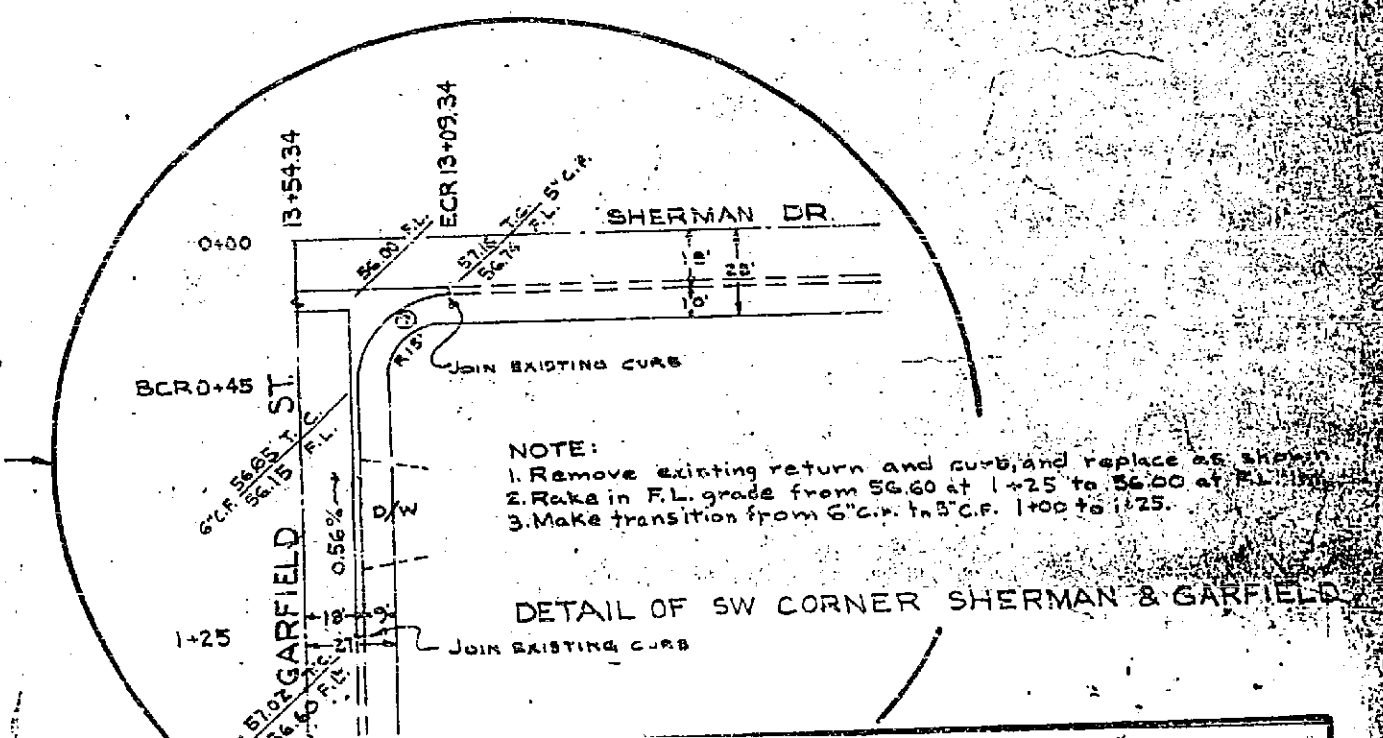

CURB RETURN DATA

① R 27.00'	② R 10.00'	③ R 10.00'	④ R 10.00'
L 27.00'	L 10.00'	L 10.00'	L 10.00'
⑤ R 27.00'	⑥ R 10.00'	⑦ R 10.00'	⑧ R 10.00'
L 27.00'	L 10.00'	L 10.00'	L 10.00'

REVISIONS		CITY OF RIVERSIDE CALIFORNIA DEPARTMENT OF PUBLIC WORKS
MARK	DATE	
		HUNT PARK PARKING LOT AND ADJACENT PORTION OF SHERMAN DRIVE FROM GARFIELD STREET 660'± N'LY
	7-24-57	Added detail of SW corner Sherman & Garfield to show changes.
DESIGNED BY	W.M.	CHECKED BY H.H.
DRAWN BY	W.M.	APPROVED BY <i>[Signature]</i> DIRECTOR OF PUBLIC WORKS
RECOMMENDED BY	[Signature]	DATE: 7/27/57

R-122