



PROPOSED DRILL TRACK  
 5' TRACKS (EELS-REMOV.)  
 NOTE: TRACK CROSSING ATLANTA ST.  
 AUTHORIZED BY CITY OF RIVERSIDE  
 RESOLUTION NO. 11063 JULY 23, 1968,  
 AND CALIFORNIA PUBLIC UTILITIES  
 COMMISSION DECISION NO. 74774,  
 OCT. 8, 1968. CROSSING ASSIGNED  
 NO. "BJ-544.45-C"

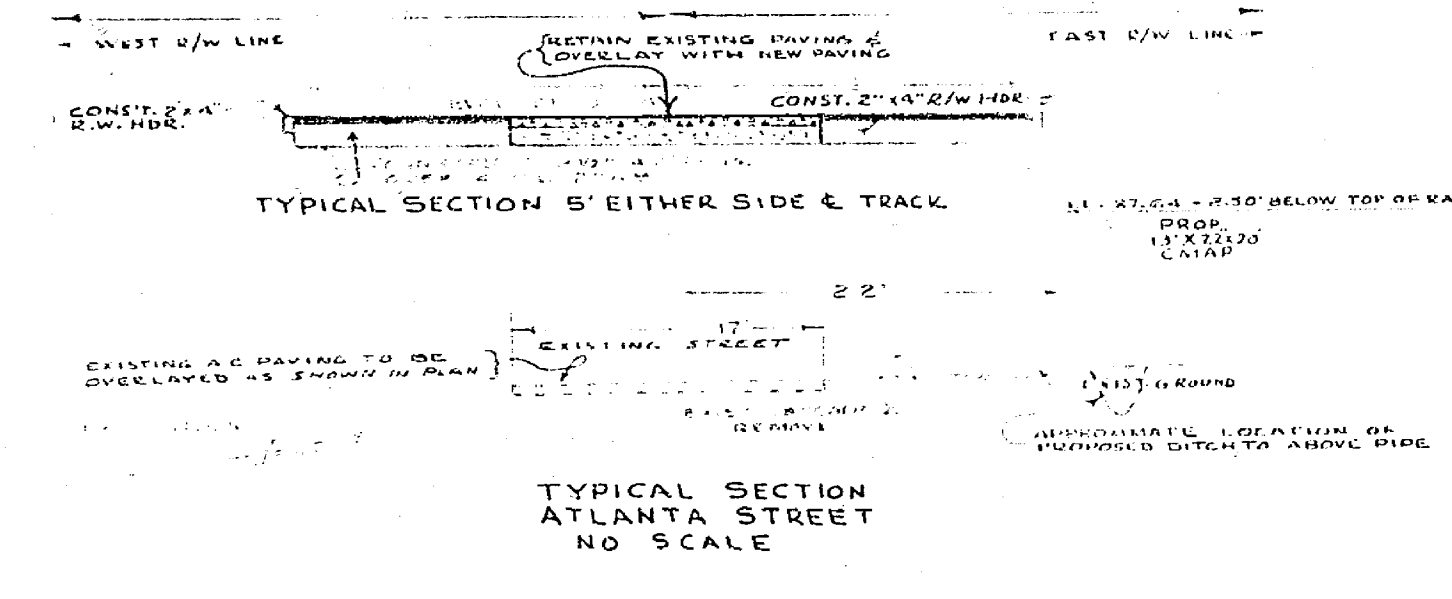

- GENERAL NOTES -
- (1) IT SHALL BE THE RESPONSIBILITY OF THE CONTRACTOR TO CLEAR THE RIGHT OF WAY IN ACCORDANCE WITH THE PROVISIONS OF LAW AS IT AFFECTS EACH UTILITY, INCLUDING IRRIGATION LINES, AND APPURTENANCES, AND AT NO COST TO THE CITY.
  - (2) CONSTRUCTION SHALL BE IN ACCORDANCE WITH THE CITY OF RIVERSIDE, DEPARTMENT OF PUBLIC WORKS, SPECIFICATIONS NO. 461 AND STANDARD DRAWINGS.
  - (3) PRIME COAT, SEAL COAT, AND PAINT BINDER ARE REQUIRED.
  - (4) TRIM EDGE OF EXISTING PAVEMENT, WHERE NEW PAVING JOINS EXISTING PAVEMENT, TO A CLEAN, STRAIGHT LINE. CONSTRUCT MATCH-UP PAVING AS SHOWN AND OVERLAY PAVING AS DIRECTED IN THE FIELD TO PRODUCE A SMOOTH CROWN SECTION.
  - (5) RAILROAD SHALL INSTALL TWO STANDARD NO. 11A "REFLECTORIZED" CROSSING SIGNS PER P.U.C. GENERAL ORDER NO. 78-B.
- NOTE: THE CONTRACTOR IS TO CONTACT THE CITY ENGINEER PRIOR TO CONSTRUCTION TO NEGOTIATE CITY OF RIVERSIDE ("BY OTHERS") PORTION OF CONSTRUCTION.
- NOTICE TO CONTRACTOR: THE EXISTENCE AND LOCATION OF ANY UNDERGROUND UTILITY PIPES OR STRUCTURES SHOWN ON THESE PLANS ARE OBTAINED BY A SEARCH OF THE AVAILABLE RECORDS. TO THE BEST OF OUR KNOWLEDGE, THERE ARE NO EXISTING UTILITIES EXCEPT AS SHOWN ON THESE PLANS.
- THE CONTRACTOR IS REQUIRED TO TAKE DUE PRECAUTIONARY MEASURES TO PROTECT THE UTILITY LINES SHOWN AND ANY OTHER LINES NOT OF RECORD OR NOT SHOWN ON THESE PLANS.
- THE CONTRACTOR IS TO ACQUIRE PERMITS AND ARRANGE FOR TRAFFIC PROTECTION WITH CITY OF RIVERSIDE.
- (6) THE CONTRACTOR SHALL RELOCATE THIS PALM TREE TO IOWA AVE. NORTH OF S.D. MAIN LINE, PER CITY PARK & RECREATION DEPT. SPEC. - CONTACT MR. DAVENPORT @ 787-7518 PRIOR TO RELOCATING.

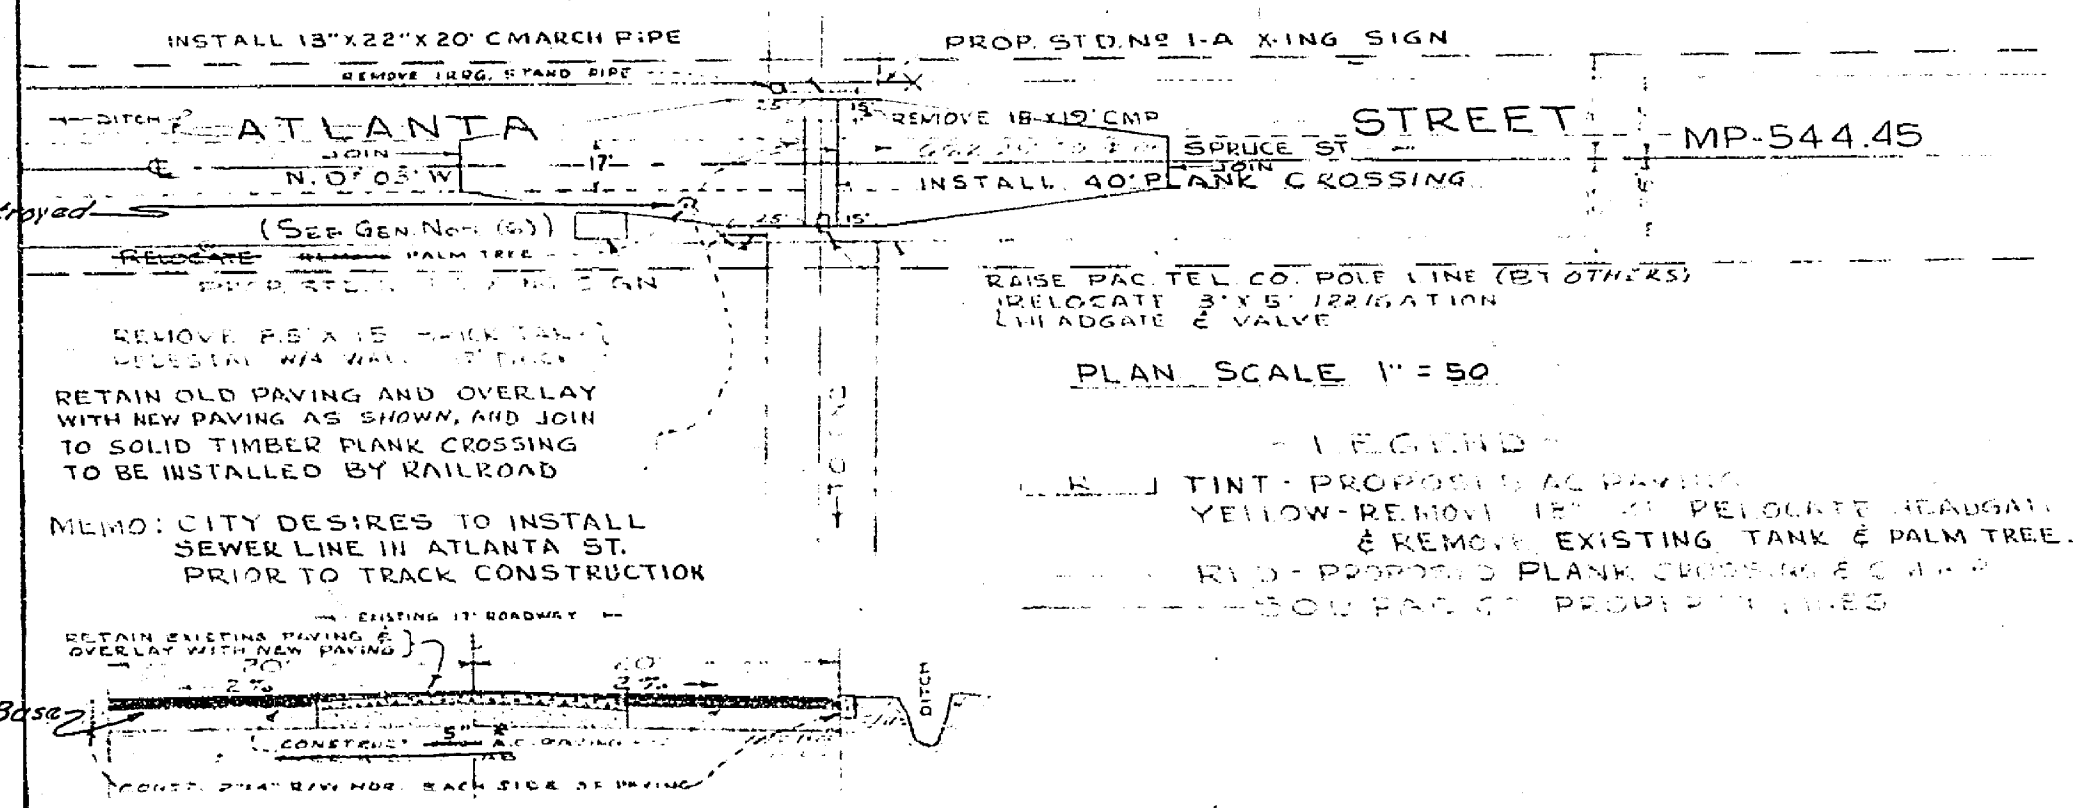

TYPICAL SECTION - ATLANTA STREET  
 AT 15' EITHER SIDE OF TRACK -  
 SECTION TO BECOME LEVEL AT TRACK CROSSING  
 (NO SCALE)

SOUTHERN PACIFIC COMPANY  
 PACIFIC LINES  
 RIVERSIDE  
 STREET PLAN AND PROFILE - ATLANTA STREET  
 AT RAILROAD'S PROPOSED TRACK CROSSING  
 AT GRADE M.P. 544.45

\* As Built - Norm 7.31.69

CITY OF RIVERSIDE, CALIFORNIA DEPARTMENT OF PUBLIC WORKS		ATLANTA STREET AT PROPOSED S.P.R.R. CROSSING		I.A. DIVN. DWG. B-5179 SHEET NO. 1	
APPROVED BY: [Signature]		APPROVED BY: [Signature]		PROJECT NO. R-1344	
DESIGNED BY: [Signature]		DATE: 3-27		SHEET 1 OF 1	
DRAWN BY: [Signature]		DATE: [Blank]		FILE NO. [Blank]	
CHECKED BY: [Signature]		DATE: [Blank]		FILE NO. [Blank]	