

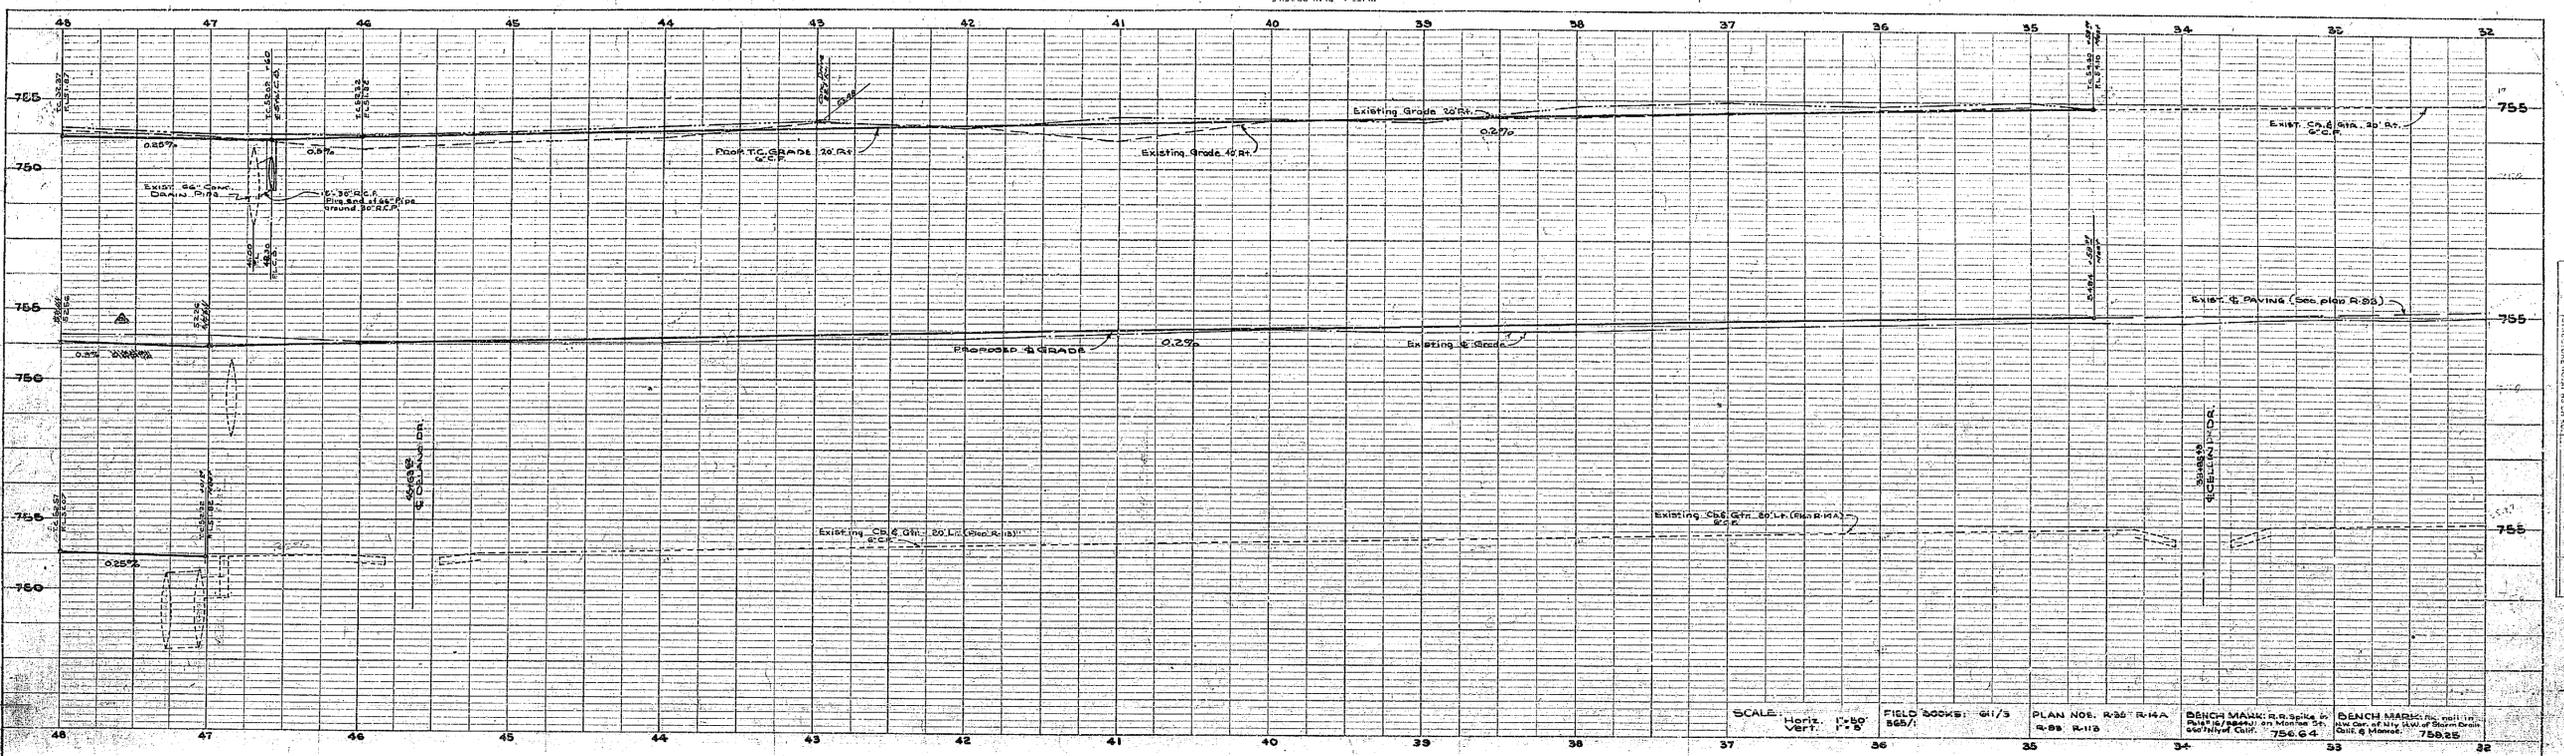


PLATE 1 - PLAN PROFILE
 MONROE ST. & VILLAS D'ESTE
 RIVERSIDE, CALIFORNIA


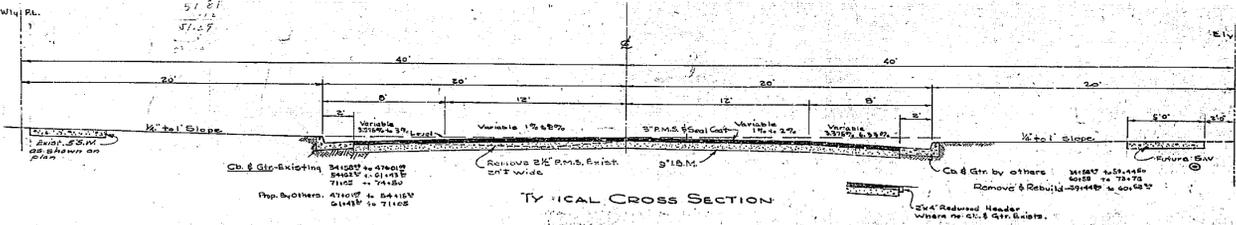


SCALE: Horiz. 1"=50' VERT. 1"=5'
 FIELD BOOKS: 61/3 62/1
 PLAN NOS. R-30 R-14 R-88 R-119
 BENCH MARK: R.R. 5014.00 at 756.64
 BENCH MARK: 756.25


PLAN	REVISIONS
DATE	DATE
BY	BY
CHECKED	CHECKED
APPROVED	APPROVED

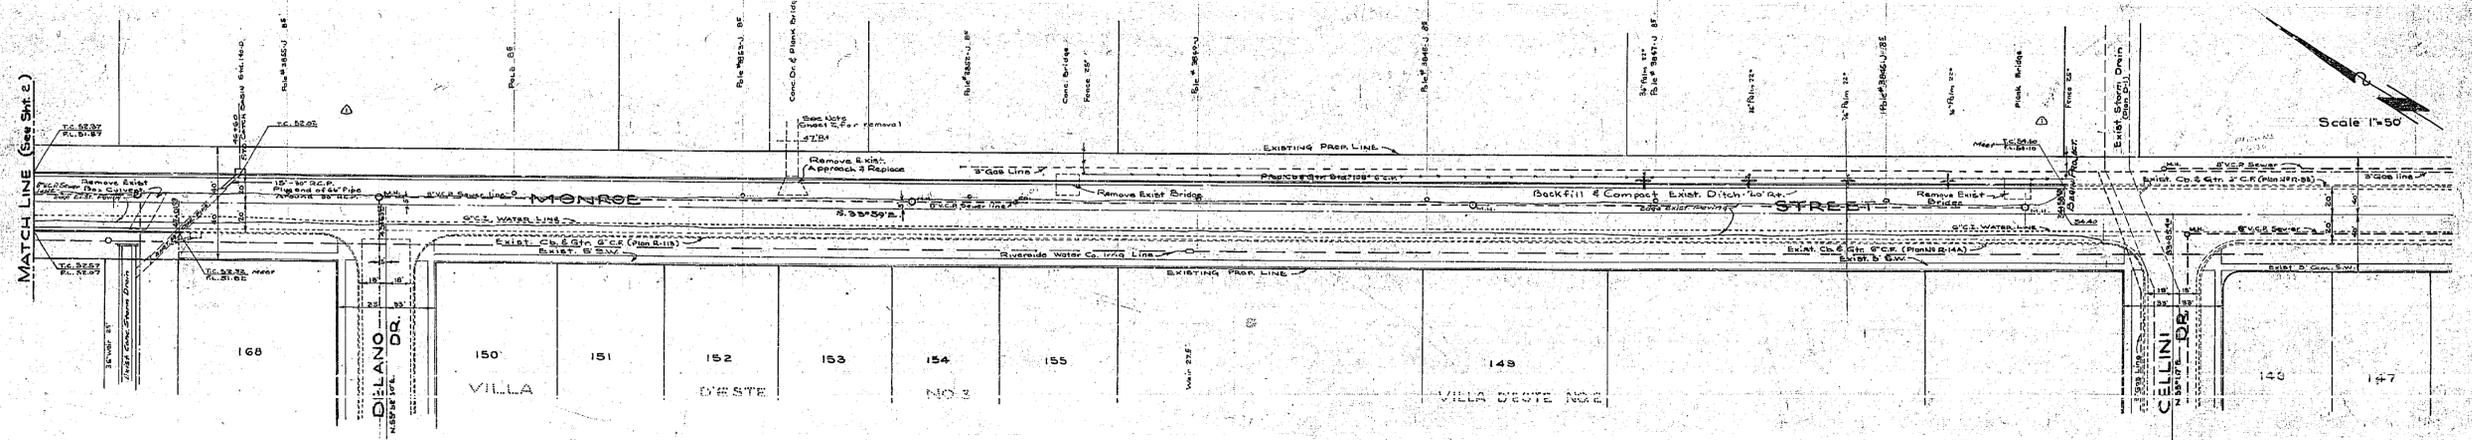


REVISIONS		CITY OF RIVERSIDE CALIFORNIA DEPARTMENT OF PUBLIC WORKS	
MARK	DATE	DESCRIPTION	
Δ	1-16-57	Added Tops on Nly Side of Monroe between Sta 34+57 & 40+150. (d.r.b.)	MONROE ST. LOWERING & PAVING. 700 Northernly of California Ave. to Arlington Ave. STATE AID PROJ. No. 93
Δ	8-8-58	Changed Grades & Elevations	
Δ	7-18-59	Changed Sidewalk Location from 12' off Prop. Line to 2' off Prop. Line. (d.r.b.)	
DESIGNED BY	CHECKED BY	APPROVED BY	R-138 SHEET 1 OF 3
DRAWN BY	d.r.b.	 J.L.G. ASSISTANT CITY ENGINEER	
RECOMMENDED BY	 J.L.G. ASSISTANT CITY ENGINEER	DATE 12-19-57 DIRECTOR OF PUBLIC WORKS R.S. 6734	

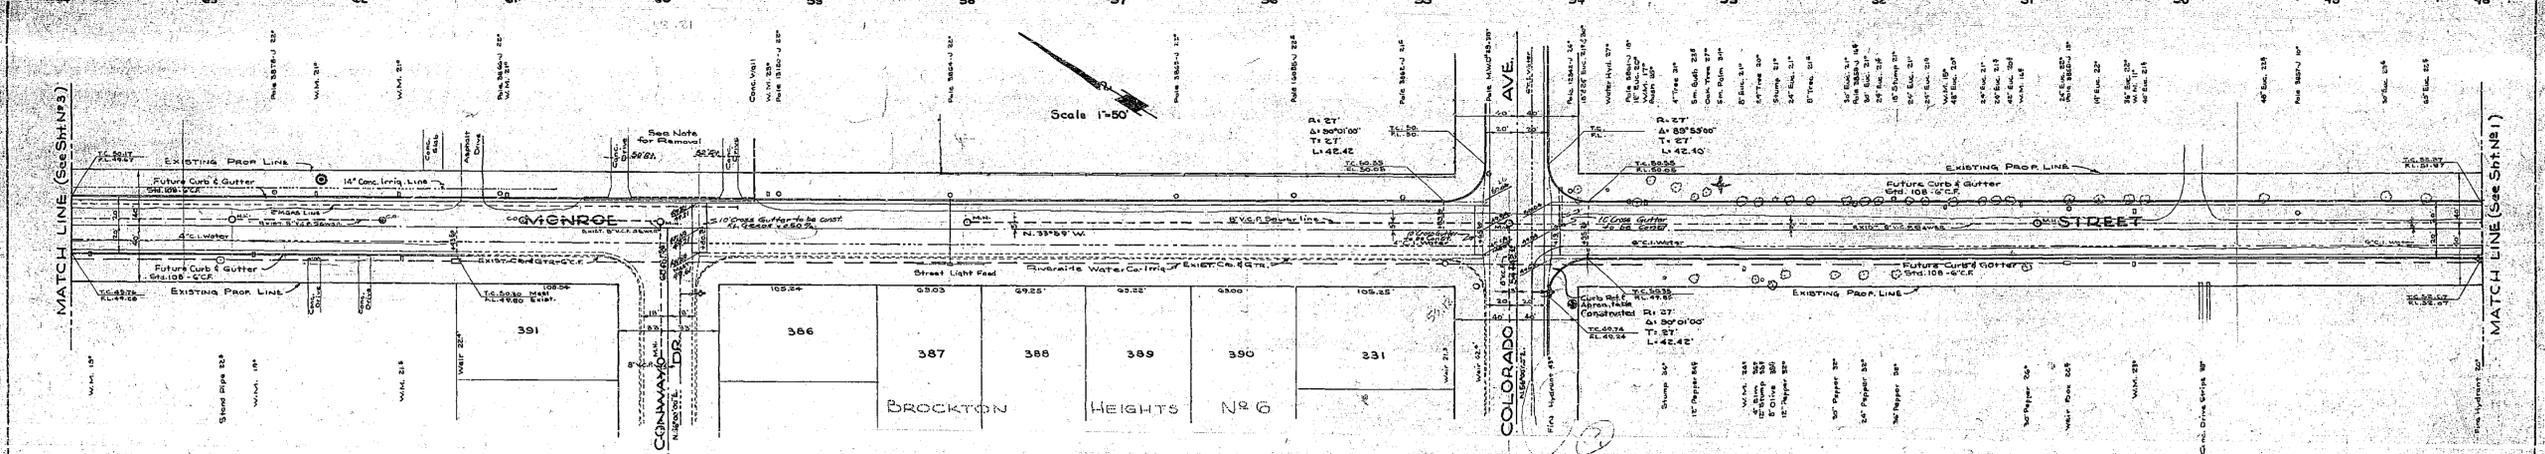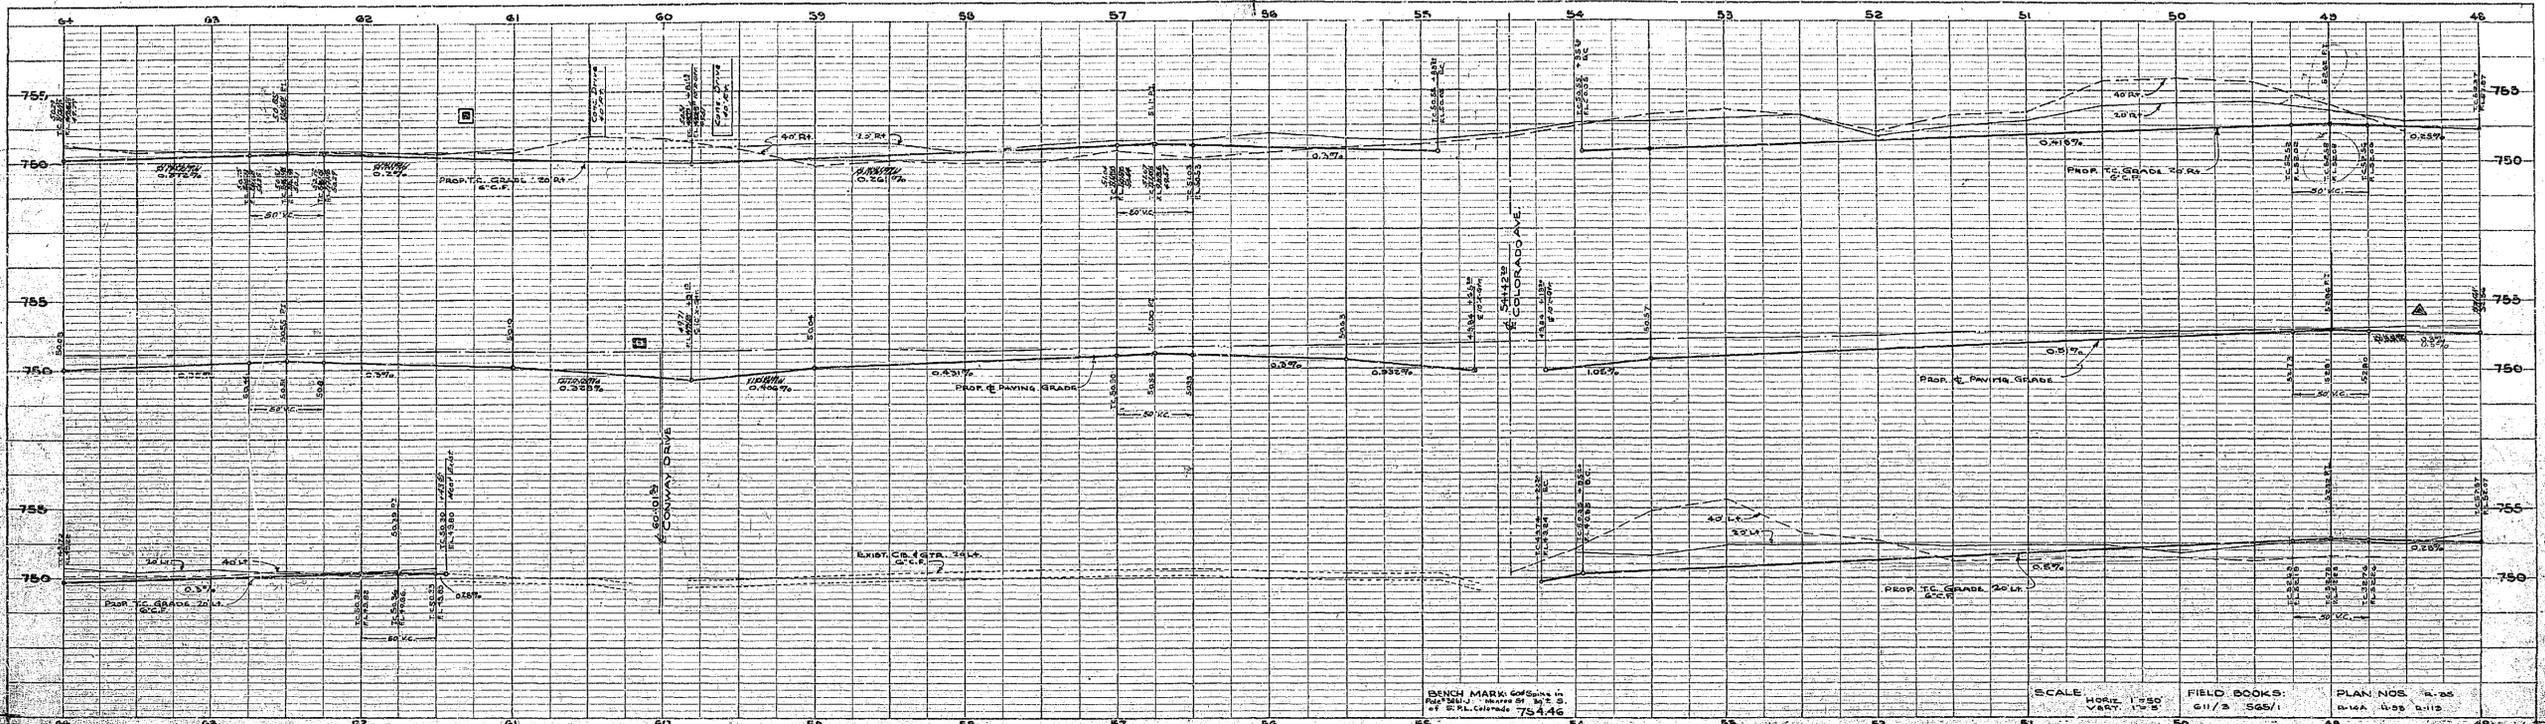


NOTE:
 Existing driveway approaches and concrete driveways to be removed to indicated offset distances. Replace concrete driveway approaches with City of Riverside Std. NB 109-B and Join existing drives to new approach & sidewalk section with maximum 10% slope.

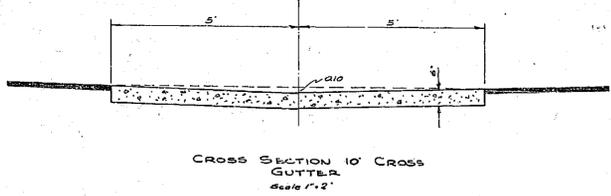

REVISIONS			CITY OF RIVERSIDE CALIFORNIA DEPARTMENT OF PUBLIC WORKS	
MARK	DATE	DESCRIPTION	MONROE ST. LOWERING & PAVING 700 Northerly of California Ave. to Arlington Ave. STATE AID PROJ. NO. 93	
⊙	4-30-58	Added 14" Conc. Irrig. Line		
⊠	5-2-58	Changed Curb Grades & Elevations.		
⊡	5-8-58	Changed Grades & Elev. dr.		
⊞	5-15-58	Added Note on Ret. #Apro		
DESIGNED BY	CHECKED BY	APPROVED BY	R-138 SHEET 3 of 3	
DRAWN BY	RECOMMENDED BY	DIRECTOR OF PUBLIC WORKS		
ASSISTANT CITY ENGINEER			DATE 12-10-57	

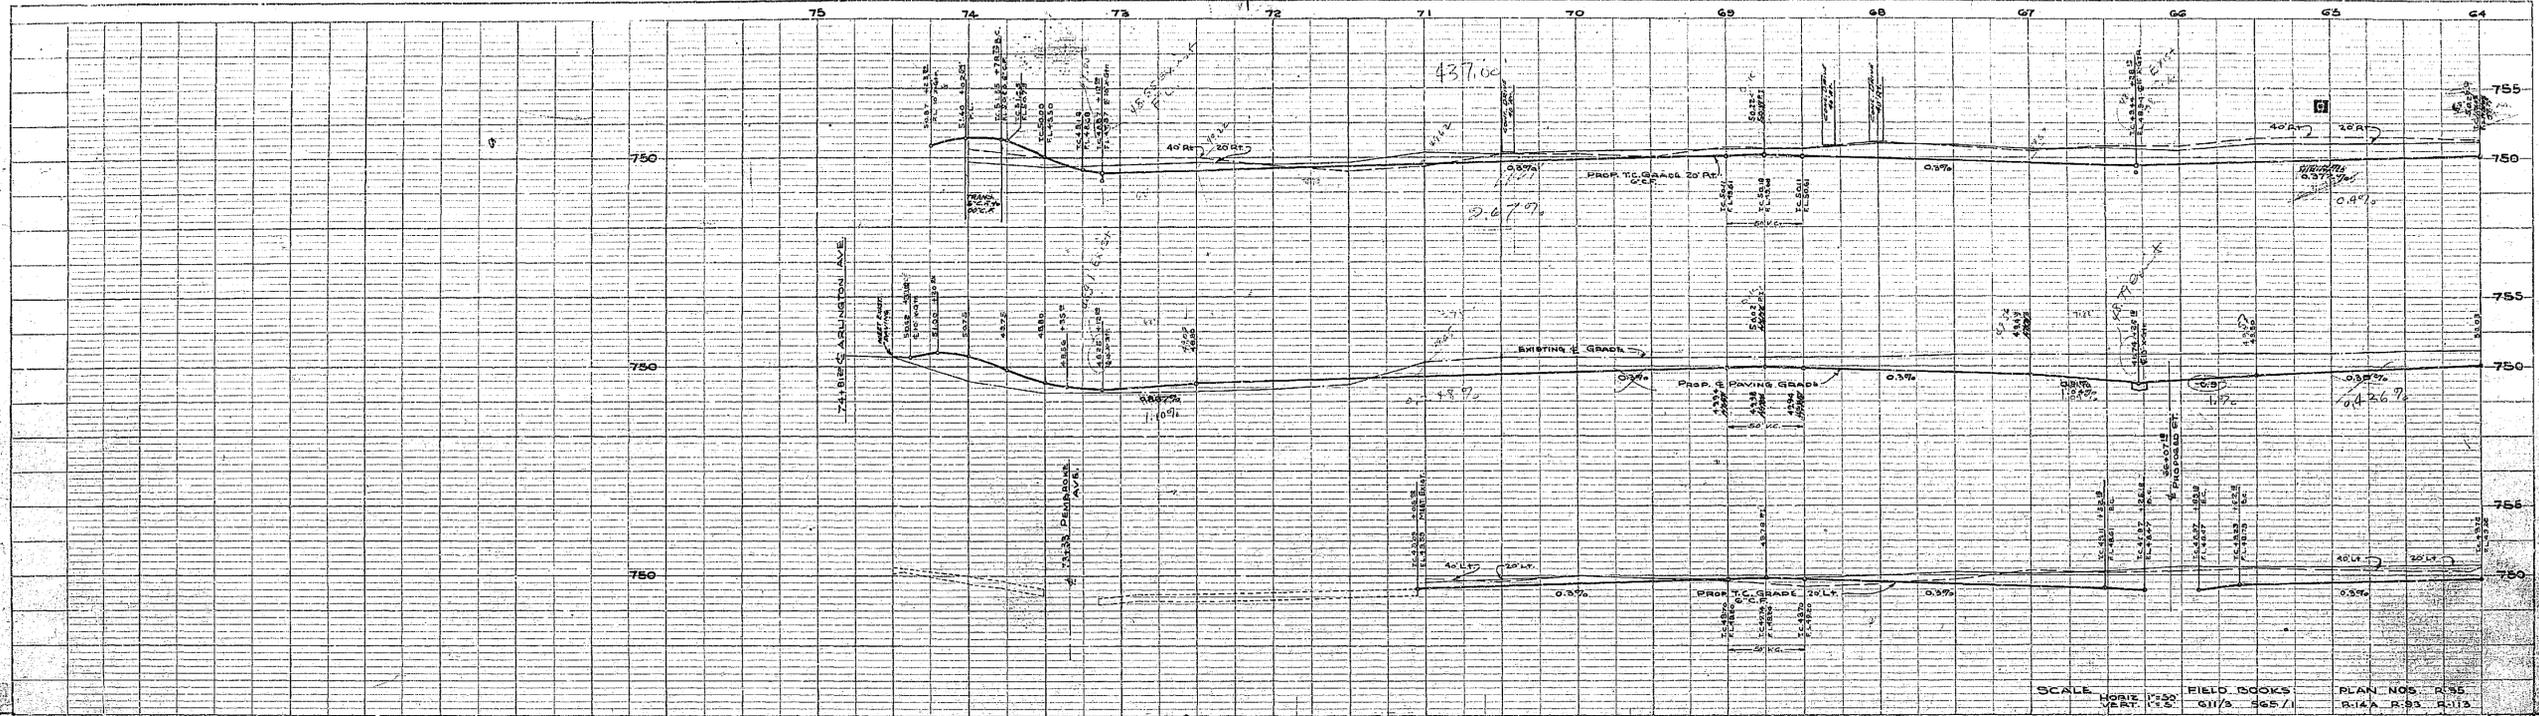

PROFILE	PROJECT
DATE	NO. 1
SCALE	1" = 20'
FIELD BOOKS	611/3 465/1
PLAN NOS.	R-135 R-136 R-137

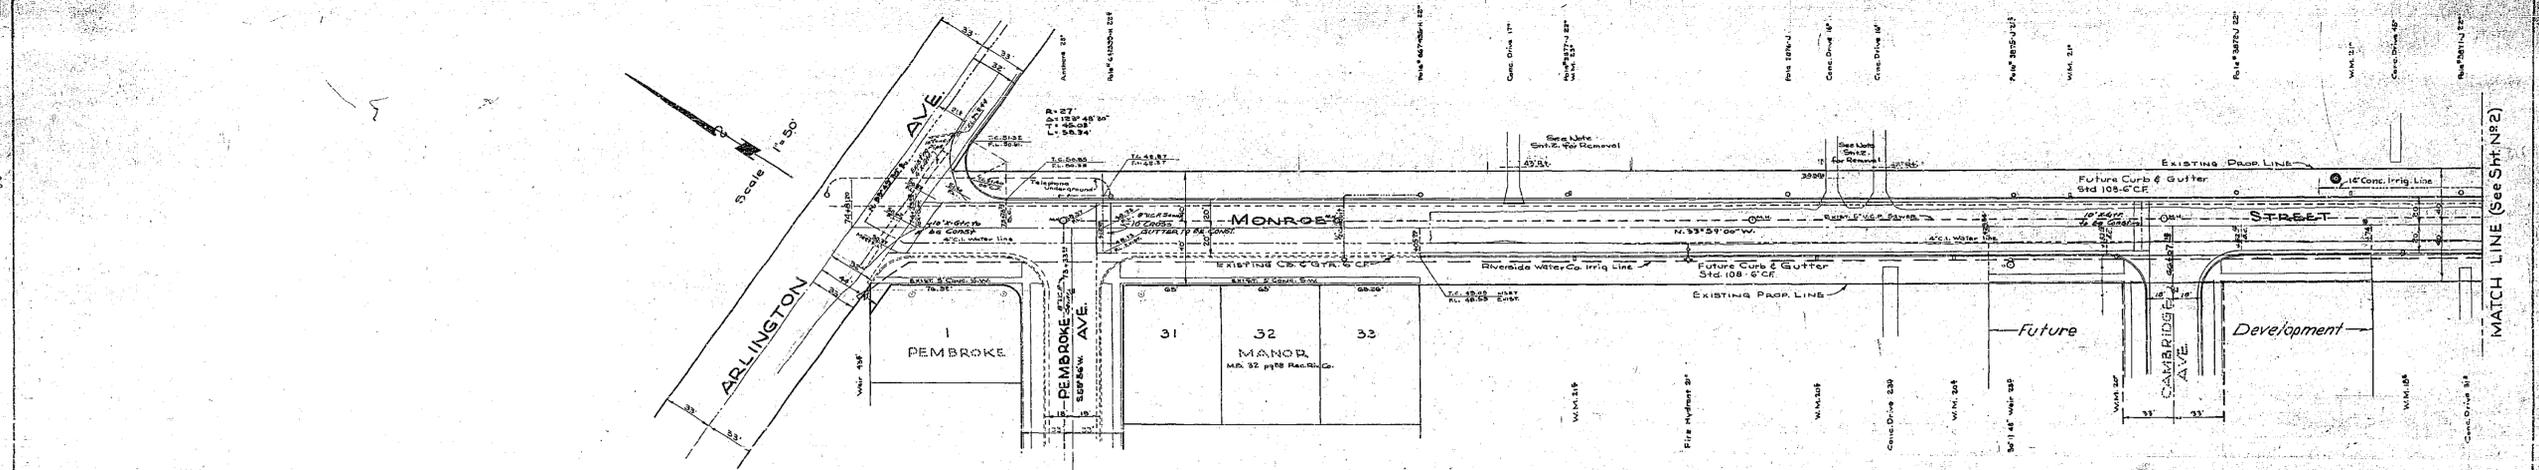

PLAN	PROJECT
DATE	NO. 1
SCALE	1" = 50'
FIELD BOOKS	611/3 465/1
PLAN NOS.	R-135 R-136 R-137

REVISIONS DATE DESCRIPTION 1-30-67 Added 14" Conc. Irrig. Line & Adjusted Curb Grades & Elevations, etc.		CITY OF RIVERSIDE, CALIFORNIA DEPARTMENT OF PUBLIC WORKS <h3>MONROE ST.</h3> LOWERING & PAVING 100 Northernly of California Ave. to Arlington Ave. STATE AID PROJ. NO. 53
DESIGNED BY DRAWN BY <i>d.r.b.</i>	CHECKED BY <i>J.L.G.</i> APPROVED BY <i>[Signature]</i> DIRECTOR OF PUBLIC WORKS R-138	
RECOMMENDED BY <i>[Signature]</i> ASSISTANT CITY ENGINEER	DATE 12-19-67	SHEET 3 OF 5