


EB-69/1-4

A. V. Jester  
 Office O.K. 6-3311  
 Vincent Jester  
 O.K. 6-4422


Jefferson Street  
 R-128

NOTE: FIGURES SHOWN IN  
PURPLE ARE 2 TIMES TOO  
LARGE:

CITY OF CHICAGO  
CIVIL ENGINEERING DEPARTMENT

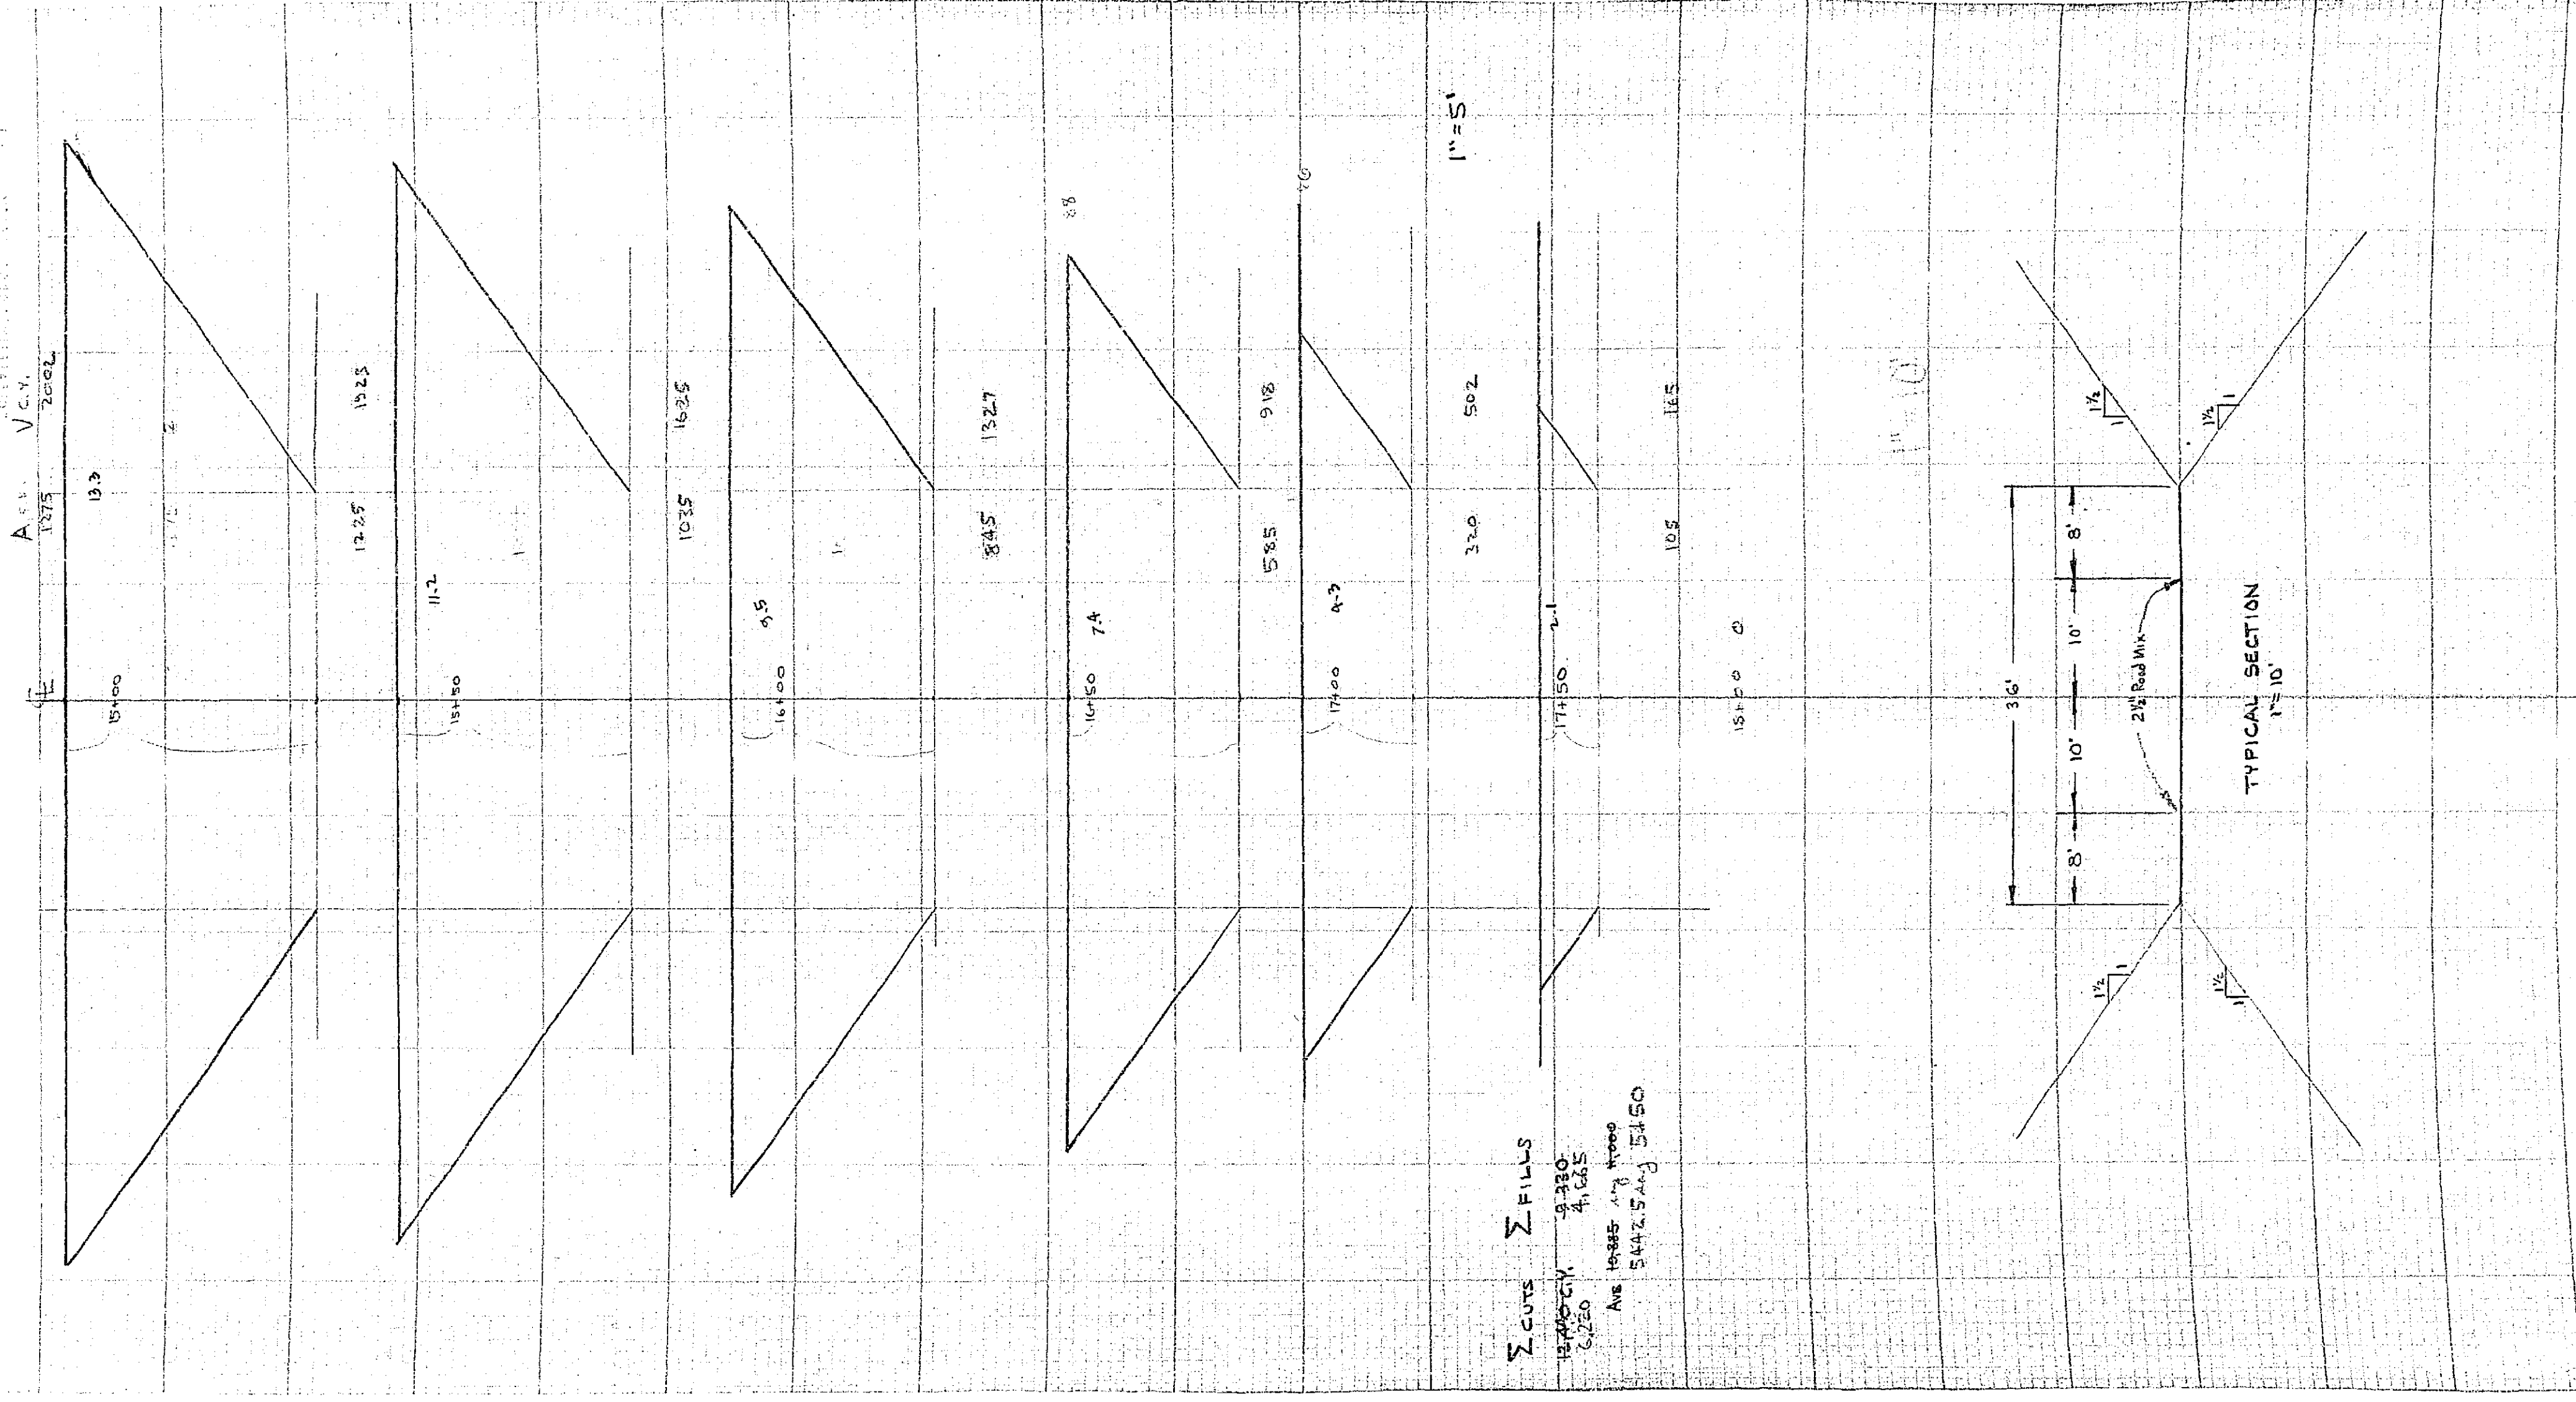


Σ CUTS Σ FILLS  
 19,200 CY 9,330  
 6,250 4,625  
 Ave 19,850 ± 7,955  
 54,250 ± 5,150

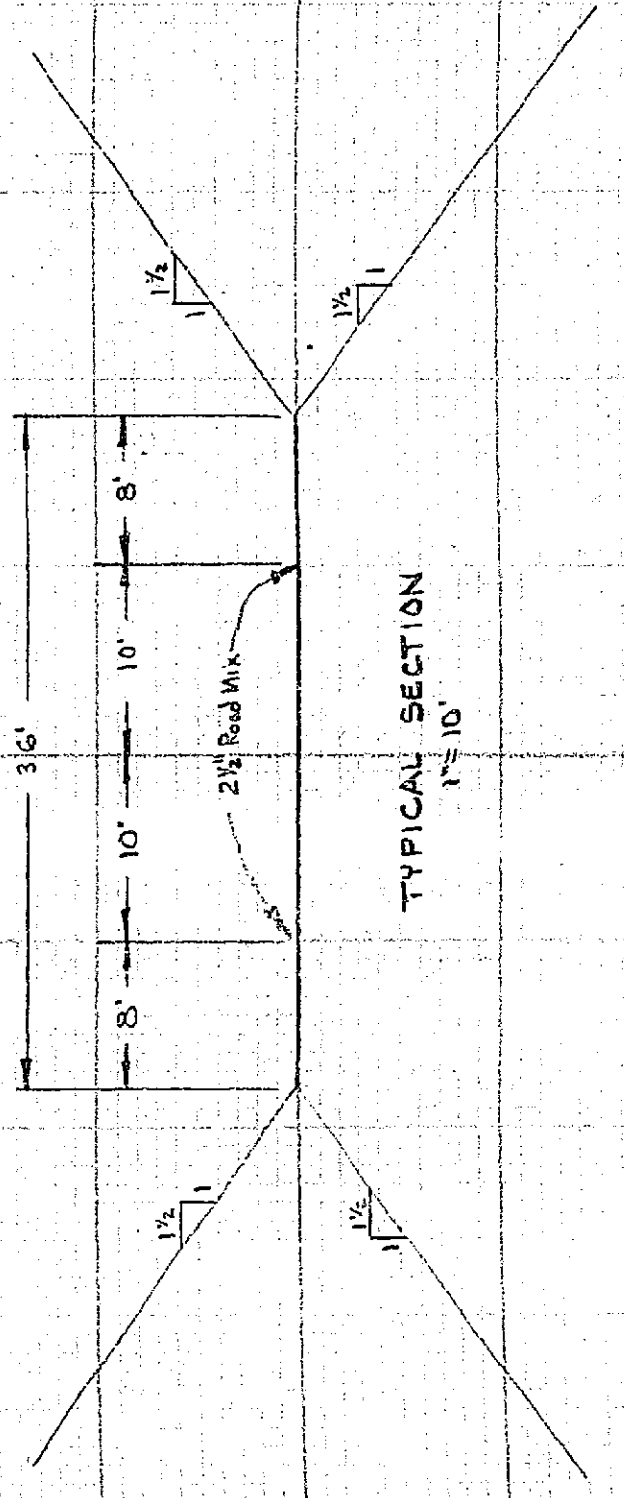

R-148

$\frac{11}{0.7} = 15.7$

repetition  
repetition

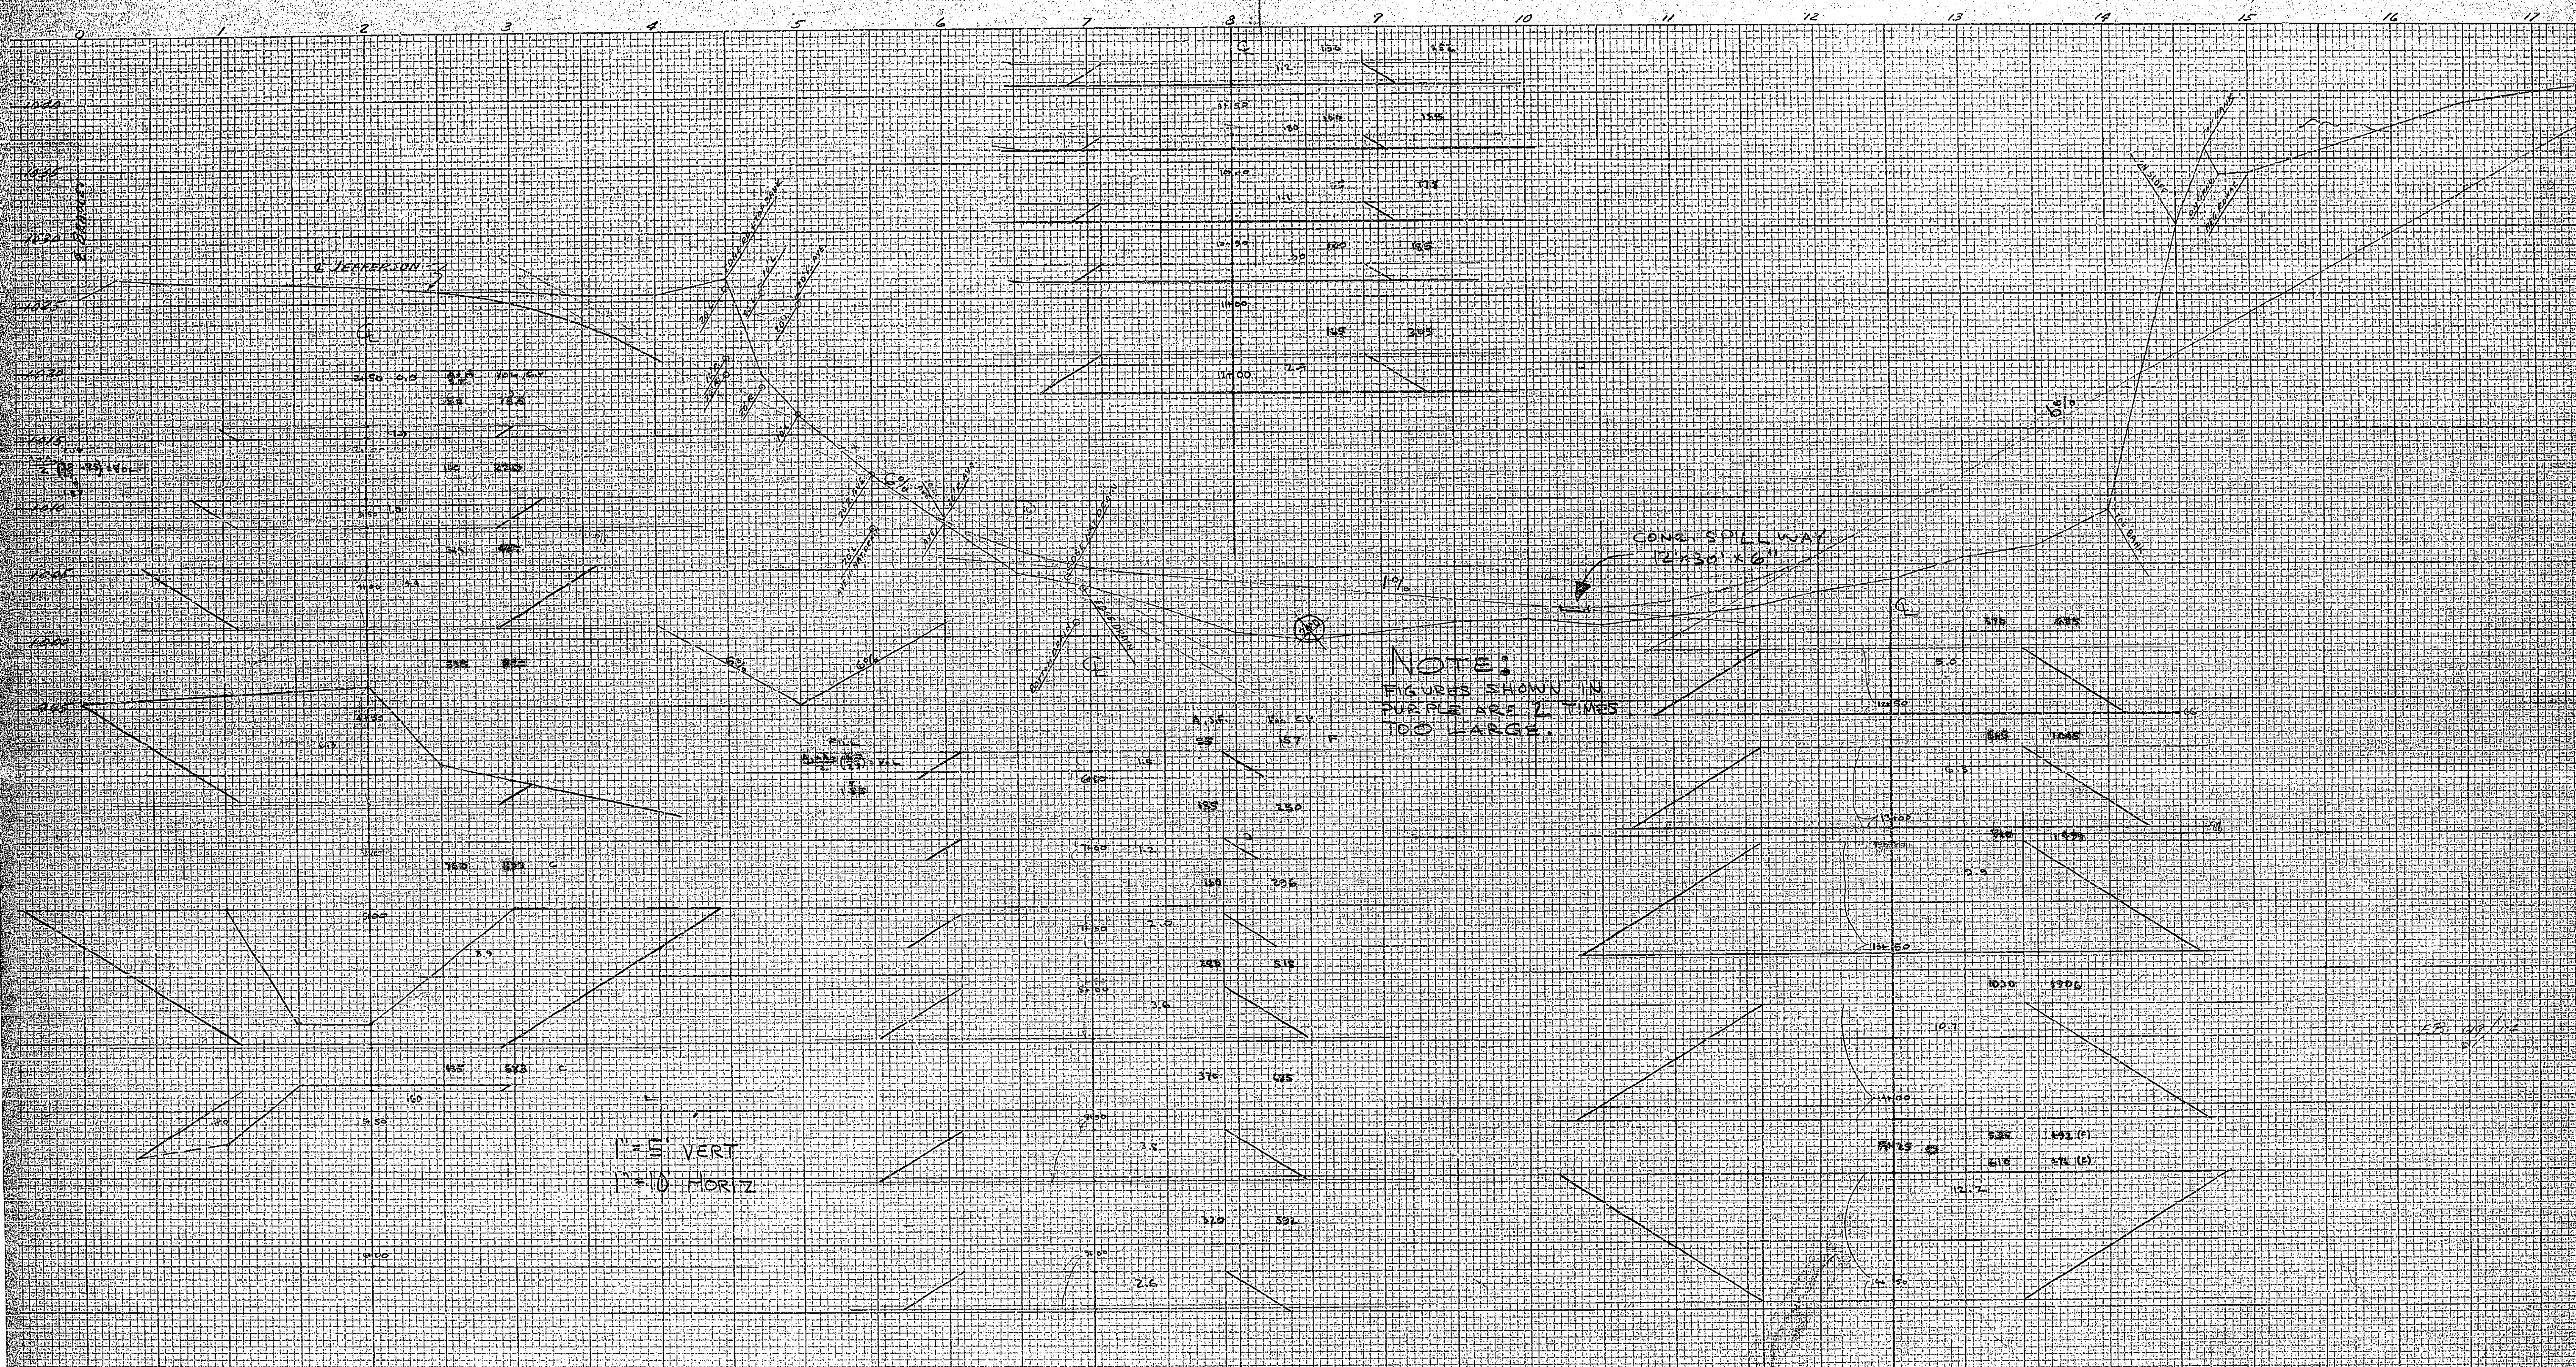

NOTE:  
 FIGURES SHOWN IN  
 PURPLE ARE 2 TIMES  
 TOO LARGE.

1" = 5' VERT  
 1" = 10' HORIZ

2170  
 540  
 1630

A. V. Jester  
 Office 5/11/61

Jefferson Sect.  
 R-148