

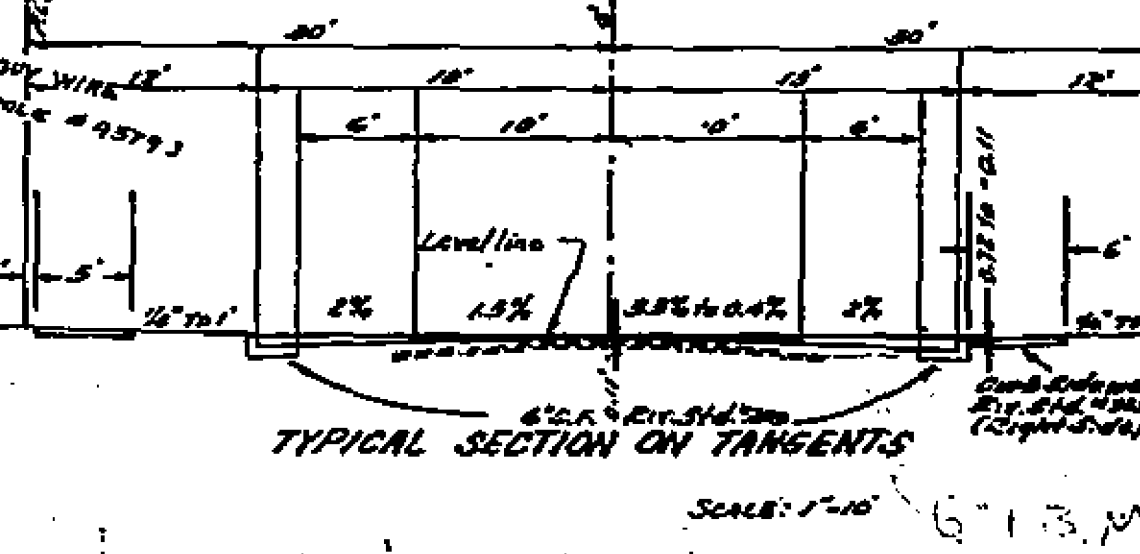


S.M. ELV 818.10 SPK. IN SW CB.  
RET. SCHOOL CIRCLE &  
CAROLINE CT.  
F.B. 606/26,55  
SCALE: HOR. 1" = 50'  
VERT. 1" = 5'

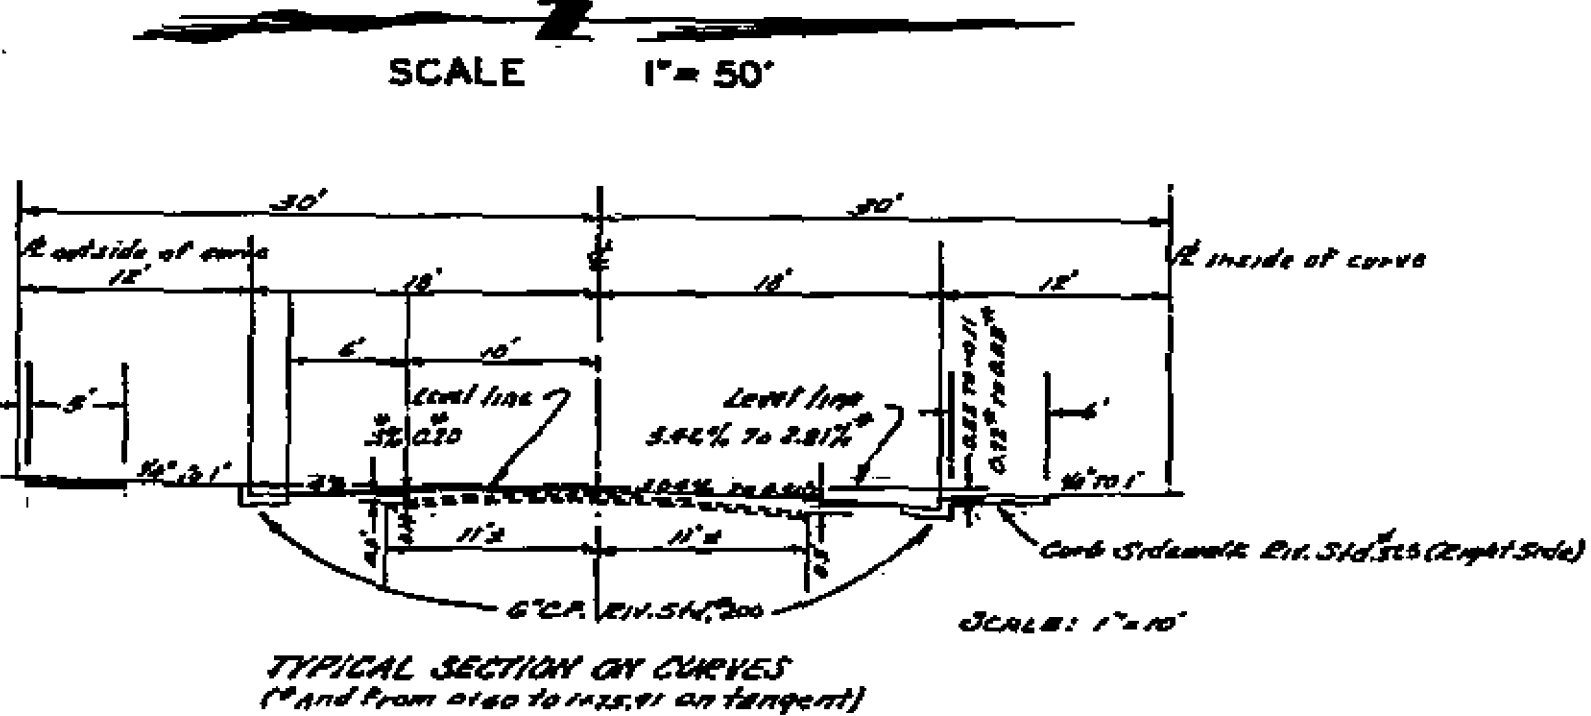


REVISIONS			CITY OF RIVERSIDE CALIFORNIA DEPARTMENT OF PUBLIC WORKS
MARK	DATE	DESCRIPTION	
①		W/ave Changed Slope - wdg	SCHOOL CIRCLE CURB AND GUTTER MAGNOLIA TO CENTRAL

DESIGNED BY W.D.G.	CHECKED BY J.L.B.	APPROVED BY	R-156
DRAWN BY R.L., C.N.		<i>[Signature]</i> DIRECTOR OF PUBLIC WORKS	
RECOMMENDED BY	ASSISTANT CITY ENGINEER	DATE Jan 13, 1958	


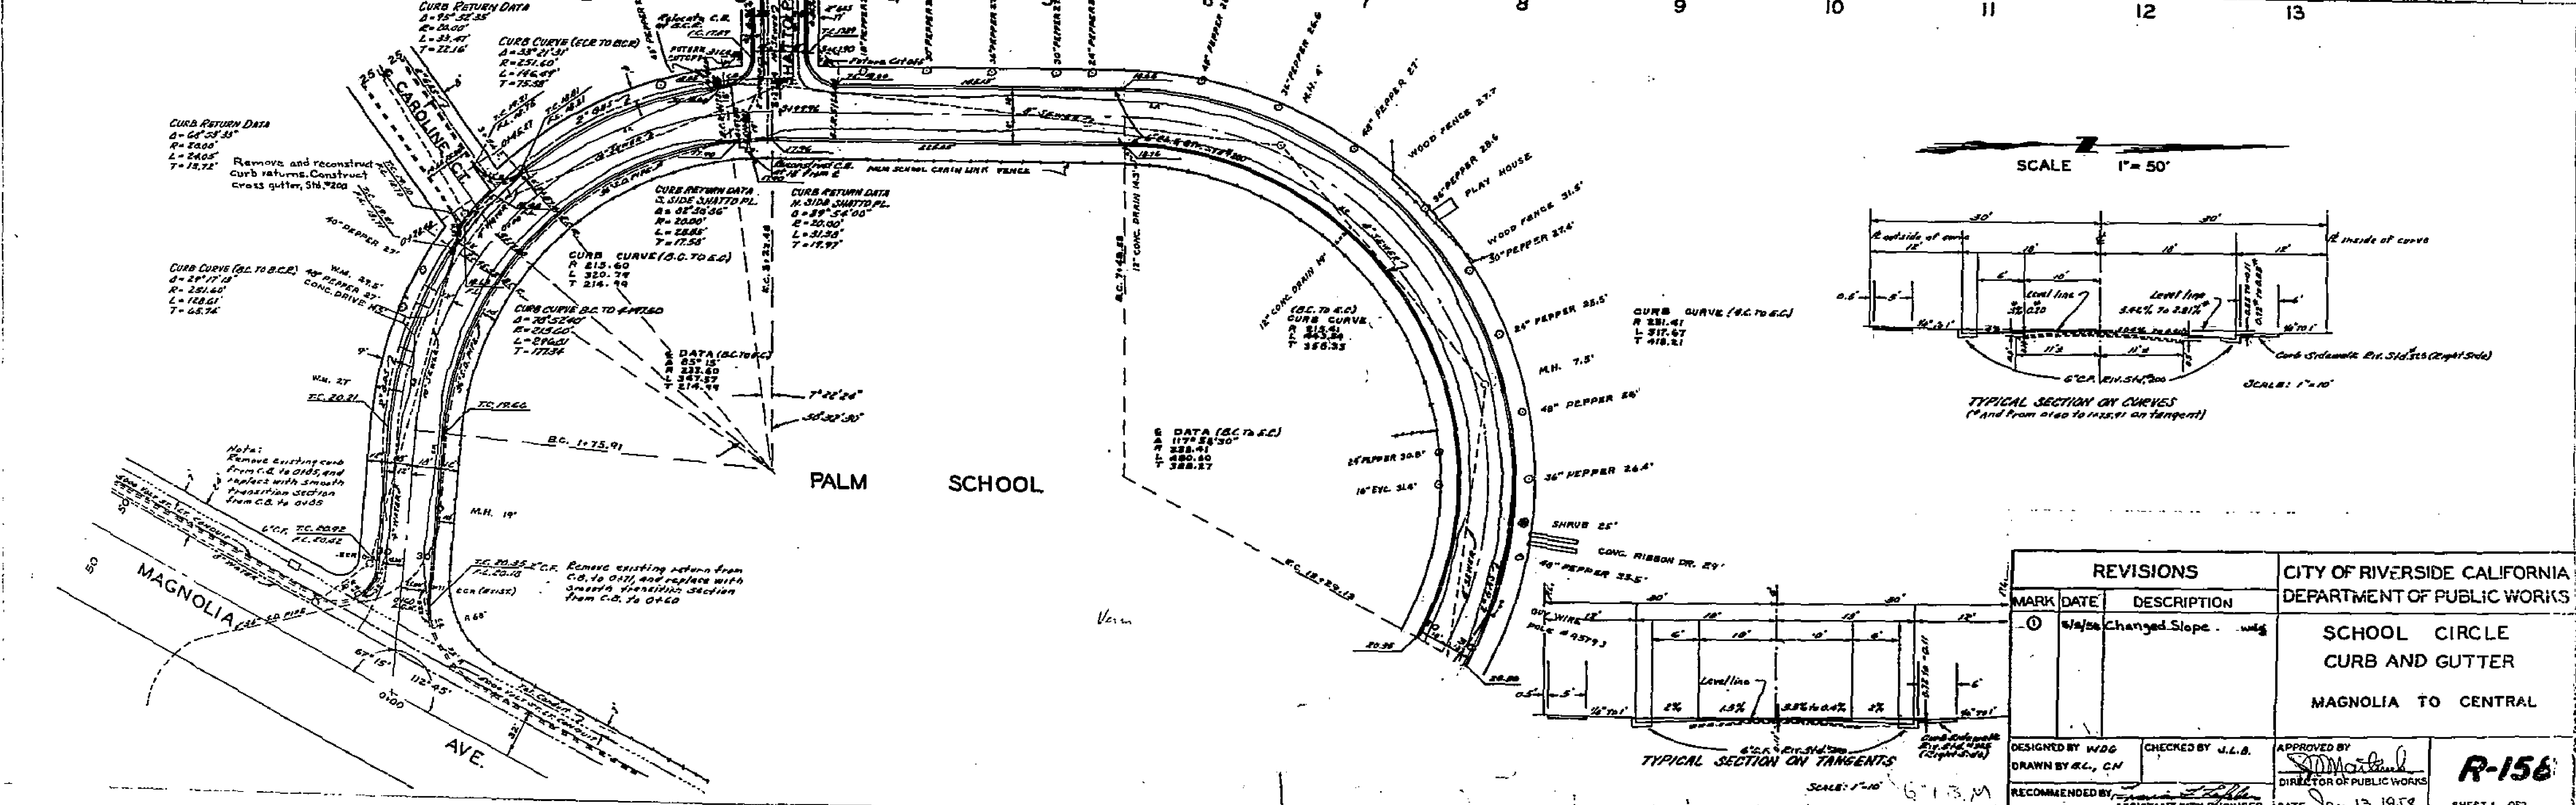


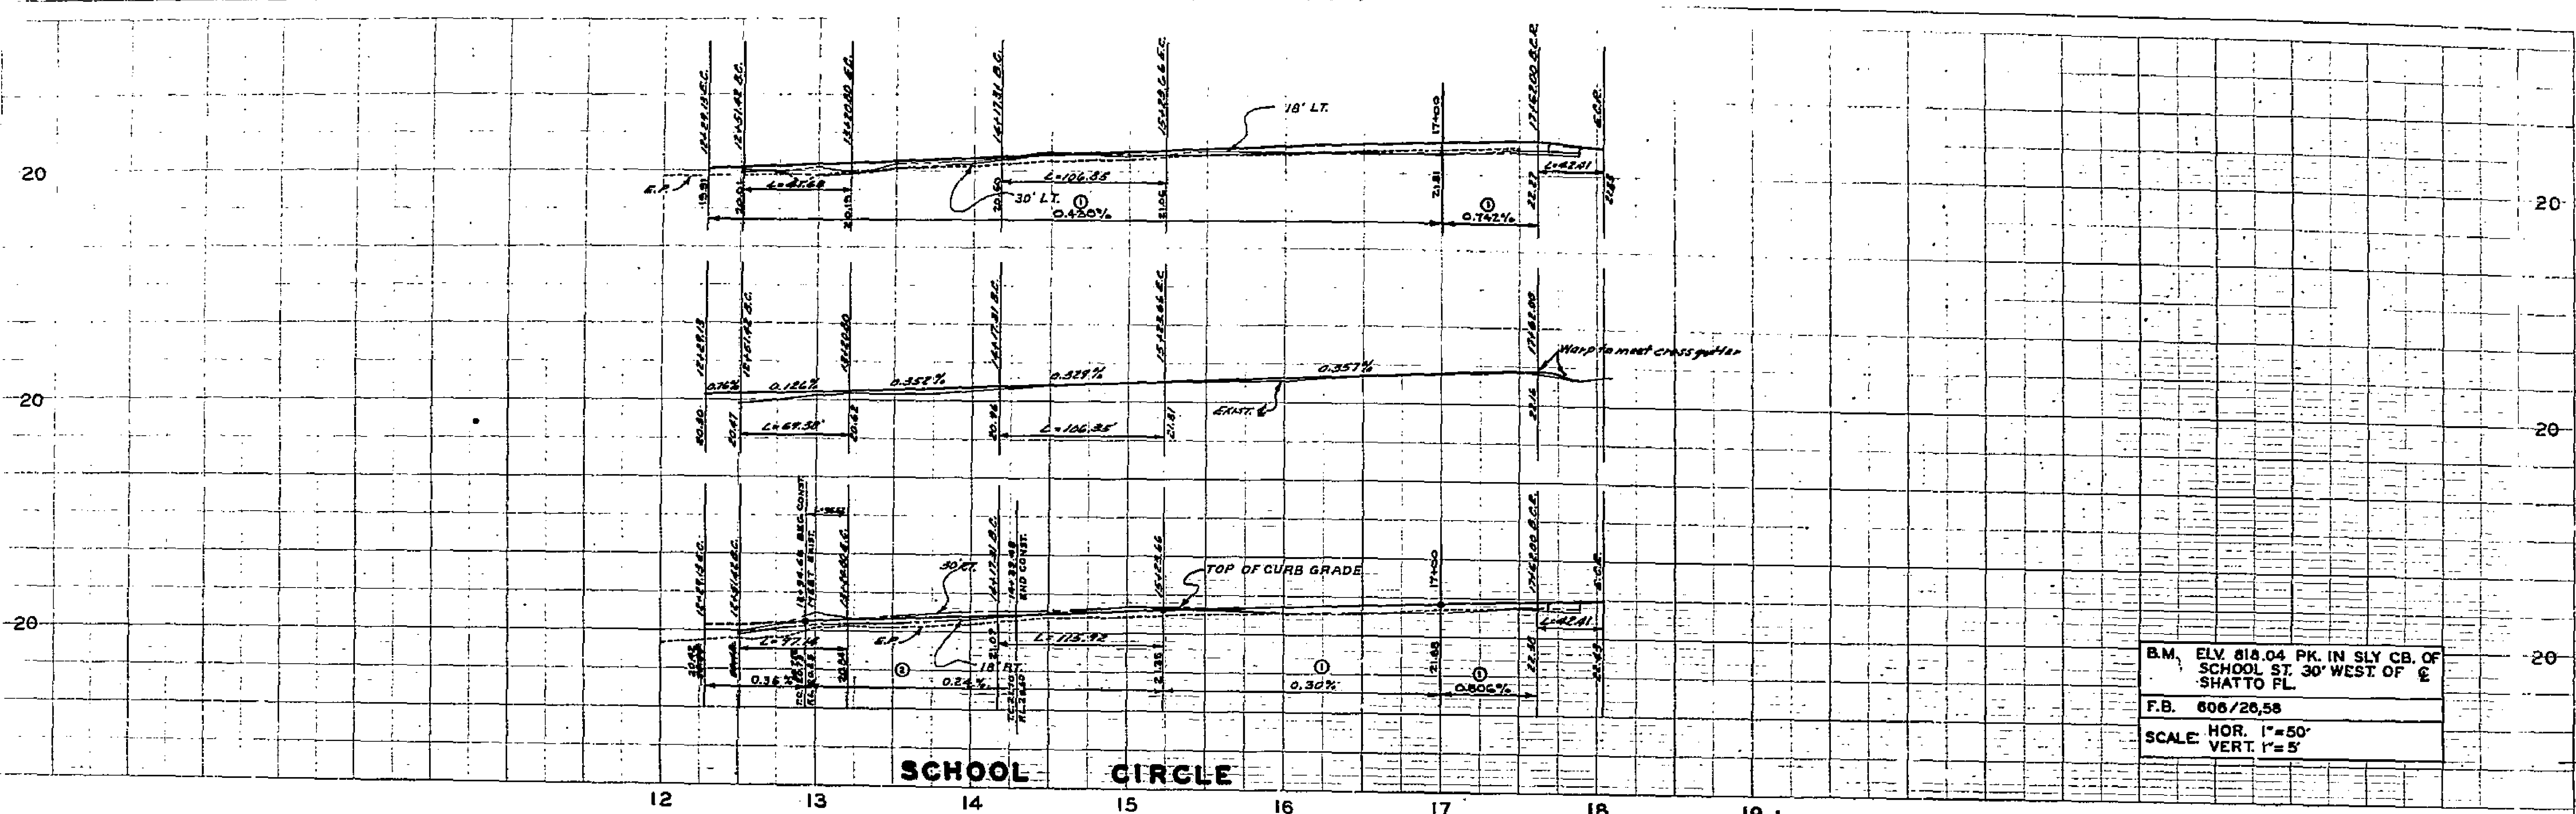

B.M. ELV. 818.04 PK. IN SLY CB. OF SCHOOL ST. 30' WEST OF SHATTO FL.  
 F.B. 606/26,58  
 SCALE HOR. 1"=50'  
 SCALE VERT. 1"=5'

SCALE 1"=50'

NOTE: CENTER LINE IS NOT CONCENTRIC WITH EITHER PROPERTY LINE AND PROPERTY LINES ARE NOT CONCENTRIC WITH EACH OTHER. CURBS ARE CONCENTRIC WITH CENTER LINE.

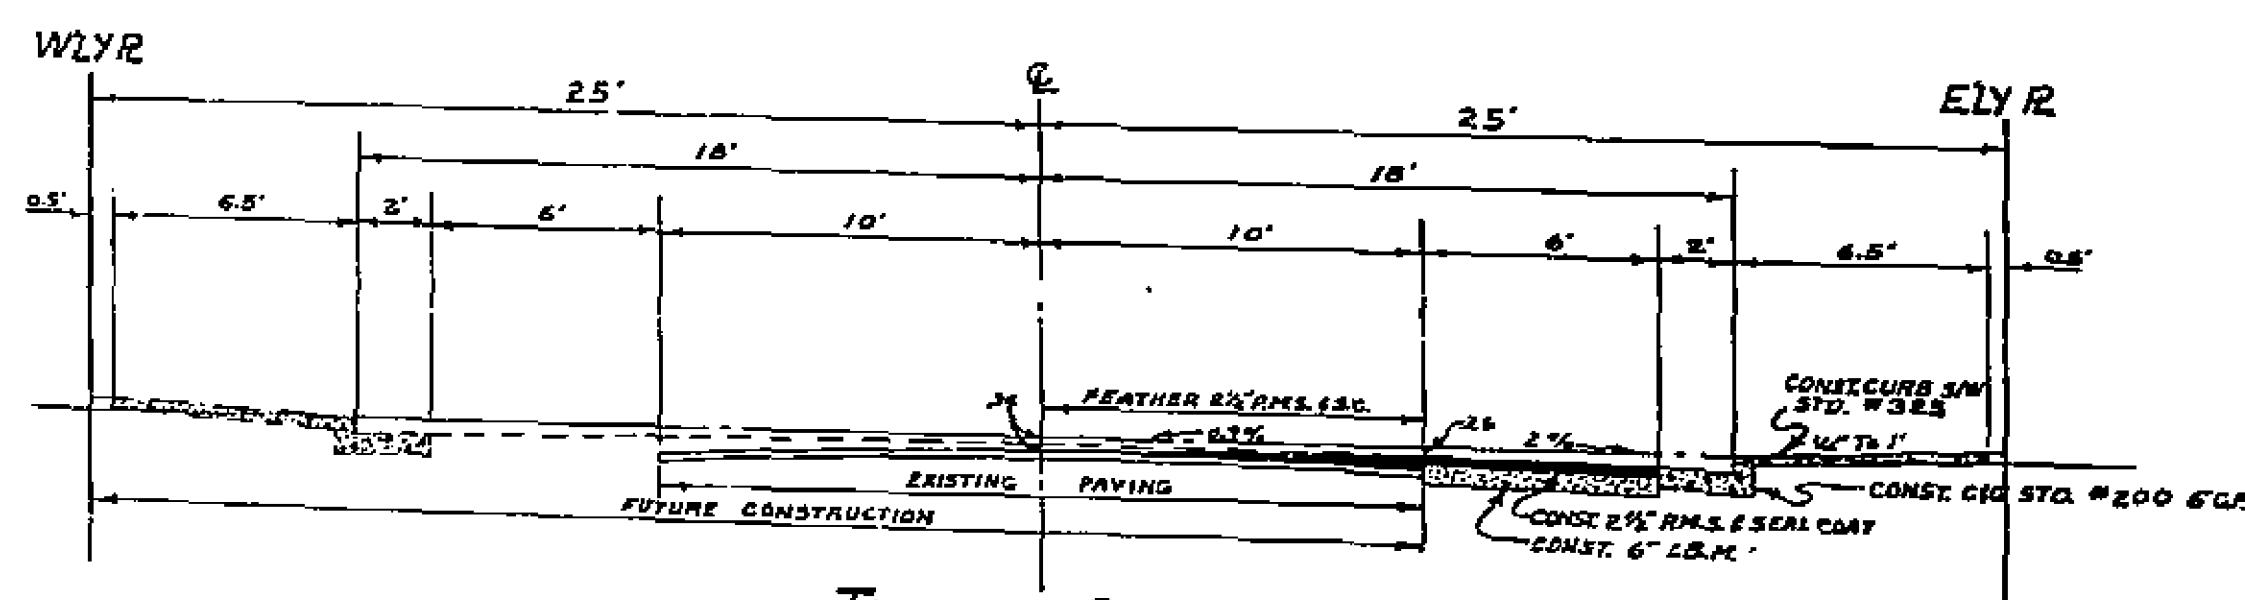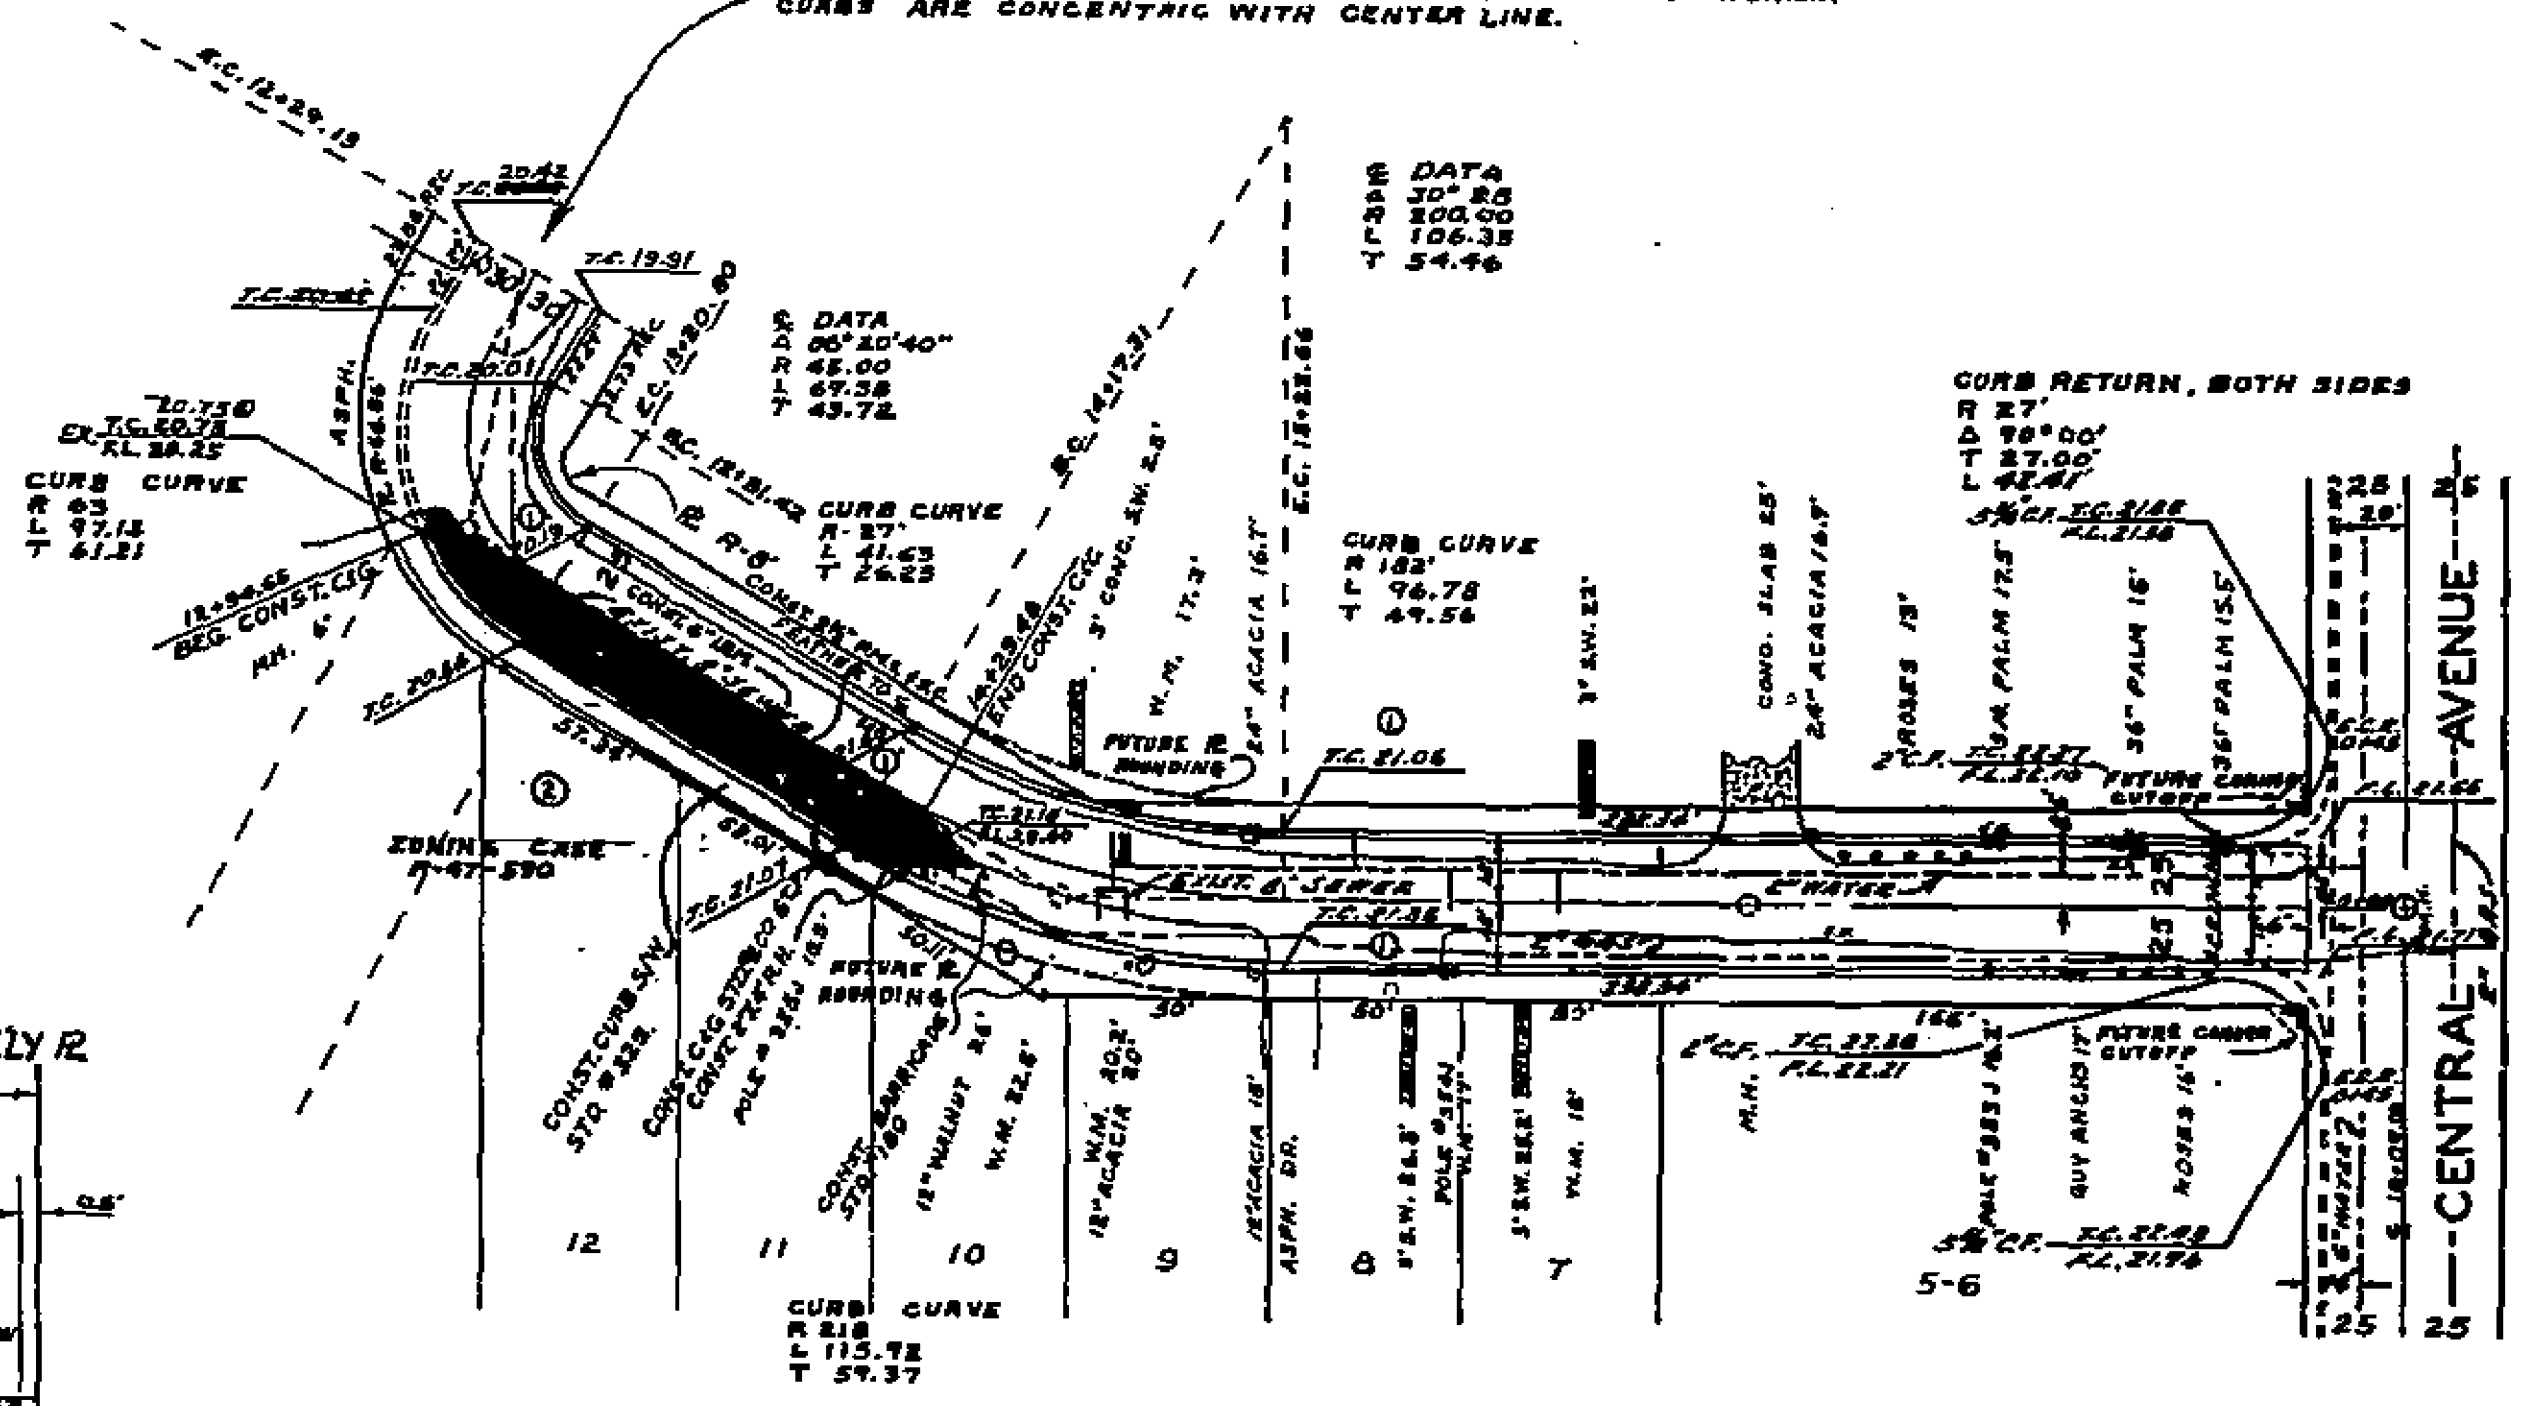

TYPICAL SECTION  
 STA. 14+00  
 SCALE: 1"=5'

Remove and reconstruct curb returns and cross gutter, Sta. 1220.

NOTE: It shall be the responsibility of the Contractor to clear the right of way in accordance with the provisions of the law as to effects each utility including irrigation lines and appurtenances and at no cost to the City.

REVISIONS		CITY OF RIVERSIDE CALIFORNIA DEPARTMENT OF PUBLIC WORKS
DATE	DESCRIPTION	
1/13/08	Change Slope wdg	SCHOOL CIRCLE CURB AND GUTTER MAGNOLIA TO CENTRAL
1/13/08	ADDED CONST. NOTES & TYPICAL SECTION B.L. 158	
DESIGNED BY W.G.	CHECKED BY J.L.B.	APPROVED BY
DRAWN BY A.L.C.M.		DIRECTOR OF PUBLIC WORKS
RECOMMENDED BY	ASSISTANT CITY ENGINEER	DATE Jan 13, 1908

R-158

SHEET 2 OF 2

