


- GENERAL NOTES**
- (1) IT SHALL BE THE RESPONSIBILITY OF THE CONTRACTOR TO CLEAR THE RIGHT OF WAY IN ACCORDANCE WITH THE PROVISIONS OF THE LAW AS IT AFFECTS EACH UTILITY, INCLUDING IRRIGATION LINES AND APPURTENANCES AND AT NO COST TO THE CITY.
 - (2) CONSTRUCTION SHALL BE IN ACCORDANCE WITH THE CITY OF RIVERSIDE, DEPARTMENT OF PUBLIC WORKS, STANDARD DRAWING N2 10.
 - (3) PAINT BINDER IS REQUIRED.
 - (4) PLACE 7/8" OF L.T.B. UNDER CURB & GUTTER, CROSS GUTTERS & APRONS.

- CONSTRUCTION NOTES**
- (200) CONSTRUCT CURB & GUTTER PER CITY OF RIVERSIDE STD DWG. 200 (3" CURB FACE)
 - (150) CONSTRUCT SIDEWALK PER CITY OF RIVERSIDE STD DWG. 350.
 - (220) CONSTRUCT CROSS GUTTER PER CITY OF RIVERSIDE STD DWG. 220.
 - (A) OVERLAY EXISTING PAVEMENT.
 - (B) PLACE 6" A.C. OVER 10 1/2" LIME TREATED BASE.
 - (C) PLACE 2 1/2" A.C. OVER NATIVE SOIL.
 - (D) PLACE 3" A.C. OVER 9" AGG. BASE, OR 2 1/2" A.C. OVER 10" L.T.B., OR 6 1/2" A.C. OVER NATIVE SOIL, OR 6" CONCRETE.

QUANTITY ESTIMATE

CURB & GUTTER	1019.6 L.F.
APRON & CROSS GUTTER	1343.5 SQ. FT.
SIDEWALK	2157.9 SQ. FT.
ASPHALT	772.2 TONS
LIME TREATED BASE	612.8 CU. YDS.
BORROW	380 CU. YDS.

9 BENCH MARK
 ELEV. 712.103
 DESCRIPTION: B.M. - P.K. NAIL IN S.E'LY C.B. RET. LA SIERRA AND MAGNOLIA E.B. 703/71.

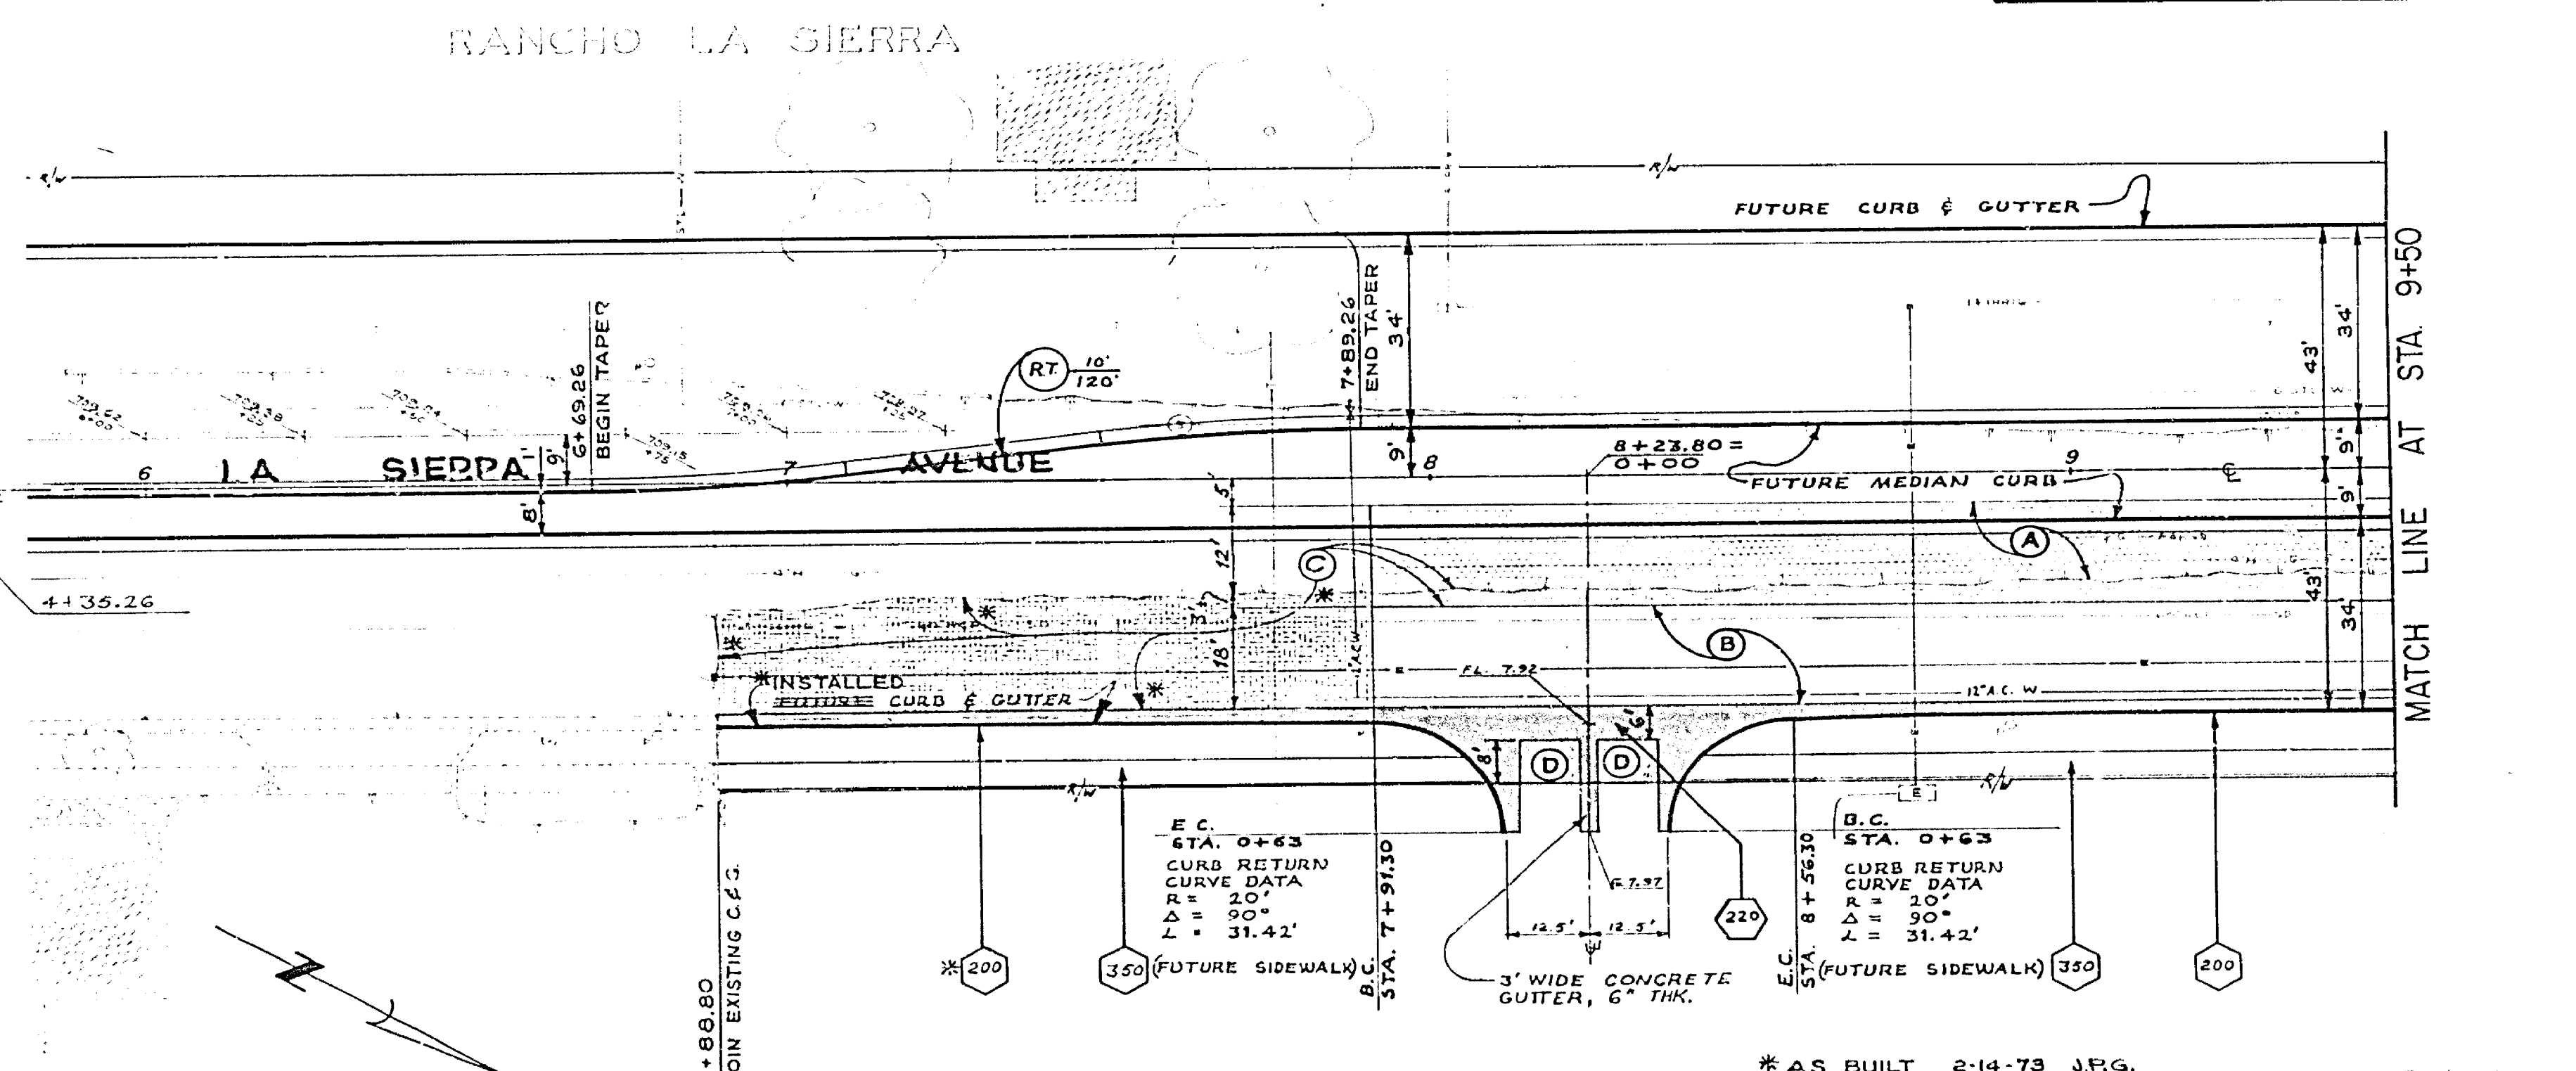

*AS BUILT 2-14-73 J.R.G.
LA SIERRA AVE.
 EAST SIDE
 250' NLY OF MAGNOLIA AVE.
 TO 150' SLY OF COCHRAN AVE.
 ACCOUNT NO 290
 DRAWING NUMBER
R-1592
 1 3

Anti R JCR#