


B.M. ELEV. 826.21 PK. IN NLY CB. INDIANA 2' WLY OF WLY SIDE D/W TO HSE. #9287 @ GIBSON
 B.M. ELEV. 832.26 PK. NAIL IN N. CB. INDIANA 1' W. CB. RET. JACKSON
 F.B. 621/48-52, 602/29-32, 76
 SCALE: HOR. 1"=50'
 VERT. 1"=5'

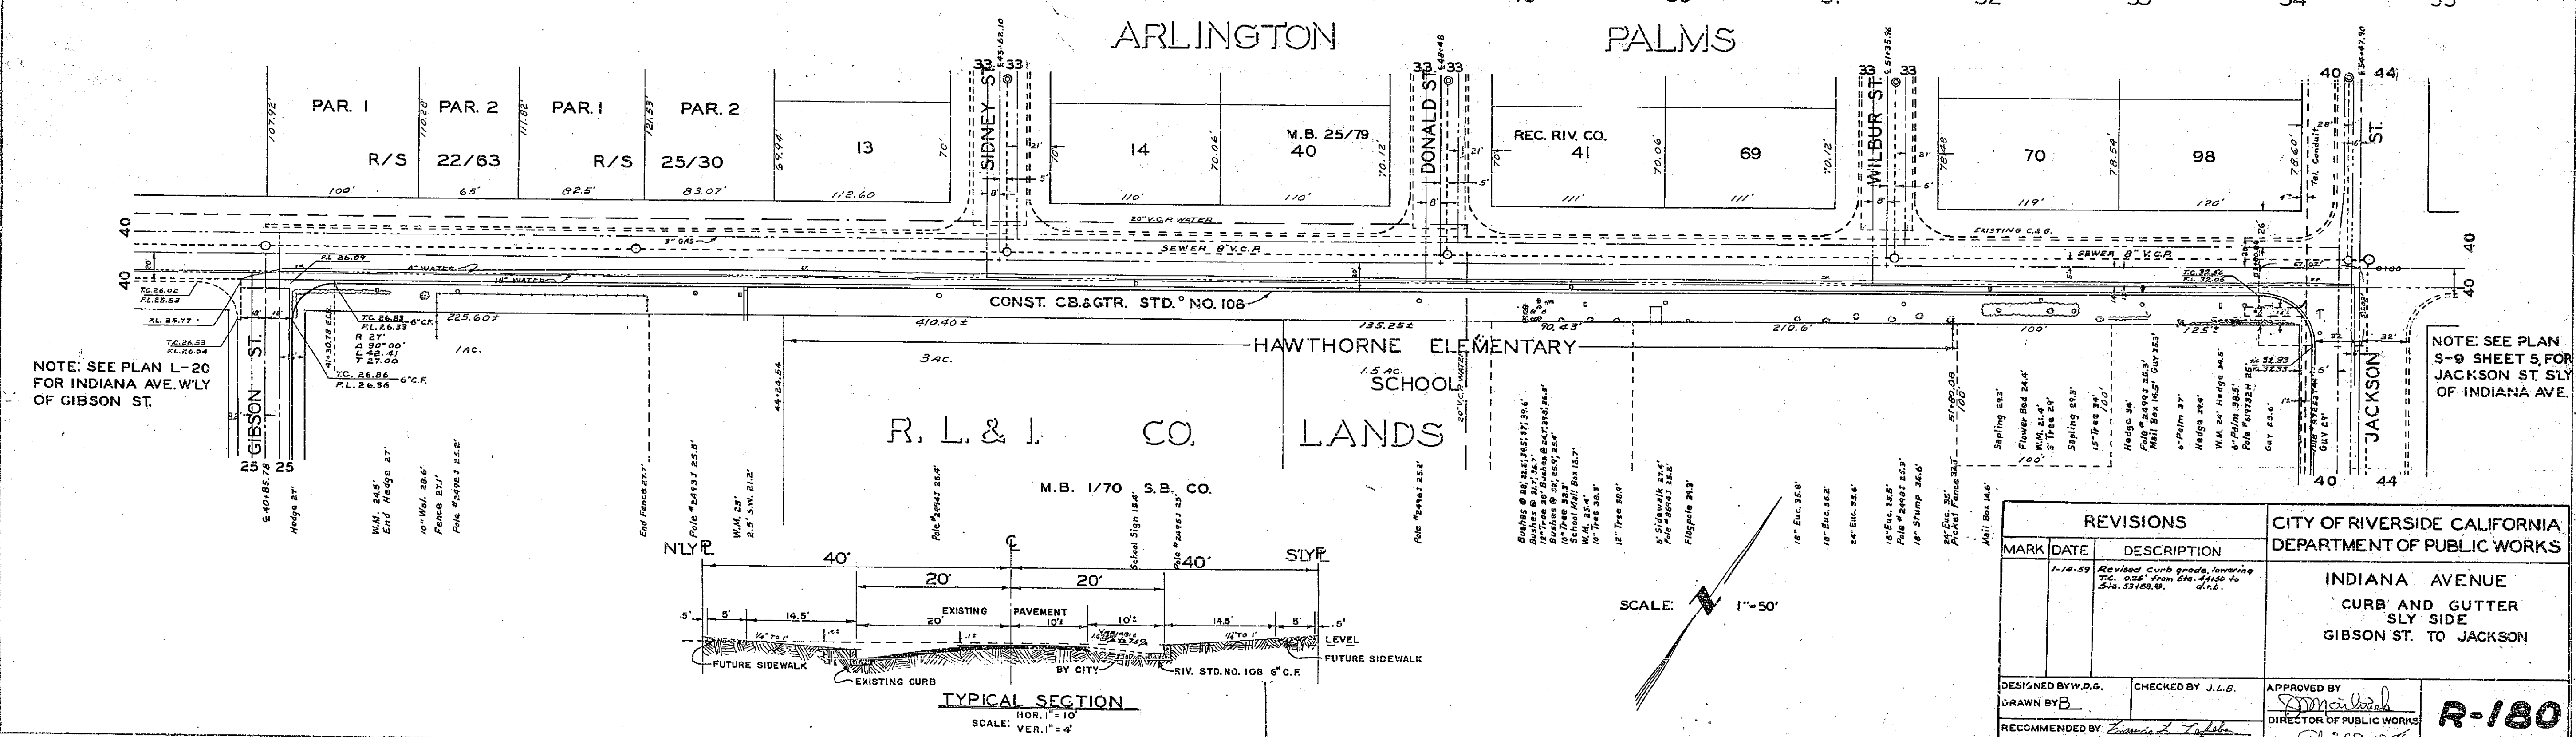


NOTE: SEE PLAN L-20 FOR INDIANA AVE. WLY OF GIBSON ST.

NOTE: SEE PLAN S-9 SHEET 5, FOR JACKSON ST. SLY OF INDIANA AVE.

REVISIONS		CITY OF RIVERSIDE CALIFORNIA DEPARTMENT OF PUBLIC WORKS
MARK	DATE	
	1-14-59	Revised Curb grade, lowering 2" on 24' from 266.446 to 264.446, d.n.s.

DESIGNED BY W.D.G.	CHECKED BY J.L.G.	APPROVED BY <i>[Signature]</i>	R-180
DRAWN BY <i>[Signature]</i>	RECOMMENDED BY <i>[Signature]</i>	DIRECTOR OF PUBLIC WORKS	
		ASSISTANT CITY ENGINEER	SHEET OF

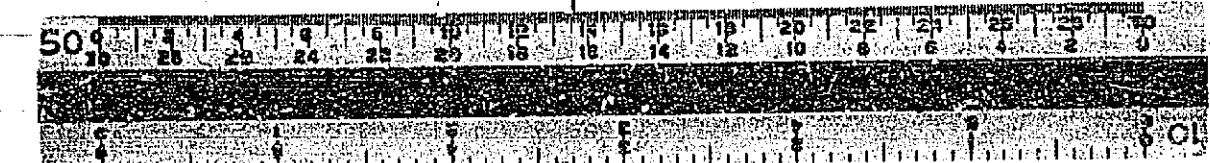

PROFILE	DATE
NO. 101	
NO. 102	
NO. 103	
NO. 104	
NO. 105	

PLAN	DATE
NO. 101	
NO. 102	
NO. 103	
NO. 104	
NO. 105	