


- GENERAL NOTES**
- CONSTRUCTION SHALL BE IN ACCORDANCE WITH THE CITY OF RIVERSIDE DEPARTMENT OF PUBLIC WORKS STANDARD DRAWINGS AND PER STANDARD SPECIFICATIONS FOR PUBLIC WORKS CONSTRUCTION, 1976 EDITION.
 - IT SHALL BE THE RESPONSIBILITY OF THE CONTRACTOR TO CLEAR THIS RIGHT-OF-WAY IN ACCORDANCE WITH THE PROVISIONS OF LAW AS IT AFFECTS EACH UTILITY INCLUDING IRRIGATION LINES AND APPURTENANCES AND AT NO COST TO THE CITY.
 - ALL FLAGGED ELEVATIONS SHALL BE STAKED IN THE FIELD BY THE ENGINEER.

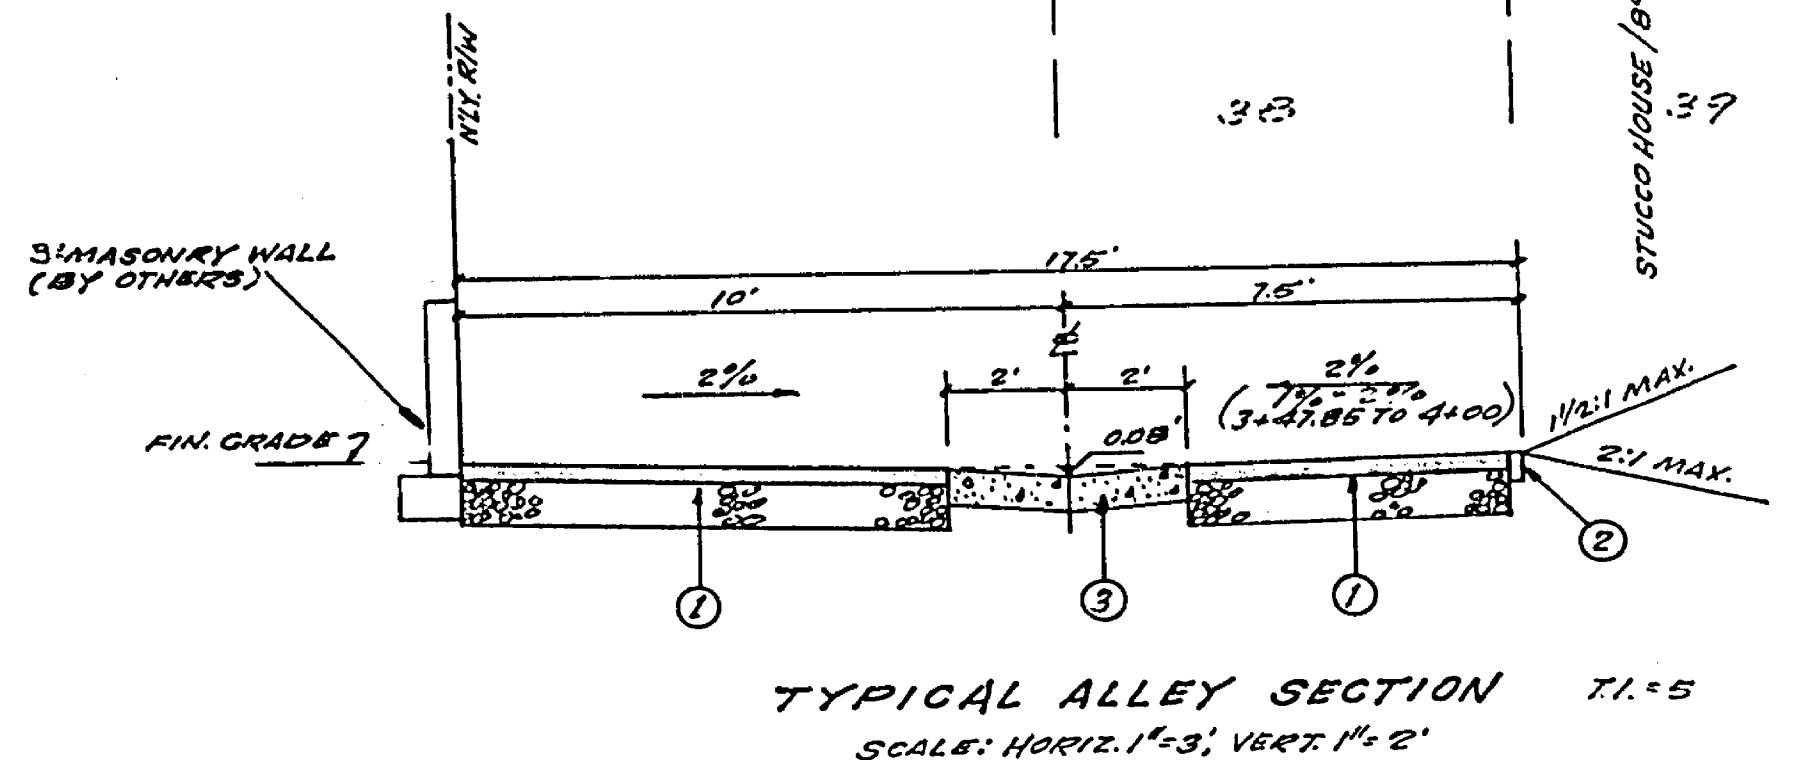

- CONSTRUCTION NOTES**
- CONST. 2 1/2" A.C. OVER 8" D.G. BASE
 - CONST. 2 1/2" REDWOOD HEADS
 - CONST. ALLEY VALLEY GUTTER PER STD. DWG. NO.

HAWKINS, ROBERTSON & ASSOC.
 ENGINEERS & SURVEYORS
 RIVERSIDE CALIFORNIA
 Charles E. Robertson 11/18/76
 R.C.E. 15016 DATG

NO.	REVISIONS	DATE
1	CHANGED WALL HEIGHT FROM 4' TO 3' 2"	

CITY OF RIVERSIDE, CALIFORNIA
 DEPARTMENT OF PUBLIC WORKS
 APPROVED BY: [Signature]
 OFFICE ENGINEER
 PARK DEPARTMENT
 TRAFFIC DIVISION
 PERMANENT CITY ENGINEER

PLAN & PROFILE
ALLEY
 FROM 347.85' EAST OF TO 496.86'
 EAST OF EUCALYPTUS STREET.
 C-16-767 & 2200 UNIVERSITY AVS.
 BENCH MARK TOP OF P.C.C. MON. AT INT.
 OF 9TH ST. & EUCALYPTUS ST.
 CITY RB. 530/AT & R-1766 5164.916.89
 *AS BUILT 3-77 KPT
 PROJECT NO. R-1940
 SHEET 1 OF 1
 FILE NO. 76-2680
 HORIZ. SCALE: 1" = 20'
 VERT. SCALE: 1" = 4'