


- 1 CONSTRUCT 3" A.C. OVER 6" D.G. BASE
- 2 OVERLAY EXISTING PAVEMENT WITH VARIABLE THICKNESS A.C. TO LIMITS SHOWN ON PLAN.
- 3 GRADE WALKWAY AND DRIVEWAYS TO LIMITS SHOWN ON PLAN.
- 4 RELOCATE FENCE.
- 5 REMOVE EXISTING PAVEMENT AND REPLACE AS NOTED.
- 200 CONSTRUCT CURB AND GUTTER PER STD. DWG. NO. 200. 6" C.F. EXCEPT WHERE SHOWN IN PROFILE AT STA. 11+50.
- 302 CONSTRUCT DRIVEWAY APPROACH PER STD. DWG. NO. 302.
- 410 CONSTRUCT CURB OUTLET PER STD. DWG. NO. 410.

BENCH MARK:
 ELEV. 944.502 BM G6B
 BRASS DISC. CAPPED & INTER-SECTION MARY & VICTORIA PER PRECISE B.M. BOOK.

- CONSTRUCTION NOTES:**
- CONSTRUCTION SHALL BE IN ACCORDANCE WITH THE CITY OF RIVERSIDE, DEPARTMENT OF PUBLIC WORKS, STANDARD DRAWINGS, AND THE STANDARD SPECIFICATIONS FOR PUBLIC WORKS CONSTRUCTION, 1976 EDITION.
 - TRIM EDGE OF EXISTING PAVEMENT WHERE NEW PAVEMENT JOINS TO A SMOOTH, STRAIGHT LINE. CONSTRUCT MATCH-UP PAVING AS SHOWN ON PLAN AND OVERLAY PAVING AS DIRECTED IN THE FIELD TO PRODUCE A SMOOTH SECTION.

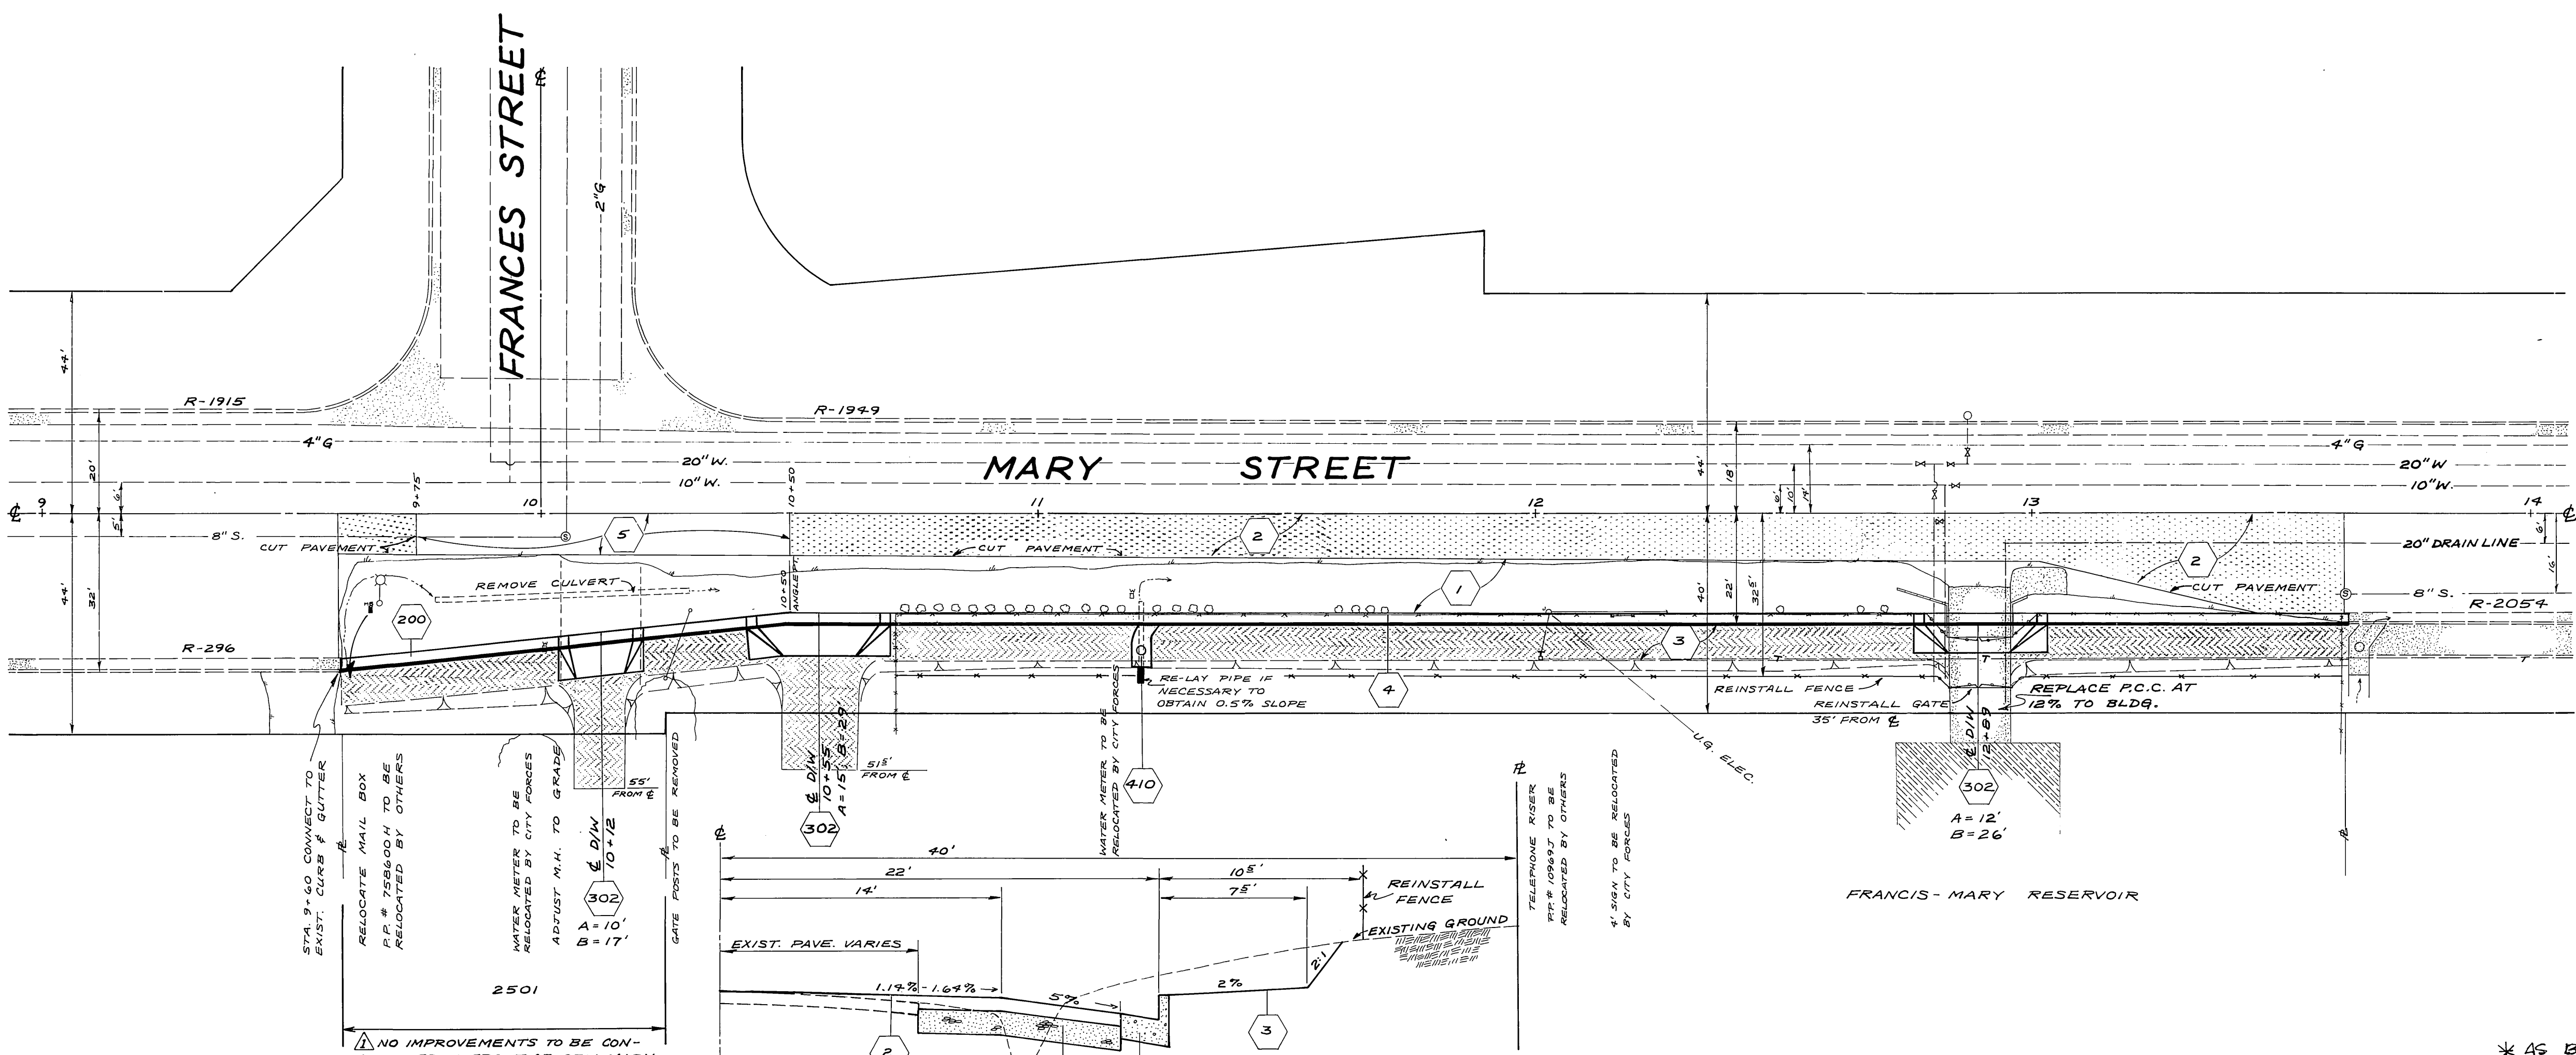

TYPICAL SECTION - MARY ST.
 NOT TO SCALE
 T.I. = 6

-CAUTION-
 PACIFIC TELEPHONE CABLES UNDERGROUND BEFORE EXCAVATING
 CALL COLLECT: 714-633-0811
 After Hours: 714-547-6606
 Orange County: 714-633-0811
 Riverside County: 714-684-0071

CITY OF RIVERSIDE PUBLIC WORKS DEPARTMENT		* AS BUILT 12-19-79 BLP INDEXED R/W
APPROVED BY: [Signature] PRINCIPAL ENGINEER: [Signature] PARK DEPARTMENT: [Signature] TRAFFIC DIVISION: [Signature] CHIEF P.W. ENGINEER: [Signature] WATER DIV. PUD: [Signature]		MARY STREET WIDENING - AT FRANCIS-MARY RESERVOIR
DESIGNED BY: [Signature] DRAWN BY: [Signature] CHECKED BY: [Signature]		R-2172 SHEET 1 OF 1
DATE: 3/20/79		HORIZ. SCALE: 1" = 20' VERT. SCALE: 1" = 4' FILE NO.