



912  
910  
908


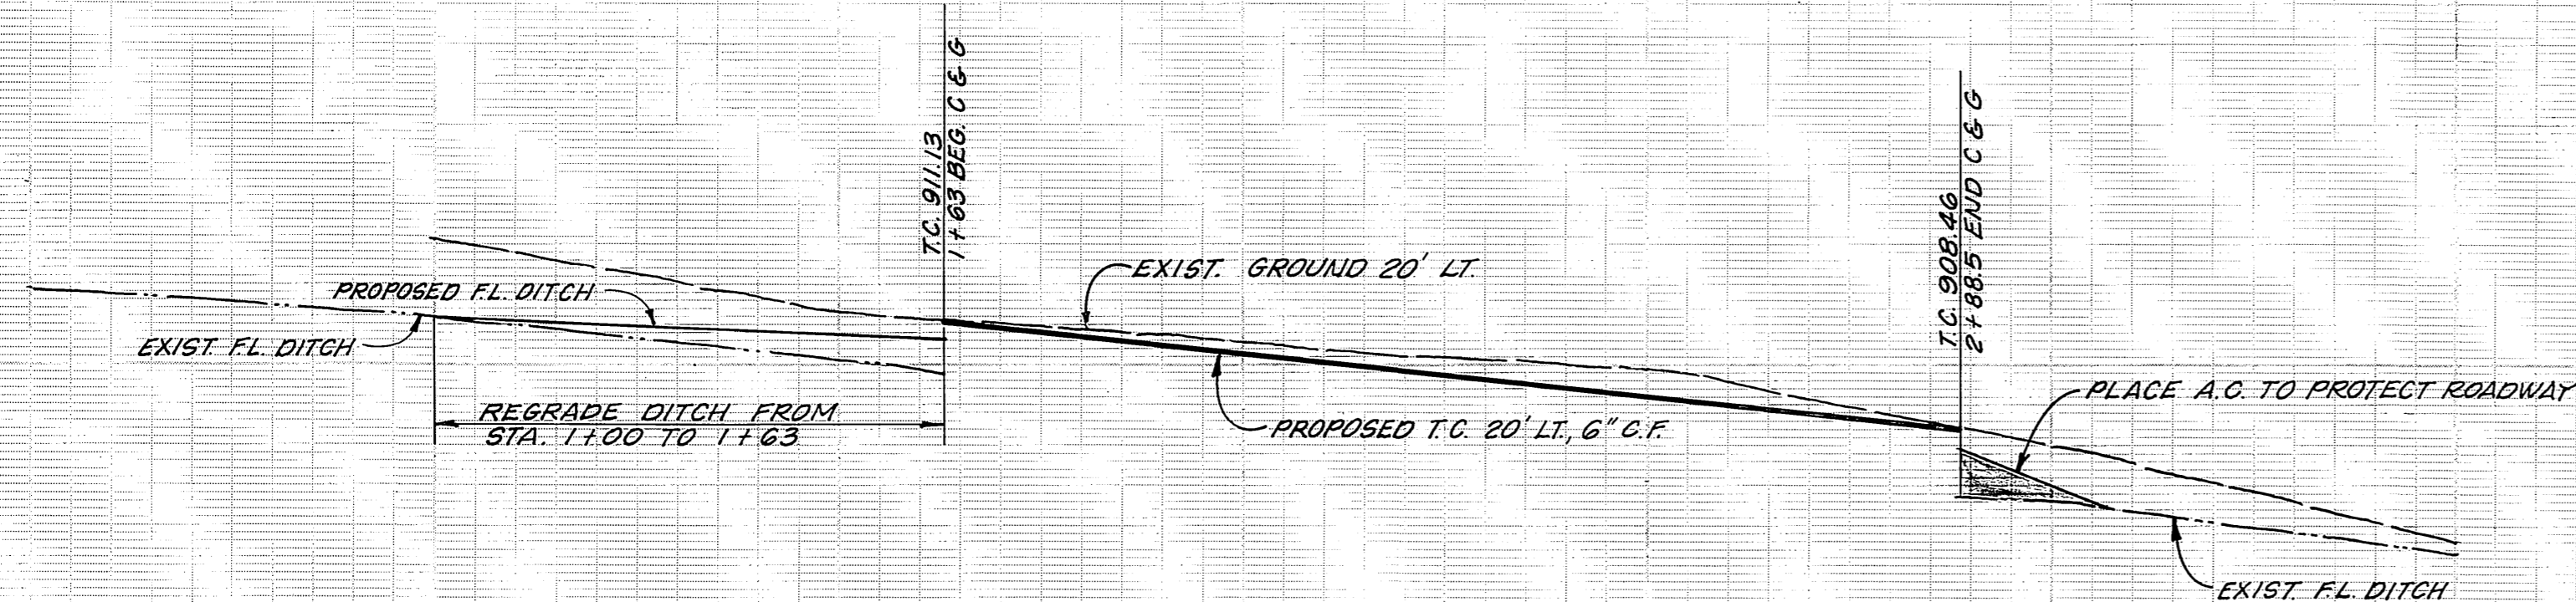


910  
908  
906

912  
910  
908

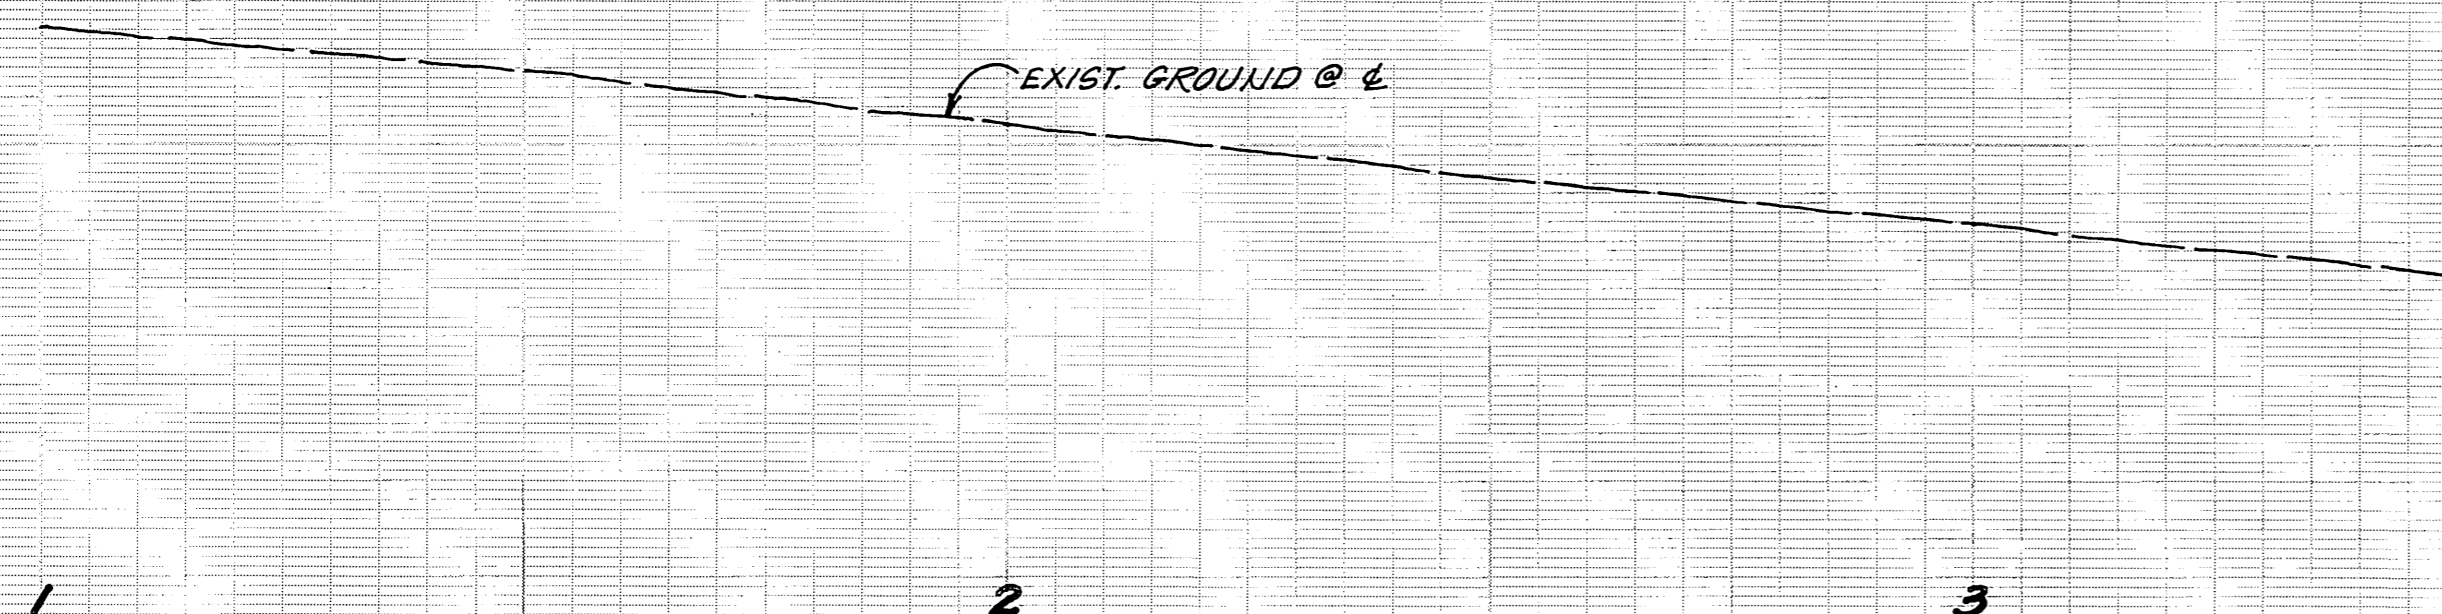

910  
908  
906

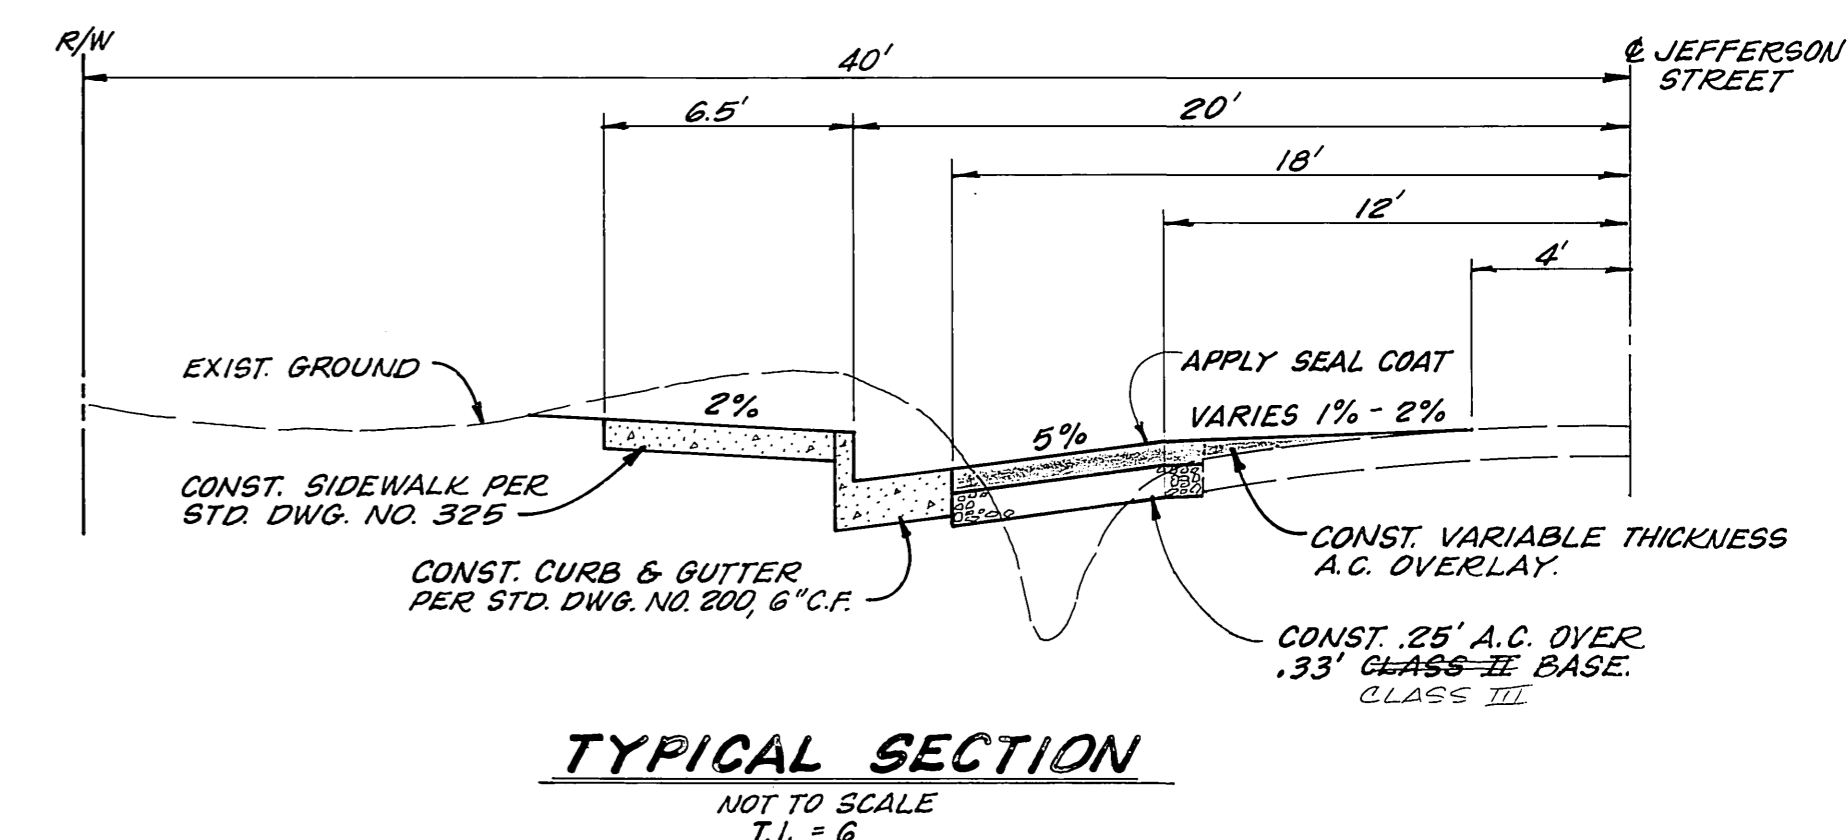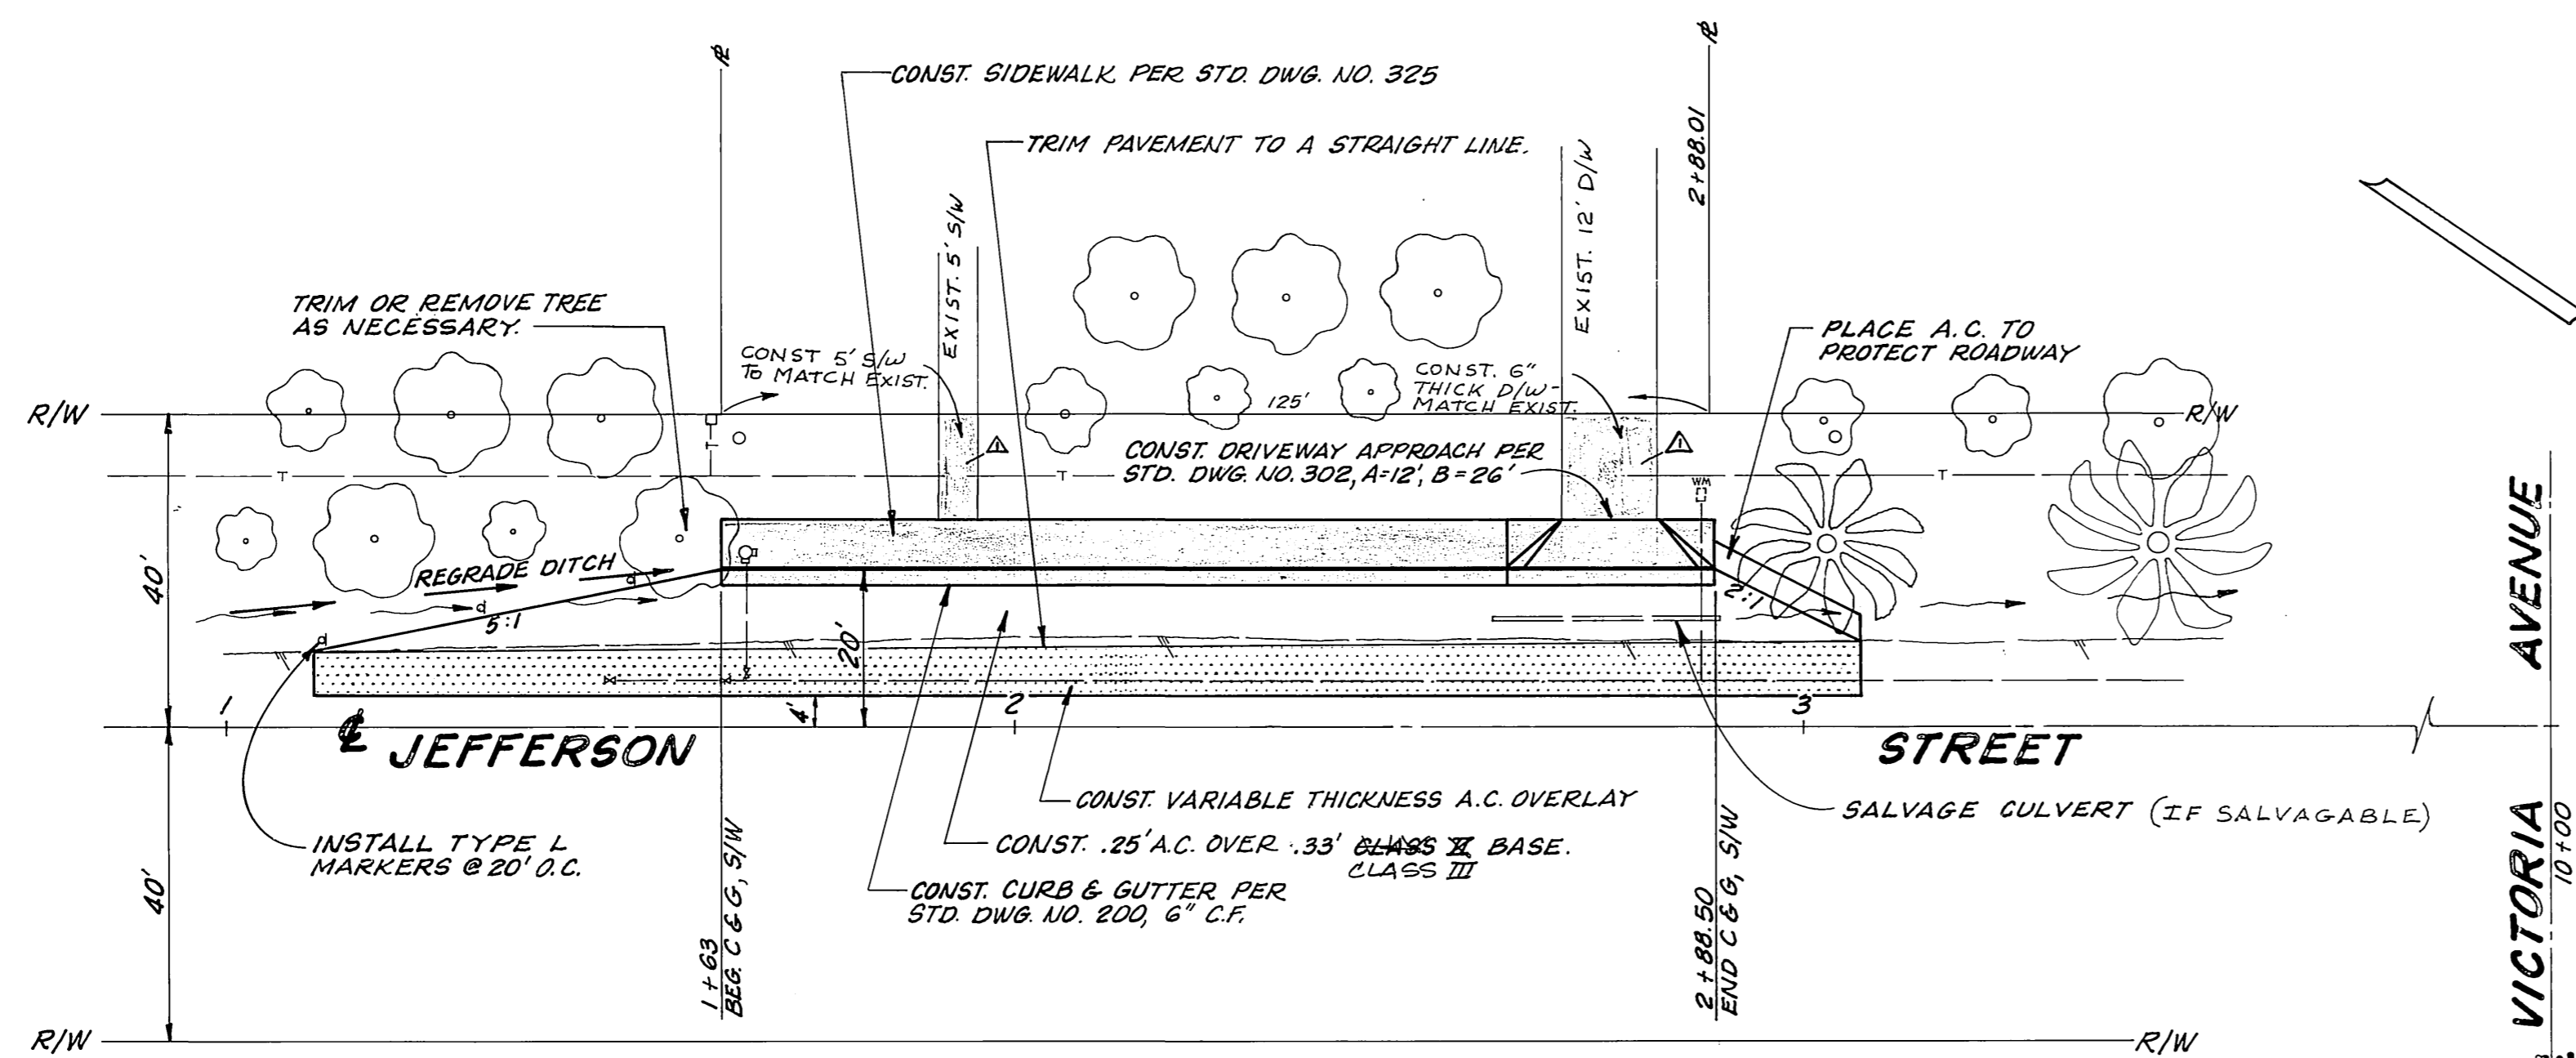

**CONSTRUCTION NOTES**

1. CONSTRUCTION SHALL BE IN ACCORDANCE WITH STANDARD SPECIFICATIONS FOR PUBLIC WORKS CONSTRUCTION, 1976 EDITION AND CITY OF RIVERSIDE STANDARD DRAWINGS.

<p style="text-align: right;">* AS BUILT 10-27-81 BRET</p> <p style="text-align: right;">Indexed RMF</p>		<p>ACCOUNT NO. 33-580-575</p>
<p><b>CITY OF RIVERSIDE</b> PUBLIC WORKS DEPARTMENT</p>		<p><b>JEFFERSON ST. WIDENING</b> <b>FOR FIRE STATION NO. 10</b></p>
<p>APPROVED BY</p> <p>PRINCIPAL ENGINEER <i>[Signature]</i></p> <p>PARK DEPARTMENT</p> <p>TRAFFIC DIVISION</p> <p>CHIEF P.W. ENGINEER</p>	<p>APPROVED BY</p> <p>PUBLIC WORKS DIRECTOR <i>[Signature]</i></p>	<p>R-2193</p> <p>SHEET 1 OF 1</p> <p>FILE NO.</p>
<p>DESIGNED BY <i>[Signature]</i></p> <p>DRAWN BY <i>[Signature]</i></p> <p>CHECKED BY</p>	<p>DATE 2/10/79</p>	<p>HORIZ. SCALE: 1" = 20'</p> <p>VERT. SCALE: 1" = 4'</p>