


Ref. No.	Street	Limits	Total Length (L.F.)	D/C S/W (S.F.)	P/C D/W (S.F.)	A.C. S/W & D/W (L.F.)	Berm (L.F.)	Wheelchair Ramps	Remarks
1	Streeter	Mountain View To Exist. S/W W/V	280	-	-	34	75	1	A.C. Place 6" A.C. S/W with Type I berm from Mountain View to drainage inlet approx. 25' W/V. Place 2" x 2" curb trap at Mountain View and meet top of exist. concrete adjacent to inlet. From this inlet, transition to 2% slope to align with the existing curb to the north, with 6 ft. A.C. S/W behind Type III berm, then meet exist. S/W approx. 280 ft. W/V of Mountain View. Grade behind new A.C. S/W to drain toward the street. (See Typical Section)
2	Victoria	At 5216 (opposite Dwyer)	235	E'y	-	20	-	-	Place 25 L.F. of 5" A.C. S/W to trans. between exist. P.C.C. P.L. S/W at 5200 Victoria and exist. P.C.C. D/W N'y. Place 150 L.F. of 6" A.C. S/W along exist. E.P. or berm between exist. P.C.C. D/W and 330 feet N'y. *100' of 2" x 2" curb.
3	Campbell	Norwood to Jones	1321	S'y	-	177	850	111	Place 390 L.F. of 5" A.C. S/W between exist. P.C.C. P.L. S/W at 1116 Campbell. Then trans. to E.P. and place 850 L.F. of 6" A.C. S/W with Type III berm continuing W'y to Norwood. Place a total of 390 L.F. ("B" dimension) of A.C. D/W approaches at exist. D/W locations.
4	Campbell	Bolivar to La Sierra	669	S'y	3384	750	-	3	Place 564 L.F. of 6" P.C.C. curb S/W between exist. 5" W'y of Clara to La Sierra. Place the wheelchair ramps at Clara and at La Sierra. Place 188 L.F. of 4" P.C.C. S/W adjacent to exist. fence. On E'y side of the fence, begin 6" P.C.C. curb S/W and meet exist. D/W's. Approx. 310' W'y of Runney to Runney, place a total of 305 L.F. of 6" P.C.C. S/W. An exist. retaining wall will require the S/W to be narrowed to 3' wide for 94 L.F. The remainder will be 6' wide. Place P.C.C. wheelchair ramps at freeway overpass, Olivewood, driveway approx. 600' W'y of Runney, and the W'y side of Runney. Move back the sprinklers between freeway overpass and Olivewood. Narrow S/W 3.5' min. at trees.
5	Central	Freeway to Runney	685	N'y	9367	-	-	6	Between freeway overpass and Olivewood, place 135 L.F. of 6" P.C.C. curb S/W. Place 422 L.F. of 6" P.C.C. curb S/W. From just E'y of the centerline, place 188 L.F. of 4" P.C.C. S/W adjacent to exist. fence. On E'y side of the fence, begin 6" P.C.C. curb S/W and meet exist. D/W's. Approx. 310' W'y of Runney to Runney, place a total of 305 L.F. of 6" P.C.C. S/W. An exist. retaining wall will require the S/W to be narrowed to 3' wide for 94 L.F. The remainder will be 6' wide. Place P.C.C. wheelchair ramps at freeway overpass, Olivewood, driveway approx. 600' W'y of Runney, and the W'y side of Runney. Move back the sprinklers between freeway overpass and Olivewood. Narrow S/W 3.5' min. at trees.
* DELETED	Indiana	Barnard to Vance	600	E'y	95	-	-	-	Place 540 L.F. of 6" P.C.C. curb S/W between exist. 5" W'y of Clara to La Sierra. Place the wheelchair ramps at Clara and at La Sierra. Place 188 L.F. of 4" P.C.C. S/W adjacent to exist. fence. On E'y side of the fence, begin 6" P.C.C. curb S/W and meet exist. D/W's. Approx. 310' W'y of Runney to Runney, place a total of 305 L.F. of 6" P.C.C. S/W. An exist. retaining wall will require the S/W to be narrowed to 3' wide for 94 L.F. The remainder will be 6' wide. Place P.C.C. wheelchair ramps at freeway overpass, Olivewood, driveway approx. 600' W'y of Runney, and the W'y side of Runney. Move back the sprinklers between freeway overpass and Olivewood. Narrow S/W 3.5' min. at trees.
7	Alessandro	Glenhaven to approx. 700' N'y of Chicago	840	E'y	4200	-	-	1	Place 840 L.F. of 5" P.C.C. curb S/W between Glenhaven and the exist. 5" P.C.C. S/W S'y. Place wheelchair ramp at Glenhaven. Remove sprinkler system and place behind proposed S/W. See Typical Section. Profile landscaping per Sec. 308 of the Special Provisions.
8	Bandini	Palm to Brockton	968	S'y	5603	270	-	3	Place 6" curb S/W between exist. S/W near Palm and corner of Brockton. Place wheelchair ramps at Palm and Brockton. Meet exist. P.L. S/W on Brockton.
* DELETED	Hedrick	Tyler to Crest	3050	S'y	131	1005	111	-	Place 6" A.C. curb S/W behind existing 2 1/2" x 2" curb. Approx. 100' W'y of Tyler, transition around existing 2 1/2" x 2" curb to 6" A.C. curb. Place 6" A.C. curb S/W behind existing 2 1/2" x 2" curb. (See Typical Section)
* DELETED	Love	Palmyra to Columbia	1820	W'y	7320	-	-	2	Place 6" curb S/W. Place wheelchair ramps at Palmyra and Columbia. Remove sprinkler system and place behind proposed S/W. See Typical Section. Profile landscaping per Sec. 308 of the Special Provisions.

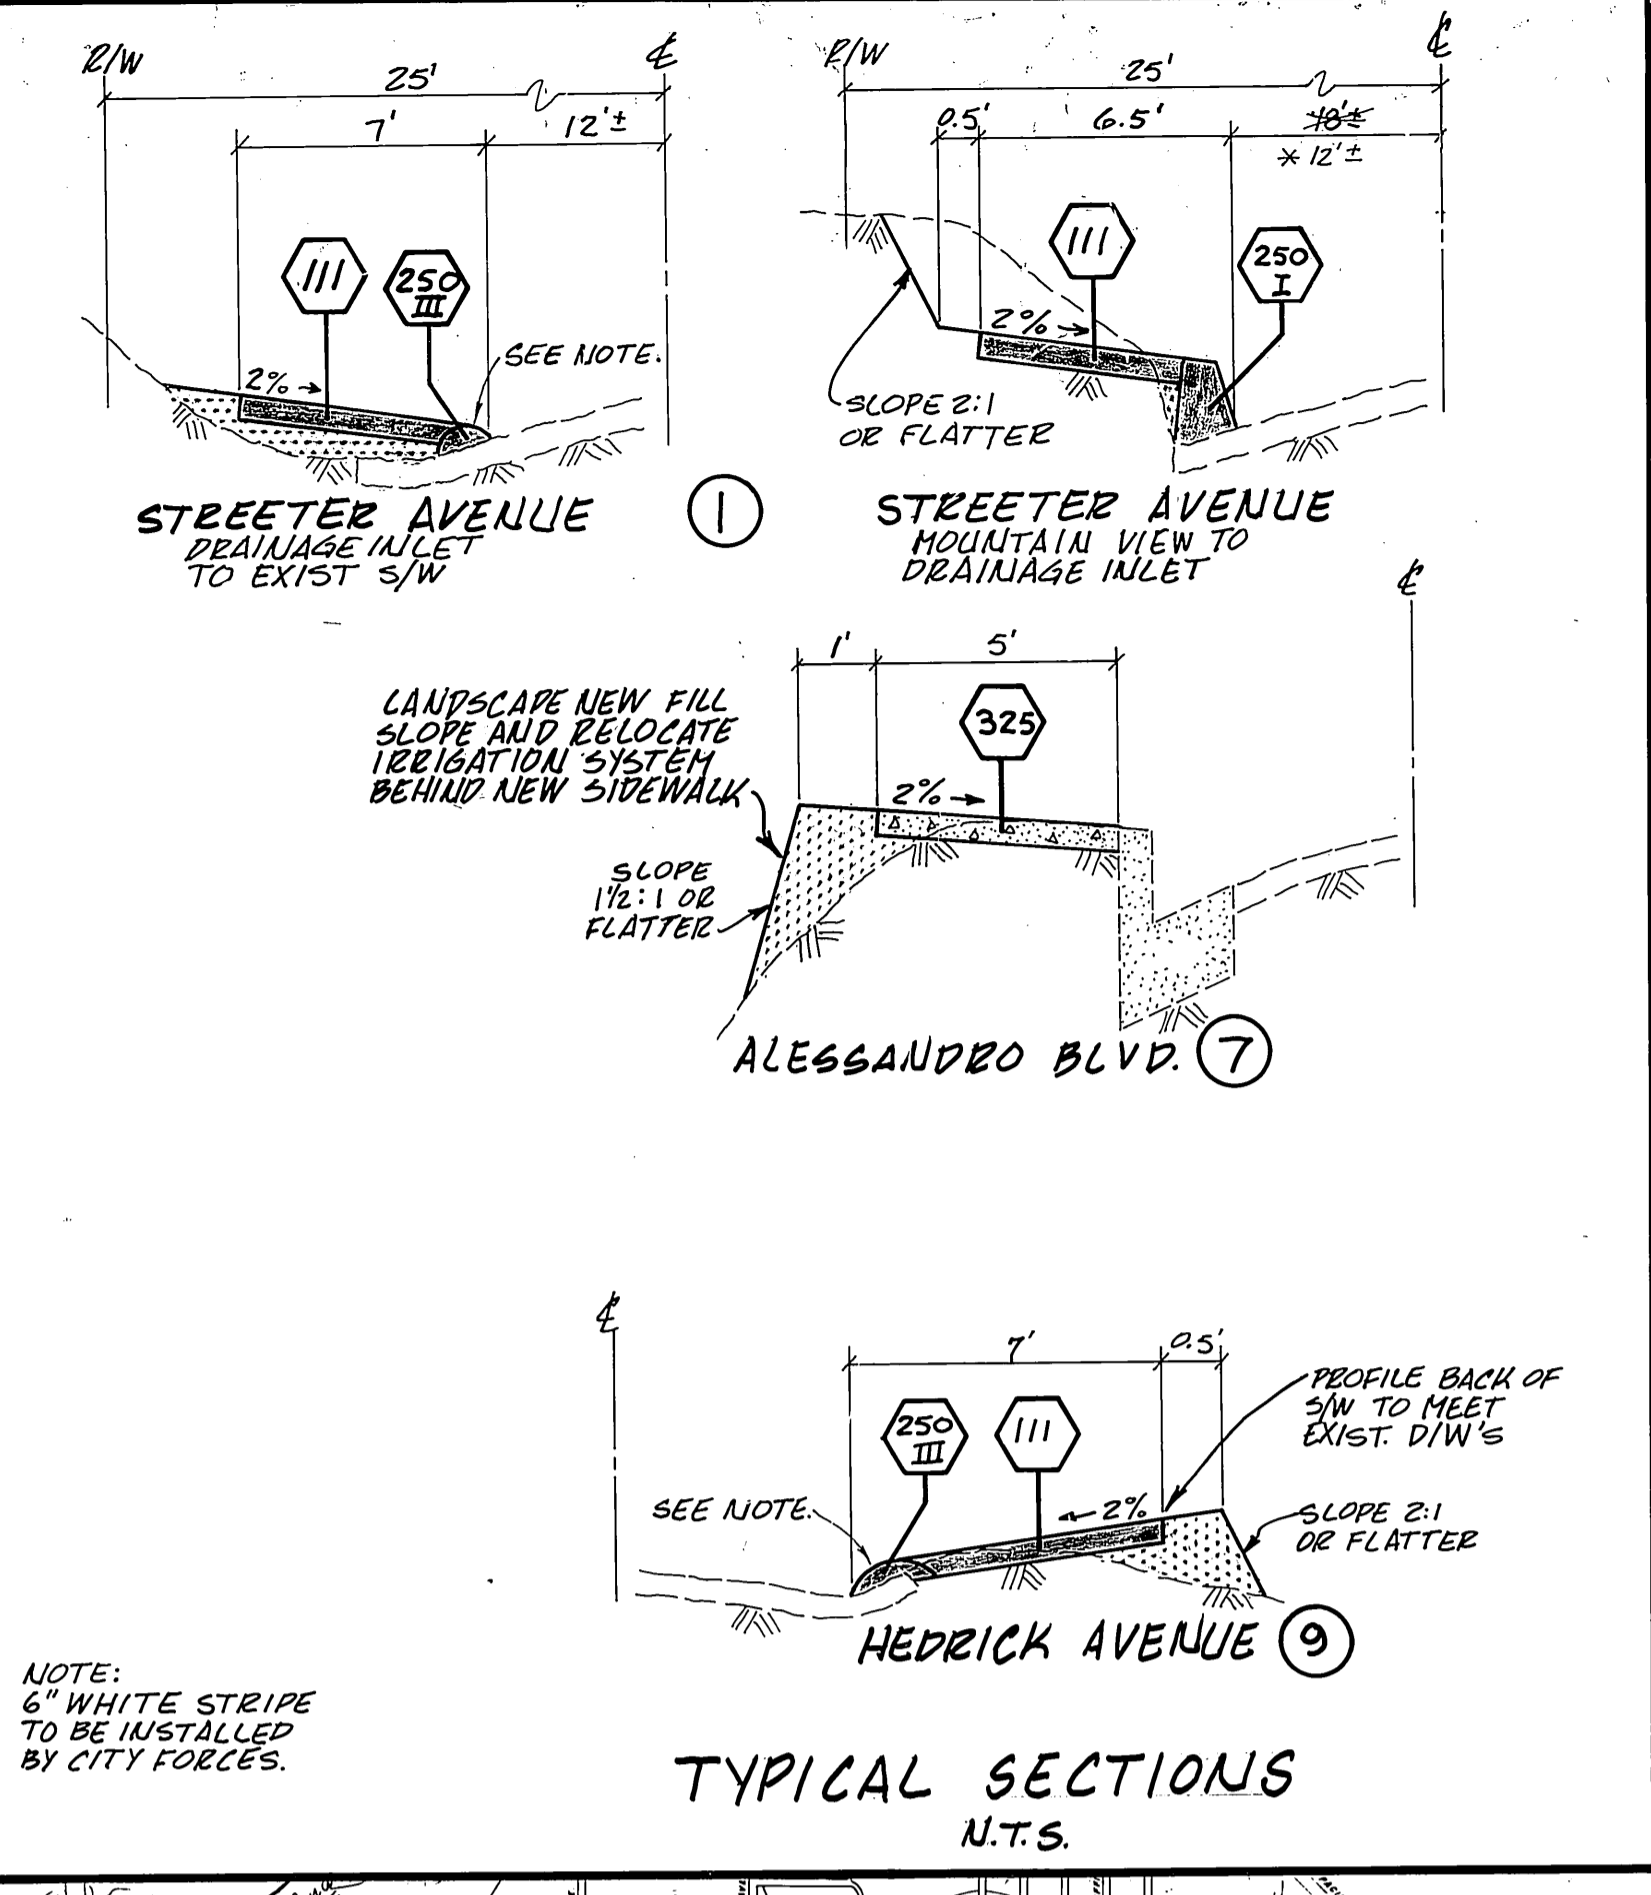

CITY OF RIVERSIDE PUBLIC WORKS DEPARTMENT		SIDWALK CONSTRUCTION AT VARIOUS LOCATIONS 1982 - 1983	ACCOUNT NO. 30-575-206-09 R-2491 SHEET OF
APPROVED BY PRINCIPAL ENGINEER PARK DEPARTMENT TRAFFIC DIVISION CHIEF P.W. ENGINEER	DATE 12/14/83 1/1/83 2/2/83	APPROVED BY PUBLIC WORKS DIRECTOR	DATE 12/23/82
DESIGNED BY DRAWN BY CHECKED BY	REVISIONS APPR. DATE	HORIZ. SCALE: 1" = 1600'	* AS BUILT OR INCORP. UP