


CONSTRUCTION NOTES

- A - CONSTRUCT STRUCTURAL SECTION OF 0.25' A.C. OVER 0.65' AGGREGATE BASE. REMOVE EXIST. A.C. AND REPLACE WITH STRUCTURAL SECTION WHERE APPLICABLE AS SHOWN ON PLAN.
- B - OVERLAY EXIST. A.C. PAVEMENT WITH A VARIABLE THICKNESS OF A.C.
- C - GRADE AREA BEHIND CURB OR BERM AS SHOWN ON PLAN OR TYPICAL SECTION. MATERIALS WITH R-VALUE EQUAL TO 65 (MIN.) SHALL BE PLACED ON FILL. RELATIVE COMPACTION SHALL BE 90% (MIN.) ON DRIVEWAYS WITH EXIST. SLAG OR GRAVEL SURGRADING. THE SURFACING SHALL BE REPLACED WITH 0.25' THICK PEA GRAVEL AS SHOWN ON PLAN.
- D - PROVIDE RCC STEPS AS NECESSARY TO MATCH EXIST. R.C.C. WALKWAY.
- E - REMOVE EXIST. A.C. & REPLACE WITH 0.30' THICK A.C. OVER NATIVE MATERIAL COMPACTED TO 90% RELATIVE COMPACTION (MIN.).
- 200 Z - CONSTRUCT CURB & GUTTER PER STD. DWG. NO. 200. (6" C.F.)
- 302 Z - CONSTRUCT D/W PER STD. DWG. NO. 302, A & B AS NOTED. DEPRESS BACK OF D/W APPROACH AS INDICATED ON PLAN.
- R T - REMOVE TREE. SEE SPECIAL PROVISIONS FOR TREE DIAMETER AND CLASS INVOLVED.
- T - PLANT CAMPHOR TREE. SEE PARK & REC. NOTES, SHT. 3.

GENERAL NOTES

1. CONSTRUCTION SHALL BE IN ACCORDANCE WITH THE CITY OF RIVERSIDE STD. DRAWINGS AND STD. SPECS FOR PUBLIC WORKS CONSTRUCTION, 1982 EDITION.
2. NUMBERS ABOVE 100 IN A HEXAGON ON THE PLAN REFER TO THE RESPECTIVE STD. DWG. SHALL BE CONSTRUCTED ACCORDINGLY, UNLESS MODIFICATIONS ARE NOTED ON THE PLAN. ANY NUMBER SHOWN BELOW THE STD. DWG. NO. INDICATES THE SPECIFIC ALTERNATE TO BE CONSTRUCTED.
3. CUT & FILL SLOPES ARE 2:1 OR FLATTER.
4. RIGHTS OF ENTRY HAVE BEEN OBTAINED FOR ALL WORK SHOWN ON PRIVATE PROPERTY.
5. ALL ELEVATIONS SHOWN ON THE PLAN SHALL BE STAKED IN THE FIELD.

PARK & RECREATION NOTES AND TYPICAL SECTIONS - SEE SHEET 3.

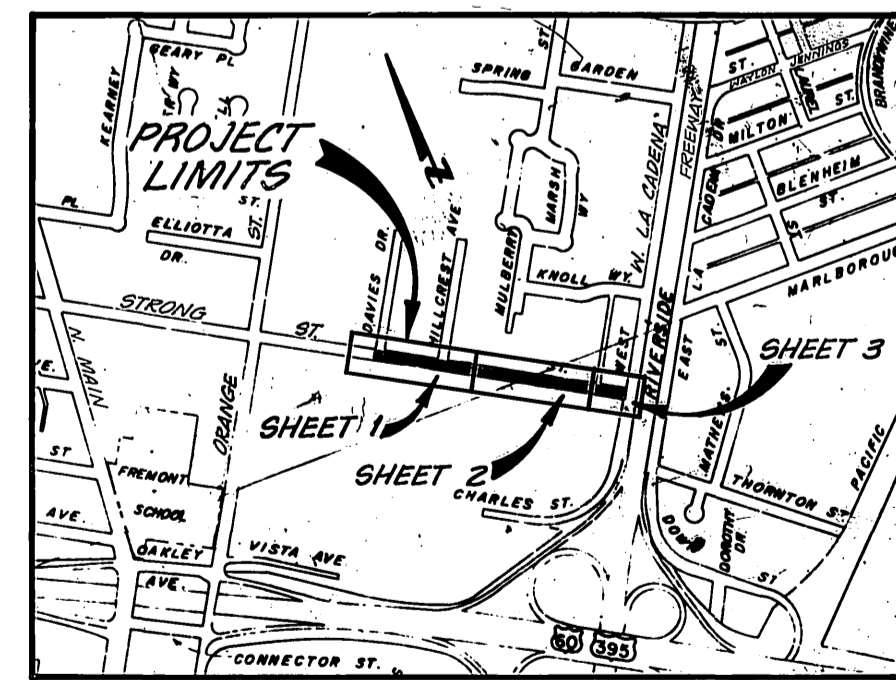

LOCATION MAP

*As built 9-20-85 TL

<p>CITY OF RIVERSIDE PUBLIC WORKS DEPARTMENT</p>		<p>STRONG STREET WIDENING (H.U.D. FUNDED)</p>		<p>ACCOUNT NO. 15-550-596</p>
<p>APPROVED BY: <i>[Signature]</i> DATE: 10/12/84</p>		<p>APPROVED BY: <i>[Signature]</i> DATE: 10/12/84</p>		<p>R-2533</p>
<p>DESIGNED BY: <i>[Signature]</i> DRAWN BY: <i>[Signature]</i> CHECKED BY: <i>[Signature]</i></p>		<p>DATE: 10/12/84</p>		<p>SHEET 1 OF 3</p>
		<p>HORIZ. SCALE: 1" = 20' VERT. SCALE: 1" = 4'</p>		

