


- GENERAL NOTES:**
- CONSTRUCTION TO BE IN ACCORDANCE WITH STD. SPEC. FOR PUBLIC WORKS CONSTRUCTION 1982 ED. AND WITH CITY OF RIVERSIDE STD. DWGS.
 - CONSTRUCT DRIVEWAY APPROACH AS PER STD. DWG. NO. 302 DIMENSIONS A / B AS INDICATED.
 - CONSTRUCT WHEELCHAIR RAMP AS PER STD. DWG. NO. 304 MATCHING EXIST. DEPRESSIONS.
 - CONSTRUCT CURB SIDEWALK AS PER STD. DWG. NO. 323.

BENCH MARK
 PK NAIL IN WLY CURB OF HOWARD 130' NLY
 OF E OF 14TH ST PER FB 938744
 ELEV: 878.83

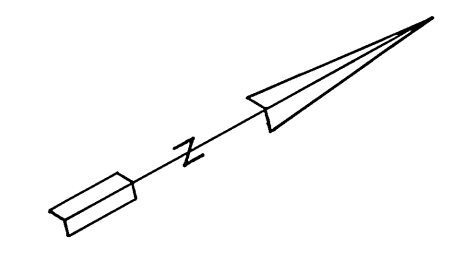

* AS BUILT 6-7-85-76

CITY OF RIVERSIDE		AN HUD PROJECT		ACCOUNT NO. 15-550-5802
PUBLIC WORKS DEPARTMENT		HOWARD AVE. SIDEWALK		R-2542
APPROVED BY	DATE	BY	APPROVED BY	
PRINCIPAL ENGINEER	11-4-83		<i>[Signature]</i>	
PARK DEPARTMENT			PUBLIC WORKS DIRECTOR	
TRAFFIC DIVISION	6/16/84			
CHIEF P. W. ENGINEER	10-7		DATE	12/7/84
DESIGNED BY <i>[Signature]</i>	DRAWN BY <i>[Signature]</i>	CHECKED BY	SCALE: 1" = 20'	

INDEX *[Symbol]*