


**GENERAL NOTES**

1. CONSTRUCTION SHALL BE IN ACCORDANCE WITH THE CITY OF RIVERSIDE STANDARD DRAWINGS AND STANDARD SPECS FOR PUBLIC WORKS CONSTRUCTION, 1982 EDITION.

**CONSTRUCTION NOTES**

- 1 - PLUG OPENING IN BACK OF CATCH BASIN. CONSTRUCT 18" x 18" D.I. WITH 20" x 20" GRATING (ALHAMBRA 2012 OR APPROVED EQUAL). CONSTRUCT D.I. AS PER STD. DWG. NO. 425 EXCEPT FOR INSIDE DIMENSION. CONNECT D.I. TO EXIST. C.B. WITH 8" A.C.P. LEAVE 1" OF 8" A.C.P. STUB FOR D.I. FACING SOUTH. TOP OF GRATING TO MEET EXIST. FL. D.I. TO BE 2' DEEP.
- 2 - REPLACE EXIST. A.C. PAVING WITH 3" A.C. OVER 12" CLASS 2 BASE.
- 300 - CONSTRUCT CONCRETE CURB & GUTTER PER STD. DWG. NO. 200. (6" C.F.).
- 302 - CONSTRUCT DRIVEWAY APPROACH PER STD. DWG. NO. 302. A & B AS NOTED.
- 325 - CONSTRUCT CONCRETE SIDEWALK PER STD. DWG. NO. 325.

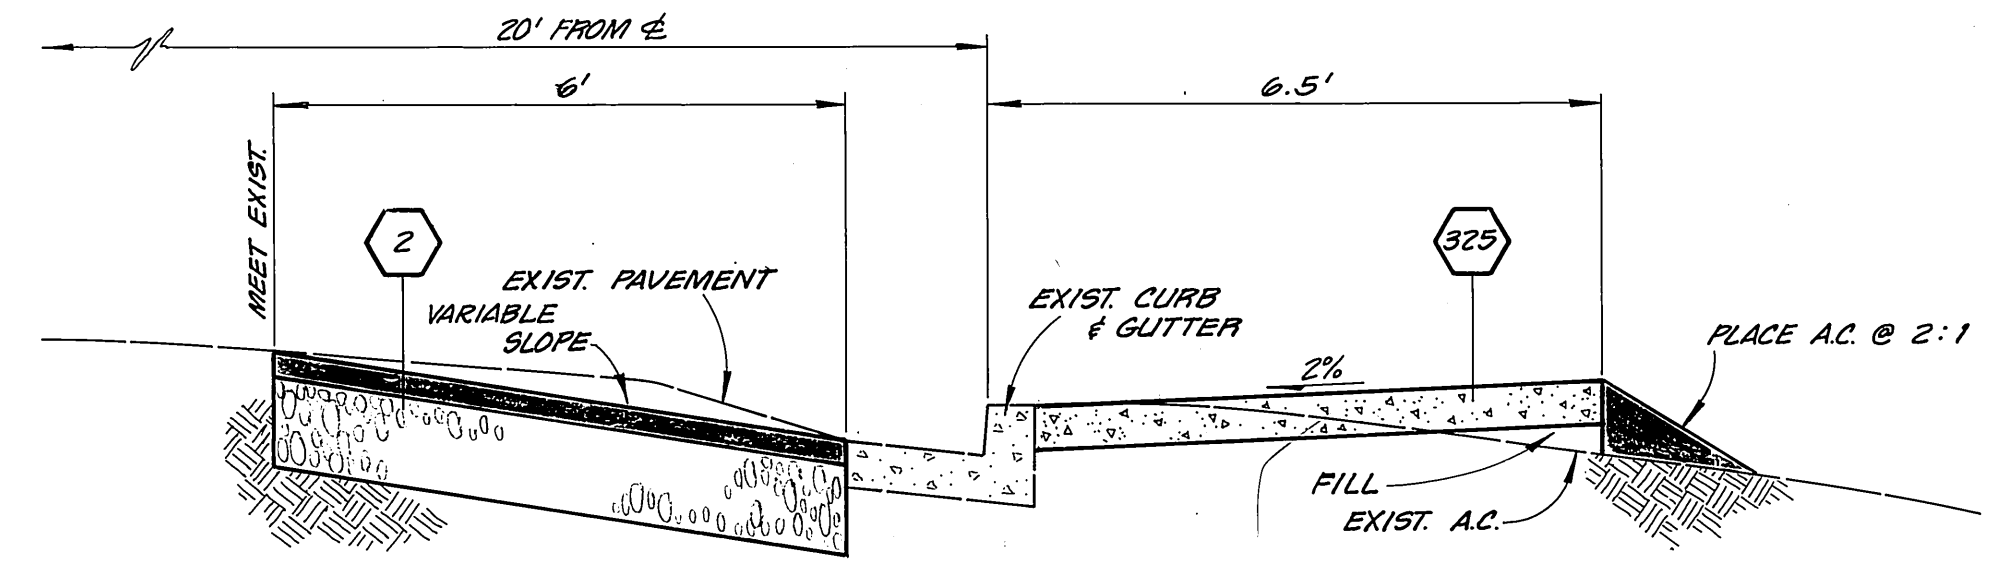

**SECTION A - A**  
NO SCALE

\* AS BUILT OCT. 1, 1984 TAWNY

<p><b>CITY OF RIVERSIDE</b> PUBLIC WORKS DEPARTMENT</p>		<p><b>ARLINGTON AND RUTLAND AVENUE SIDEWALKS</b> 6350 RUTLAND C-2-834</p>		<p>INDEX UP SHEET <b>R-2571</b> OF 1</p>
<p>APPROVED BY: [Signature]</p>	<p>DATE: 4/18/84</p>	<p>APPROVED BY: [Signature]</p>	<p>DATE: 4/20/84</p>	<p>ACT. NO. 30-575-248-30</p>
<p>PRINCIPAL ENGINEER</p>	<p>PARK DEPARTMENT</p>	<p>TRAFFIC DIVISION</p>	<p>CHIEF P.W. ENGINEER</p>	<p>SCALE: 1" = 30'</p>
<p>DESIGNED BY: [Signature]</p>	<p>DRAWN BY: [Signature]</p>	<p>CHECKED BY: [Signature]</p>	<p>APPR. DATE</p>	<p>MARK REVISIONS</p>