

ALL NOTES APPLY TO THIS SHEET ONLY

GENERAL NOTES


- CONSTRUCTION SHALL BE IN ACCORDANCE WITH THE CITY OF RIVERSIDE DEPARTMENT OF PUBLIC WORKS STANDARD DRAWINGS, AND THE STANDARD SPECIFICATIONS FOR PUBLIC WORKS CONSTRUCTION, 1982 EDITION.
- TRIM EDGE OF EXISTING PAVEMENT WHERE NEW PAVEMENT JOINS TO A SMOOTH STRAIGHT LINE. CONSTRUCT MATCH-UP PAVING AS SHOWN ON PLAN AND OVERLAY PAVING AS DIRECTED IN THE FIELD TO PRODUCE A SMOOTH SECTION.
- NUMBERS ABOVE 100 IN A HEXAGON ON THE PLAN REFER TO THE RESPECTIVE STD. DWS. AND SHALL BE CONSTRUCTED ACCORDINGLY, UNLESS MODIFICATIONS ARE NOTED ON THE PLAN. ANY NUMBER SHOWN BELOW THE STANDARD DRAWING NUMBER INDICATES THE SPECIFIC ALTERNATE TO BE CONSTRUCTED.
- A.C. OVERLAY

CONSTRUCTION NOTES

- OVERLAY EXIST. P.V.M.T. WITH VARIABLE THICKNESS OF A.C. AS SHOWN
- CONSTRUCT STRUCTURAL SECTION OF .21' A.C. OVER .75' OF CRUSHED AGGREGATE BASE (C.A.B.)
- REMOVE EXIST. PAVEMENT AROUND GATE VALVE AND ADJUST GATE VALVE COVER TO GRADE.
- REMOVE GUARD POSTS
- REMOVE & REINSTALL INTERFERING PORTIONS OF FENCE
- REMOVE EXIST. IMPROVEMENTS
- CONSTRUCT CONC. CURB & GUTTER PER STANDARD DWG. NO. 200
- CONSTRUCT WHEELCHAIR RAMP PER STD. DWG. NO. 304 WITH RAMP LOCATION AS SHOWN ON PLAN.
- CONSTRUCT CONC. SIDEWALK AS PER STD. DWG. NO. 325
- RELOCATE PALM TREE TO LOCATION INDICATED ON PLANS OR WHERE DIRECTED BY PARK DEPARTMENT, CLASS I: 6" TO 18" DIA.; CLASS II: OVER 18" TO 36" DIA.; CLASS III: OVER 36" DIA.


PARK DEPT. NOTES

- All related work shall conform to the City of Riverside, Park and Recreation Department Standards.
- Contact the Park Projects Inspector a minimum of 48 hours in advance at 787-7223 to schedule inspections. Inspections shall be required: a) when plant locations have been spotted in the field prior to digging plant pits, b) while digging plant pits and planting/relocating trees, c) after planting and all other indicated or specified work has been completed for start of maintenance, and d) at end of maintenance/final acceptance (contractor/developer will be released from maintenance only upon receipt of written notification from the city that the Park and Recreation Department is assuming maintenance responsibilities).
- The Contractor/Developer shall maintain all plantings for a minimum period of one (1) year.

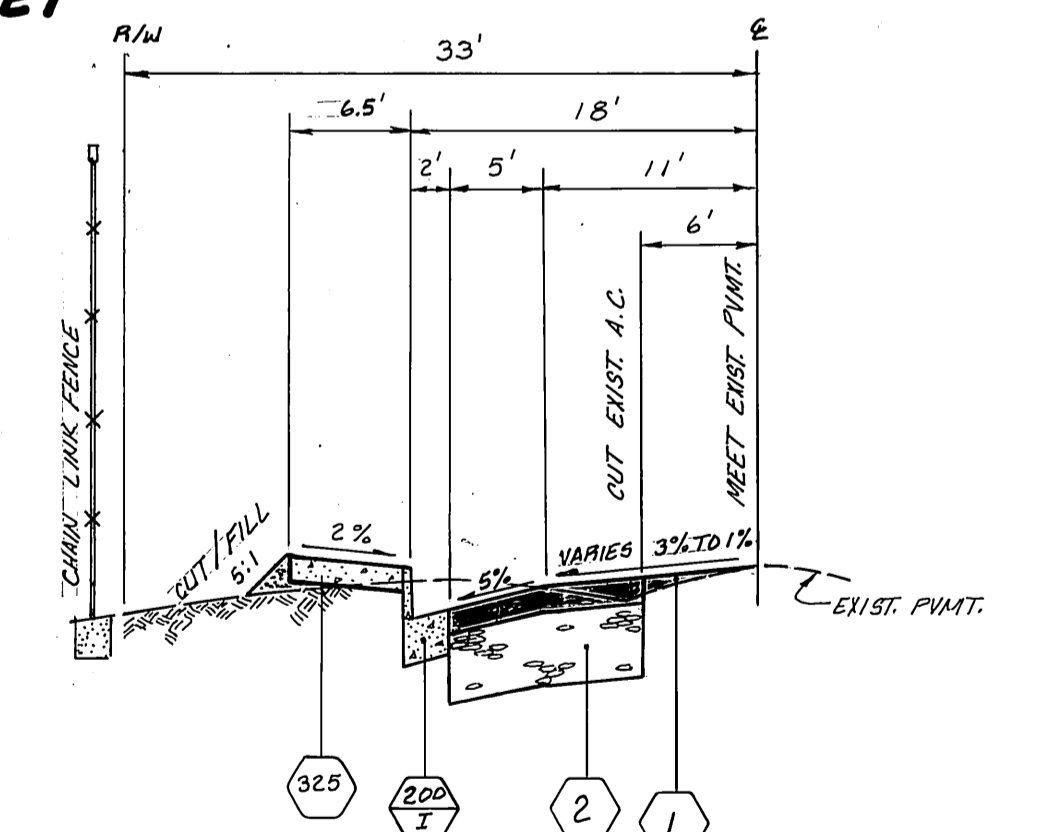

TYPICAL SECTION DETAIL

NO SCALE

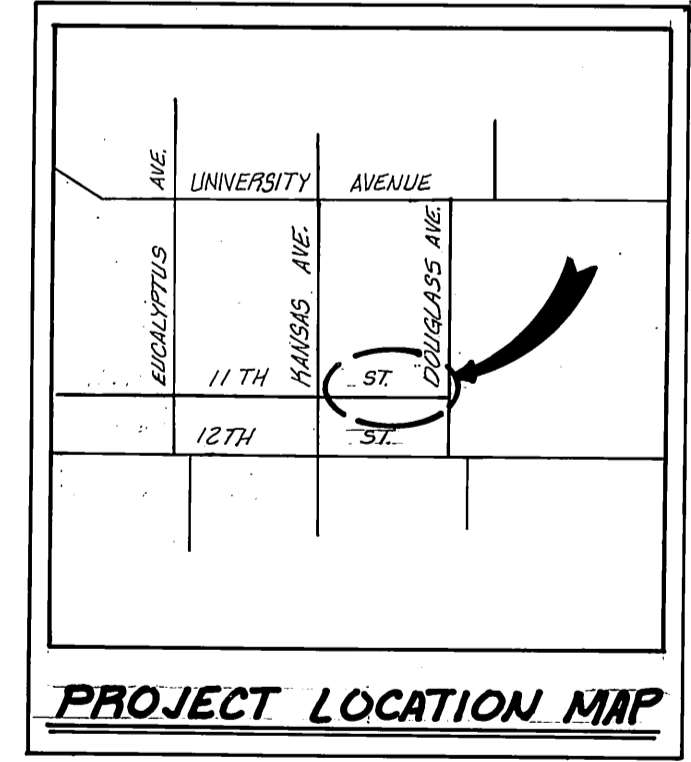

| | | | | | |
|---|-------------------------|-------------------------|--|--|--|
| CITY OF RIVERSIDE PUBLIC WORKS DEPARTMENT | | | 11 TH STREET WIDENING (A HUD FUNDED PROJECT) | | ACCOUNT NO. 5-550-550-1 R-2663 |
| APPROVED BY PRINCIPAL ENGINEER PARK DEPARTMENT TRAFFIC DIVISION CHIEF P.W. ENGINEER | DATE 5-19-85 | BY William D. Hansen | APPROVED BY PUBLIC WORKS DIRECTOR | | |
| DESIGNED BY DRAWN BY CHECKED BY | REVISIONS APPR. DATE | DATE MAY 20, 1985 | HORIZ. SCALE: 1" = 20' VERT. SCALE: 1" = 2' | | |
| SHEET 1 OF 1 | | | *As built 7-28-88 JE | | |