ESTIMATE OF QUANTITIES

Curb & Gutter (Std. 200)	200 L.F.
A.C. Paving	1860 SF.
Aggregate Base	
Driveway Approach (3 EA.)	675 [,] <i>Şt</i> .

CONSTRUCTION NOTES

- ① Construct Curb and Gutter (Std. 200-6"C.F.)
- ② Construct 2-1/2"A.C. Paving over 4" crushed Agg. Base per Plan R-2209, S.R.-1041.
- 3 Construct Driveway Approach (Std. 302, A=16', B=23', unless otherwise indicated.)
- (4) Construct A.C. Overlay

FALCON CABLE TV

PACIFIC TELEPHONE COMPANY

Chief Utilities Engineer - Electric

CITY OF RIVERSADE - PUBLIC UTILITIES, ELECTRIC

#/ Landones

Approved by

5 Plant Street Trees to the specification of the Park and Recreation Department.

Rate 2,198)

2/2/87


GENERAL NOTES


- 1. The private engineer, signing these plans is responsible for the accuracy and acceptability of the work hereon In the event of discrepancies arising during construction, the private engineer signing these plans shall be responsible for determining an acceptable solution and revising the plans for approval by City.
- 2. Construction shall be in accordance with the City of Riverside Department of Public Works, Standard Drawings' No. 10 and the Standard Specifications for Public Works Construction, current edition.
- 3. All flagged elevations shall be staked in the field by the private engineer
- 4. Curb and gutter to be staked on 3'offset at 25'intervals.
- 5. Trim edge of existing pavement where new pavement joins, to a smooth, straight line. Construct match up pavement as shown on plans and overlay paving as directed in the field to produce a smooth section.
- 6. It shall be the responsibility of the contractor to clear the right of way in accordance with the provisions of law as it effects each utility, including irrigation lines and appurtenances, at no cost to the City.
- 7. Any traffic control striping obliterated and or badly worn during construction shall be restored by the contractor within five days after notification from the City Inspector.
- 8. Construct driveway approches per. Std. Dwg 302. Exact size and location to be determined at time of construction as approved by the Traffic Engineer.
- 9. All traffic signs shall be installed prior to opening streets to traffic.
- 10. Final striping for traffic and /or pavement marking to be responsibility of the developer.
- II. Quanities shown are for information only and the City of Riverside is not responsible for their accuracy.
- 12. Developer to give City Water Division five (5) working days written notice prior to start of construction and to allow City ten (10) working days for completion of work. (351-6150)
- 13. The contractor shall call in a location request to Underground Service Alert (U.S.A.), Phone No. 1-800-422-4133, two working days before digging. No construction permit will be issued by the Public Works Department involving excavation for underground facilities unless the applicant has been provided an inquiry identification number by U.S.A.
- 14. Location of laterals to be determined in the field at the direction of the owner. Avoid conflict with proposed and/or existing facilities.
- 15. No finished floor elevation shall be less than 4' above the sewer flow line at point of connection without having a proper backwater valve installed in the lateral

GENERAL NOTES (STREET TREES)

- 1. All related work shall conform to the City of Riverside, Park and Recreation Department Standards.
- 2. Contact the Park Projects Inspector a minimum of 48 hours in advance at 787-7223 to schedule inspections. Inspections shall be required: A) When plant locations have been spotted in the field prior to digging plant pits, B) While digging plant pits and planting or relocating trees, C) After planting and all other indicated or specified work has been completed for start of maintenance, and D) At the end of maintenance/final acceptance (contractor/developer will be released from maintenance only upon receipt of written notification from the city that the Parks and Recreation Department is assuming maintenance responsibilities).
- 3. The Contractor/Developer shall maintain all plantings for a minimum period of one (1) year.
- 5. Street Tree plantings shall be as follows:

Street Name	Botanical Name	Common Name	Min. Size	Approx. Spacing	<u>Nº Req</u> .
Crest Avenue	Ulmus parvifolia	Evergreen Elm	15 Gallon	45'	5

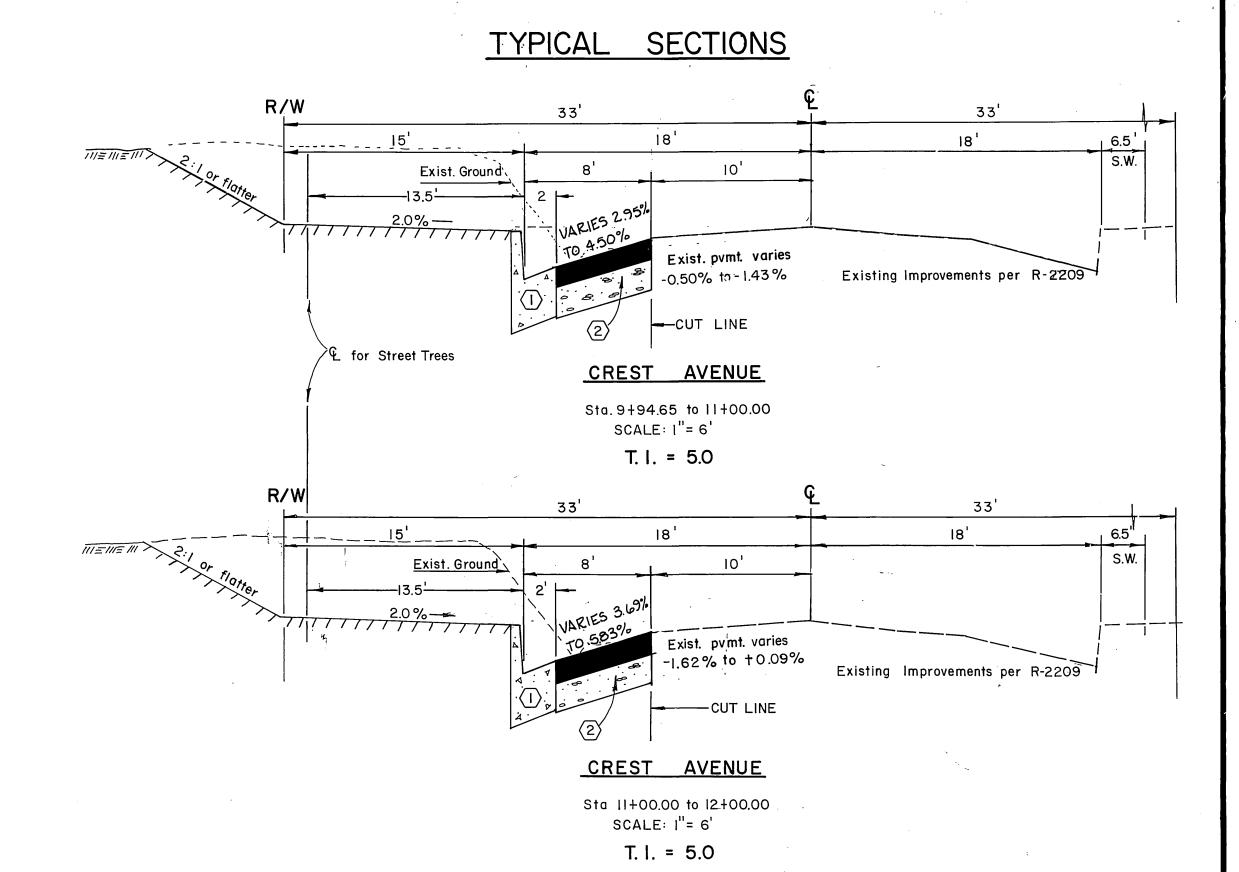

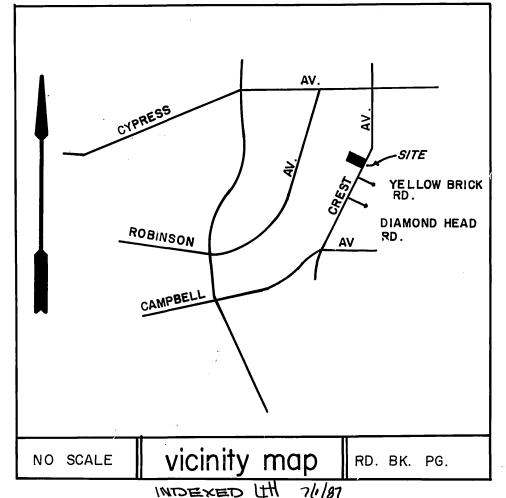

Bary Bed

* As built 2.3.89 TE

TRAFFIC DIVISION

CHIEF PUB. WKS ENGR WE 5.29

DATE 5/29/87

DATE 5/29/87

RINCIPAL ENGINEER

APPR. DATE

REVISIONS

DESIGNED BY: G. Y. DRAWN BY JAJ. CHECKED BY: PD

CITY OF RIVERSIDE, CALIFORNIA STREET PLAN AND PROFILE CCOUNT Nº DRAWING NUMBER PUBLIC WORKS DEPARTMENT CREST AVE. R-2843 P.M. 21,723 INDEX MAP SHEET | OF 2 SHEETS SCALE: AS SHOWN W.O. Nº 86-39

Carl alungarine

SOUTHERN CALIFORNIA GAS COMPANY attolet 12-31-86 Date Approved by CITY OF RIVERSIDE - WATER SYSTEM

PAUL DIEGES - CIVIL ENGINEER - R.C.E 13,234 1051 DAVIDS ROAD; PERRIS, CA 92370 (714) 657-2822

PERRIS ENGINEERING

BENCH MARK: Fd P.K.nail & city of Riverside tag in center of Northerly curb return at Babb Ave. & Beejay St. per C.R.F.B. LL15 page 40-A

ELEV=758.60'

