


GENERAL NOTES:


- CONSTRUCTION SHALL BE IN ACCORDANCE WITH THE CITY OF RIVERSIDE STANDARD DRAWINGS AND STANDARD SPECIFICATIONS FOR PUBLIC WORKS CONSTRUCTION 1991 EDITION.
- CUT AND FILL SLOPES SHALL BE 2:1 OR FLATTER.
- EXISTING UTILITIES SHOWN ON THESE PLANS ARE PLOTTED FROM UTILITY RECORDS. THE CONTRACTOR IS REQUIRED TO TAKE DUE PRECAUTIONARY MEASURES TO LOCATE & PROTECT ALL UTILITIES WHETHER OR NOT SHOWN ON THIS PLAN. IF THE COVER OF THE UTILITY IS KNOWN, IT IS SHOWN IN THE PROFILE. UTILITIES IN THE PROFILE SHOWN AS ? INDICATES THE COVER IS UNKNOWN, BUT THE UTILITY IS NOT EXPECTED TO CONFLICT WITH THE PROPOSED IMPROVEMENTS.
- CONFLICTING UTILITIES SHOWN WITHIN THE CONSTRUCTION AREA WILL BE RELOCATED PRIOR TO CONSTRUCTION.

CONSTRUCTION NOTES:

- CONSTRUCT STRUCTURAL SECTIONS OF 0.21' A.C. OVER 0.80' C&G OR 0.58' A.C. OVER COMPACTED NATIVE MATERIAL.
- REMOVE AND REPLACE STRUCTURAL SECTIONS WITH 0.21' A.C. OVER 0.80' C&G OR 0.58' A.C. OVER COMPACTED NATIVE MATERIAL.
- REMOVE AND REPLACE STRUCTURAL SECTIONS WITH 0.58' A.C. OVER COMPACTED NATIVE.
- CONSTRUCT VARIABLE THICKNESS DGAC OVERLAY.
- CONTRACTOR TO ADJUST G.V. COVER TO GRADE.
- PUD, WATER DIV. TO EXTEND/RELOCATE.

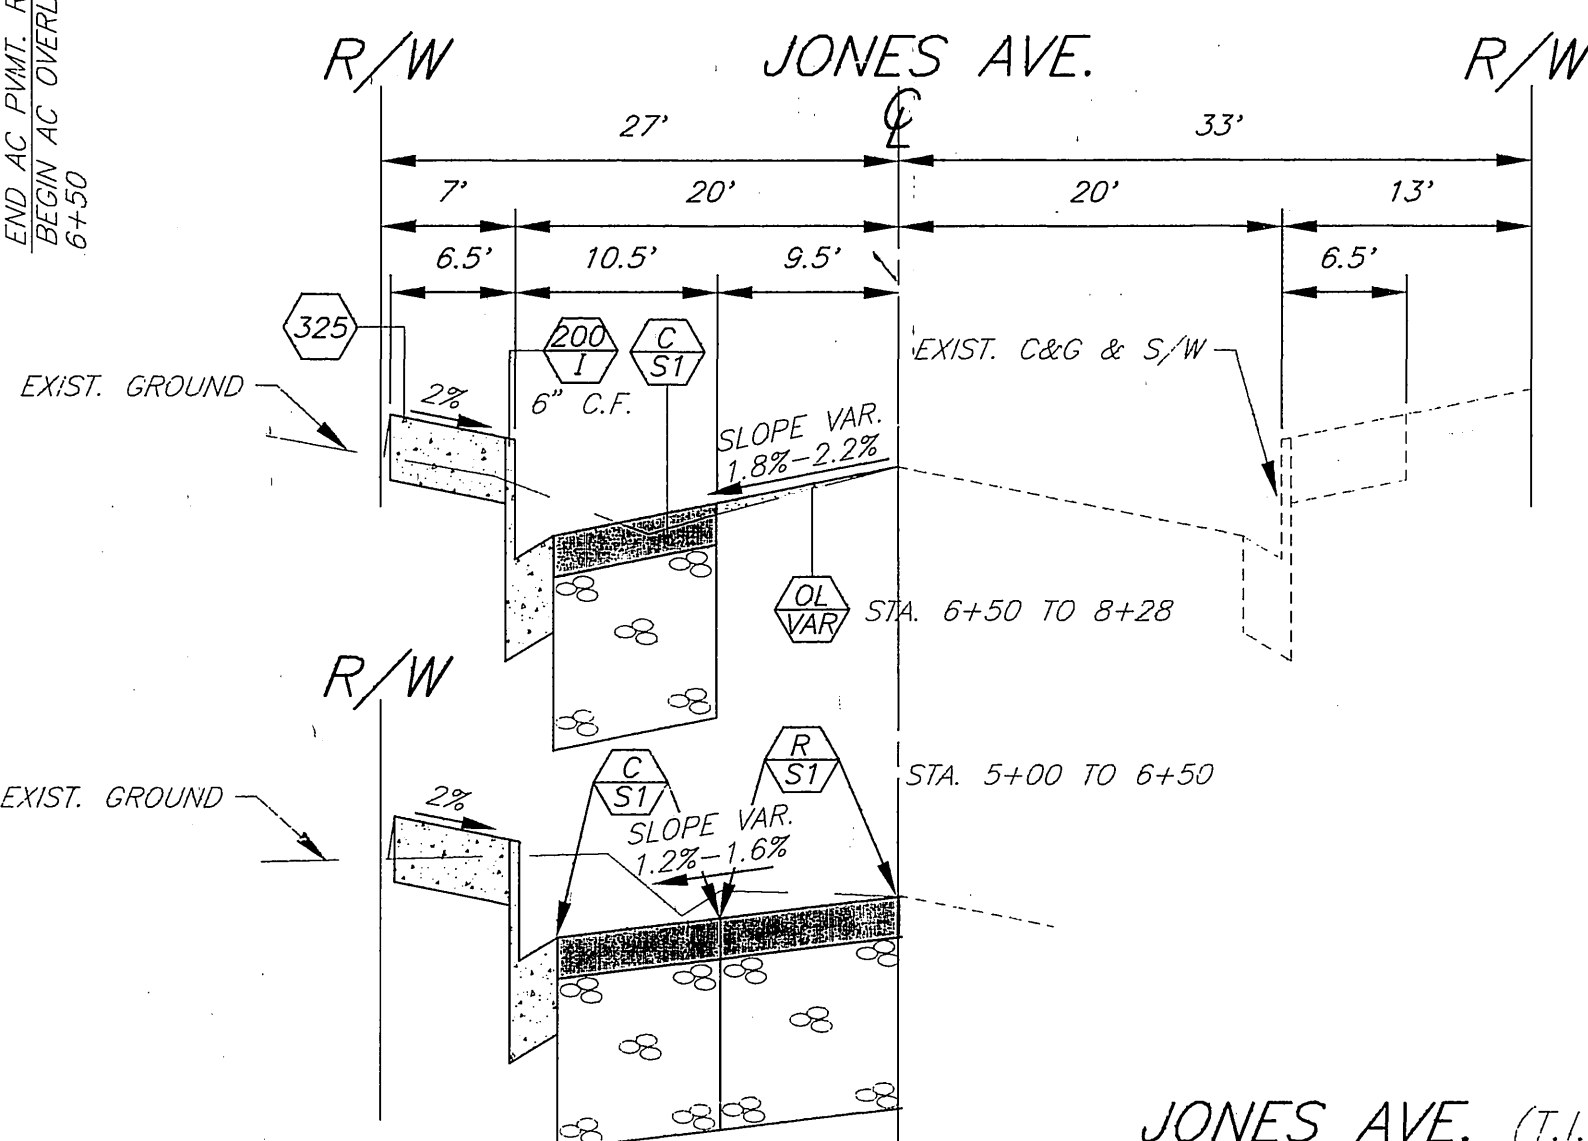

JONES AVE. (T.I. = 6.0)
TYPICAL SECTIONS
(N.T.S.) * AS-BUILT 5-11-94 LFH

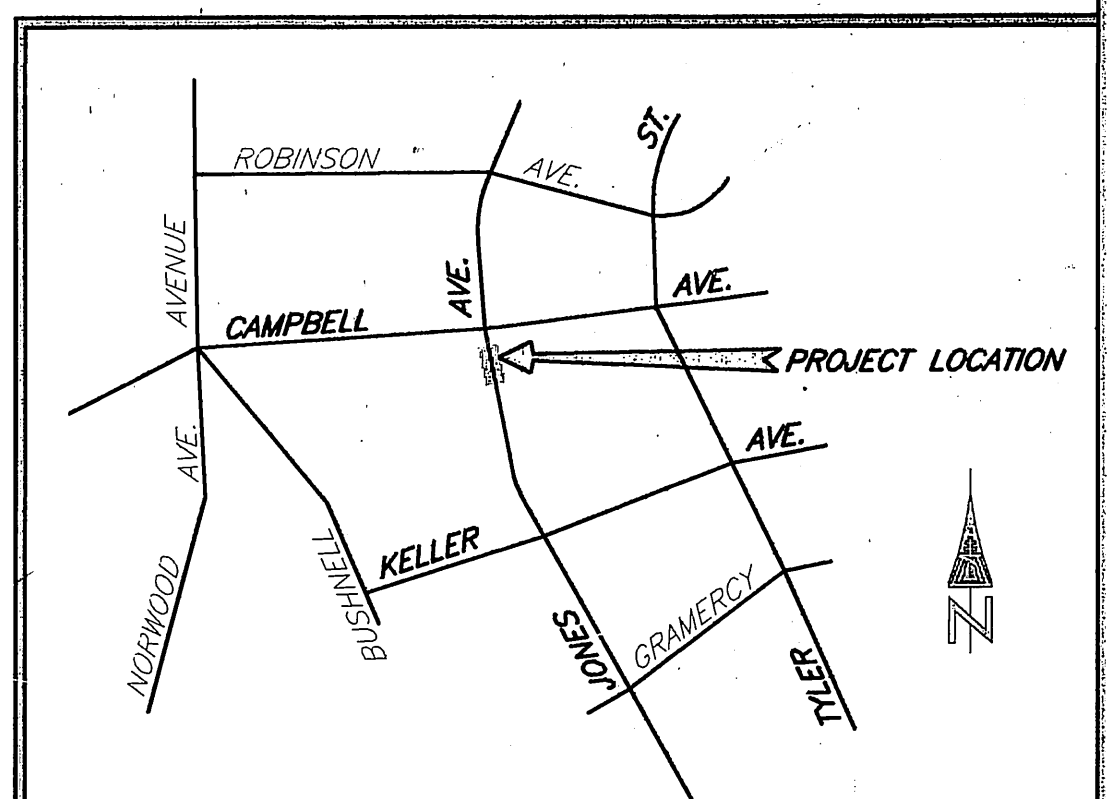

BENCHMARK
G2-G, PK NAIL AND ENGINEER'S TAG
IN S'LY CURB OF CAMPBELL AVE. 50' S
OF E JONES AVE.
ELEVATION 774.91'



ENGINEER IN RESPONSIBLE CHARGE
Duane K. Greenwood
DUANE K. GREENWOOD
R.C.E. No. 43965 expires 6/30/97
DATE 10/13/93

MARK	REVISIONS	APPR.	DATE

CITY OF RIVERSIDE, CALIFORNIA
PUBLIC WORKS DEPARTMENT
APPROVED BY: [Signature]
DEPUTY P.W. DIRECTOR
PRINCIPAL ENGINEER
DATE 10/20/93

JONES AVE. WIDENING FROM 175' TO 575' SOUTHERLY OF CAMPBELL AVENUE
ACCT. NO.: 430-541500-440222-30319
R-3338
SHEET 1 OF 1
FILE NO.