



#	TREE QTY.S	#	LOCATION	S/W	S.F. S/W	D/W	S.F. D/W	L.F. C&G	COMMENTS
1		1	3545 MARKET ST.	1.0X10.0	10	X	0		
1		2	3500 MARKET ST.	3.0X12.0	36	X	0		
1		3	3786 FIFTH ST. (PARKING LOT)	6.0X25.0	30	X	0		
1		4	3740 ORANGE ST.	10.0X5.0	50	X	0		
1		5	3501 MAIN ST. (FIFTH ST.)	10.0X5.0	50	X	0		
2		6	3575 ORANGE ST.	3.0X25.0	25	X	0		REMOVE TREE AND REPLACE TREE WELL WITH SIDEWALK
2		7	3540 ORANGE ST.	48.0X6.0	288	8X15	120	50	
3		8	3546 ORANGE ST.	3.0X3.0	9	X	0	32	
3		9	3570 FIFTH ST.	6.0X8.5	51	X	0		
3		10	3553 FIFTH ST.	5.0X18.0	30	X	0		REMOVE TREE AND REPLACE TREE WELL WITH SIDEWALK
3		11	3546 FIFTH ST.	6.0X5.0	30	X	0		
3		12	3499 LEMON ST.	3.0X10.0	30	X	0		
3		13	3487 FIFTH ST.	3.0X5.0	15	X	0		
3		14	3477 FIFTH ST.	5.0X5.0	25	X	0		
3		15	3471 FIFTH ST.	5.0X5.0	25	X	0		
3		16	3476 FIFTH ST.	5.0X18.0	30	X	0		
3		17	3500 LEMON ST.	5.0X5.0	25	X	0		
4		18	3412 FIFTH ST.	6.0X20.0	120	X	0		REMOVE TREE AND REPLACE TREE WELL WITH SIDEWALK
4		19	3510 LIME ST.	5.0X10.0	50	X	0		
5		20	3555 LIME ST.	6.0X20.0	120	X	0	9	REMOVE TREE AND REPLACE TREE WELL WITH SIDEWALK
5		21	3425 SIXTH ST.	5.0X5.0	25	X	0		
5		22	3425 SIXTH ST.	5.0X5.0	25	X	0		
5		23	3444 SIXTH ST.	3.0X27.0	81	X	0		
5		24	3456 SIXTH ST.	5.0X9.0	45	X	0		
5		25	3456 SIXTH ST.	1.0X5.0	5	X	0		
5		26	3469 SIXTH ST.	15.0X4.0	60	X	0		
5		27	3475 SIXTH ST.	5.0X20.0	100	X	0		
5		28	3574 LEMON ST.	5.0X5.0	25	X	0		
5		29	3440 SIXTH ST.	7.0X5.0	35	X	0		
5		30	3540 SIXTH ST.	9.0X3.0	27	X	0		
5		31	3517 SIXTH ST.	2.0X4.0	8	X	0		
5		32	3517 SIXTH ST.	6.0X12.0	72	X	0		
5		33	3549 SIXTH ST.	5.0X6.0	30	22.0X7.0	154		
5		34	3549 SIXTH ST.	4.0X7.0	28				
5		35	3549 SIXTH ST.	6.0X20.0	120	20.0X6.0	120	20	
5		36	3549 SIXTH ST.	7.0X9.0	63	X	0		
5		37	3506 SIXTH ST.	3.0X25.0	225	X	0		
5		38	3622 ORANGE ST.	8.0X5.0	40	X	0		
5		39	3625 SIXTH ST.	9.5X3.5	52	X	0		
5		40	3681 SIXTH ST.	6.3X16.0	101	X	0		
5		41	3725 SIXTH ST.	12.3X18.0	117	X	0		
5		42	3737 SIXTH ST.	6.0X10.0	60	X	0		REMOVE DAMAGED S/W AND RECONSTRUCT LARGER TREE WELLS
5		43	3741 SIXTH ST.	25.0X3.0	75	X	0		REMOVE DAMAGED S/W AND RECONSTRUCT LARGER TREE WELLS
5		44	3750 SIXTH ST. (ALLEY)	5.0X3.0	15	X	0		REMOVE DAMAGED S/W AND RECONSTRUCT LARGER TREE WELLS
5		45	3790 SIXTH ST. (PARKING LOT ON 6TH ST.)	5.5X7.5	41	X	0		
5		46	3580 MARKET ST. (PARKING LOT ON 6TH ST.)	5.0X5.0	25	X	0		
5		47	3580 MARKET ST. (PARKING LOT ON 6TH ST.)	20.0X5.0	100	X	0		
5		48	3580 MARKET ST. (PARKING LOT ON 6TH ST.)	5.0X5.0	25	X	0		
5		49	3580 MARKET ST. (PARKING LOT ON 6TH ST.)	5.0X5.0	25	X	0		
5		50	3580 MARKET ST. (PARKING LOT ON 6TH ST.)	5.0X5.0	25	X	0		
5		129	3580 MARKET ST. (PARKING LOT ON 6TH ST.)	5.0X5.0	25	X	0		
16			SUBTOTAL SHEET 1 OF 3		19621		568	156	

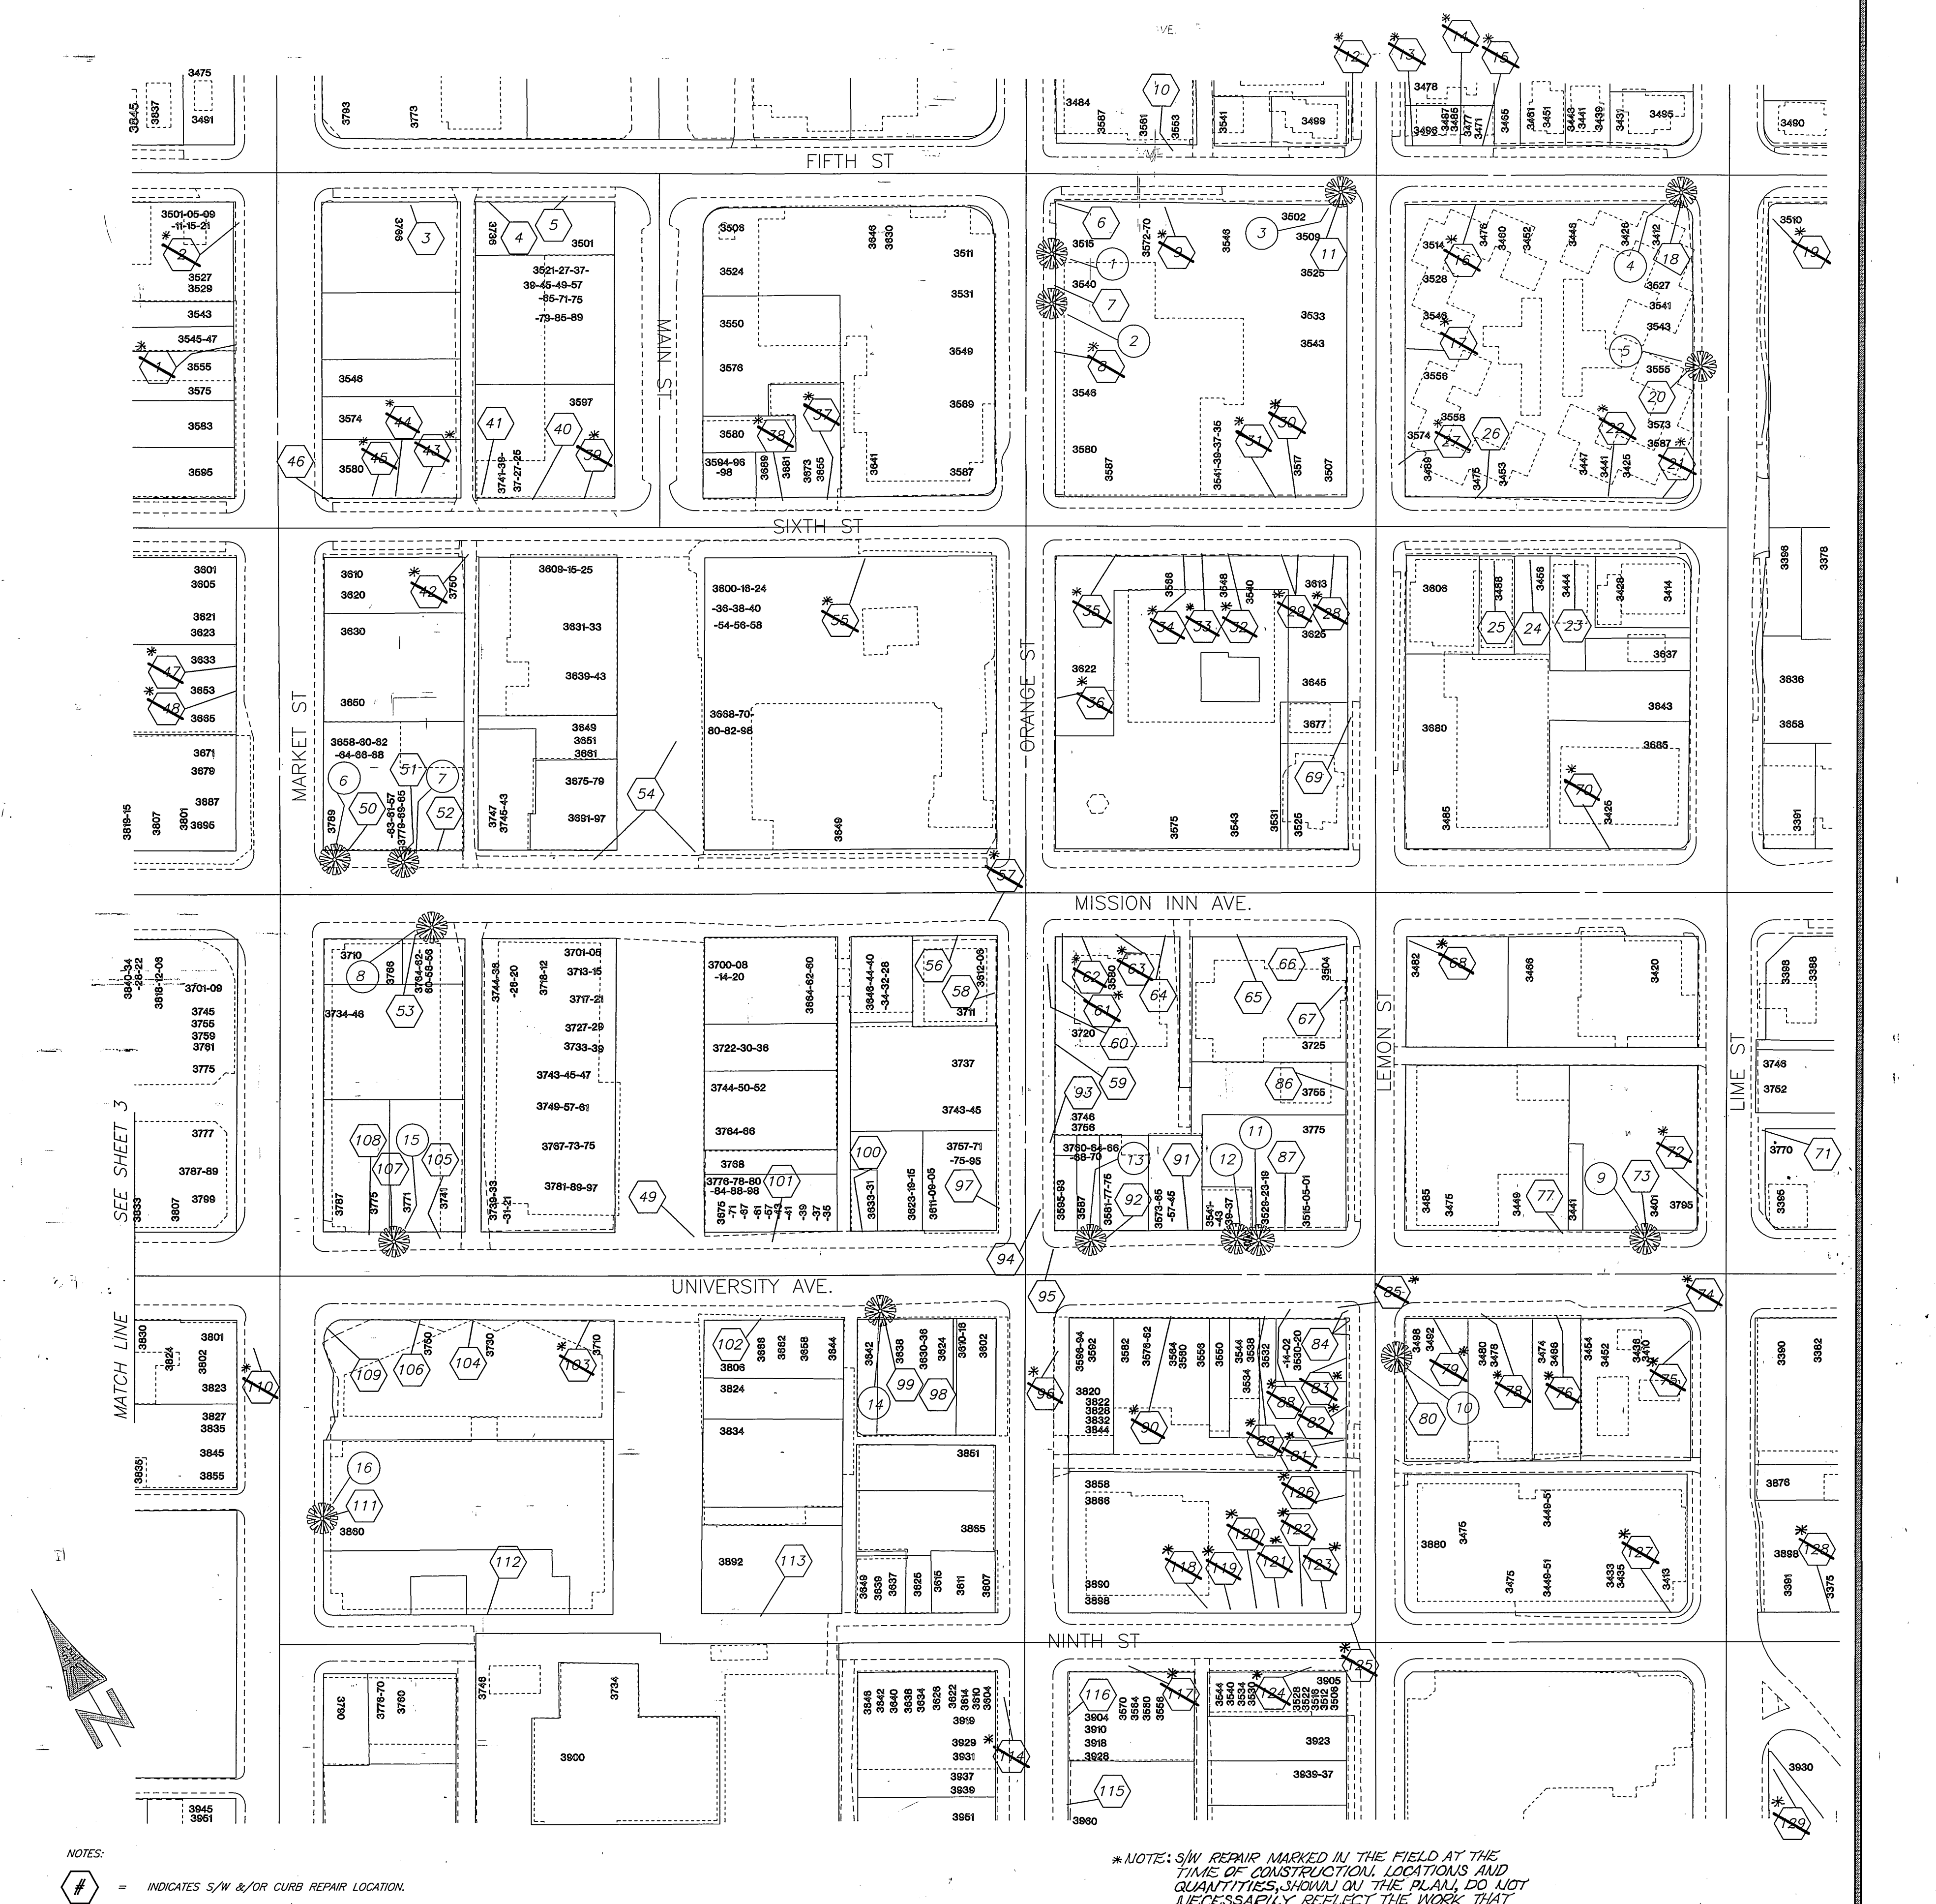

NOTES:

- # = INDICATES S/W &/OR CURB REPAIR LOCATION.
- \*# = INDICATES TREE TO BE REMOVED.
- \*NOTE: S/W REPAIR MARKED IN THE FIELD AT THE TIME OF CONSTRUCTION. LOCATIONS AND QUANTITIES SHOWN ON THIS PLAN DO NOT NECESSARILY REFLECT THE WORK THAT WAS DONE.
- # = THIS ITEM WAS NOT CONSTRUCTED.

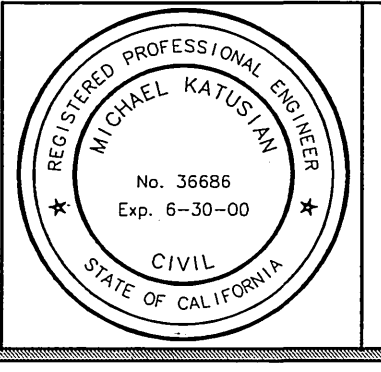

ENGINEER IN RESPONSIBLE CHARGE  
**Michael Katusian**  
 MICHAEL KATUSIAN  
 R.C.E. No. 36686 expires 6/30/00  
 DATE: 2/25/97


CITY OF RIVERSIDE, CALIFORNIA  
 PUBLIC WORKS DEPARTMENT  
 APPROVED BY: [Signature]  
 DEPUTY P.W. DIRECTOR  
 PRINCIPAL ENGINEER  
 DATE: 3/11/97

DOWNTOWN SIDEWALK REPAIR 96-97  
 ACCT. NO.: 230-541500-440223-30286  
 R-3463  
 SHEET 1 OF 3  
 FILE NO.  
 HORIZ. SCALE: NONE VERT. SCALE: NONE  
 INDEXED 4-21-97 LFH

#	TREE QTY.S	#	LOCATION	S/W	S.F. S/W	D/W	S.F. D/W	L.F. C&G	COMMENTS
17	1	130	3885 MARKET ST.	7.5X4.0	30	X	0	0	TREE ON MARKET BY MIN GAU RESTAURANT
		131	3769 TENTH ST.	9.5X2.0	20	X	0	0	
		132	3900 MAIN ST. (ON TENTH ST.)	4.0X2.0	320	X	0	0	RED COBBLE TEXTURED CONCRETE
		133	3900 MAIN ST. (ON TENTH ST. SIDE)	2.0X2.0	0	X	0	0	
		134	3900 MAIN ST. (ON TENTH ST. SIDE)	15.0X5.0	60	X	0	0	
		135	3605 TENTH ST.	3.0X2.0	15	X	0	0	
		136	3908 ORANGE ST.	3.0X2.5	0	X	0	0	
		137	3980 ORANGE ST.	3.0X2.0	25	X	0	0	
		138	3491 TENTH ST.	6.0X2.0	48	X	0	0	
		139	3378 TENTH ST.	4.0X2.0	24	X	0	0	
		140	3388 TENTH ST. (ON LIME ST.)	6.0X2.0	24	X	0	0	
		141	4057 LIME ST.	1.0X1.0	1	X	0	0	
		142	3410 LIME ST. (ON TENTH ST.)	4.0X2.0	4	X	0	26	
		143	3444 TENTH ST.	4.0X2.0	0	6.0X5.0	30	0	
		144	4024 LEMON ST.	3.0X3.0	9	X	0	0	
		145	3769 TENTH ST.	9.0X1.0	99	X	0	0	
		146	3778 TENTH ST.	29.0X8.0	232	X	0	0	
		147	4019 MARKET ST.	6.0X4.0	24	X	0	0	
		148	3609 ELEVENTH ST.	12.0X8.0	96	X	0	0	
		149	4078 ORANGE ST.	5.0X2.0	40	X	0	0	
		150	4086 ORANGE ST.	26.0X6.0	156	X	0	0	
		151	3545 ELEVENTH ST.	6.0X12.0	72	X	0	0	
		152	4085 LEMON ST.	3.0X2.0	24	X	0	10.0X5.0	
		153	3381 ELEVENTH ST.	2.0X2.0	40	X	0	0	
		154	3379 ELEVENTH ST.	2.0X2.0	100	X	0	0	
		155	4151 LEMON ST.	5.0X2.0	20	X	0	0	
		156	3920 ELEVENTH ST.	15.0X20.0	300	X	0	0	
		157	4102 ORANGE ST.	2.0X20.0	40	X	0	0	
		158	4130 ORANGE ST.	5.0X2.0	20	X	0	0	
		159	4145 ORANGE ST.	10.0X2.0	20	X	0	0	
		160	3610 ELEVENTH ST.	5.0X2.0	20	X	0	0	
		161	3640 ELEVENTH ST.	17.0X2.0	34	X	0	0	
		162	4129 MAIN ST.	5.0X2.0	20	X	0	0	
		163	4111 MAIN ST.	6.0X2.0	24	X	0	0	
		164	3736 ELEVENTH ST.	37.0X2.0	74	X	0	0	
		165	4128 MARKET ST.	2.0X2.0	40	X	0	0	
		166	4119 MARKET ST.	3.5X2.0	21	X	0	0	
		167	4135 MARKET ST.	3.5X13.0	46	X	0	0	
		168	4138 MARKET ST.	3.5X2.0	28	X	0	0	
		169	4134 MARKET ST.	3.5X2.0	28	X	0	0	
		170	3784 TWELFTH ST.	1.0X2.0	4	X	0	26	
		171	3784 TWELFTH ST.	1.0X2.0	4	X	0	0	
		172	4139 MAIN ST.	3.0X2.0	12	X	0	0	
		173	4176 MAIN ST.	3.0X2.0	12	X	0	0	
		174	4141 MAIN ST.	2.0X2.0	8	X	0	0	
		175	4182 LEMON ST.	6.0X2.0	24	X	0	0	
		176	3478 TWELFTH ST.	3.0X2.0	12	X	0	0	
		177	3473 TWELFTH ST.	5.0X2.0	20	X	0	0	
		178	3457 TWELFTH ST.	6.0X2.0	24	X	0	0	
		179	3430 TWELFTH ST.	8.0X17.0	136	X	0	0	
		180	3380 TWELFTH ST.	15.0X12.0	180	X	0	0	AROUND TREE WELLS
		181	4235 LEMON ST.	10.0X12.0	120	X	0	0	
		182	4235 LEMON ST.	12.0X12.0	144	X	0	0	
		183	4225 LEMON ST.	1.0X1.0	1	X	0	0	
		184	4205 LEMON ST.	1.0X1.0	1	X	0	0	
		185	4205 LEMON ST.	10.0X10.0	100	X	0	0	
		186	3540 TWELFTH ST.	6.0X2.0	24	X	0	0	
		187	3540 TWELFTH ST.	6.0X2.0	12	X	0	0	
		188	3540 TWELFTH ST.	X	0	12.0X18.0	216	0	
		189	3558 TWELFTH ST.	5.0X6.0	30	X	0	0	
		190	4204 ORANGE ST. (ON TWELFTH ST.)	5.0X6.0	30	X	0	0	
		191	4204 ORANGE ST. (ON TWELFTH ST.)	5.0X6.0	30	X	0	0	
		192	4220 ORANGE ST.	6.0X6.0	36	X	0	0	
		193	4220 ORANGE ST.	6.0X6.0	36	X	0	0	
		194	4220 ORANGE ST.	6.0X6.0	36	X	0	0	
		195	4220 ORANGE ST.	6.0X6.0	36	X	0	0	
		196	4220 ORANGE ST.	6.0X6.0	36	X	0	0	
		197	4232 ORANGE ST.	3.0X4.0	12	X	0	0	
		198	4257 ORANGE ST.	6.0X6.0	36	X	0	0	
		199	3612 TWELFTH ST. (ON ORANGE ST.)	6.0X10.0	60	X	0	0	
		200	3612 TWELFTH ST.	5.0X2.0	20	X	0	0	
		201	3612 TWELFTH ST.	5.0X2.0	20	X	0	0	
		202	3612 TWELFTH ST.	5.0X10.0	50	X	0	0	
		203	3612 TWELFTH ST.	5.0X10.0	50	X	0	0	
		204	3612 TWELFTH ST.	3.0X2.0	12	X	0	0	
		205	3670 TWELFTH ST.	4.5X2.0	23	X	0	0	
		206	3670 TWELFTH ST.	5.0X2.0	20	X	0	0	
		207	3670 TWELFTH ST.	5.0X2.0	20	X	0	0	
		208	3670 TWELFTH ST.	10.0X15.0	150	X	0	0	
		209	4253 MAIN ST.	5.0X7.0	35	X	0	0	
		210	4253 MAIN ST.	4.0X7.0	28	X	0	0	
		211	4213 MAIN ST.	11.0X3.0	33	X	0	0	
		212	3700 TWELFTH ST.	6.0X7.0	42	X	0	0	
		213	3734 TWELFTH ST.	27.0X7.0	189	X	0	0	
		214	3780 TWELFTH ST.	25.0X6.0	150	8.0X15.0	120	0	
		215	4217 MARKET ST. (ON TWELFTH ST.)	5.0X18.0	90	X	0	0	
		216	4217 MARKET ST.	3.0X2.0	12	X	0	0	TREE ON MARKET STREET BY ANTIQUE SHOP AT TWELFTH ST.
		217	4212 MARKET ST.	3.0X16.0	48	X	0	0	
		218	4274 MARKET ST.	4.0X2.0	20	X	0	0	
		219	4267 MARKET ST.	4.0X13.0	52	X	0	0	
		220	4271 MARKET ST.	3.0X3.0	9	X	0	0	REMOVE TREE AND REPLACE TREE WELL WITH SIDEWALK
		221	4269 MARKET ST.	3.0X3.0	9	X	0	0	
		222	4269 MARKET ST.	5.0X10.0	50	X	0	0	
		223	4280 MARKET ST.	X	0	0	0	0	
		224	3755 THIRTEENTH ST.	X	0	3.0X10.0	30	0	
		225	3745 THIRTEENTH ST.	2.0X10.0	20	X	0	0	
		226	4285 MAIN ST. (ON THIRTEENTH ST.)	5.0X8.0	40	X	0	0	
		227	4281 MAIN ST.	3.0X3.0	9	X	0	0	
		228	4275 MAIN ST.	3.0X3.0	9	X	0	0	
		229	4261 MAIN ST.	3.0X9.0	27	X	0	0	
		230	4265 MAIN ST.	6.0X6.0	36	X	0	0	
		231	4286 MAIN ST. (ON THIRTEENTH ST.)	2.0X8.0	16	X	0	0	
		232	4286 MAIN ST. (ON THIRTEENTH ST.)	1.0X8.0	8	X	0	0	
		233	4281 ORANGE ST. (ON THIRTEENTH ST.)	2.0X2.0	4	X	0	0	
		234	4284 ORANGE ST.	3.0X3.0	9	X	0	0	
		235	4286 ORANGE ST.	6.0X7.0	42	X	0	0	
		236	4286 ORANGE ST. (ON THIRTEENTH ST.)	5.0X2.0	10	X	0	0	
		237	3591 THIRTEENTH ST.	3.0X2.0	12	X	0	0	
		238	3591 THIRTEENTH ST.	5.0X2.0	10	X	0	0	
		239	3591 THIRTEENTH ST.	5.0X2.0	25	X	0	0	
		240	4285 LEMON ST. (THIRTEENTH ST.)	5.0X2.0	125	X	0	0	
		241	4285 LEMON ST. (THIRTEENTH ST.)	0.0X20.0	100	X	0	0	
		242	4285 LEMON ST. (THIRTEENTH ST.)	5.0X2.0	25	X	0	0	
		243	4264 LEMON ST.	1.0X4.0	4	X	0	0	
		244	4268 LEMON ST.	5.0X4.0	20	X	0	0	
		245	4284 LEMON ST.	5.0X2.0	10	X	0	0	
		246	4284 LEMON ST. (ON THIRTEENTH ST.)	12.0X6.0	72	X	0	0	
		247	3469 THIRTEENTH ST.	5.0X10.0	50	X	0	0	
		248	3465 THIRTEENTH ST.	3.0X8.0	24	X	0	0	
		249	3469 THIRTEENTH ST.	5.0X8.0	40	X	0	0	
		250	4324 LIME ST. (ON THIRTEENTH ST.)	10.0X5.0	50	X	0	0	
		251	4324 LIME ST.	12.0X4.0	48	X	0	0	FILL IN 3 TREE WELLS. INSUFFICIENT S/W
		252	4339 LIME ST.	4.0X4.0	16	X	0	0	
		253	4303 LIME ST.	3.0X6.0	18	X	0	0	
		254	3458 THIRTEENTH ST.	5.0X2.0	25	X	0	0	
		255	3458 THIRTEENTH ST.	3.0X3.0	9	X	0	0	
		256	4306 LEMON ST.	5.0X10.0	50	X	0	0	
		257	4330 LEMON ST.	5.0X10.0	50	X	0	0	
		258	4330 LEMON ST.	4.0X10.0	40	X	0	0	
		259	4315 LEMON ST. (ON THIRTEENTH ST.)	5.0X2.0	25	X	0	0	
		260	4315 LEMON ST. (ON THIRTEENTH ST.)	3.0X2.0	15	X	0	0	
		261	4310 ORANGE ST. (ON THIRTEENTH ST.)	5.0X2.0	25	X	0	0	
		262	4342 ORANGE ST.	3.0X2.0	12	X	0	0	
		263	4342 ORANGE ST.	3.0X3.0	9	X	0	0	
		264	4354 ORANGE ST.	3.0X2.0	12	X	0	0	
		265	4333 ORANGE ST.	5.0X10.0	50	X	0	0	
		266	4333 ORANGE ST.	3.0X8.0	24	X	0	0	
		267	4333 ORANGE ST. (ON THIRTEENTH ST.)	2.0X6.0	12	X	0	0	
		268	4333 ORANGE ST. (ON THIRTEENTH ST.)	5.0X7.0	35	X	0	0	
		269	4310 MAIN ST. (ON THIRTEENTH ST.)	2.0X2.0	4	3.0X4.0	12	0	
		270	4310 MAIN ST. (ON THIRTEENTH ST.)	2.5X10.0	25	X	0	0	
		271	4310 MAIN ST.	3.0X3.0	9	X	0	0	
		272	4310 MAIN ST.	6.0X6.0	36	X	0	0	
		273	4310 MAIN ST.	6.0X27.0	162	X	0	0	
		274	4380 MAIN ST.	6.0X6.0	36	X	0	0	
		275	4350 MAIN ST.	6.0X2.0	12	X	0	0	
		276	4353 MAIN ST.	X	0	3.0X3.0	9	0	
		277	4329 MAIN ST.	3.0X3.0	9	X	0	0	
		278	4307 MAIN ST.	5.0X2.0	25	X	0	0	
		279	3740 THIRTEENTH ST.	16.0X30.0	480	X	0	0	
		280	4388 MARKET ST.	5.0X2.0	10	X	0	15	
		281	4387 MARKET ST.	5.0X2.0	10	X	0	0	
		282	4391 MAIN ST.	2.0X6.0	12	X	0	18	
		283	3665 FOURTEENTH ST.	5.0X2.0	25	X	0	0	
		4	SUBTOTAL THIS CHART SEE RIGHT FOR SHI TOTALS		10257		611	67	




#	TREE QTY.S	#	LOCATION/ADDRESS	S/W	S.F. S/W	D/W	S.F. D/W	L.F. C&G	CROSS STREET (COMMENTS)
		295	4045 UNIVERSITY AVE.	10.0x8.0	80		X	0	
		296	4045 UNIVERSITY AVE.	5.0x5.0	25		X	0	
21	1	297	3955 UNIVERSITY AVE.	2.0x4.0	8		X	0	REMOVE TREE AND REPLACE THE TREE WELL WITH SIDEWALK
		298	3911 UNIVERSITY AVE.	4	0		X	0	REMOVE AND REPLACE SPANDREL, 235 S.F.
		299	3911 UNIVERSITY AVE.	2.5x4.0	10		X	0	
22	1	300	3911 UNIVERSITY AVE.	15.0x8.0	120		X	0	REMOVE TREE AND REPLACE THE TREE WELL WITH SIDEWALK
23	1	301	3911 UNIVERSITY AVE.	6.0x8.0	48		X	0	REMOVE TREE AND REPLACE THE TREE WELL WITH SIDEWALK
		302	3902 UNIVERSITY AVE.	6.0x15.0	90		X	0	FIGUS TREE LIFTING SIDEWALK
		303	3802 UNIVERSITY AVE.	12.0x20.0	240		X	0	FIGUS TREE LIFTING SIDEWALK, PARK'S TREE #15
24 & 25	2	304	3830 UNIVERSITY AVE.	9.0x18.0	162		X	0	FIGUS TREE LIFTING SIDEWALK, PARK'S TREE #16
		305	3844 UNIVERSITY AVE.	12.0x12.0	144		X	0	
		306	3844 UNIVERSITY AVE.	X	0	25.0x8.0		150	
		307	3892 UNIVERSITY AVE.	18.0x18.0	324		X	0	
		308	3970 UNIVERSITY AVE.	30.0x8.0	240		X	0	FIGUS TREE LIFTING SIDEWALK, PARK'S TREE #18
26	1	309	3980 UNIVERSITY AVE.	12.0x8.0	96		X	0	FIGUS TREE LIFTING SIDEWALK, SALVAGE TREE WELL COVER
		310	4040 UNIVERSITY AVE.	5.0x8.0	40		X	0	FIGUS TREE LIFTING SIDEWALK, SALVAGE TREE WELL COVER
		311	4308 LIME ST. (ON THIRTEENTH ST.)	12.0x8.0	96		X	20	
		312	3368 THIRTEENTH ST.	15.0x2.5	37.5		X	28	
		313	3368 THIRTEENTH ST.	X	0	15.0x15.0		225	20
		314	3338 THIRTEENTH ST.	5.0x5.0	25		X	0	14 WCR
		315	4307 MULBERRY ST. & 3325 THIRTEENTH ST.	12.0x8.0	96		X	14	WCR
		6	SUBTOTAL SHEET 3 OF 3		1959.50			375	123
		4	SUBTOTAL SHEET 2 OF 3		10744			811	89
		16	SUBTOTAL SHEET 1 OF 3		19621			523	156
		26	TOTAL		32324.50			1709	368

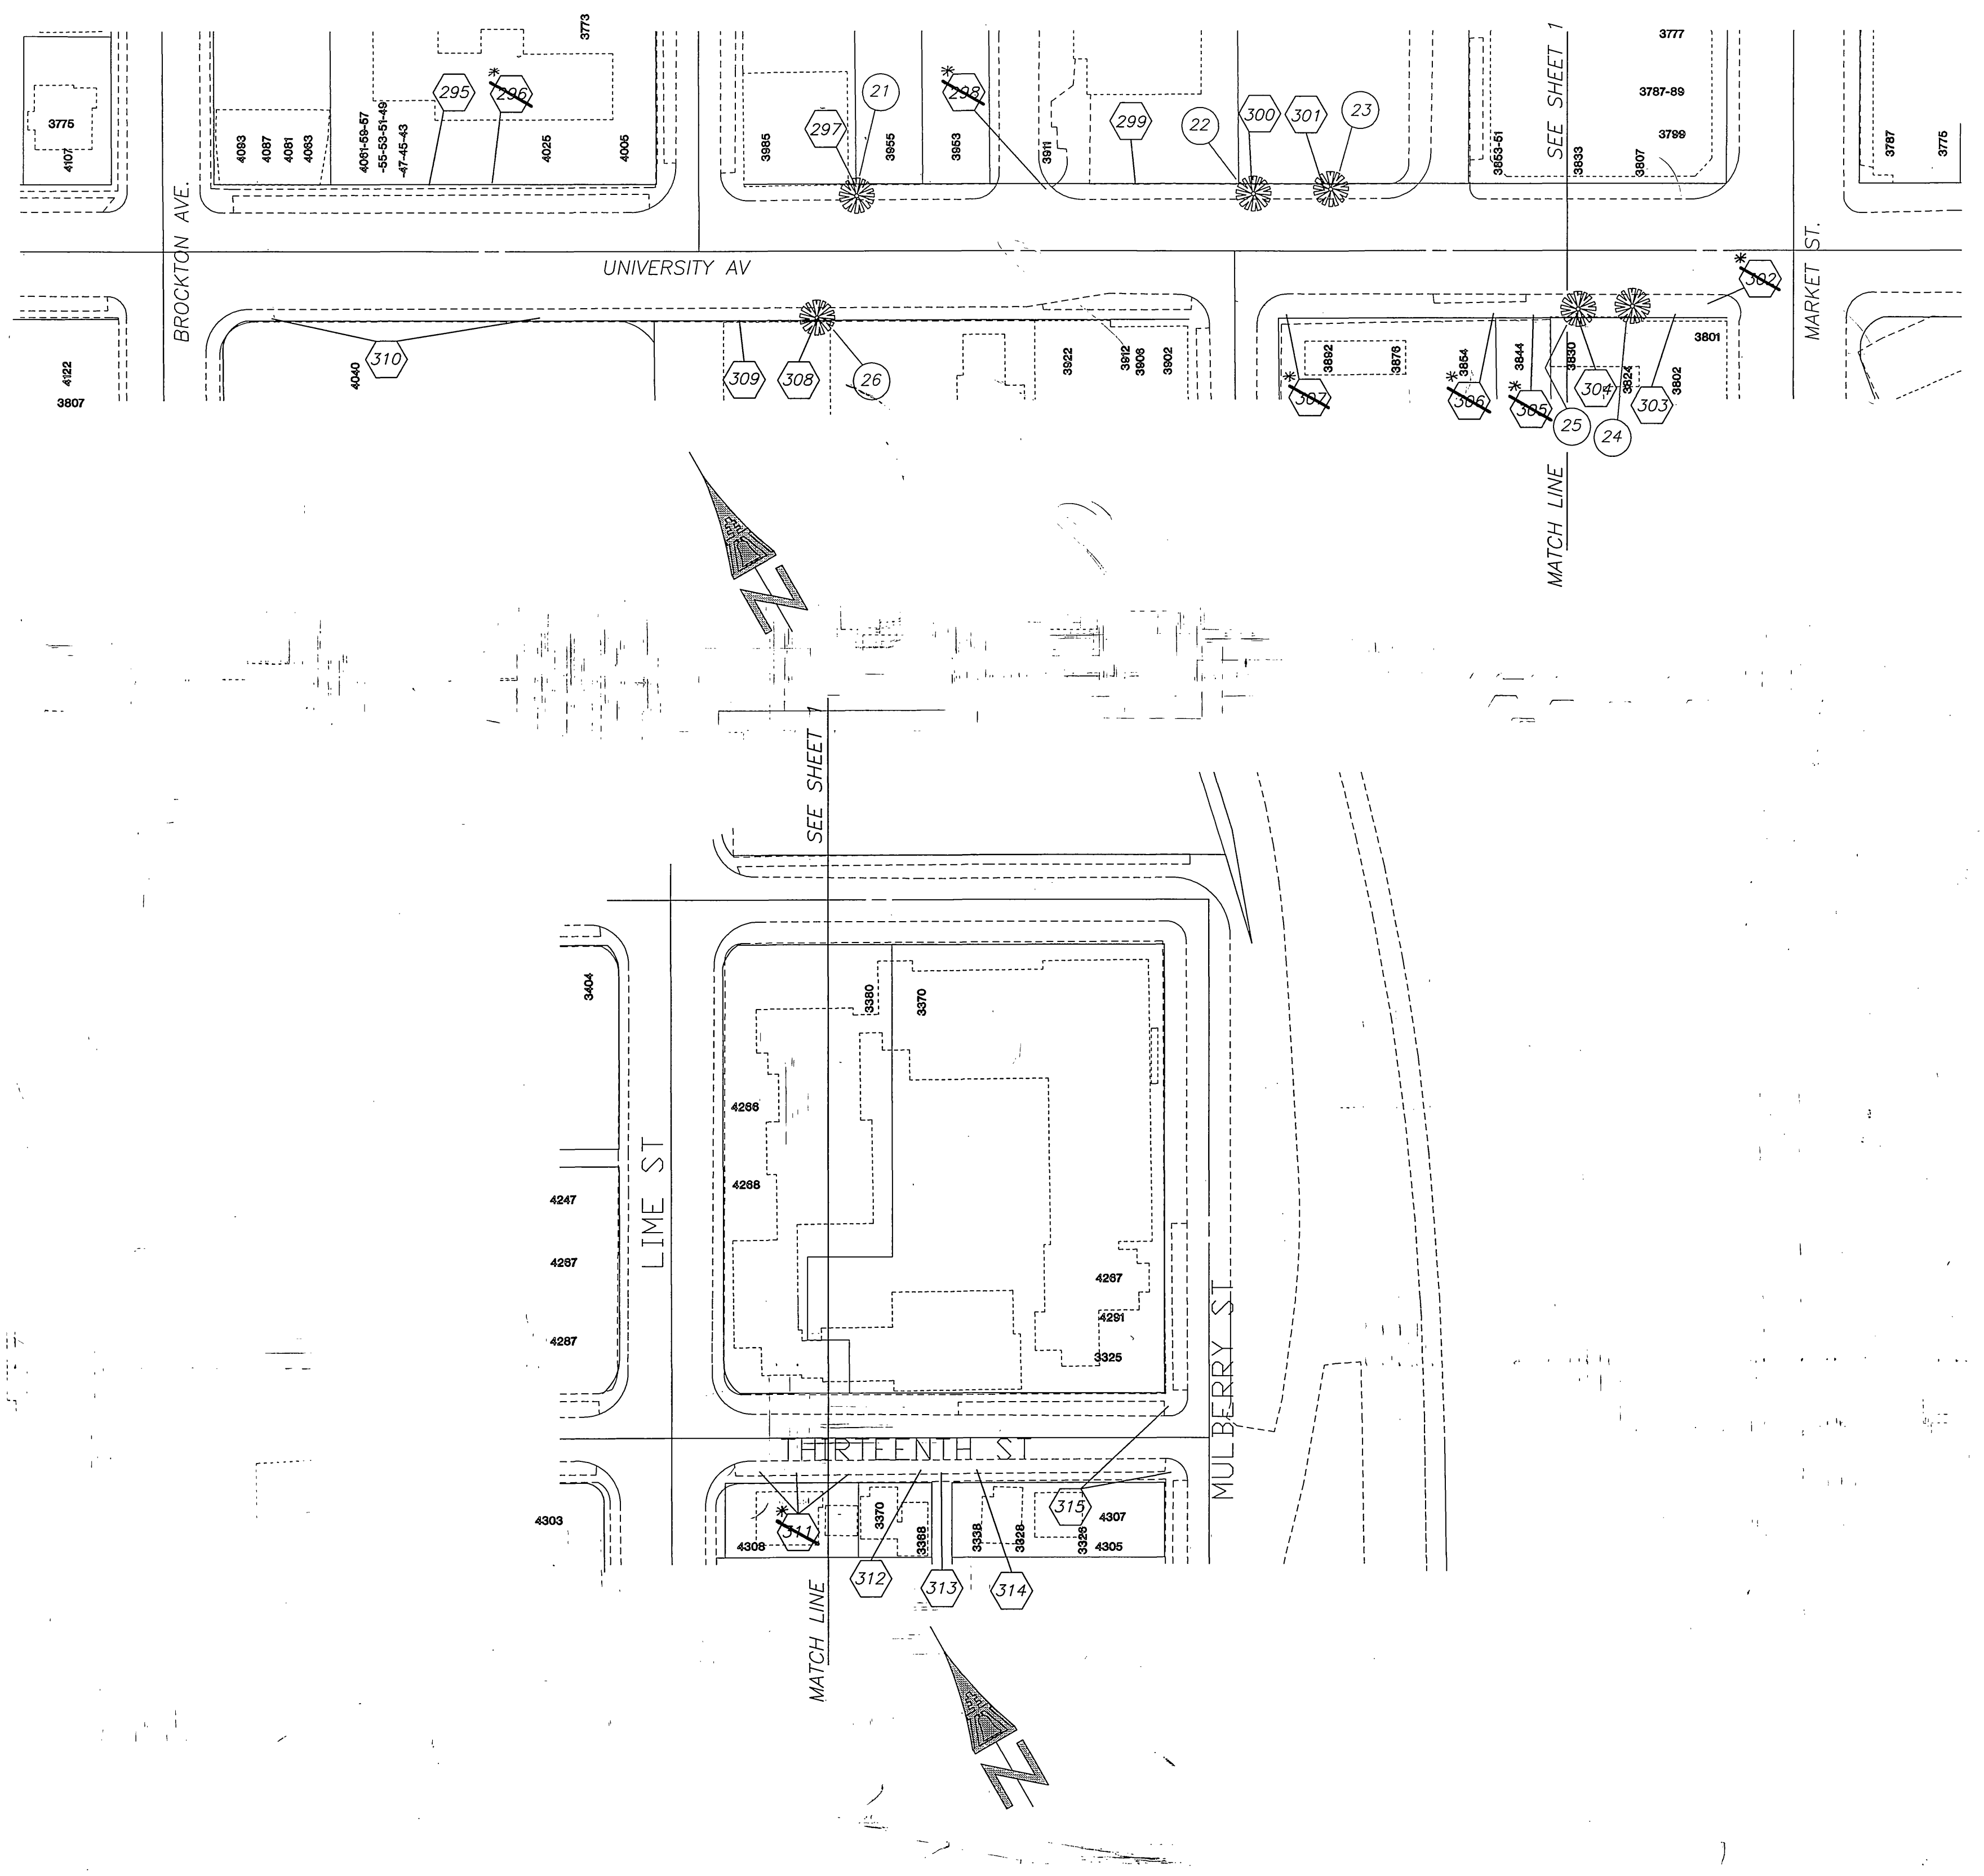

NOTES:  
 # = INDICATES S/W &/OR CURB REPAIR LOCATION.  
 # = INDICATES TREE TO BE REMOVED.

\*SEE AS BUILDING NOTES ON SHEET 1  
 \*AS BUILT 9/1/97 RM

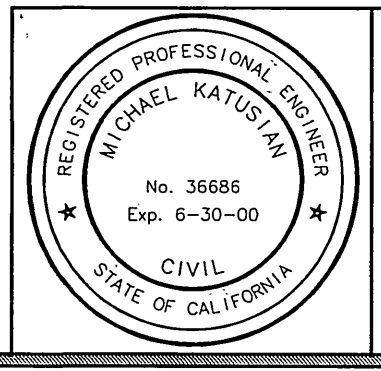

ENGINEER IN RESPONSIBLE CHARGE  
 Michael Katusian  
 MICHAEL KATUSIAN  
 R.C.E. No. 36686 expires 6/30/00  
 DATE 2/25/97

CITY OF RIVERSIDE, CALIFORNIA PUBLIC WORKS DEPARTMENT	
APPROVED BY	DATE
DEPUTY P.W. DIRECTOR	3/11/97
PRINCIPAL ENGINEER	3/17/97
DESIGNED BY	DATE
SK	3/11/97
DRAWN BY	DATE
LFH	3/17/97
CHECKED BY	DATE
SK	3/17/97

DOWNTOWN SIDEWALK REPAIR 96-97

ACCT. NO.: 230-541500-440223-30067  
 R-3463  
 SHEET 3 OF 3  
 FILE NO.

HORIZ. SCALE: NONE VERT. SCALE: NONE

INDEXED 4-21-97 LFL