




**UNDERGROUND AS-BUILT**  
 APRIL 1960  
**PROPOSED ROHR SPUR AT VAN BUREN & ARLINGTON**  
 E. YEAGER CO. MARCH 1960 DRAWN BY B.D. GILBERT  
 SCALE: 1" = 20' HORIZ. 1" = 2' VERT.  
 SHEET 1 OF 2  
 PLAN NO. Y-151

NOTE  
 RR WARNING DEVICES AT LOCATIONS SHOWN

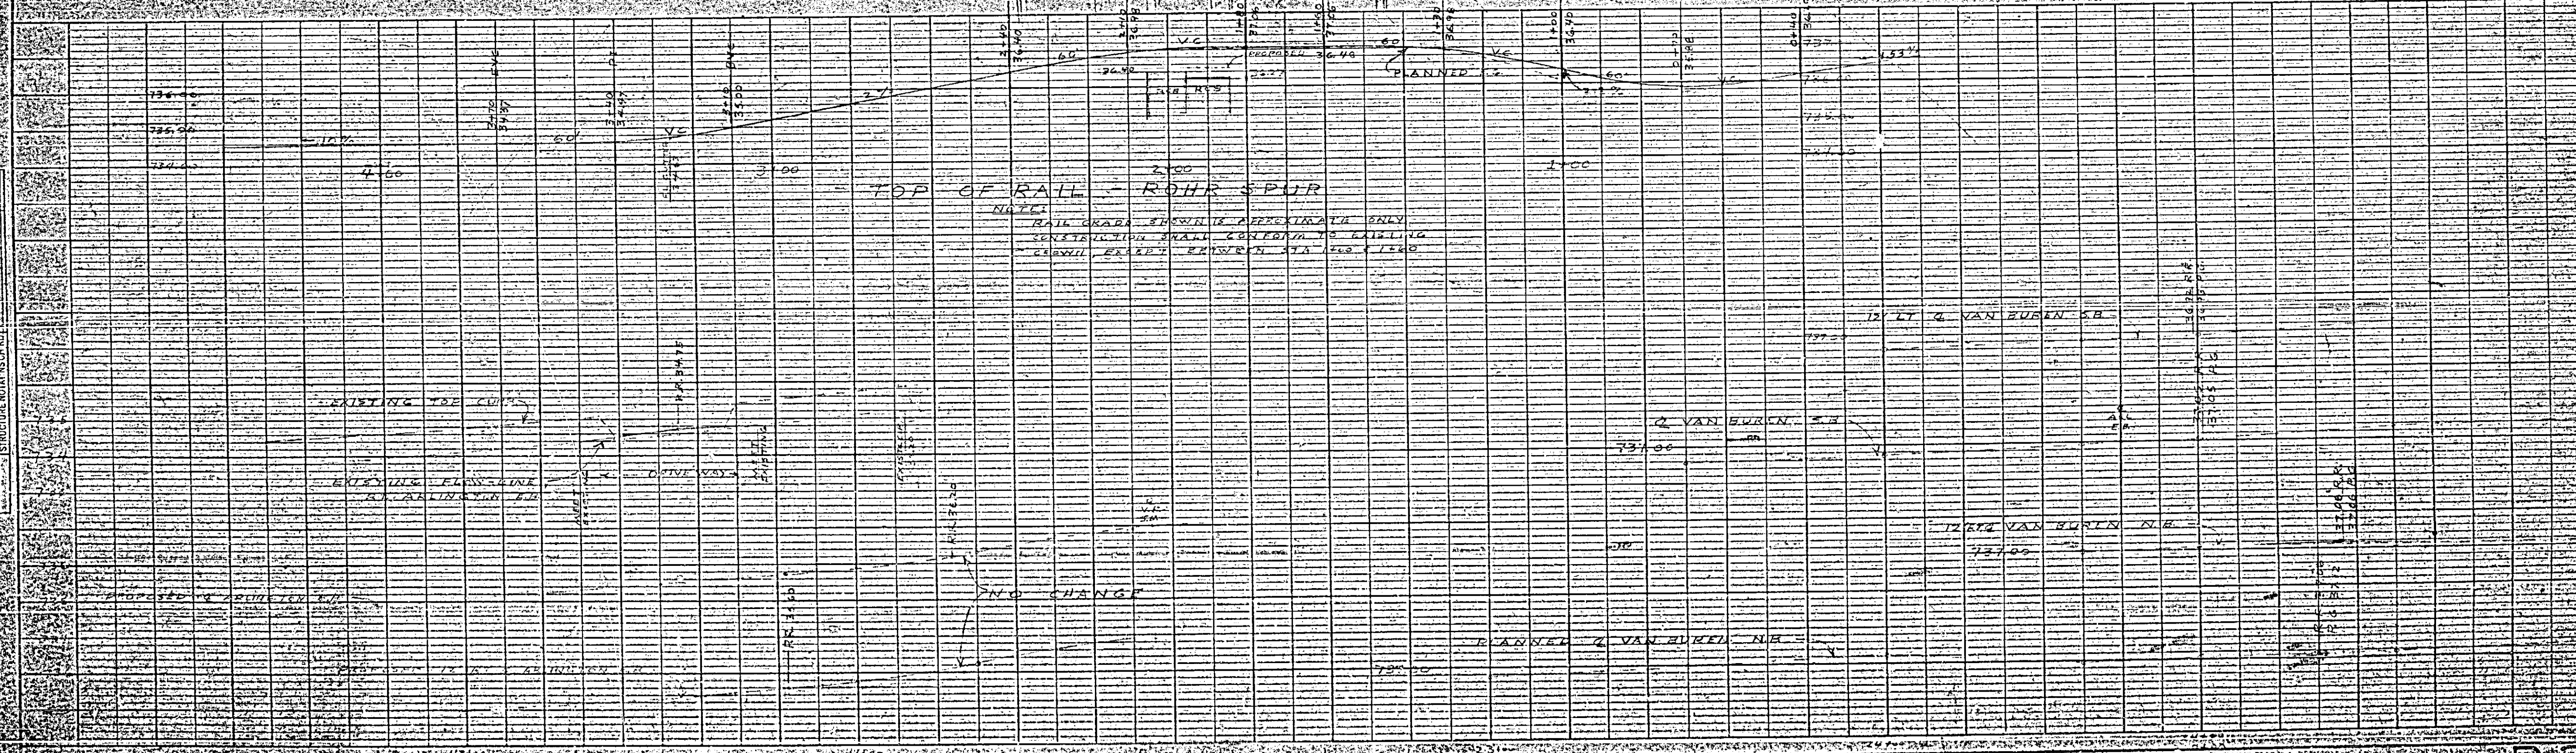

PLAN  
 DATE: \_\_\_\_\_  
 DRAWN BY: \_\_\_\_\_  
 CHECKED BY: \_\_\_\_\_  
 APPROVED BY: \_\_\_\_\_

PROFILE  
 DATE: \_\_\_\_\_  
 DRAWN BY: \_\_\_\_\_  
 CHECKED BY: \_\_\_\_\_  
 APPROVED BY: \_\_\_\_\_

