
DRAWING NUMBER	DRAWING TITLE	SHEI	
	STRUCTURAL		
S-01	GENERAL PLAN	4	
S-02	GENERAL NOTES & INDEX TO PLANS	4	
S-03	PART STRUCTURE ELEVATION AT BNSF RR	4	
S-04	DECK CONTOURS	4	
S-05	FOUNDATION PLAN NO. 1	4	
S-06	FOUNDATION PLAN NO. 2	5	
S-07	ABUTMENT 1 LAYOUT	5	
S-08	ABUTMENT 5 LAYOUT	5	
S-09 S-10	ABUTMENT DETAILS NO. 1 ABUTMENT DETAILS NO. 2	5	
S-11	ABUTMENT DETAILS NO. 3	5	
S-12	BENT DETAILS NO. 1	5	
S-13	BENT DETALS NO. 2	5	
S-14	BENT DETALS NO. 3	5	
S-15	BENT DETAILS NO. 4	5	
S-16	TYPICAL SECTION	6	
S-17	GIRDER LAYOUT NO. 1	6	
S-18	GIRDER LAYOUT NO. 2	6	
S-19 S-20	GIRDER DETAILS NO. 1 GIRDER DETAILS NO. 2	6	
S-20 S-21	GIRDER DETAILS NO. 2 GIRDER REINFORCEMENT NO. 1	6	
S-22	GIRDER REINFORCEMENT NO. 2	6	
S-23	JOINT SEAL ASSEMBLY (MAXIMUM MOVEMENT RATING =4")	6	
S-24	JOINT ARMOR DETAILS	6	
S-25	STRUCTURE APPROACH TYPE N(30)S	6	
S-26	STRUCTURE APPROACH DRAINAGE DETAILS	7	
S-27	CHAINLINK RAILING, TYPE 3 (MOD)	7	
S-28	MISCELLANEOUS DETAILS	7	
S–29 S–30	LOG OF TEST BORINGS — NO. 1 OF 3 LOG OF TEST BORINGS — NO. 2 OF 3	7	
S-31	LOG OF TEST BORINGS - NO. 3 OF 3	7	
S-100	RETAINING WALLS — GENERAL PLAN	7	
S-101	RETAINING WALL NO. 1 - LAYOUT AND DETAILS	7	
S-102	RETAINING WALL NO. 2 — WALL LAYOUT NO. 1	7	
S-103	RETAINING WALL NO. 2 — WALL LAYOUT NO. 2	7	
S-104	RETAINING WALL NO. 2 — WALL LAYOUT NO. 3	8	
S-105	RETAINING WALL NO. 3 — WALL LAYOUT NO. 1	8	
S-106 S-107	RETAINING WALL NO. 3 — WALL LAYOUT NO. 2	8	
S-107	RETAINING WALL NO. 3 — WALL LAYOUT NO. 3 MSE RETAINING WALL SECTIONS	8	
S-109	MSE RETAINING WALL DETAILS NO. 1	8	
S-110	MSE RETAINING WALL DETAILS NO. 2	8	
S-111	RETAINING WALL NO. 2 — ARCHITECTURAL DETAILS NO. 1	8	
S-112	RETAINING WALL NO. 3 — ARCHITECTURAL DETAILS NO. 2	8	
S-113	MSE RETAINING WALL — ARCHITECTURAL DETAILS NO. 3	8	
	TRAFFIC SIGNAL		
X-230B	TRAFFIC SIGNAL MODIFICATION COLUMBIA AVENUE AT LA CADENA AVENUE	90	
X-232A	TRAFFIC SIGNAL MODIFICATION COLUMBIA AVENUE AT CHICAGO AVENUE	91	
	& PAIGE DRIVE		
	ROADWAY CROSS SECTION		
CX-01	CROSS SECTIONS — COLUMBIA AVENUE	92	
CX-07 CX-02	CROSS SECTIONS — COLUMBIA AVENUE	93	
CX-03	CROSS SECTIONS — COLUMBIA AVENUE	94	
CX-04	CROSS SECTIONS — COLUMBIA AVENUE	95	
CX-05	CROSS SECTIONS — COLUMBIA AVENUE	96	
CX-06	CROSS SECTIONS - CHICAGO AVENUE	97	
CX-07	CROSS SECTIONS — CHICAGO AVENUE	98	
CX-08	CROSS SECTIONS - PAIGE DRIVE	99	
CX-09	CROSS SECTIONS— STACY COURT & ARDMORE STREET	100	
CX-10 CX-11	CROSS SECTIONS — EASTBOUND ACCESS ROAD CROSS SECTIONS — WESTBOUND ACCESS ROAD	101	
CX-11 $CX-12$	CROSS SECTIONS - WESTBOUND ACCESS ROAD CROSS SECTIONS - MAINTENANCE ROAD	102	
UN 12	SHOOS SECTIONS WITHTIEN WOLL HOND	, , ,	

AS BUILT DATE 9-14-10

DMJM HARRIS | AECOM 800 NORTH HAVEN, SUITE 410 ONTARIO, CA 91764

T (909)291-8150 F (909)291-8166

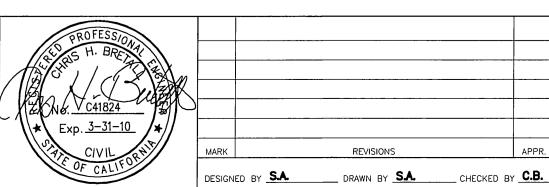

COLUMBIA AVENUE OVERPASS AT BNSF RAILROAD ACCT. NO.

R - 4036

INDEX OF DRAWINGS

K-01 SHEET 2 OF 103

BASIS OF BEARINGS

NORTH 00°32'47" EAST ALONG THE CENTERLINE OF IOWA AVENUE BETWEEN MARLBOROUGH AVENUE

ADJUSTMENT YEAR 1971

AND COLUMBIA AVENUE AS DERIVED FROM CITY OF RIVERSIDE CONTROL POINTS 109 AND 5178

BENCH MARK

"BRASS DISK STAMPED "J8-A" IN A MONUMENT WELL AT THE CENTERLINE INTERSECTION

CITY OF RIVERSIDE BENCH MARK J8-A3 DESCRIBED AS FOLLOWS:

DATUM 1929

OF IOWA AVENUE AND MARLBOROUGH AVENUE"

ELEVATION 929.11

LATERAL POUND

LEFT

LINEAR FEET LEFT HAND LAYOUT LINE


AS BUILT

DATE 9-14-10

DMJM HARRIS | AECOM | 800 NORTH HAVEN, SUITE 410

ONTARIO, CA 91764

T (909)291-8150 F (909)291-8166

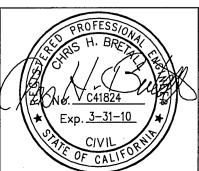

						C
\ <u> </u>						
MARK		REVISIONS		APPR.	DATE	
DESIGN	ED BY S.A.	DRAWN BY S.A.	CHECKED BY	C.B.		

COLUMBIA AVENUE OVERPASS AT BNSF RAILROAD ACCT. NO.

R - 4036

LEGEND, ABBREVIATIONS & SURVEY CONTROLS

K-02 SHEET 3 OF 103