
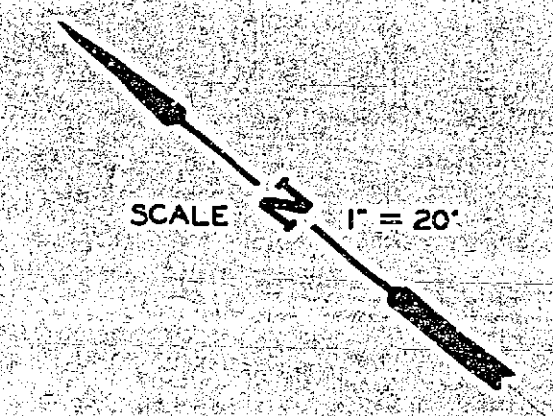


B.M. ELEV. 973.46 NAIL IN CENTER OF N.E. CB. RETURN ON ARROYO DR. AND GLENHAVEN.  
 F.B. 367/36, U/30  
 SCALE: 1" = 4' VERT.  
 1" = 20' HOR.

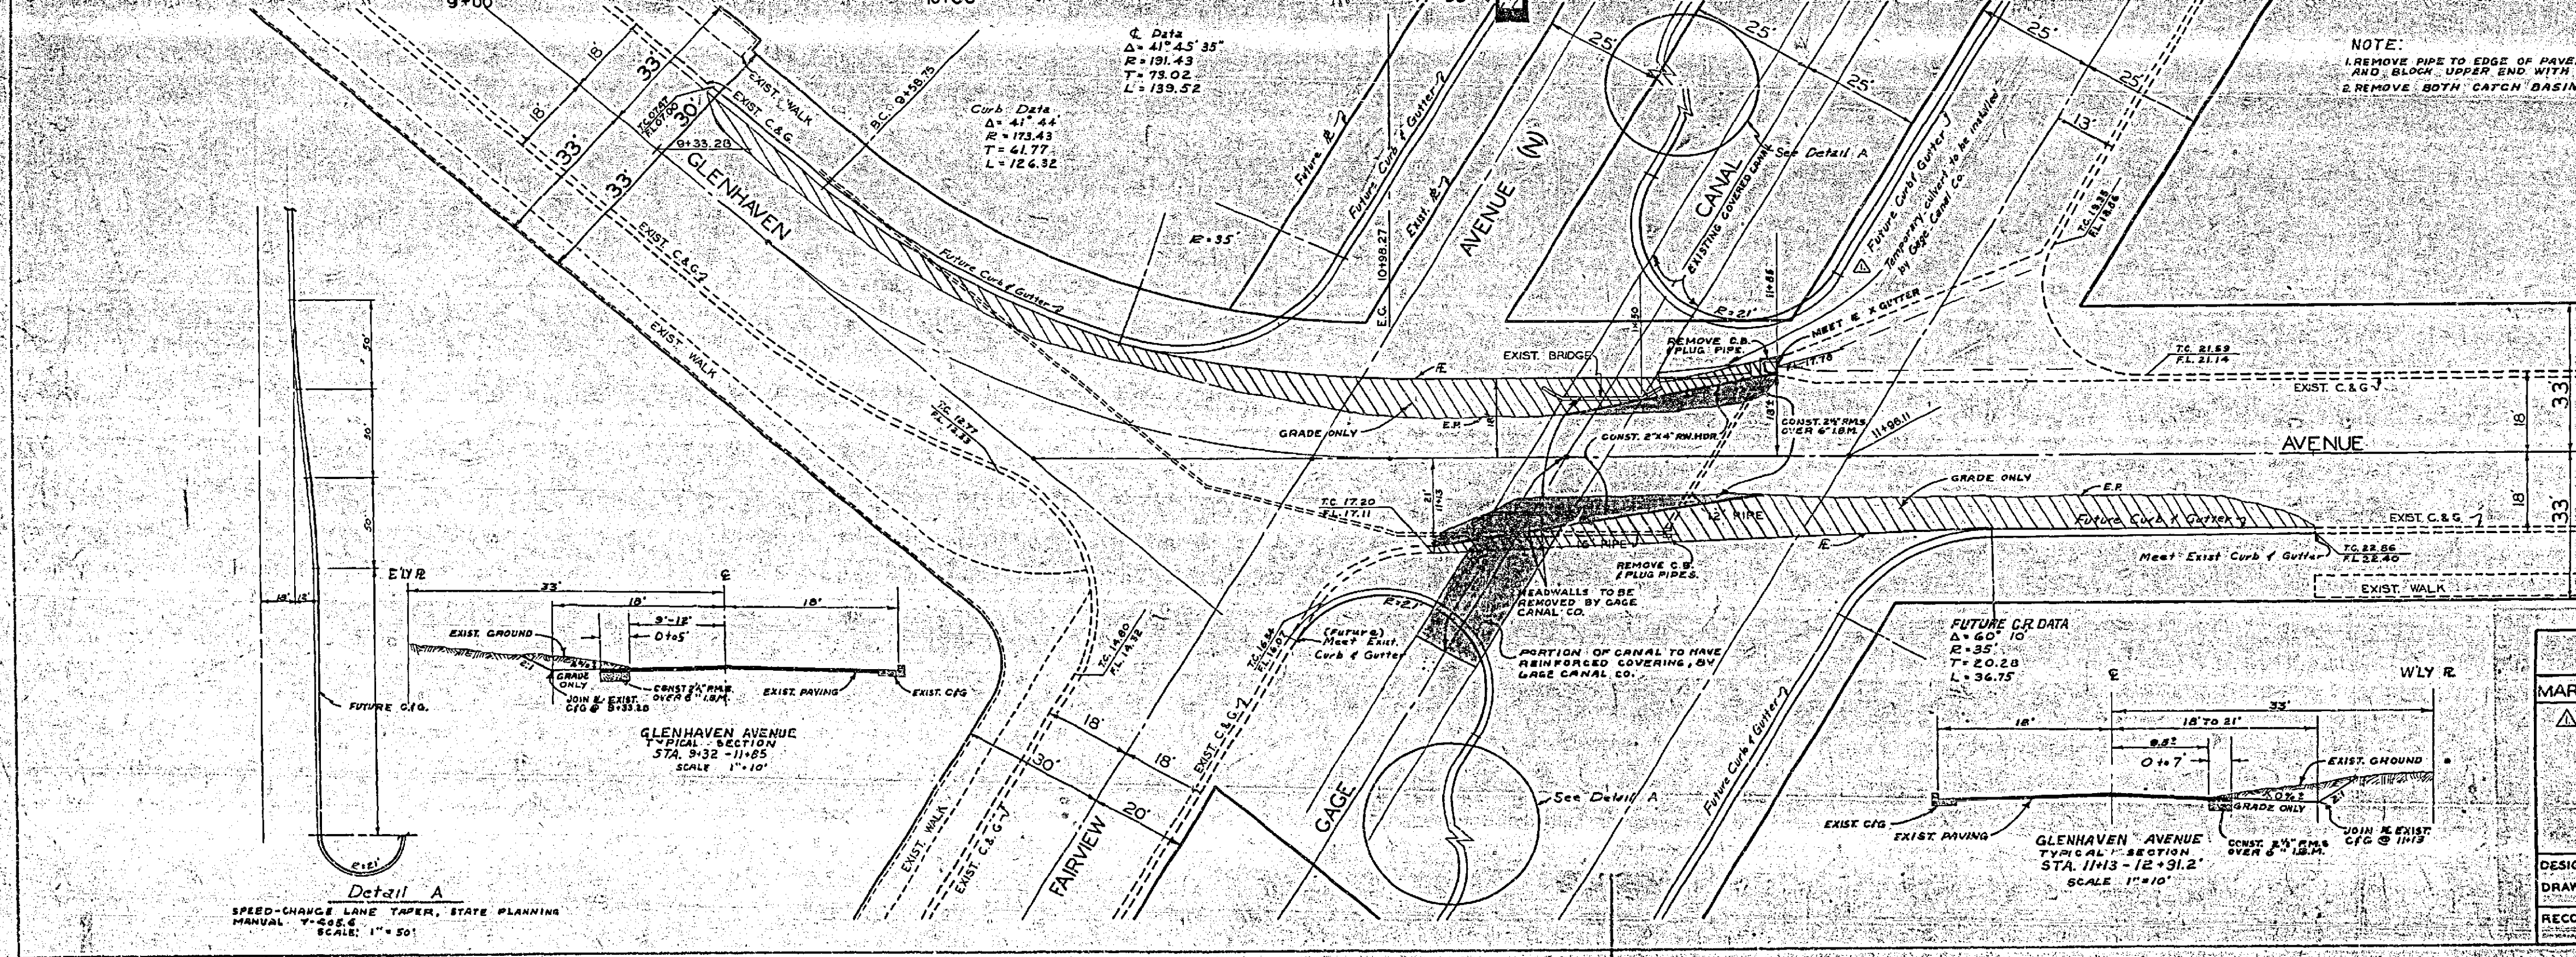

| REVISIONS |         | CITY OF RIVERSIDE CALIFORNIA<br>DEPARTMENT OF PUBLIC WORKS |
|-----------|---------|--|
| MARK      | DATE    |  |
| Δ         | 2-10-61 | Added temporary curbs.                                     |

|                     |   |   |                       |
|---------------------|---|---|-----------------------|
| DESIGNED BY<br>G.L. | CHECKED BY<br>C.M.L.  | APPROVED BY<br><i>[Signature]</i><br>DIRECTOR OF PUBLIC WORKS | R-421<br>SHEET 1 OF 1 |
| DRAWN BY<br>T.J.R.  | RECOMMENDED BY<br><i>[Signature]</i><br>ASSISTANT CITY ENGINEER | DATE<br>12-2-60   |                       |

PROFILE

|     |      |    |
|-----|------|----|
| NO. | DATE | BY |
| 1   |      |    |
| 2   |      |    |
| 3   |      |    |
| 4   |      |    |
| 5   |      |    |
| 6   |      |    |
| 7   |      |    |
| 8   |      |    |
| 9   |      |    |
| 10  |      |    |

PLAN

|     |      |    |
|-----|------|----|
| NO. | DATE | BY |
| 1   |      |    |
| 2   |      |    |
| 3   |      |    |
| 4   |      |    |
| 5   |      |    |
| 6   |      |    |
| 7   |      |    |
| 8   |      |    |
| 9   |      |    |
| 10  |      |    |