GENERAL CONSTRUCTION NOTES:

- THE CONTRACTOR SHALL PROVIDE AND MAINTAIN TRAFFIC AS INDICATED IN THE ASSOCIATED PROJECT SPECIAL PROVISIONS.
- CONSTRUCTION SHALL BE IN ACCORDANCE WITH THE CITY OF RIVERSIDE STANDARD DRAWINGS AND STANDARD SPECIFICATIONS FOR PUBLIC WORKS CONSTRUCTION, 2012 EDITION.
- EXISTING UTILITIES SHOWN ON THIS PLAN ARE PLOTTED FROM UTILITY RECORDS. THE CONTRACTOR IS REQUIRED TO TAKE DUE PRECAUTIONARY MEASURES TO LOCATE AND PROTECT ALL UTILITIES WHETHER OR NOT SHOWN ON THIS PLAN.
- CONFLICTING UTILITIES SHOWN WITHIN CONSTRUCTION AREA WILL BE RELOCATED PRIOR TO CONSTRUCTION.
- ALL STREET PULL BOXES, GATE VALVES, MANHOLES, ETC, AFFECTED BY CONSTRUCTION, SHALL BE ADJUSTED TO THE PROPOSED GRADE.
- (6) PRIME CONTRACTOR BIDDING THIS WORK SHALL HAVE A CLASS "A" OR "C-8"
- THE SEAM BETWEEN PASSES OF THE AC OVERLAY SHALL COINCIDE, AS CLOSE AS POSSIBLE. TO THE LANE LINES.
- 8 COLD MILLING SHALL BE AS DESCRIBED ON THE PLANS AND SPECIAL PROVISIONS OR AS DIRECTED BY THE ENGINEER.
- ANY DISTRESSED EXISTING PAVEMENT SHALL BE REMOVED AND REPLACED AS DIRECTED BY THE FNGINEERING AFTER COLD-MILLING AND PRIOR TO PLACEMENT OF DGAC.
- CONTRACTOR SHALL REMOVE ALL VEGETATION WITHIN ALL SIDEWALK PANELS WITHIN THE PROJECT
- ALL EXISTING IMPROVEMENTS INCLUDING, BUT NOT LIMITED TO, CURB, GUTTERS, CROSS GUTTERS, SIDEWALK, DRIVEWAYS, PARKWAY CULVERTS, INLETS, ETC. SHALL BE PROTECTED IN PLACE
- UNLESS OTHERWISE NOTED. EXISTING IRRIGATION SHALL BE PROTECTED OR MODIFIED, INCLUDING FURNISHING NEW
- MATERIALS, AS NECESSARY TO CONSTRUCT NEW CONCRETE IMPROVEMENTS.
- ALL FENCE POSTS SHALL BE PROTECTED OR MODIFIED AS NECESSARY IF POST FOUNDATION IS WITHIN A SIDEWALK PANEL THAT HAS BEEN CALLED OUT FOR REPLACEMENT.
- (14) FOR ALLEY WAY DRIVEWAY APPROACHES, CONTRACTOR SHALL CONSTRUCT AC PAVEMENT OVERLAY BEHIND DRIVEWAYS TO PROVIDE ADEQUATE FLOW LINES.
- ADEQUATE FLOW LINES SHALL BE MAINTAINED AT ALL LOCATIONS.

SHEET NO. SHEET NAME (LIMITS)

- TITLE SHEET AND NOTES
- RUTLAND AVENUE SIDEWALK IMPROVEMENTS PHILBIN AV TO WELLS AV (RUTLAND AV FROM PHILBIN AV TO 160' N/O GRAMERCY PL & 130' S/O GRAMERCY PL TO WELLS AV)
- GRAMERCY PLACE SIDEWALK IMPROVEMENTS COONEN DR TO PICKER ST (GRAMERCY PL FROM COONEN DR TO PICKER ST & RUTLAND AV FROM 160' N/O GRAMERCY PL TO 130' S/O GRAMERCY PL)

LEGEND:

PROPOSED PCC

EXISTING PCC


PROPOSED AC

EXISTING TOPOGRAPHY:

- SANITARY SEWER M.H.
- ⊗ GATE VALVE


영 FIRE HYDRANT

- STORM DRAIN M.H.
- ELECTRICAL TEST STATION (GAS)
- © ELECTRIC M.H.
- W WATER M.H.

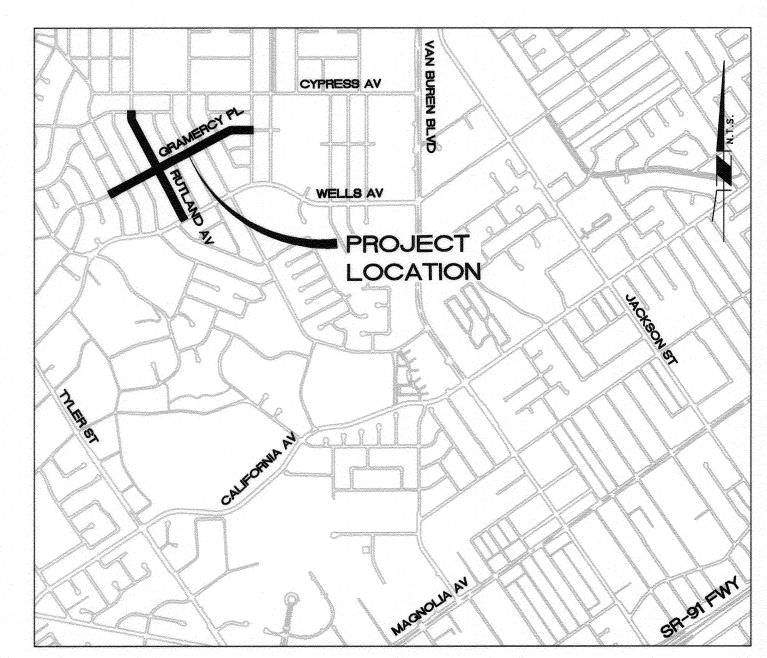


VICINTY MAP

RIVERSIDE

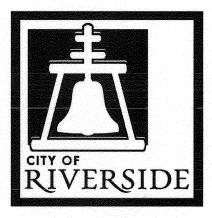

CALIFORNIA

PUBLIC WORKS DEPARTMENT RUTLAND AVENUE AND GRAMERCY PLACE SIDEWALK IMPROVEMENTS

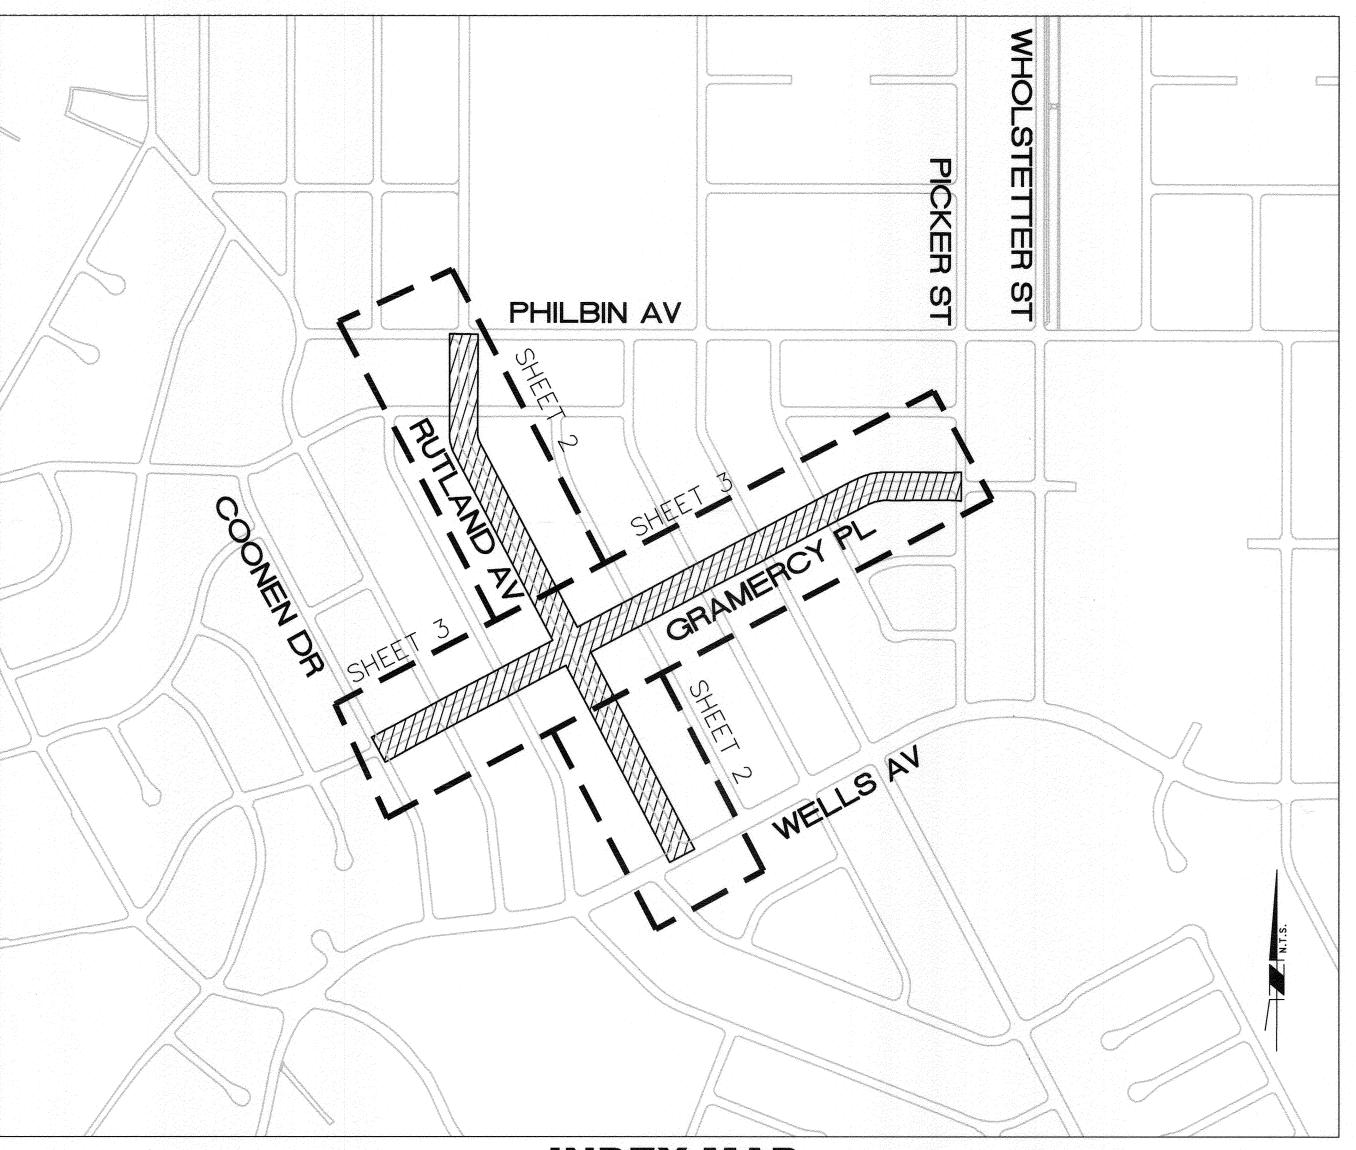

INDEX MAP

--- SHEET LIMITS


LEGEND PROJECT LOCATION

CONSTRUCTION NOTES:

- REMOVE AND REPLACE IN KIND EXISTING FACILITY. NUMBERS ABOVE 100 IN A HEXAGON ON THE PLAN REFER TO THE RESPECTIVE STANDARD DRAWING AND SHALL BE CONSTRUCTED ACCORDINGLY. ANY NOTE SHOWN BELOW THE STANDARD DRAWING NUMBER INDICATES THE SPECIFIC TYPE, ACTION, OR MODIFICATION TO BE CONSTRUCTED DIMENSIONS OF NEW FACILITY SHALL BE MODIFIED AS NECESSARY, EXCLUDING ADA REQUIREMENTS, TO MATCH EXISTING FACILITY REMOVED.
- ADJ ADJUST TO GRADE, DESCRIPTION PER PLAN (--): (WM) WATER METER.
- PROTECT IN PLACE, DESCRIPTION PER PLAN (--): (MB) MAILBOX. (PP) POWER POLE. (GUY) GUY WIRE. (FH) FIRE HYDRANT. (SGN) SIGN AND POST. (CLF) CHAIN LINK FENCE. (WIF) WROUGHT IRON FENCE. (FNC) WOODEN FENCE. (WLL) WALL. (GRS) GRASS.
- RELOCATE EXISTING TO PROPOSED LOCATION, DESCRIPTION PER PLAN (--): (MB) MAILBOX. (CLF) CHAIN LINK FENCE. (SGN) SIGN AND POST. (GATE) GATE AND POSTS.
- REMOVE EXISTING AND REPLACE WITH NEW AT PROPOSED LOCATION, DESCRIPTION PER PLAN. (CLF) CHAIN LINK FENCE. (FNC) WOODEN FENCE. (ROS) ROSE BUSHES. (MB) MAILBOX. (WHL) REPLACE EXISTING CHAIN LINK ROLLING GATE CASTERS WITH 6" GATE CASTERS PER SPECIAL PROVISIONS. (PST) REPLACE CHAIN LINK GATE POSTS WITH NEW POSTS AND FOUNDATION AT EXISTING LOCATION. REATTACH EXISTING GATE TO NEW POSTS AT EXISTING ELEVATION.
- REMOVE EXISTING, DESCRIPTION PER PLAN (--): (BSH) BUSH. (RCK) ROCK. (TREE) REMOVE TREE AS PART OF CLEARING AND GRUBBING. (T1) CLASS I TREE AND ROOTS. (T2) CLASS II TREE AND ROOTS. (CON) PORTLAND CEMENT CONCRETE PAVEMENT. (CLF) CHAIN LINK FENCE. (WLL) REMOVE INTERFERING PORTION OF WALL AND RECONSTRUCT AS NECESSARY TO PROVIDE FINISHING BLOCK AT WALL END AND CAP TO MATCH IN-KIND. (BRD) LANDSCAPE BORDER.
- CONSTRUCT CURB AND GUTTER PER CITY STD 200 WITH THE FOLLOWING MODIFICATION (--): (M1) = CONSTRUCT 6" WIDE CURB IN FRONT OF DRIVEWAY APPROACH AND TRANSITION TO ADJACENT CURB WIDTH THROUGH DRIVEWAY WING. REPLACE GUTTER IN KIND.
 - (M2) = CONSTRUCT 2" LIP AND 6" WIDE CURB IN FRONT OF DRIVEWAY APPROACH. TRANSITION TO ADJACENT CURB WIDTH THROUGH DRIVEWAY WING. REPLACE GUTTER IN KIND.
 - CONSTRUCT DRIVEWAY PER CITY STD 302 WITH THE FOLLOWING MODIFICATIONS (--): (M1) = TRANSITION THE CURB WITHIN THE DRIVEWAY WING(S) BETWEEN THE 1" HIGH CURB AND THE EXISTING ADJACENT ROLLED CURB. TRANSITION THE WINGS TO JOIN PROPOSED ADJACENT SIDEWALK WIDTH. CONSTRUCT TYPE CURB-1 DRIVEWAY, MODIFIED TO CONSTRUCT WINGS AS DESCRIBED IN NOTE (M1),
 - AND TO REDUCE THE TYPICAL 8.33% APPROACH WIDTH TO 1.5' BETWEEN THE TOP OF 1" HIGH CURB AND FRONT OF 4' WIDE SIDEWALK SECTION. (M3) = CONSTRUCT TYPE CURB-1 DRIVEWAY, MODIFIED TO CONSTRUCT WINGS AS DESCRIBED IN NOTE (M1),
 - AND TO INCREASE THE DRIVEWAY APPROACH SLOPE TO 14% . CONSTRUCT DRIVEWAY MATCH UP BEYOND 4' WIDE SIDEWALK SECTION AS INDICATED ON PLANS.
 - (M4) = CONSTRUCT TYPE CURB-1 DRIVEWAY, MODIFIED TO CONSTRUCT WINGS AS DESCRIBED IN NOTE (M1), TO REDUCE APPROACH WIDTH AS DESCRIBED IN NOTE (M2), AND TO INCREASE APPROACH SLOPE AS DESCRIBED IN NOTE (M3).
- CONSTRUCT WHEELCHAIR RAMP PER CITY STD 304 WITH THE FOLLOWING TYPE OR MODIFICATION (--): (I) = TYPE I. (III) = TYPE III.
 - (M1) = CONSTRUCT WHEELCHAIR RAMP, TYPE PER PLAN, MODIFIED TO TRANSITION CURB WITHIN WHEELCHAIR RAMP WING(S) BETWEEN THE O" CURB FACE AND THE EXISTING ADJACENT ROLLED CURB. TRANSITION THE WINGS TO JOIN PROPOSED ADJACENT SIDEWALK WIDTH.
 - (M2) = CONSTRUCT TYPE I WHEELCHAIR RAMP WITH RETAINING CURB AT BACK OF LANDING. (M3) = CONSTRUCT WHEELCHAIR RAMP, MODIFIED TO CONSTRUCT WINGS AS DESCRIBED IN NOTE (M1) AND RETAINING CURB AS DESCRIBED IN NOTE (M2).
- CONSTRUCT SIDEWALK PER CITY STD 325 WITH THE FOLLOWING TYPE OR MODIFICATION (--):
- (CRB) = CONSTRUCT CURBSIDE SIDEWALK PER STD. PLANS. (M1) = CONSTRUCT CURBSIDE SIDEWALK, MODIFIED TO REDUCE WIDTH TO 5' FROM BACK OF CURB.
- (M2) = CONSTRUCT SIDEWALK AROUND EXISTING POWER POLE. MAINTAIN 4' CLEARANCE BEHIND POLE. (RET) = CONSTRUCT RETAINING CURB BEHIND SIDEWALK. INCLUDES CURB HEIGHTS UP TO 18".
- CONSTRUCT PARKWAY DRAIN PER CITY STD 410 WITH THE FOLLOWING TYPE (--): (II) SECTION INLET TYPE 2.
- LOWER EXISTING FACILITY TO NEW GRADE, DESCRIPTION PER PLAN (--): (TRK) WROUGHT-IRON FENCE TRACK. (GATE) CHAIN LINK ROLLING GATE AND TRACK.
- (AC) REMOVE EXISTING AC. RECONSTRUCT NEW AC TO MATCH GRADE OF ADJACENT ROADWAY SECTION.
- (SAW) SAWCUT CONCRETE.
- CONSTRUCT NEW STEPPED WALKWAY TO MATCHUP WITH EXISTING WALKWAY. MINIMUM/MAXIMUM RISE ON STEPS SHALL BE 4"/7.75", RUN SHALL BE 10".
- CONSTRUCT 2' LONG 6' TALL WROUGHT-IRON FENCE (WIF) ON BOTH SIDES OF NEW STEPPED WALKWAY AT 5447 IVANHOE AVENUE (4' TOTAL WIF). WIF SHALL BE JOINED TO SOUTH FACES OF EXISTING BLOCK WALL. RELOCATE EXISTING WIF GATE TO TOP OF NEW STEPPED WALKWAY, CONNECT TO NEW 2' WIF SECTIONS, AND
- RECONSTRUCT HINGES SO GATE SWINGS AWAY FROM STREET. CONSTRUCT 24' LONG 6" WIDE CONCRETE CHANNEL FOR CHAIN LINK ROLLING GATE. BOTTOM OF CHANNEL ELEVATION TO MATCH ADJACENT DRIVEWAY ELEVATION.
- FURNISH AND INSTALL NEW 23' LONG 4' TALL CHAIN LINK ROLLING GATE. GATE TRACK SHALL BE INSTALLED ON RELOCATED ADJACENT FENCE.
- RPU ELECTRIC DIVISION TO RELOCATE POWER POLE PRIOR TO CONSTRUCTION. CONTRACTOR TO PROTECT IN PLACE POLE AT NEW LOCATION.
- POWER POLE TO BE RELOCATED DURING CONSTRUCTION. RELOCATION WORK SHALL BE COORDINATED WITH RPU ELECTRIC PER SPECIAL PROVISIONS.
- WATER METER TO BE RELOCATED DURING CONSTRUCTION. RELOCATION WORK SHALL BE COORDINATED WITH RPU WATER PER SPECIAL PROVISIONS.



ENGINEER IN RESPONSIBLE CHARGE Edward Lara R.C.E. No. 63753 EXPIRES: 9-30-14

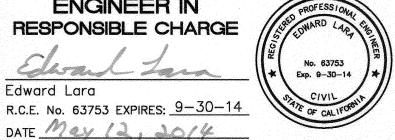

DESIGNED BY BGA DRAWN BY BGA CHECKED BY

DEPARTMENT OF PUBLIC WORKS APPROVED BY (22.23///2) CITY ENGINEER 5-12-14

NGINEERING MANAGER

ONSTRUCTION ADMIN.

RAFFIC DIVISION

REETS DIVISION

CITY OF RIVERSIDE. CALIFORNIA

SIDEWALK IMPROVEMENTS RUTLAND AVENUE AND GRAMERCY PLACE SIDEWALK IMPROVEMENTS

R-4281

DESIGN WORK ORDER. NO.: 1410703 CONSTR. WORK ORDER. NO.: 1419060

AS-BUILT 10-27-15 DC

DATE 5/15/2019 TITLE SHEET AND NOTES FILE NAME: R4281-01.DWG HORIZ, SCALE: NA VERT, SCALE: NA

