
# RIVERSIDE

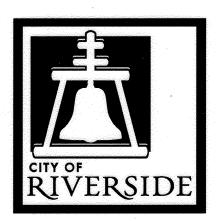

### CALIFORNIA


## PUBLIC WORKS DEPARTMENT 2014-2015 CDBG - WARD 6 STREET IMPROVEMENTS FOR JONES AVENUE FROM HOLE AVENUE TO WELLS AVENUE A HUD FUNDED PROJECT

### GENERAL CONSTRUCTION NOTES:

- THE CONTRACTOR SHALL PROVIDE AND MAINTAIN TRAFFIC AS INDICATED IN THE ASSOCIATED PROJECT SPECIAL PROVISIONS.
- CONSTRUCTION SHALL BE IN ACCORDANCE WITH THE CITY OF RIVERSIDE STANDARD
- CONTRACTOR IS REQUIRED TO TAKE DUE PRECAUTIONARY MEASURES TO LOCATE AND
- 4. CONFLICTING UTILITIES SHOWN WITHIN CONSTRUCTION AREA WILL BE RELOCATED PRIOR TO CONSTRUCTION.
- 6. PRIME CONTRACTOR BIDDING THIS WORK SHALL HAVE A CLASS "A" OR "C-8".
- 7. THE SEAM BETWEEN PASSES OF THE AC OVERLAY SHALL COINCIDE, AS CLOSE AS
- 8. COLD MILLING SHALL BE AS DESCRIBED ON THE PLANS AND SPECIAL PROVISIONS OR AS
- 9. ANY DISTRESSED EXISTING PAVEMENT SHALL BE REMOVED AND REPLACED AS DIRECTED BY THE ENGINEERING AFTER COLD-MILLING AND PRIOR TO PLACEMENT OF DGAC.
- 10. CONTRACTOR SHALL REMOVE ALL VEGETATION WITHIN ALL SIDEWALK PANELS WITHIN THE
- 11. ALL EXISTING IMPROVEMENTS SHOWN HEREON SHALL BE PROTECTED IN PLACE UNLESS
- 12. EXISTING IRRIGATION SHALL BE PROTECTED OR MODIFIED AS NECESSARY TO CONSTRUCT NEW CONCRETE IMPROVEMENTS.
- 13. ALL FENCE POSTS SHALL BE PROTECTED OR MODIFIED AS NECESSARY IF POST FOUNDATION IS WITHIN A SIDEWALK PANEL THAT HAS BEEN CALLED OUT FOR REPLACEMENT.


#### CONSTRUCTION NOTES:

- NUMBERS ABOVE 100 IN A HEXAGON ON THE PLAN REFER TO THE RESPECTIVE STANDARD DRAWING AND SHALL BE CONSTRUCTED ACCORDINGLY. UNLESS MODIFICATIONS ARE NOTED ON THE PLAN OR COVER SHEET. ANY NUMBER SHOWN BELOW THE STANDARD DRAWING NUMBER INDICATES THE SPECIFIC ALTERNATE TO BE CONSTRUCTED.
- ADJ ADJUST TO GRADE, DESCRIPTION PER PLAN. (MH) SEWER OR STORM DRAIN. (GV) GATE VALVE. (ETS) ELECTRIC TEST STATION
- PROVIDE VARIABLE DEPTH COLDMILLING TO TRANSITION FROM 0.15' AT GUTTER LIP/JOINT TO 0' DEPTH AT THE MILL WIDTH INDICATED. (XX) = WIDTH OF LINEAR COLD MILL AS INDICATED ON PLANS.
- COLD MILL EXISTING AC PAVEMENT. (DEPTH =0.15').
- OVERLAY EXISTING PAVEMENT WITH 0.15' DGAC PAVEMENT.
- CONTRACTOR SHALL MATCH EXISTING AC DRIVEWAYS AND RECONSTRUCT EXISTING AC FLOWLINE. BERM AND/OR WALKWAY AS NEEDED AND DIRECTED IN FIELD BY ENGINEER.

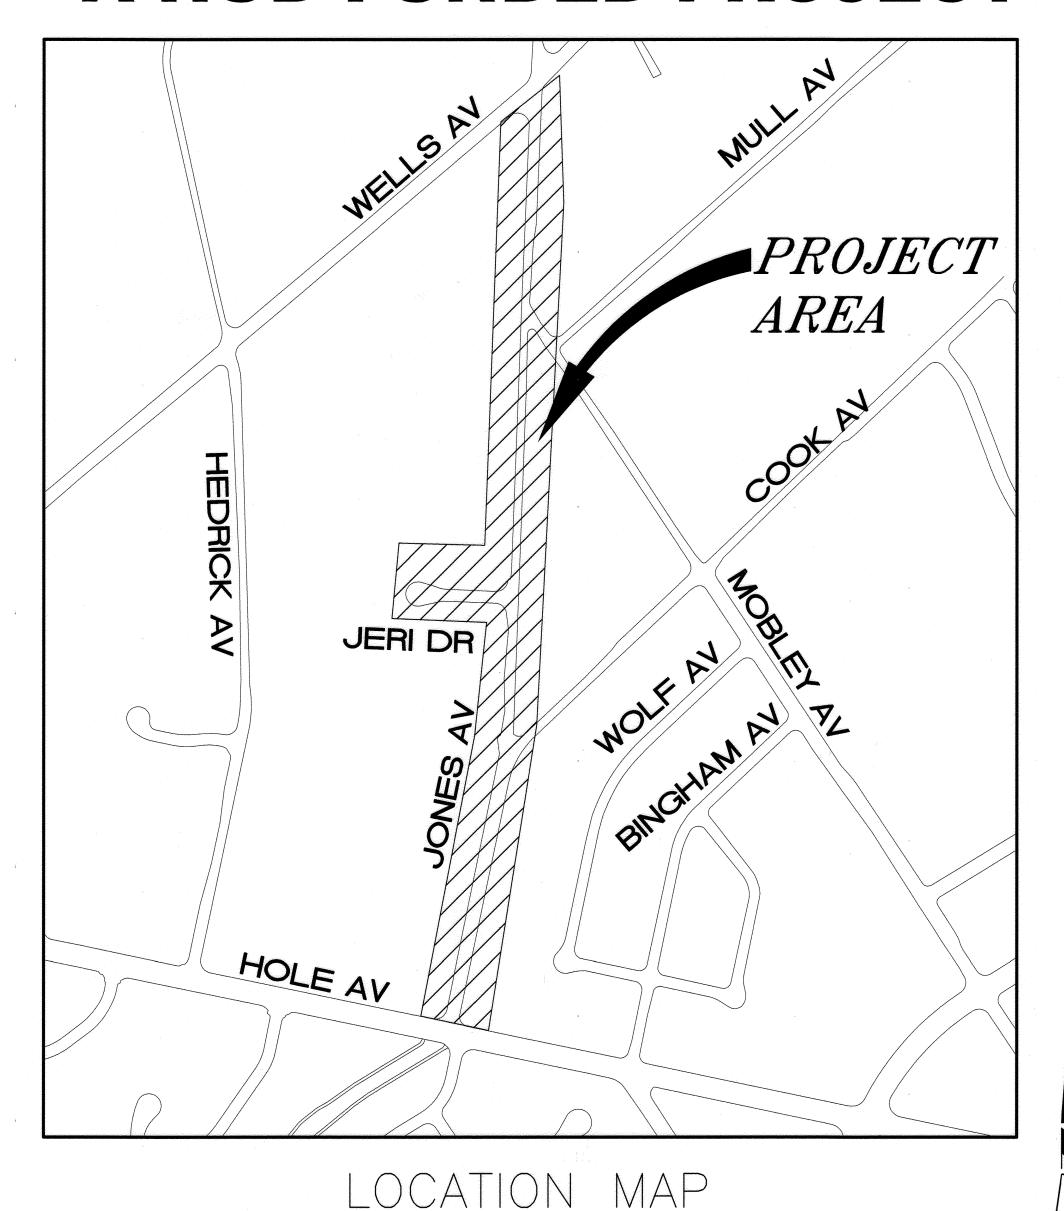

#### EXISTING TOPOGRAPHY:

- ELECTRICAL TEST STATION (GAS)
- ♥ FIRE HYDRANT
- W WATER M.H.

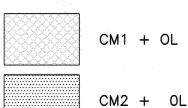

LEGEND:

PROPOSED PCC

SHEET INDEX: STREET IMPROVEMENTS


SHEET NO. DESCRIPTION


- TITLE SHEET
- MAINTENANCE PLAN

MAINTENANCE PLAN

AS-BUILT 7-20-18 DESIGN WORK ORDER. NO.: 1520062 CONSTR. WORK ORDER. NO.: 1604748 STREET IMPROVEMENTS CITY OF RIVERSIDE, CALIFORNIA

VERT. SCALE: N/A

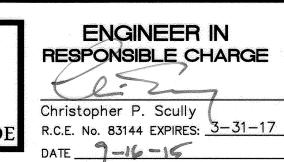

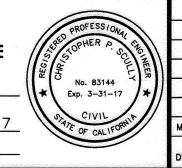

أندمستين	Exercise the second		Same and the state of the state				
				APPRO			
				ENGINEERII			
				CONSTRUC			
ARK	REVISIONS	APPR.	DATE	TRAFFIC D			
20.700							
SIGN	ED BYCSDRAWN BYDC/CS _CHECKED BY	cs		SURVEYOR			


DEP	DEPARTMENT OF PUBLIC WORKS						
APPROVED BY	BY	DATE	APPROVED BY				
ENGINEERING MANAGER	řΜ	9/17/15	1/4/2/1				
CONSTRUCTION ADMIN.	1)4	9.19.10	CITY ENGINEER				
TRAFFIC DIVISION	S.H	9-22-15	~1 )				
STREETS SERVICES			DATE 9/23/2015				
SURVEYOR	B	9122115					


2014-2015 CDBG - WARD 6 APPROVED BY STREET IMPROVEMENTS FOR JONES AVENUE FROM WELLS AVENUE TO HOLE AVENUE DATE 9/23/2015 TITLE SHEET


HORIZ, SCALE: N/A

FILE NAME: R4342-1.DWG

R-4342

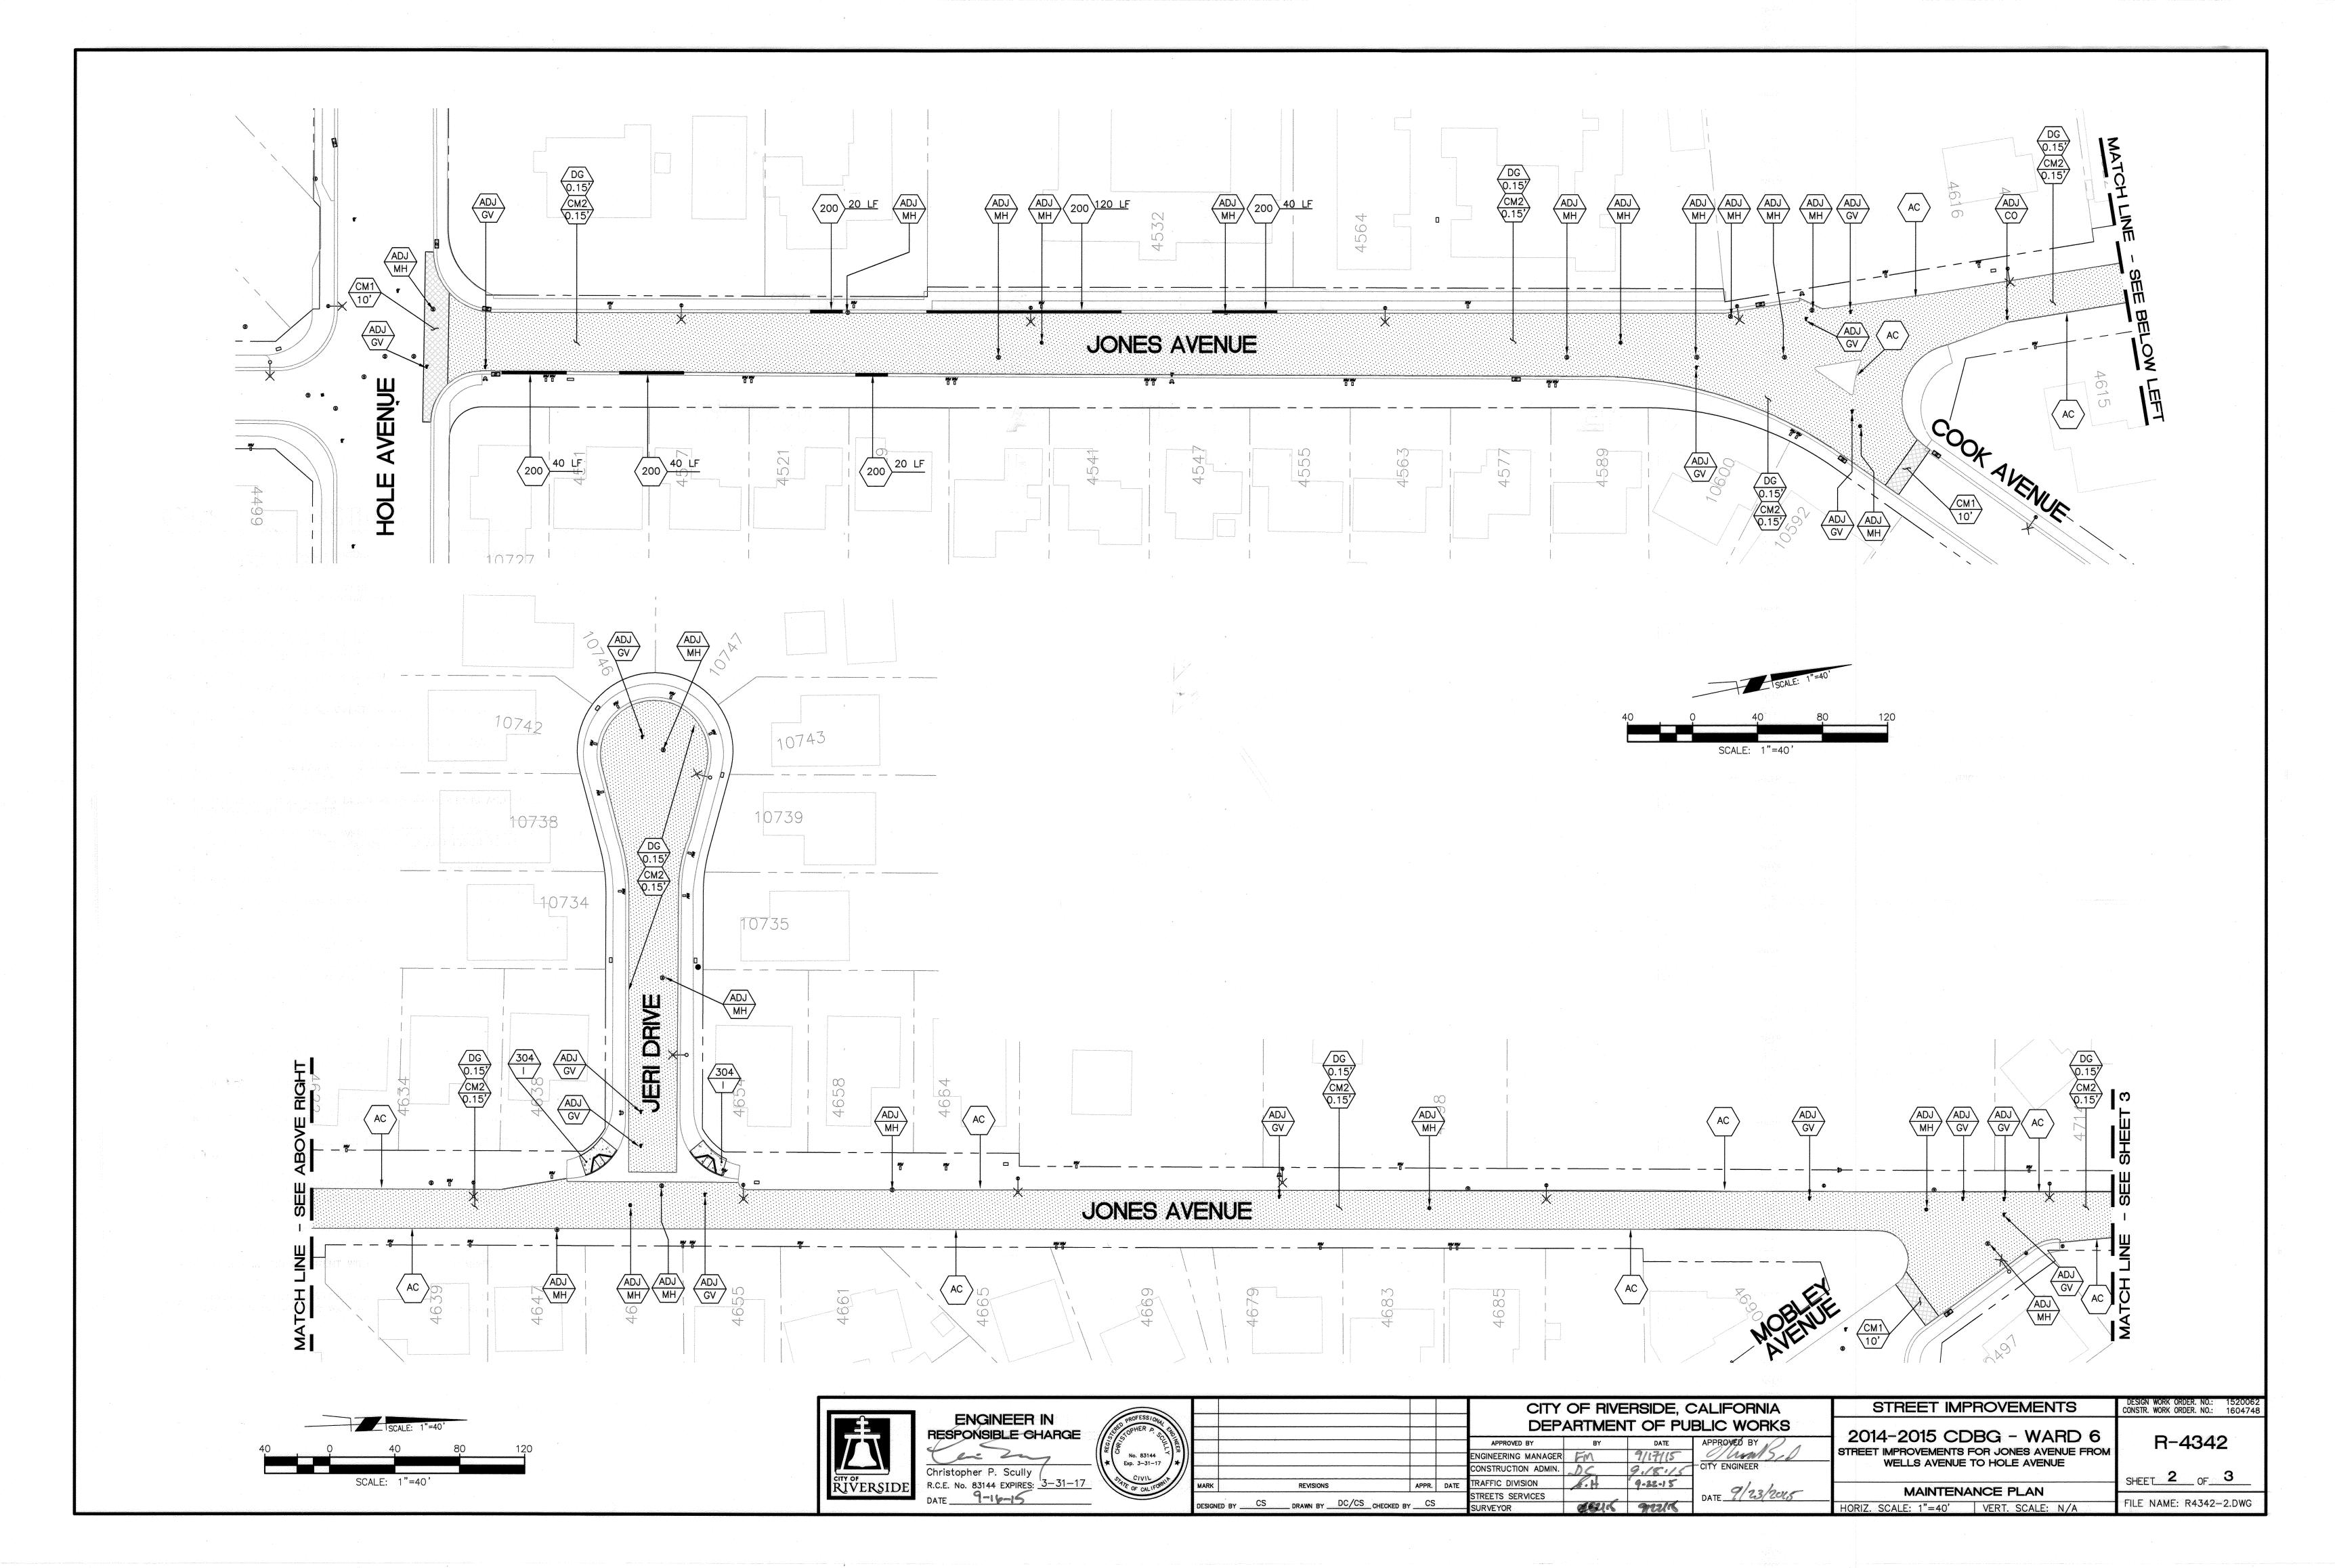

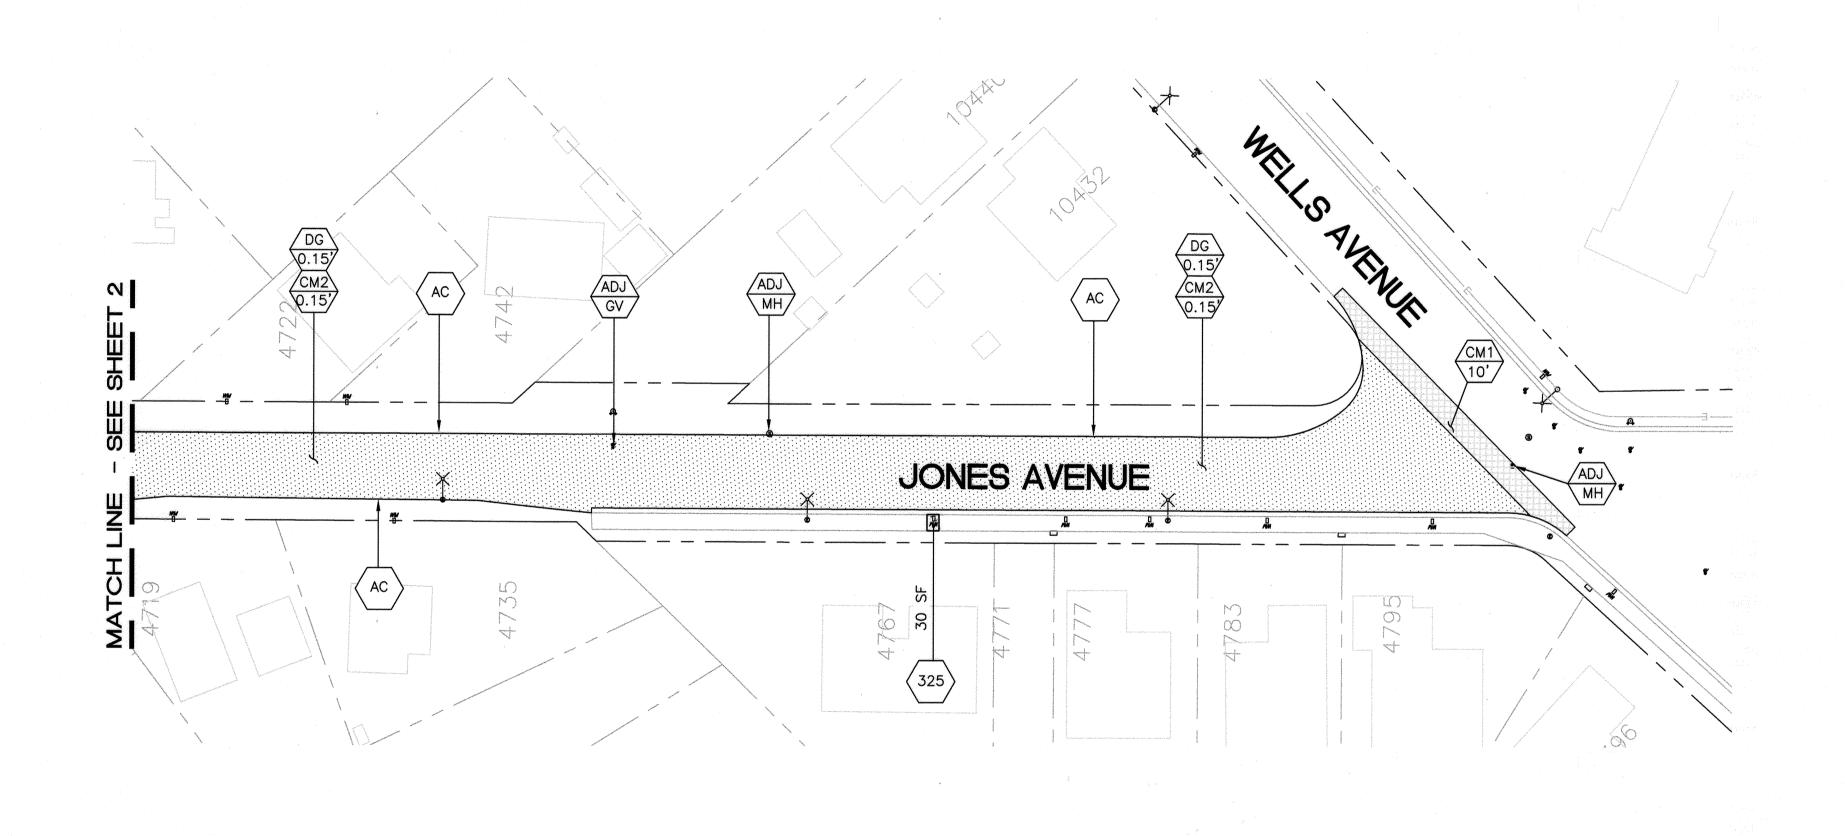

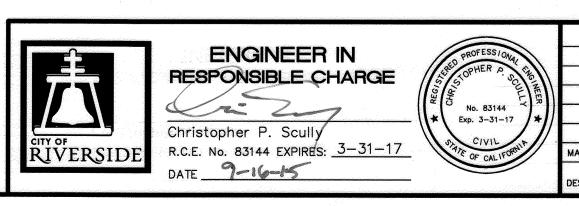

				CITY OF RIVERSIDE, CALIFORNIA DEPARTMENT OF PUBLIC WORKS			
				APPROVED BY	BY	DATE	APPROVED BY
				ENGINEERING MANAGER	EM	9/17/15	1/hussed
				CONSTRUCTION ADMIN.	DC	90/80/6	CITY ENGINEER
/ARK	REVISIONS	APPR.	DATE	TRAFFIC DIVISION	S.H	9-22-15	
DESIGNED BYCSDRAWN BYDC/CSCHECKED BYCS				STREETS SERVICES			DATE 9/23/2015
				- SURVEYOR	B	9112/15	

STREET IMPROVEMENTS

2014-2015 CDBG - WARD 6
STREET IMPROVEMENTS FOR JONES AVENUE FROM WELLS AVENUE TO HOLE AVENUE

MAINTENANCE PLAN

HORIZ. SCALE: 1"=40' VERT. SCALE: N/A

FILE NAME: R4342-3.DWG

R-4342