



CONSTRUCTION NOTES:

- 1 CONSTRUCT ASPHALT CONCRETE (A.C.) BERM PER CITY STD 250, TYPE I.
- 2 PROVIDE A 1' CUT AT 20' SPACING ALONG A.C. BERM FOR DRAINAGE.
- 3 NEW A.C. BERM TO MATCH EXISTING CURB ELEVATION AT TRANSITION POINT. PROVIDE TRANSITION (8.33% MAX) AREA BETWEEN NEW WALKWAY AND EXISTING SIDEWALK ELEVATION.
- 4 FURNISH AND INSTALL NEW DECOMPOSED GRANITE WALKING PATH (4' WIDE) 3" MIN DEPTH OF MATERIAL WITH A CROSS-SLOPE OF 2% AWAY FROM ROAD, INCLUDING EDGING AND WEED BARRIER. CONTRACTOR TO REMOVE 4" MIN DEPTH OF SOIL. IMPORT/EXPORT MATERIAL AS NECESSARY TO PROVIDE 90% MIN. COMPACTED NATIVE SUBGRADE FOR NEW IMPROVEMENTS.
- 5 NEW IMPROVEMENT TO CONTINUE BEHIND AND AROUND EXISTING TREE.
- 6 DECOMPOSED GRANITE WALKWAY TO END AT EXISTING PRIVATE ROAD/DRIVEWAY.
- 7 CONTRACTOR TO REMOVE EXISTING PIPE AND CONSTRUCT NEW PARKWAY DRAIN PER CITY STD. 410, S=48". NEW PARKWAY DRAIN SHALL SLOPE AWAY FROM ROAD AND DISCHARGE INTO EXISTING SWALE. GRADE TO DRAIN EXISTING SWALE BEHIND NEW DRAIN AS NECESSARY.
- 8 CONTRACTOR TO REMOVE AND RELOCATE EXISTING FENCE (AND VEGETATION, IF NECESSARY) WITHIN THE R/W TO 1' TO 3' SOUTH OF EXISTING LOCATION TO ALLOW ROOM FOR NEW IMPROVEMENTS. PROVIDE 1.5' SPACE BETWEEN NEW IMPROVEMENTS AND RELOCATED FENCE.
- 9 REMOVE 2' WIDE OF EXISTING AC PAVEMENT SECTION AND 1' WIDE IN DIRT SHOULDER AREA, PER PLAN (3' TOTAL), DOWN TO NATIVE/BASE MATERIAL AND COMPACT AS NECESSARY TO INSTALL NEW 0.65' MIN. DEPTH PAVEMENT SECTION (0.29 DGAC OVER 0.33' CRUSHED AGGREGATE BASE). FINAL CAP TO INCLUDE OVERLAY AREA.
- 10 AC PAVEMENT GRIND LIMITS. PROVIDE 0.12' MIN. AC GRIND AND 0.12' MIN. DGAC OVERLAY, TO MATCH FINAL CAP PAVEMENT ELEVATION OF NEW AC PAVEMENT SECTION.
- 11 SURVEY OF WORK AREA WILL BE CONDUCTED AND PROVIDED TO THE CONTRACTOR PRIOR TO THE START OF THE PROJECT.

LEGEND:

- NEW ASPHALT CONCRETE (AC) BERM
- NEW DECOMPOSED GRANITE (DG) WALKWAY
- NEW PCC CONCRETE
- REMOVE & REPLACE SECTION

IMPROVEMENTS - THIS SHEET			
ITEM	DESCRIPTION	QUANTITY	UNIT
1	AC BERM CITY STD. 250	320	LF
2	PARKWAY DRAIN CITY STD. 410	1	EA
3	DECOMPOSED GRANITE	13	CY
4	WALKWAY EDGING	650	LF
5	WEED BARRIER 4' WIDE	320	LF
6	RELOCATED FENCING	80	LF

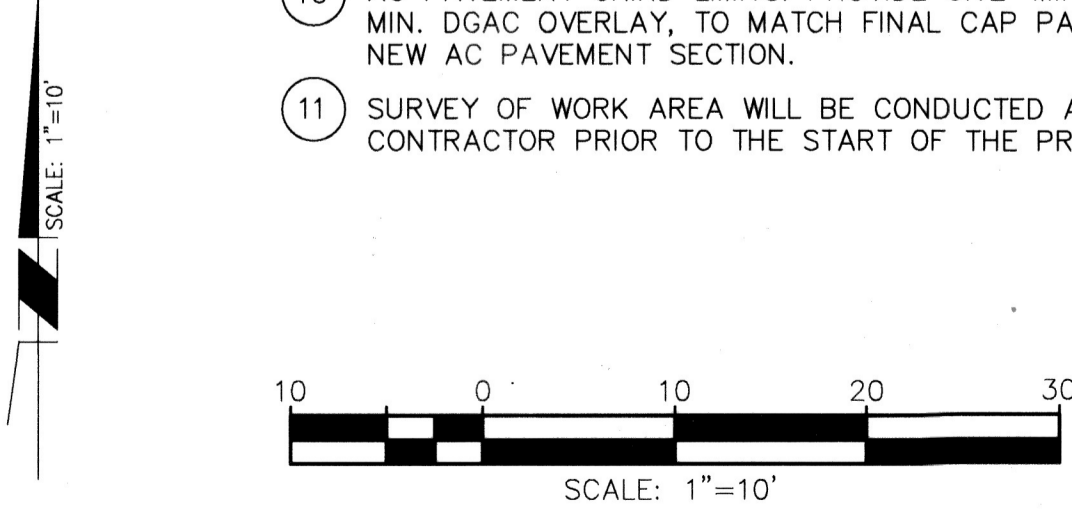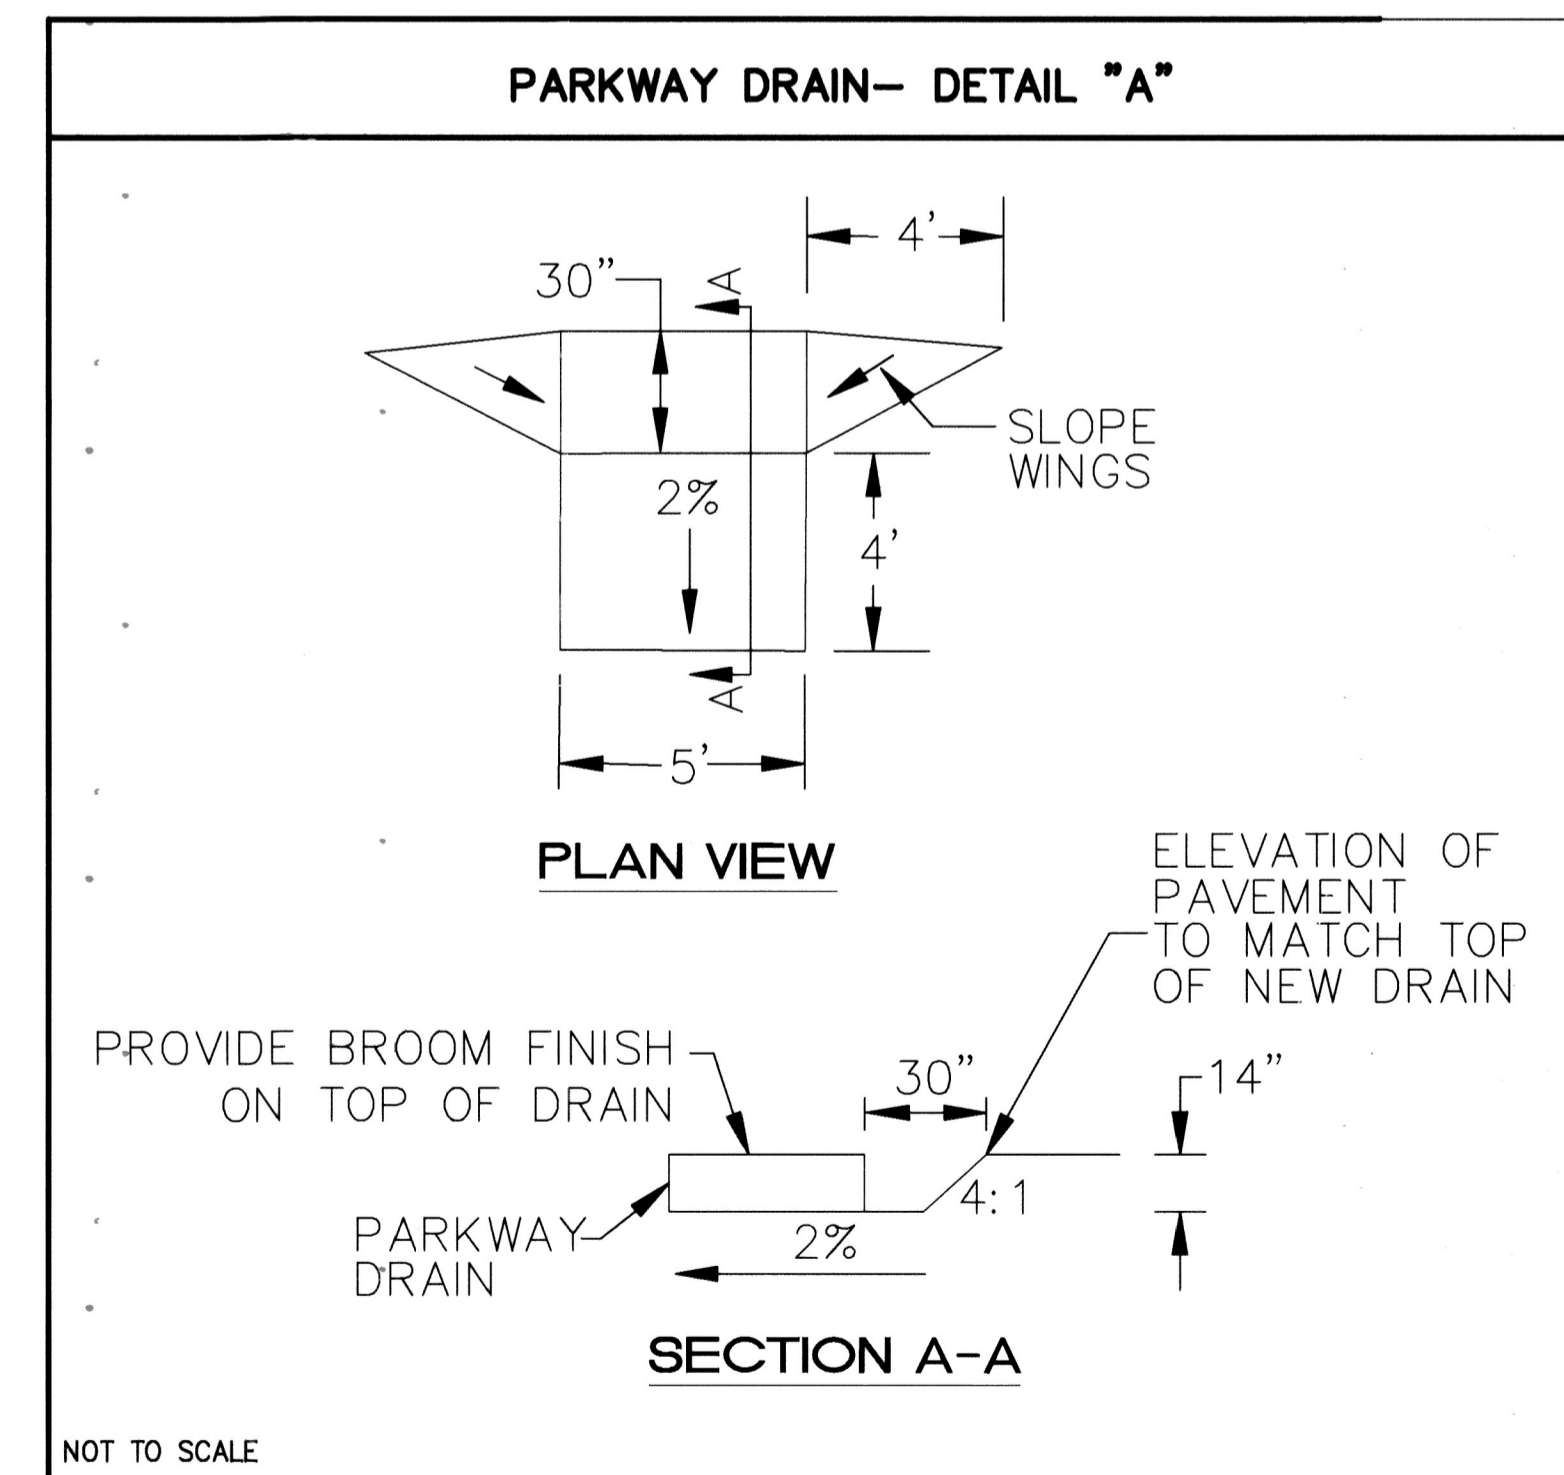

Under Ground Service Alert of Southern California
 Call: TOLL FREE 1-800-227-2600
 TWO WORKING DAYS BEFORE YOU DIG

ENGINEER IN RESPONSIBLE CHARGE
 GILBERT M. HERNANDEZ
 R.C.E. No. 69170 EXPIRES: 6-30-18
 DATE: 6-26-17

MARK	REVISIONS	APPR.	DATE

DESIGNED BY: FDM DRAWN BY: FDM CHECKED BY: GMH

CITY OF RIVERSIDE, CALIFORNIA
 DEPARTMENT OF PUBLIC WORKS

APPROVED BY	BY	DATE	APPROVED BY
ENGINEERING MANAGER	E.L.	6-26-17	[Signature]
PRINCIPAL ENGINEER			CITY ENGINEER
TRAFFIC DIVISION	NA	6/22/17	
CONSTRUCTION ADMIN.	DC	7/10/17	
PUBLIC UTILITIES			

NEW IMPROVEMENTS
 GLENWOOD DRIVE
 BETWEEN 14TH STREET
 AND SAN ANDREAS AVENUE

R-4415
 SHEET 1 OF 1
 SCALE: 1" = 10'
 FILE NAME: R-4415.DWG

AS-BUILT DC 5/10/23