


ACCT. NO. 07-3060-3027		MAJOR CITY STREETS PROJ. 110	
REVISIONS		CITY OF RIVERSIDE CALIFORNIA DEPARTMENT OF PUBLIC WORKS	
MARK	DATE	DESCRIPTION	COLUMBIA AVE. FREEWAY TO CITY LIMITS
	12-24-61	Rev. Plans per City Engineer's office with plans 07-3060-3027	
	1-25-62	Revised construction per the Plans per City Engineer's office	
DESIGNED BY	CHECKED BY	APPROVED BY	R-454
DRAWN BY	WJG	Director of Public Works	
RECOMMENDED BY	Assistant City Engineer	DATE	
		Jun. 14, 1961	SHEET 2 OF 2

SURVEYED BY: _____
 CHECKED BY: _____
 DRAWN BY: _____
 DATE: _____
 PROJECT NO.: 624-834-779
 SHEET NO.: 1 OF 6
 CLIENT: TEMPLET
 ADDRESS: A.K.J.

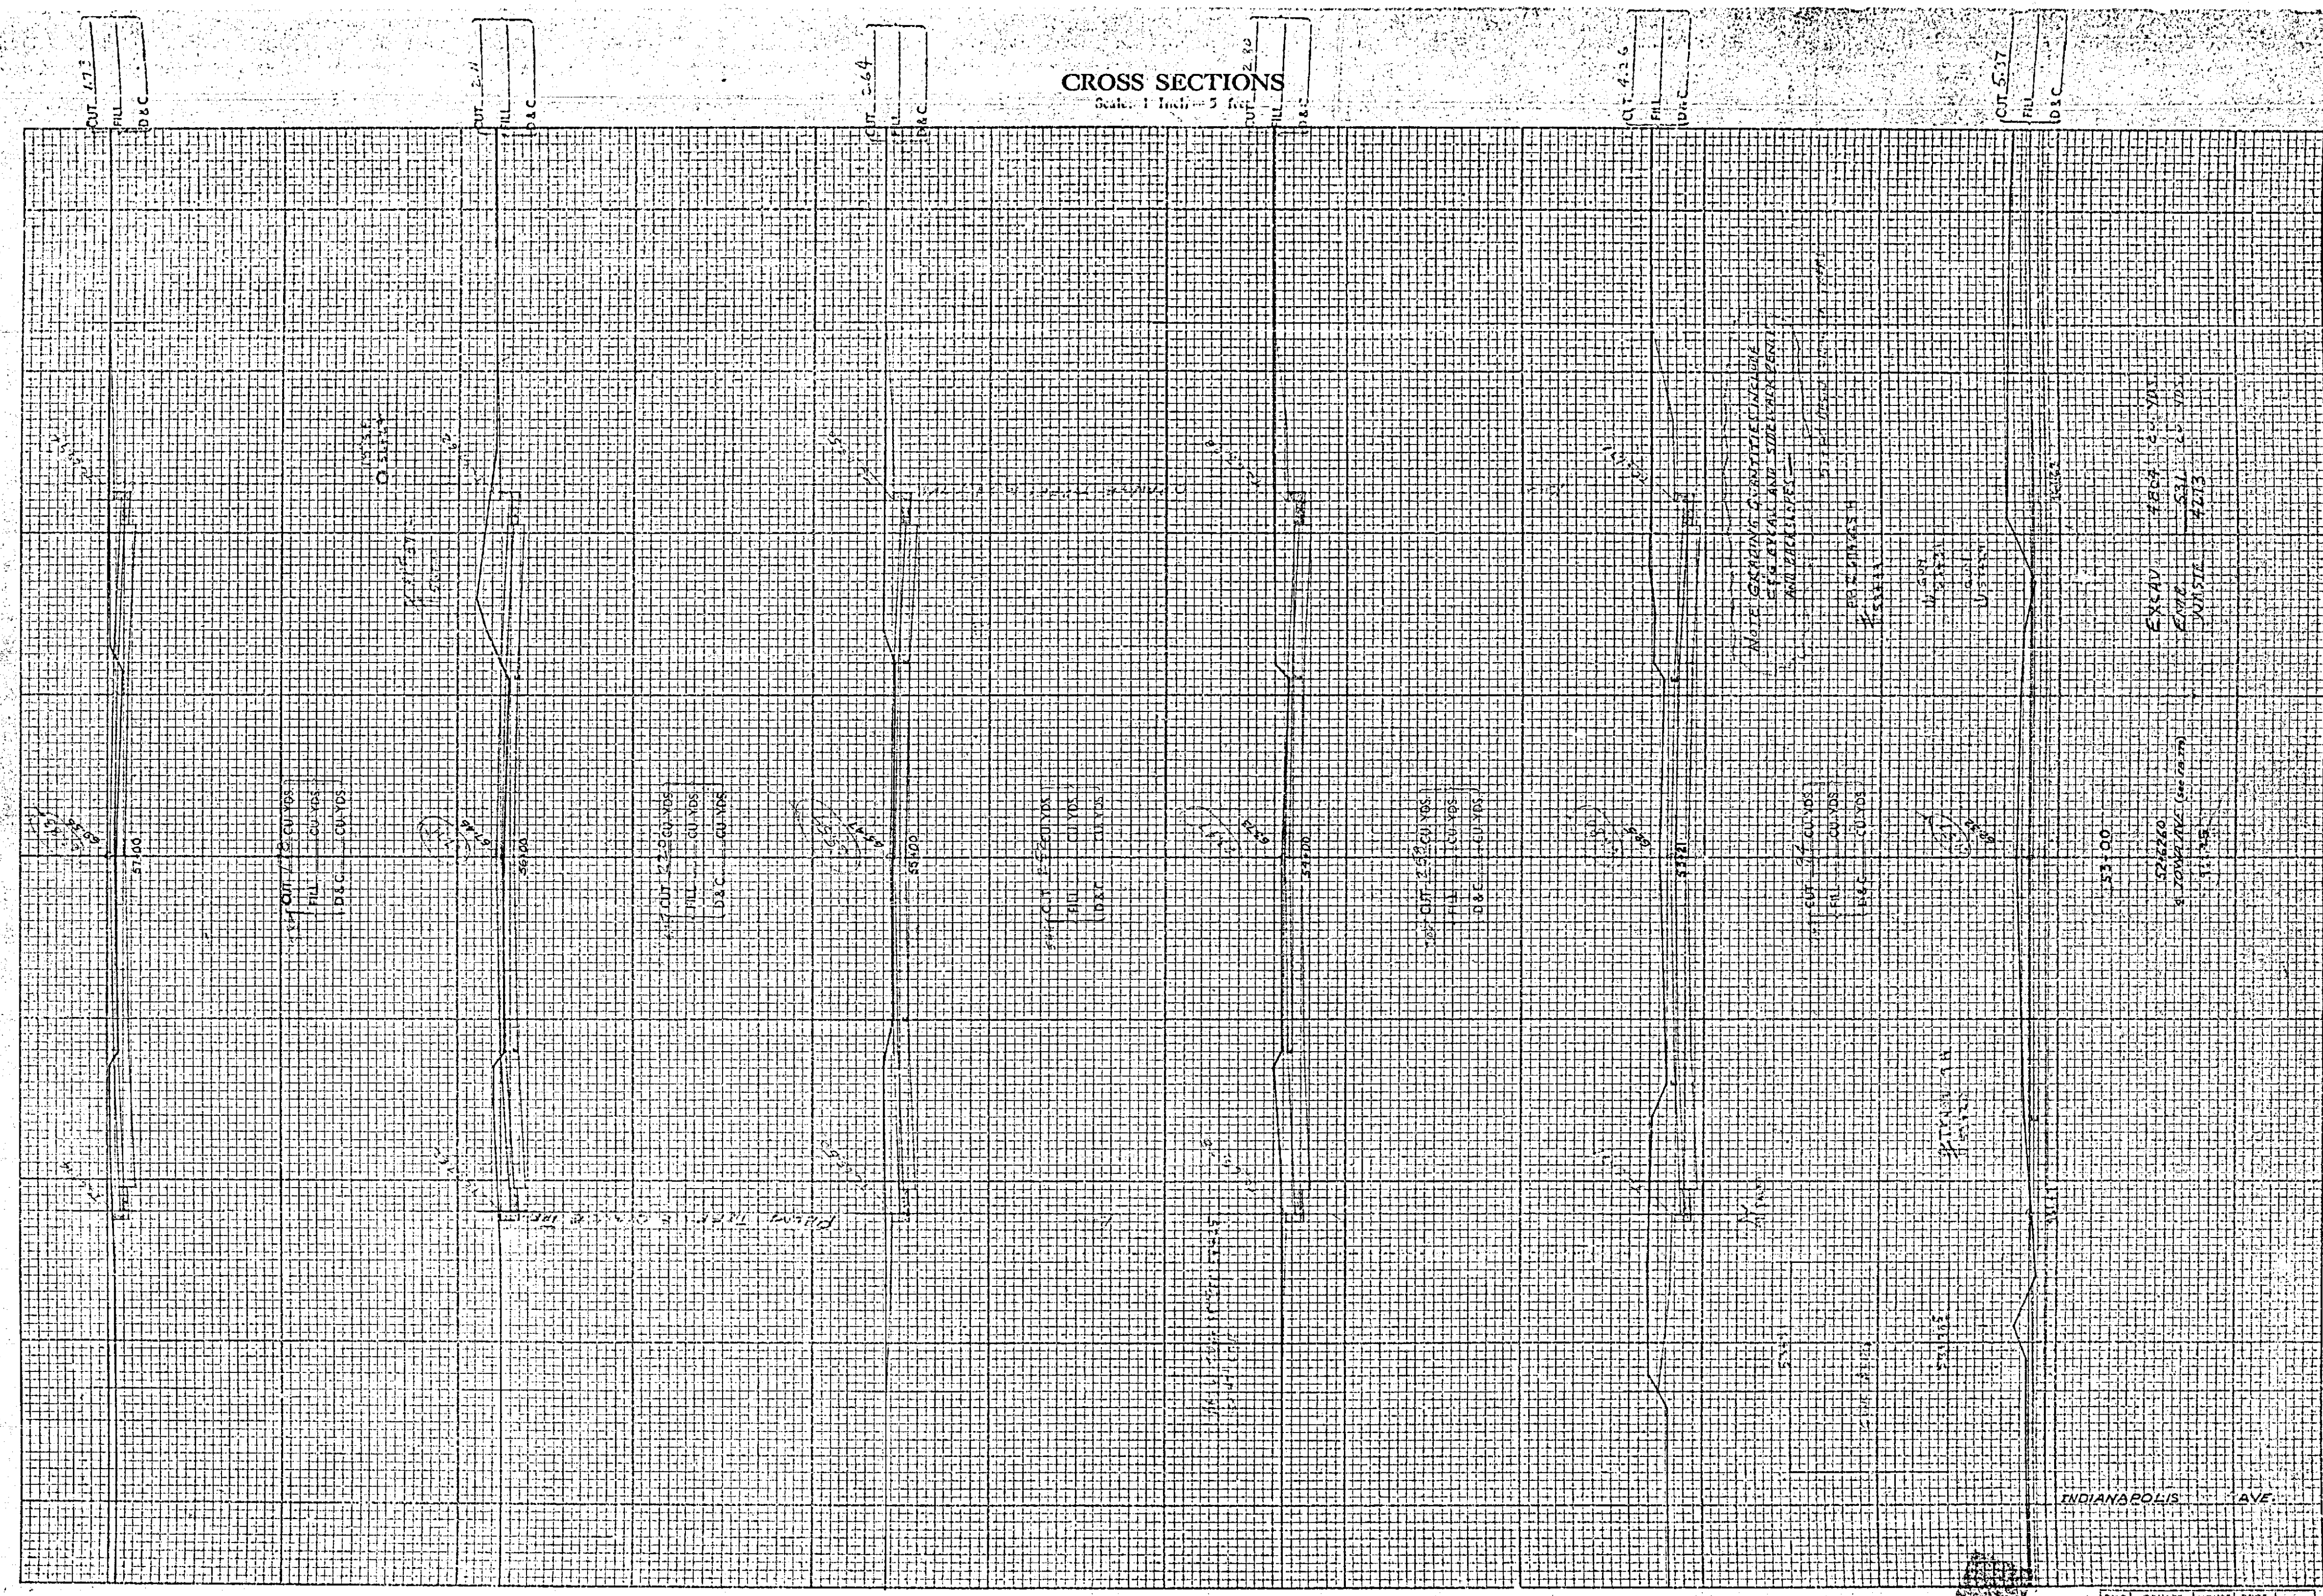

INDIANAPOLIS AVE
 SHEET 1 OF 6

ENT.	COUNTY	TOWNSHIP	RANGE	SECTION
				1