


- GENERAL NOTES:**
1. It shall be the responsibility of the contractor to check the right of way in accordance with provisions of law and locate each utility including irrigation lines and easements and set no cut to the City.
 2. Construction shall be in accordance with the City of Riverside, Department of Public Works, Specifications No. 461 and Standard Drawings.
 3. Prime coat, seal coat, and paint binder are required.
 4. Grading will require a permit under Ordinance 3093 for cut or fill exceeding 100 cubic yards, or 4' fill over one foot in depth.
 5. Trim edge of existing pavements, where new paving is to be existing pavement, to a clean straight line. Construct curb and gutters as shown and overlay paving as directed in the field to produce a smooth, correct surface.

APPROVED BY: *Albert A. Webb* DATE: 11-20-63
 APPROVED BY: *Albert A. Webb* DATE: Aug 9, 1961

CONST. NOTES FOR C.G. STA. 719618 TO 846618	DATE: 11/20/63
CONST. NOTES FOR C.G. STA. 918115 TO 996115	DATE: 11/20/63
REVISIONS	
NO.	DATE
TRACT NO 2072	
R/S 337 TENT # 743	
STREET PLAN & PROFILE	
MT. VERNON AVENUE	
SCALE: 1"=50'	W.D. 119-117
DATE: 1-18-60	DRAWN BY: <i>Albert A. Webb</i>
CHECKED BY: <i>Albert A. Webb</i>	DATE: 11/20/63
BY: <i>Albert A. Webb</i>	DATE: 11/20/63

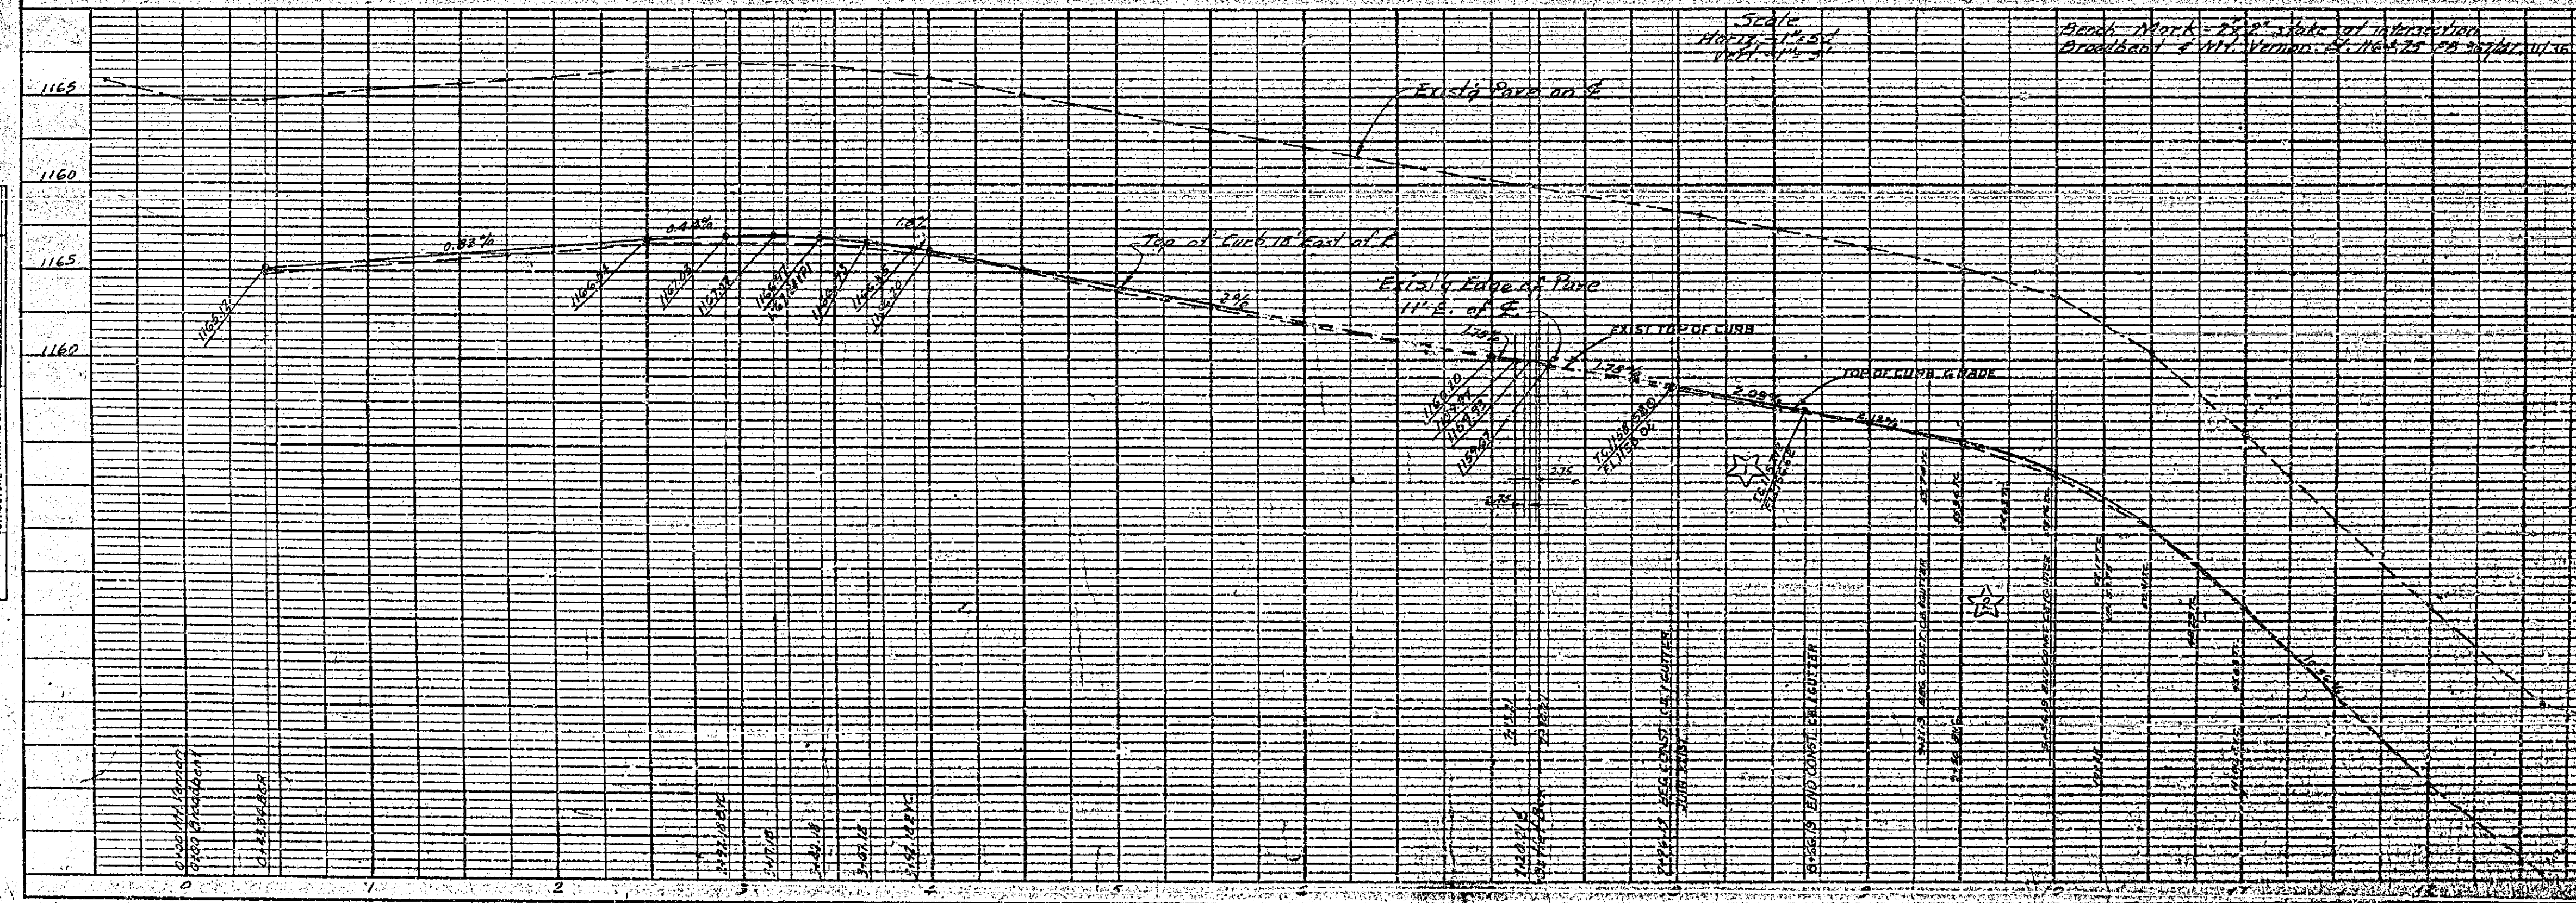

PLAN	DATE

PROFILE	DATE

DATE: 1-18-60
 DRAWN BY: *Albert A. Webb*
 CHECKED BY: *Albert A. Webb*
 BY: *Albert A. Webb*

MISSING

MISSING

MISSING