


EAST RIVERSIDE LAND CO.  
M.B. 6, PG. 44, REC. OF S.B. CO.


LINDEN STREET  
ROAD NO. 3042 WORK ORDER 230  
SURVEY NO 2200 FIELD BOOK 687

STATION 16+00 TO IOWA AVENUE  
OFFICE OF THE COUNTY ROAD COMM.  
RIVERSIDE COUNTY  
AUGUST 1952

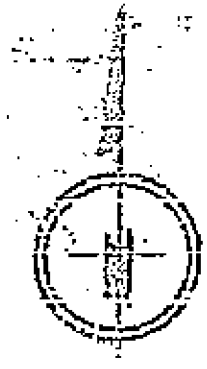

SCALE: HORIZ. 1" = 50'  
VERT. 1" = 10'

Beginning of Project  
Sta. 16+00

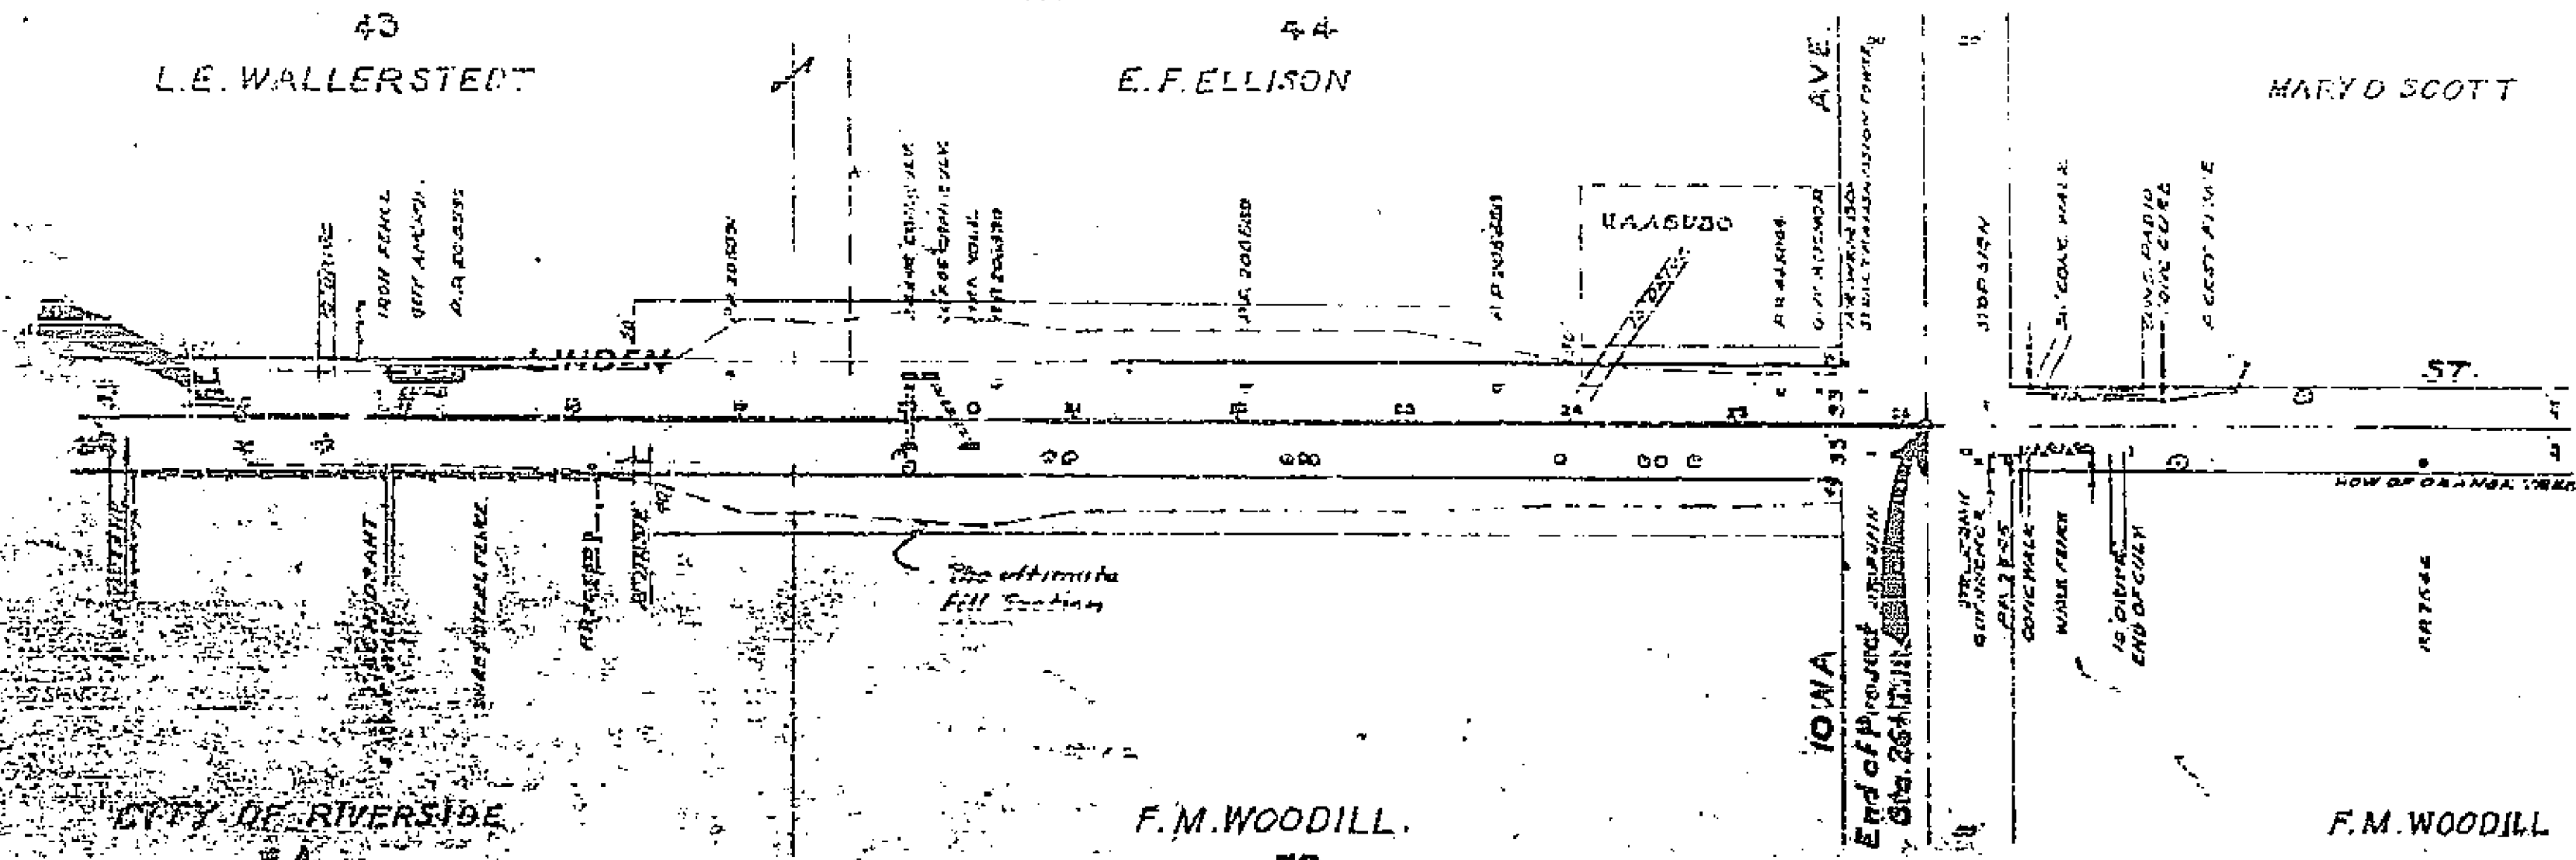

BILT TO CONSTR GRADE  
NOT ULTIMATE GRADE

