
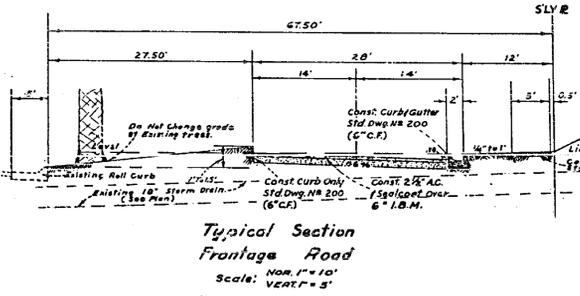


DATE	
BY	
CHECKED	
APPROVED	
PROJECT	
NO.	
DATE	

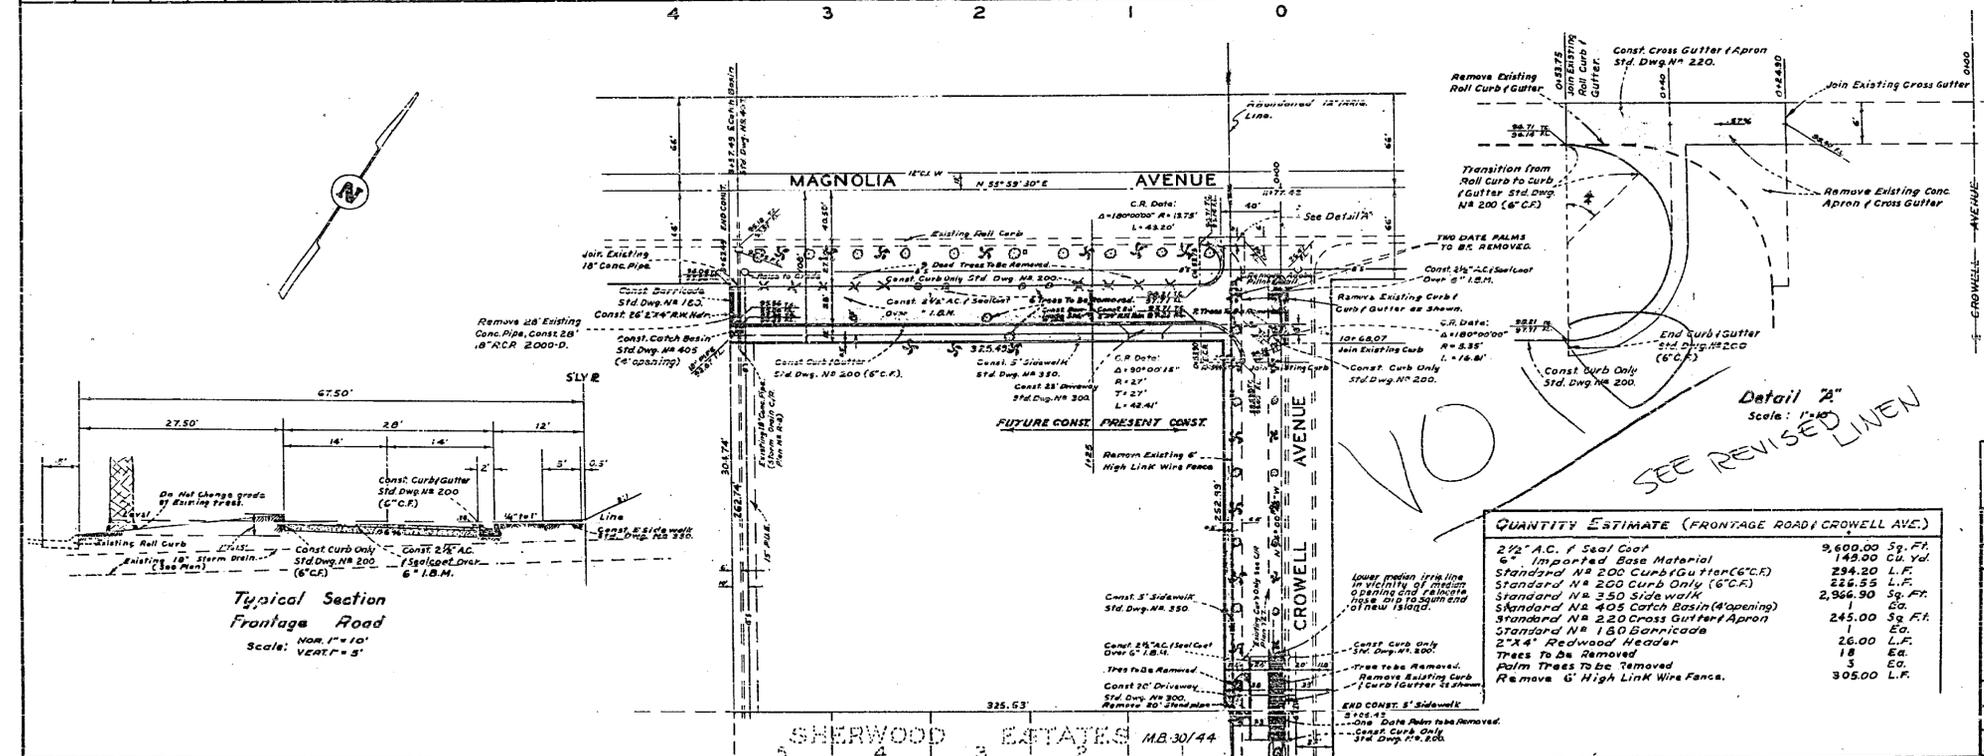

- GENERAL NOTES:**
1. Construction shall be in accordance with the City of Riverside Department of Public Works Specification No. 461 and standard Drawings.
 2. If the Subdivider wishes to reduce requirements for imported base materials, additional soil tests may be taken at the expense of the subdivider after the streets are prepared to rough grade. Subdivider will contact the Inspection Division, City of Riverside, before making tests. The City of Riverside will make a test of base material in place. Before paving can be installed, results of this test must indicate that base material is satisfactory to the Inspection Division.
 3. Trim edge of existing paving where new paving joins existing pavement to clean straight line. Construct match-up paving as shown, and overlay existing paving as directed in the field to produce smooth crown section.
 4. Prime coat & paint binder required.
 5. Contractor shall check details of the trees shrubs, and areas to be planted with the Park and Recreation Department.

DATE	
BY	
CHECKED	
APPROVED	
PROJECT	
NO.	
DATE	

QUANTITY ESTIMATE (FRONTAGE ROAD CROWELL AVE.)

2 1/2" AC. of Seal Coat	9,600.00 Sq. Ft.
6" Imported Base Material	149.00 Cu. Yd.
Standard No. 200 Curb & Gutter (6" C.F.)	294.20 L.F.
Standard No. 200 Curb Only (6" C.F.)	222.55 L.F.
Standard No. 350 Side Walk	2,366.90 Sq. Ft.
Standard No. 405 Catch Basin (Opening)	245.00 Sq. Ft.
Standard No. 150 Barricade	1 EG.
2" x 4" Redwood Header	18 EG.
Remove 6" High Link Wire Fence.	5 EG.
Remove 6" High Link Wire Fence.	305.00 L.F.

APPROVED BY <i>Albert A. Webb</i> MARK RECREATION DIRECTOR 5-9-62	ALBERT A. WEBB ASSOCIATES CIVIL ENGINEERS - RIVERSIDE, CALIFORNIA APPROVED <i>Carl N. White</i> DATE 2/19/62
REVISION	CITY OF RIVERSIDE, CALIFORNIA DEPARTMENT OF PUBLIC WORKS
MARK DATE DESCRIPTION	STREET PLAN & PROFILE MAGNOLIA AVENUE FRONTAGE ROAD C.U.P. C-8-612 Y.W.C.A.
DATE 11-JAN. 1962 SCALE 1" = 50'	APPROVED BY <i>Carl N. White</i> DIRECTOR OF PUBLIC WORKS DATE 5-9-62
DRAWN <i>[Signature]</i> W.D. 5-1-62	NO. R-598
CHECKED FOR <i>[Signature]</i> W.D. 5-9-62	DATE 5-9-62 SHEET 1 OF 1

VOID
IF NOT REVISION
PLAN

