

TRACT NO. 2264  
M.B. 13/34436

TEL. CO. SHIELD TABLE  
STANDARD SERVICE  
IMPORTANT SERVICE  
RATES FOR C. 24 hours in advance of  
any connection in this area  
See page 6-21-64  
C.A. 6-21-64

Construct 6\"/>

STREET NAME SIGN SCHEDULE	
A.	ALESSANDRO BLVD. 6000
	TRAFALGAR AVE. 2100
S.	ACADEMY AVE. 2100
	ACADEMY AVE. 6000
C.	BOND ST. 6000
D.	TUDDER COURT 2000
E.	BOND ST. 5900
	LIVINGSTON ST. 2100

Street name signs and posts to be furnished and installed by the contractor per City of Riverside Standard 113 66.2.

- GENERAL NOTES**
- All construction shall be in accordance with Standards and Specifications No. 461 of the City of Riverside Department of Public Works.
  - It shall be the responsibility of the Contractor to clear the Right of Way in accordance with the provisions of law as it affects each utility including irrigation lines and appurtenances, and at no extra cost to the City of Riverside.
  - The City of Riverside will take a soil test to determine the impact base material thickness after the rough grading of the streets has been completed.
  - A Price Book will be required.
  - BENCH MARK:**  
TANK Spike in Gully pole 9861-U on Ely side of Alessandro Boulevard Elevation 1136.61  
Spike in P.A. 19400-U W side Sheffield Avenue Elevation 1139.70



Designed by: *John A. Davidson* 6-1-62  
Park Superintendent

APPROVED BY: *J. F. Davidson* DATE: 6-1-62  
DATE: 6-1-62

REVISIONS		
MARK	DATE	DESCRIPTION
*	6/1/62	Added 5\"/>

DESIGNED BY: *J. F. Davidson*  
DRAWN BY: *add*  
CHECKED BY: *add*  
RECOMMENDED BY: *Michael*  
ASSISTANT CITY ENGINEER

**J. F. DAVIDSON - CIVIL ENGINEER**  
R.E. No. 882  
RIVERSIDE, CALIFORNIA  
APPROVED BY: *J. F. Davidson* DATE: 6-1-62  
CITY OF RIVERSIDE, CALIFORNIA  
DEPARTMENT OF PUBLIC WORKS  
**STREET PLAN & PROFILE**  
**ALESSANDRO BLVD.**  
**TRACT 2405**  
HORIZ. SCALE 1"=40' VERT. SCALE 1"=4'  
APPROVED BY: *J. F. Davidson*  
Director of Public Works  
DATE: 6-1-62  
NO. **R-600**  
SHEET 1 OF 4

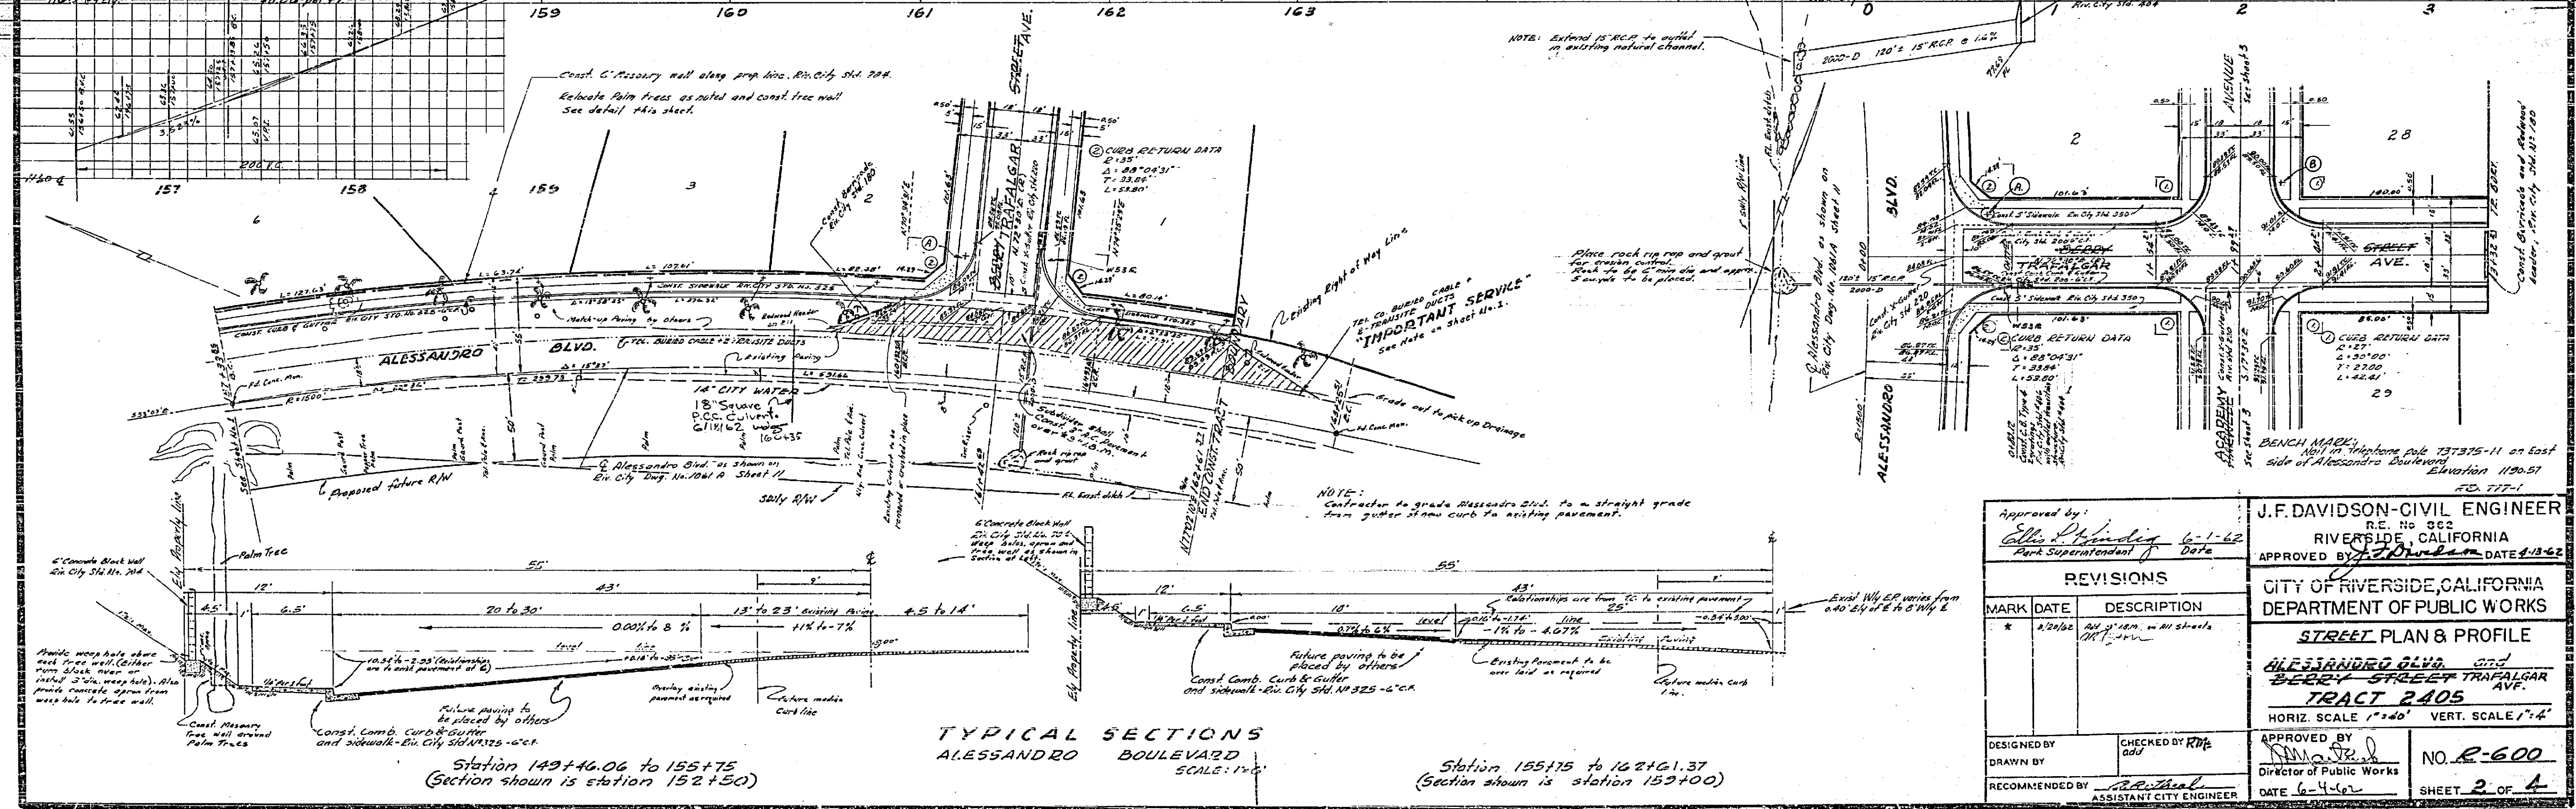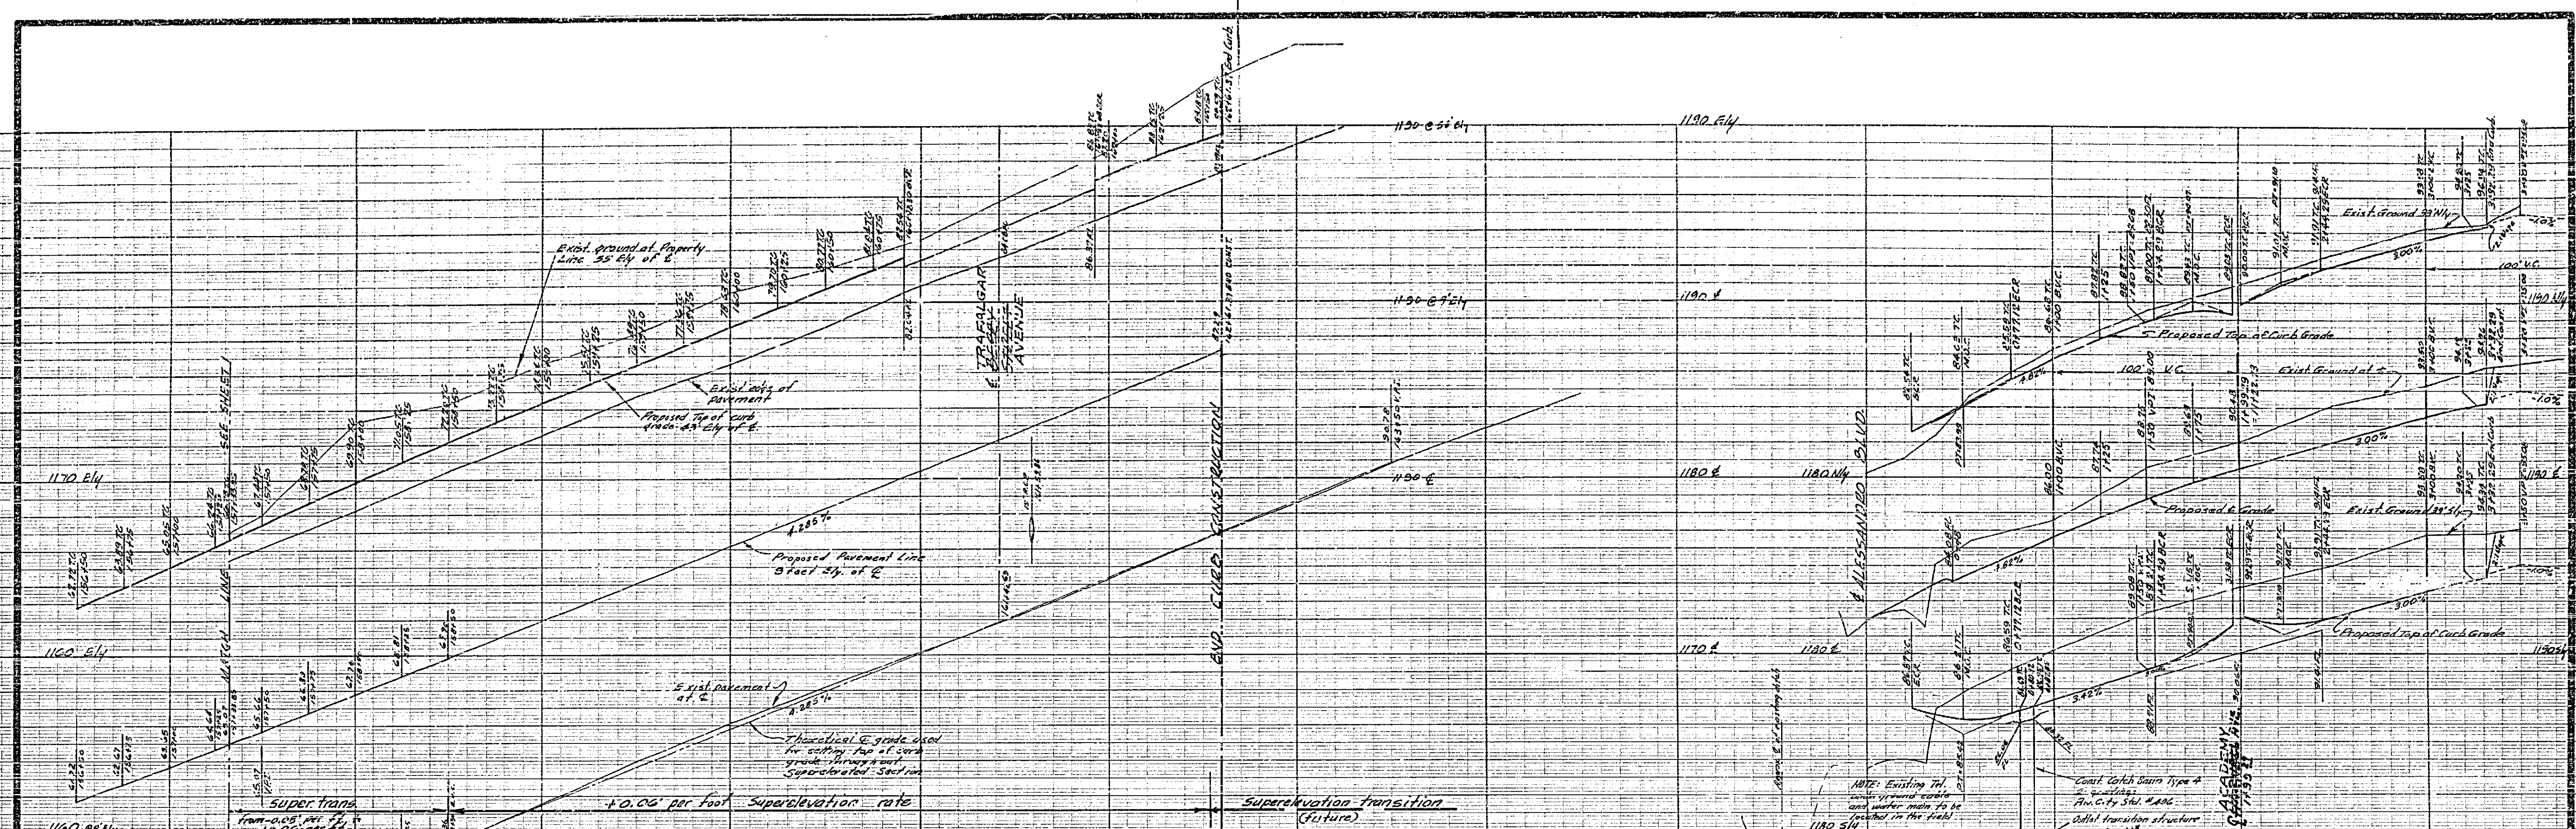

Approved by: *Ellis P. Harding* 6-1-62  
 Park Superintendent Date

J.F. DAVIDSON-CIVIL ENGINEER  
 R.E. No 362  
 RIVERSIDE, CALIFORNIA  
 APPROVED BY: *J.F. Davidson* DATE 4-13-62

CITY OF RIVERSIDE, CALIFORNIA  
 DEPARTMENT OF PUBLIC WORKS

**STREET PLAN & PROFILE**  
**ALESSANDRO BLVD. GRD.**  
**BERRY STREET TRAFALGAR AVENUE**  
**TRACT 2405**






HORIZ. SCALE 1"=40' VERT. SCALE 1"=4'

MARK	DATE	DESCRIPTION
*	4/24/62	AM. P.M. on all streets RT-10

DESIGNED BY: *RMH*  
 DRAWN BY: *RMH*  
 CHECKED BY: *RMH*  
 RECOMMENDED BY: *RMH* ASSISTANT CITY ENGINEER

APPROVED BY: *RMH*  
 Director of Public Works  
 DATE 6-4-62





NO. R-600  
 SHEET 2 OF 4

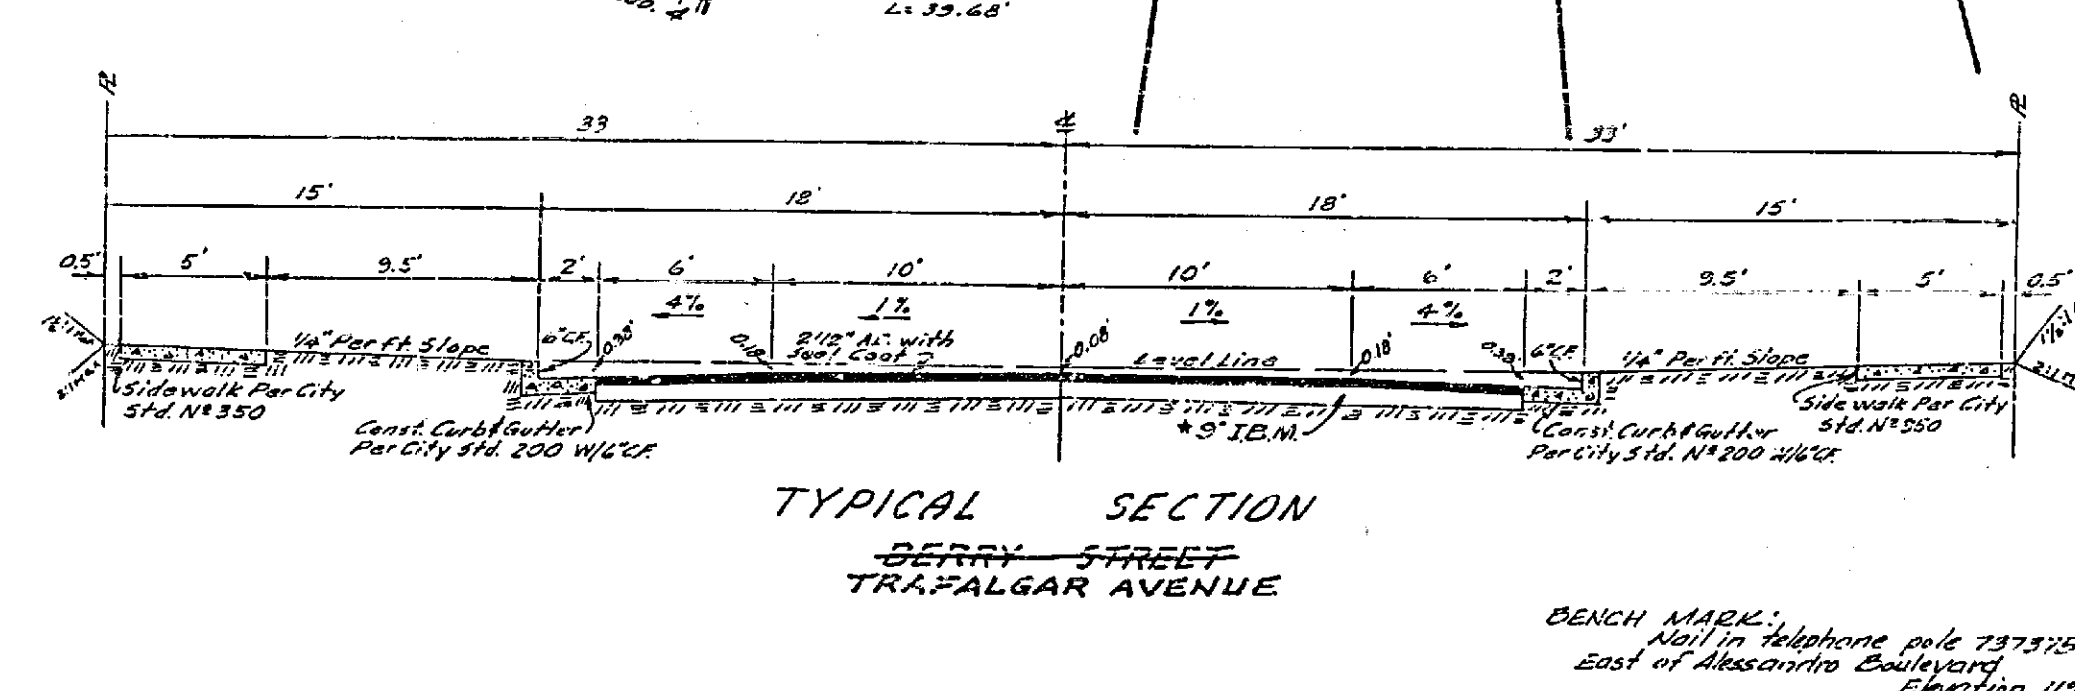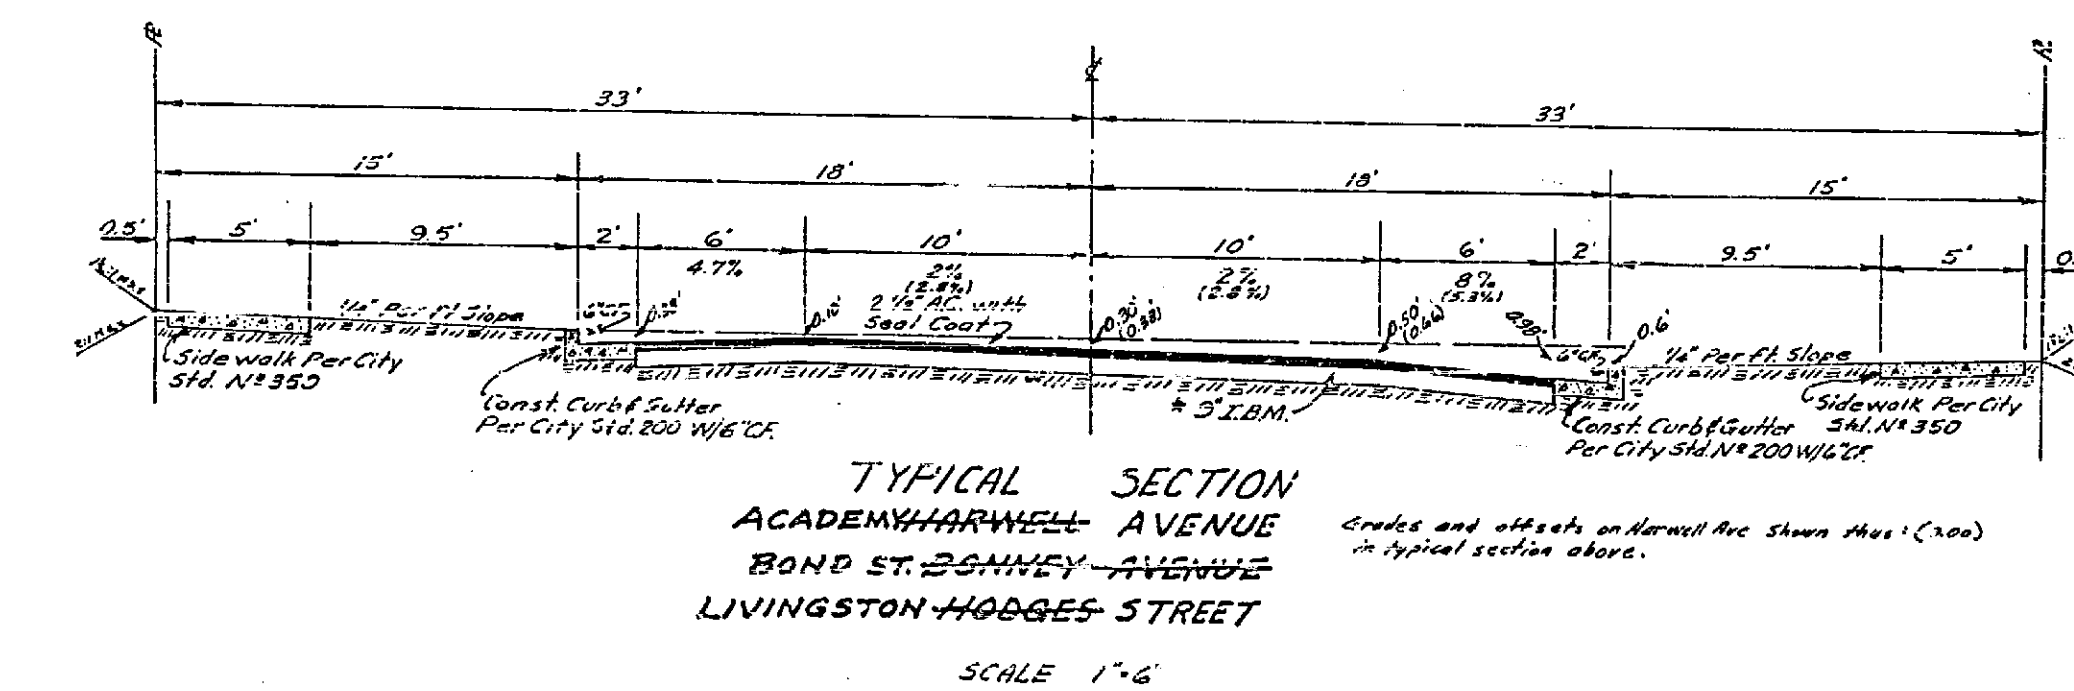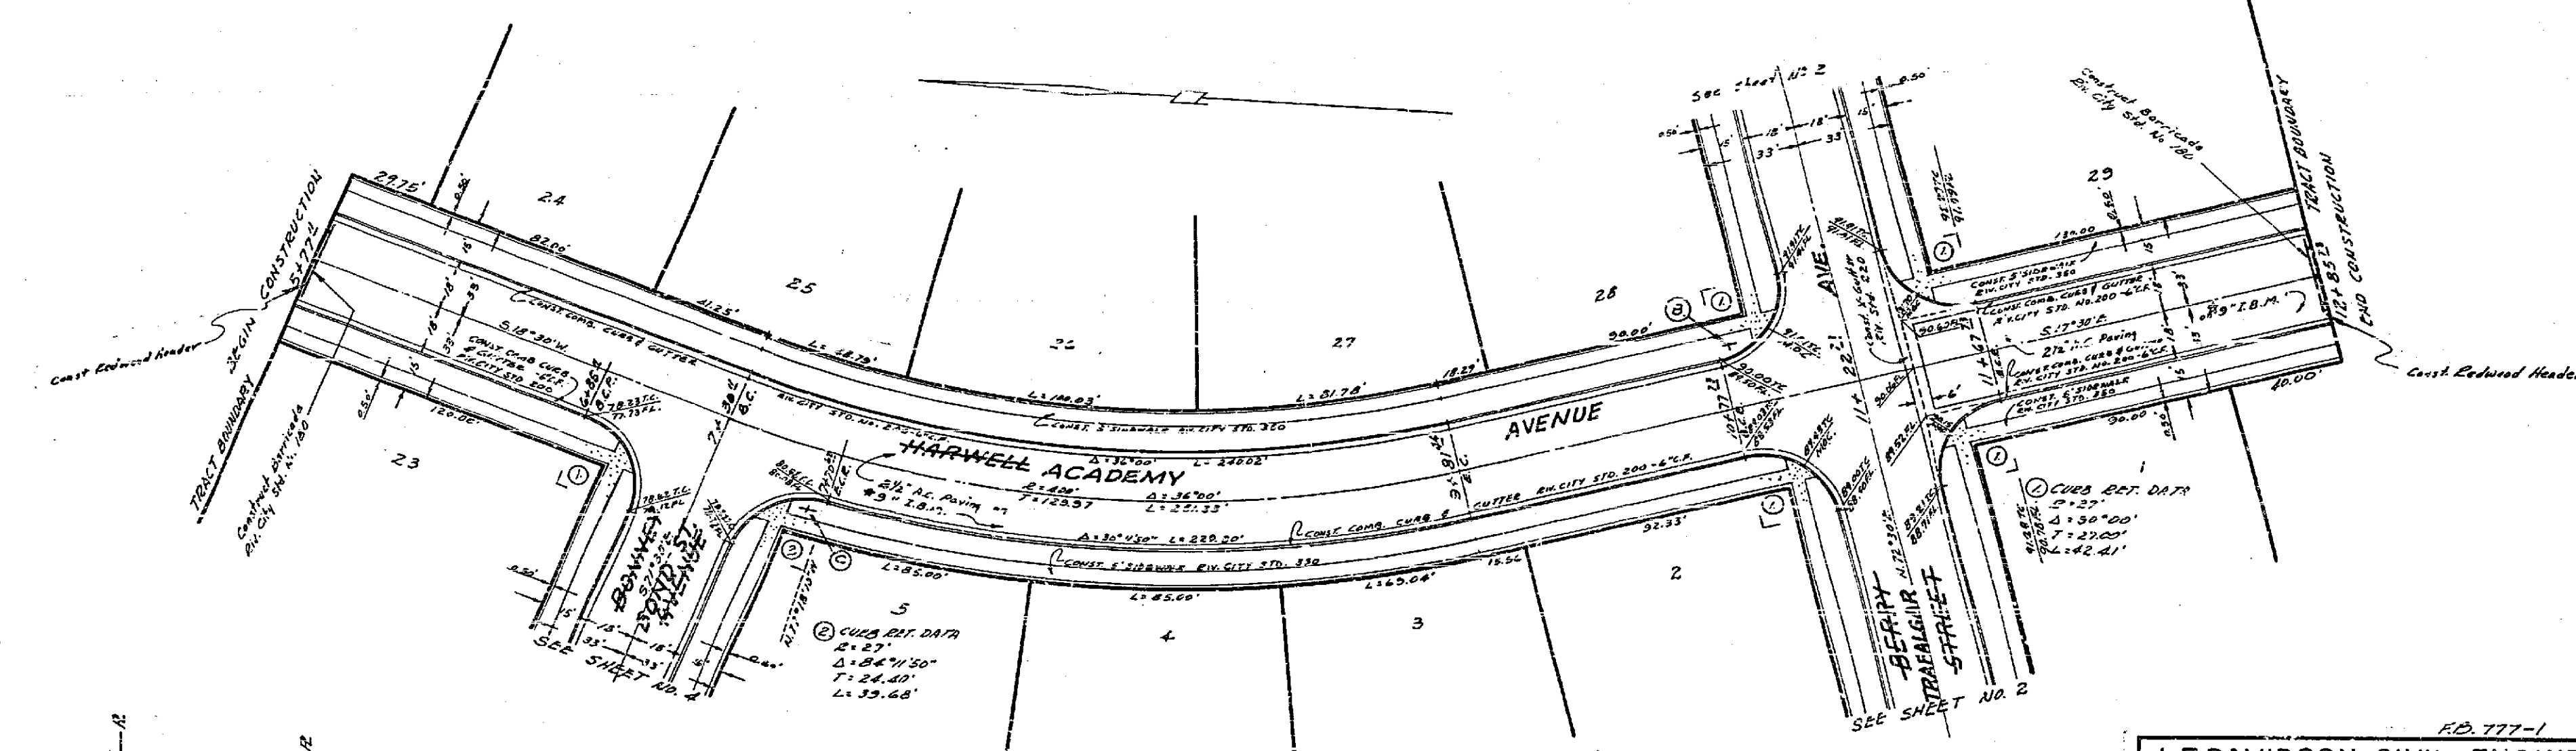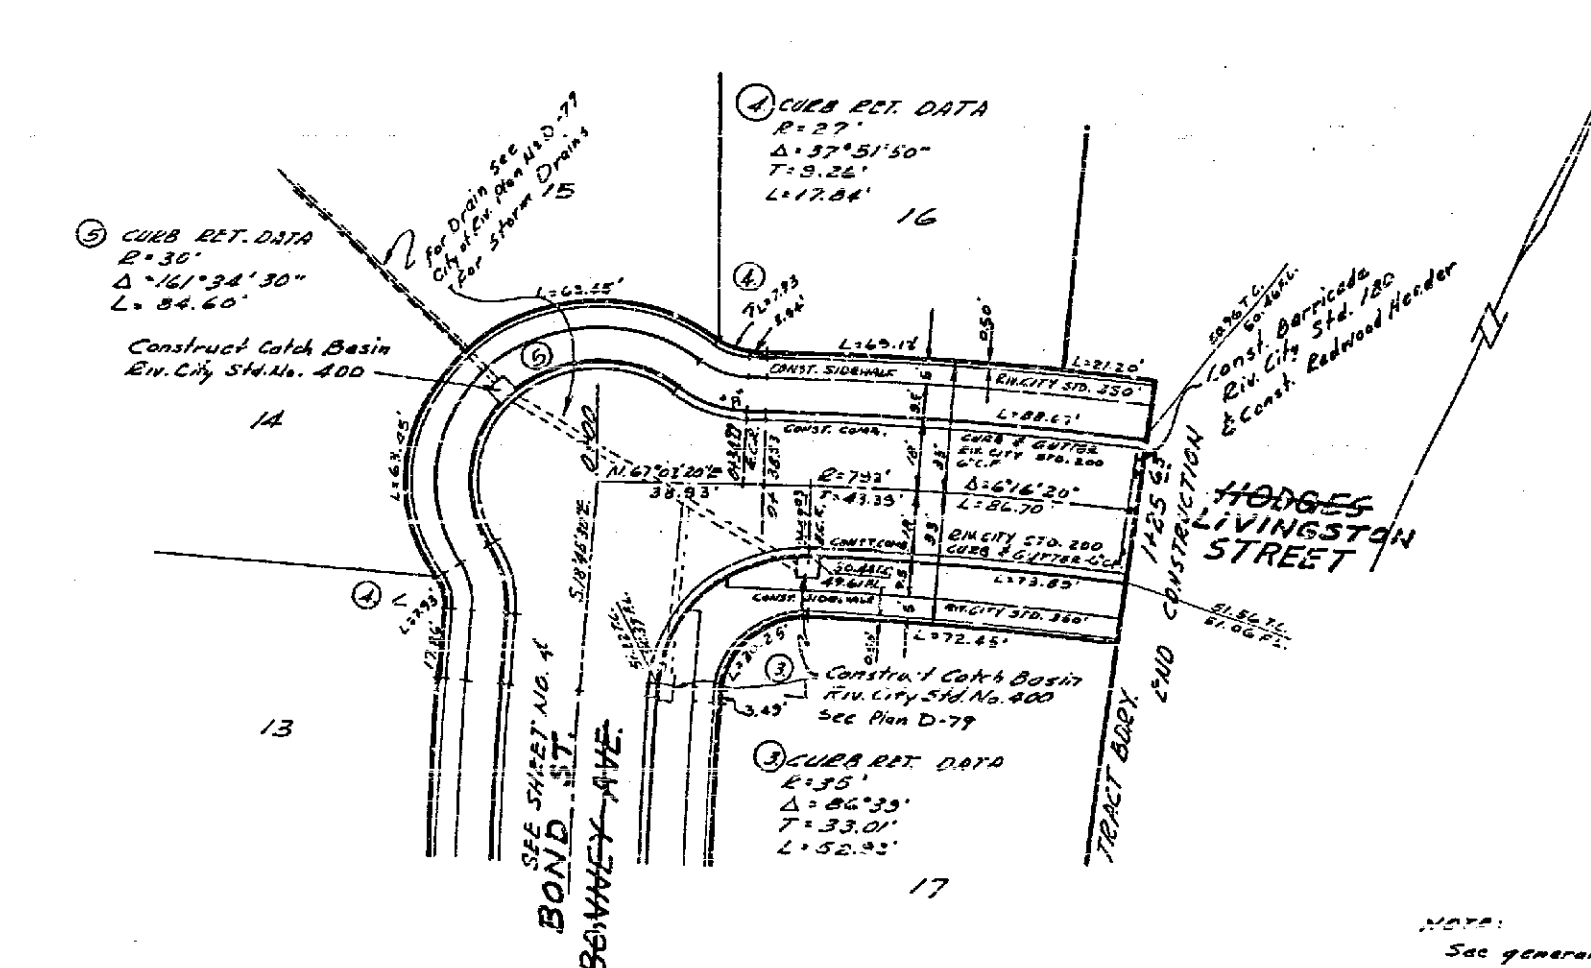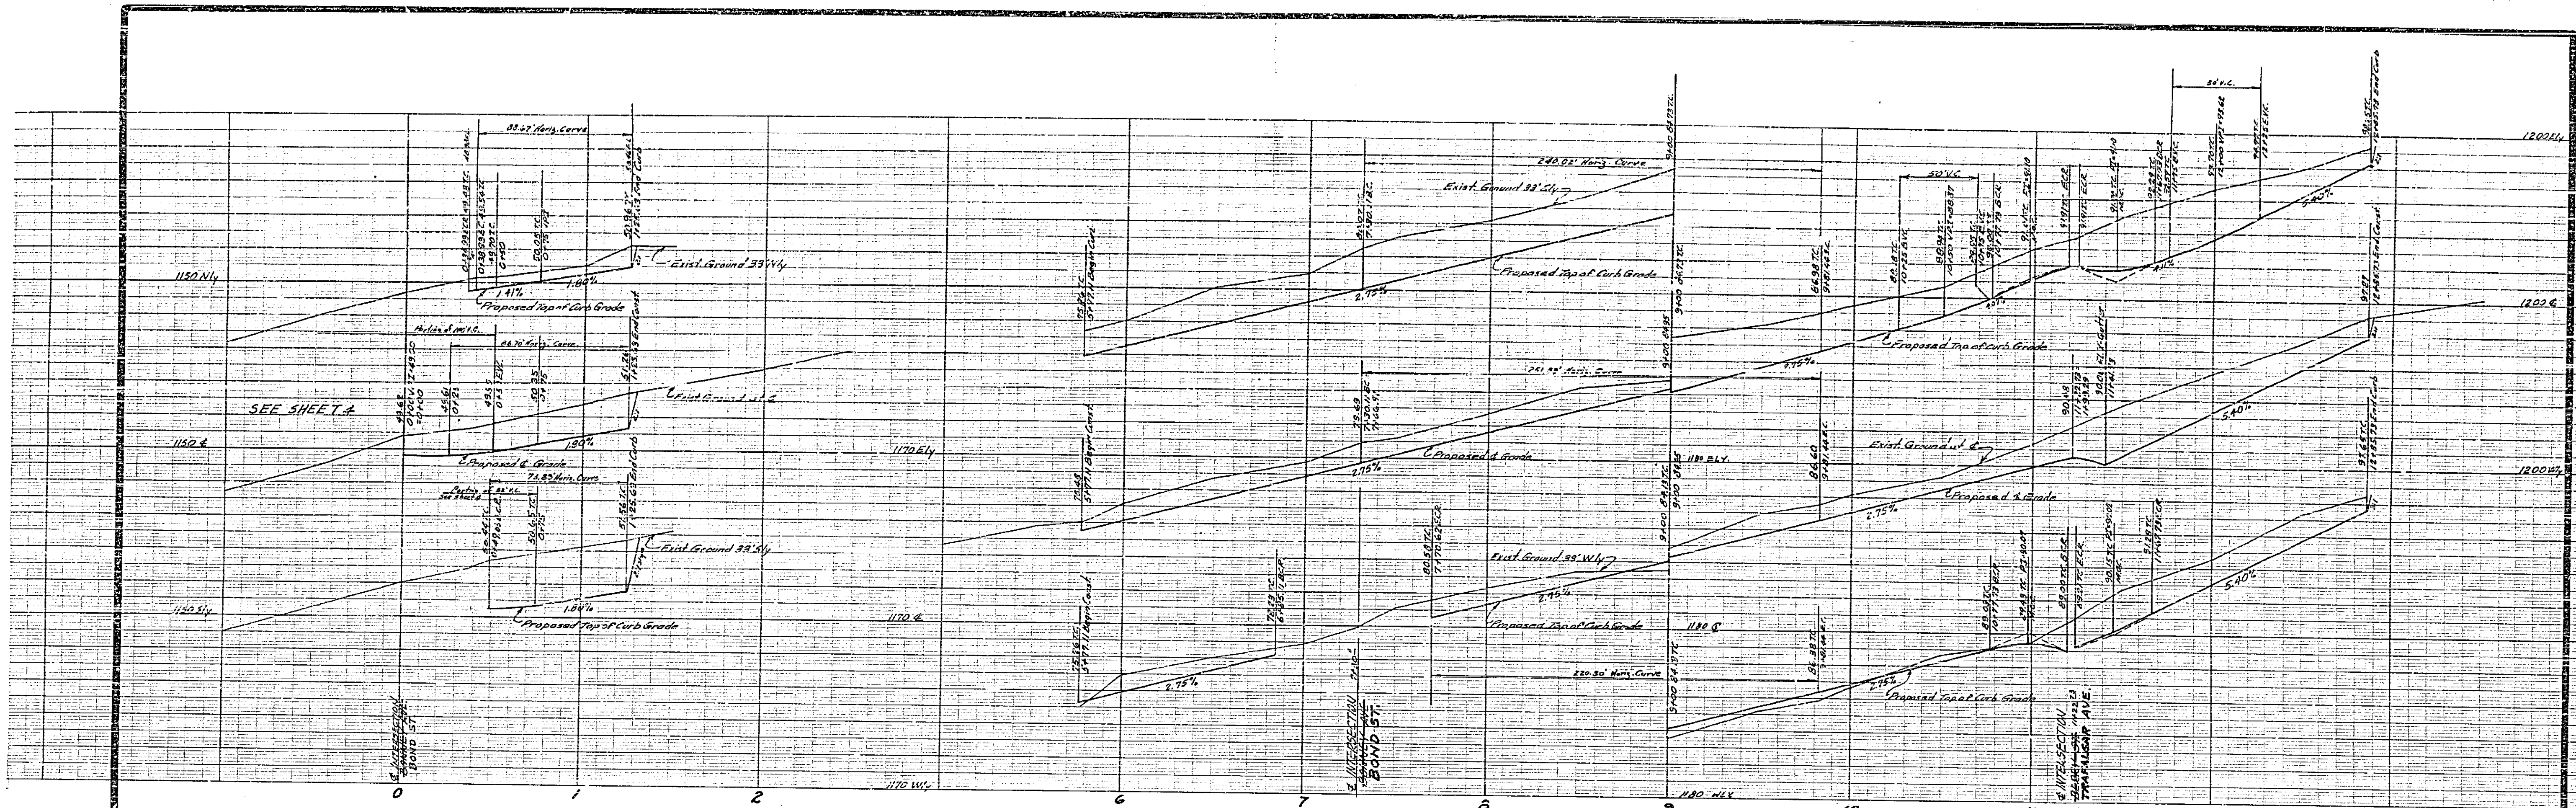

REVISIONS		
MARK	DATE DESCRIPTION	
*	1/26/62	ADD I.B.M. on all sheets

J.F. DAVIDSON-CIVIL ENGINEER  
 RIVERSIDE, CALIFORNIA  
 APPROVED BY: [Signature] DATE: 2/2/62  
 CITY OF RIVERSIDE, CALIFORNIA  
 DEPARTMENT OF PUBLIC WORKS  
**STREET PLAN & PROFILE**  
**ACADEMY HARWELL AVENUE, BOND ST, BONNEY AVENUE, LIVINGSTON, TRAFALGAR AVENUE & HODGES ST.**  
 TRACT 2405  
 HORIZ. SCALE 1"=40' VERT. SCALE 1"=4'  
 DESIGNED BY: [Signature]  
 DRAWN BY: [Signature]  
 CHECKED BY: R.M. [Signature]  
 RECOMMENDED BY: R.M. [Signature]  
 ASSISTANT CITY ENGINEER  
 APPROVED BY: [Signature]  
 DIRECTOR OF PUBLIC WORKS  
 DATE: 2-4-62  
 NO. E-600  
 SHEET 3 OF 4

BENCH MARK: Telephone pole 237515-H  
 East of Alessandro Boulevard  
 Elevation 1120.57

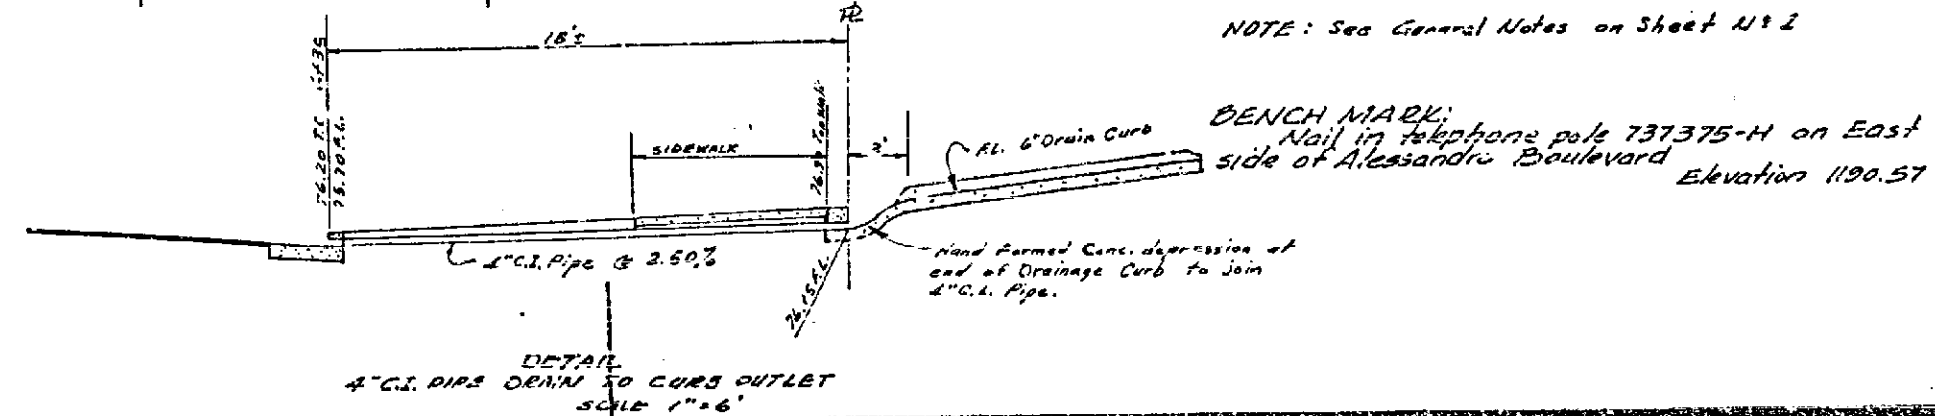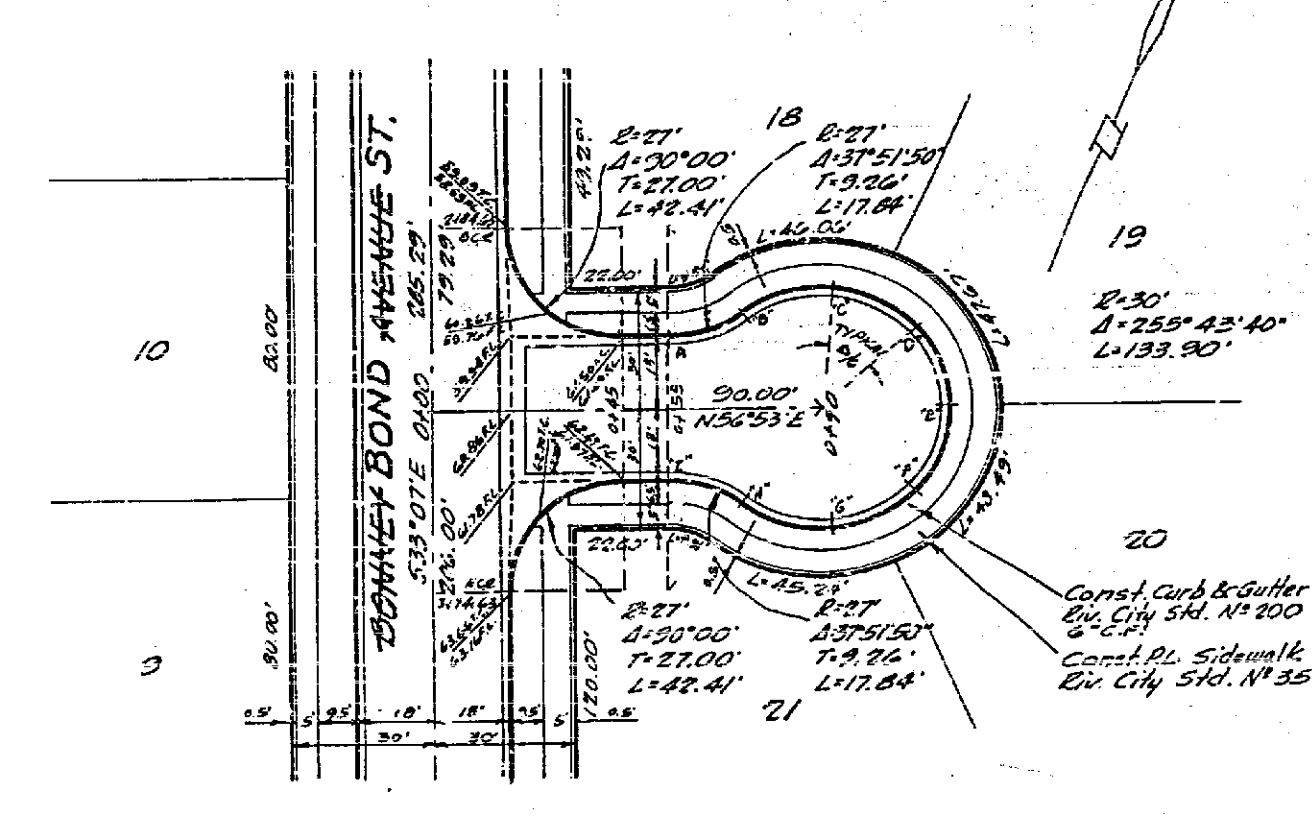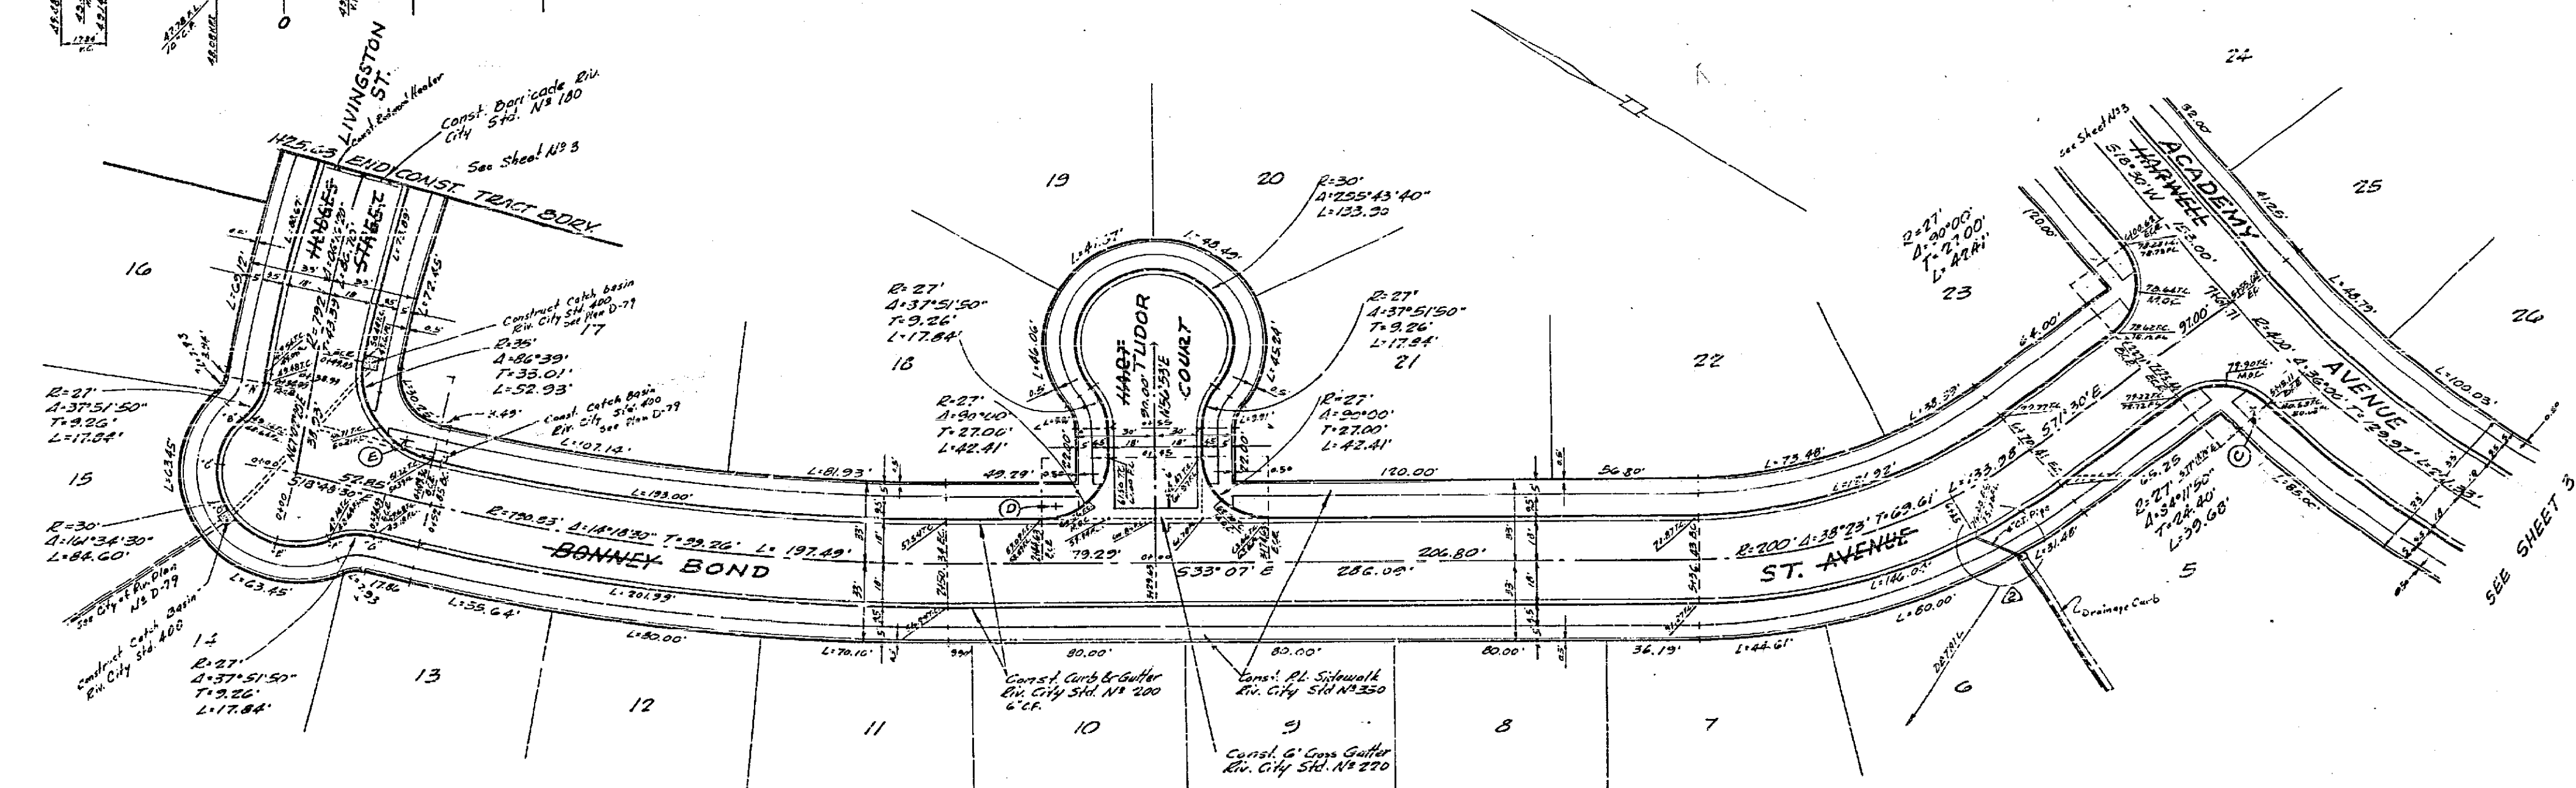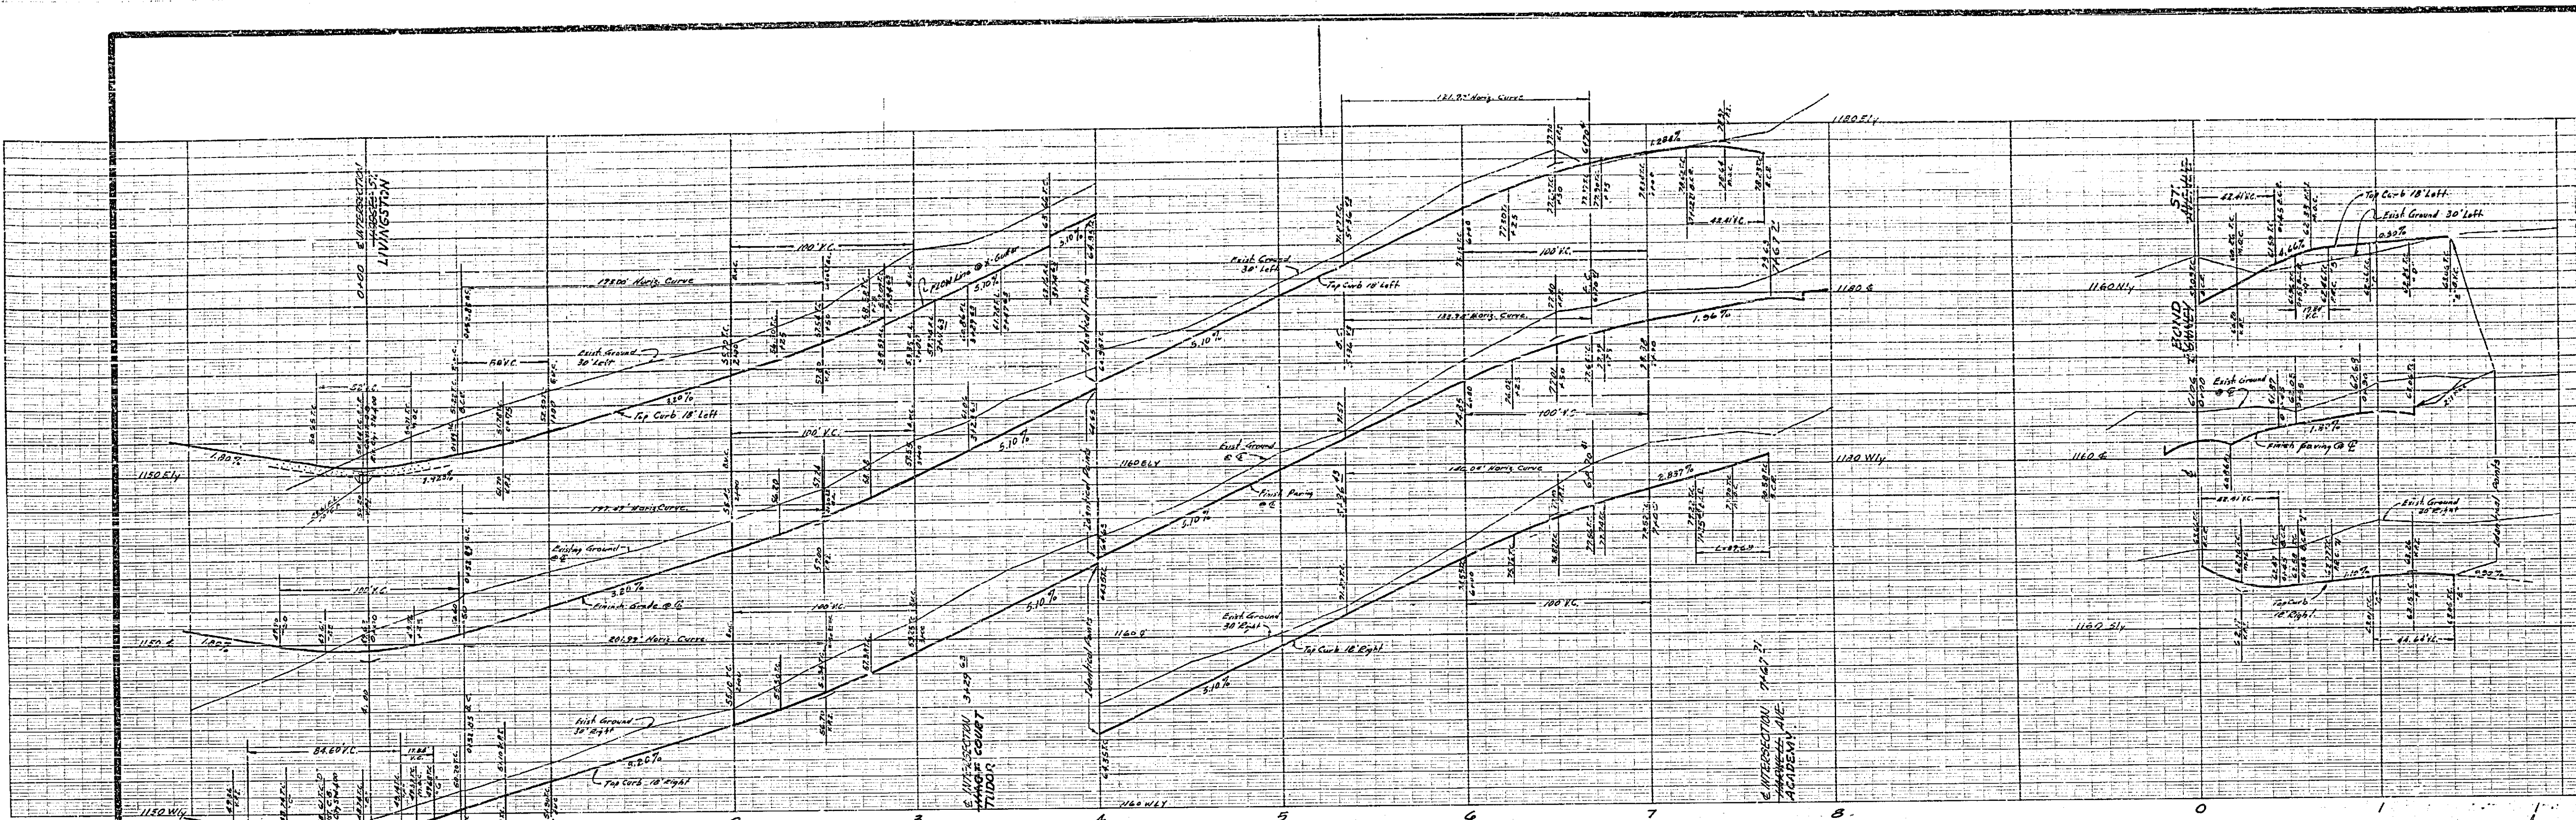

REVISIONS		
MARK	DATE	DESCRIPTION
*	1/10/28	add 5' 10\"/>
3	1/10/28	add 4\"/>

R.D. 771-1  
**J.F. DAVIDSON-CIVIL ENGINEER**  
 R.E. No. 862  
 RIVERSIDE, CALIFORNIA  
 APPROVED BY *J.F. Davidson* DATE 4-19-27  
**CITY OF RIVERSIDE, CALIFORNIA**  
**DEPARTMENT OF PUBLIC WORKS**  
**STREET PLAN & PROFILE**  
**BOND**  
**BONNEY AVENUE AND**  
**TUDOR COURT**  
**TRACT 2405**  
 HORIZ. SCALE 1"=40' VERT. SCALE 1"=4'  
 DESIGNED BY \_\_\_\_\_ CHECKED BY *R.M. add*  
 DRAWN BY \_\_\_\_\_  
 RECOMMENDED BY *J.F. Davidson* ASSISTANT CITY ENGINEER  
 APPROVED BY *J.F. Davidson* Director of Public Works  
 NO. **R-600**  
 DATE 4-1-27 SHEET **4** OF **4**  
 2/BB

NOTE: See General Notes on Sheet No. 2  
 BENCH MARK: Nail in telephone pole 737375-M on East side of Alexander Boulevard Elevation 1190.57