


- GENERAL NOTES**
1. All Construction shall be in accordance with Standards and Specifications No. 461 of the City of Riverside Department of Public Works.
 2. It shall be the responsibility of the Contractor to clear the Right of Way in accordance with the provisions of laws if objects such utility including irrigation lines and appurtenances, and at no extra cost to the City of Riverside.
 3. Stations are on the curb.

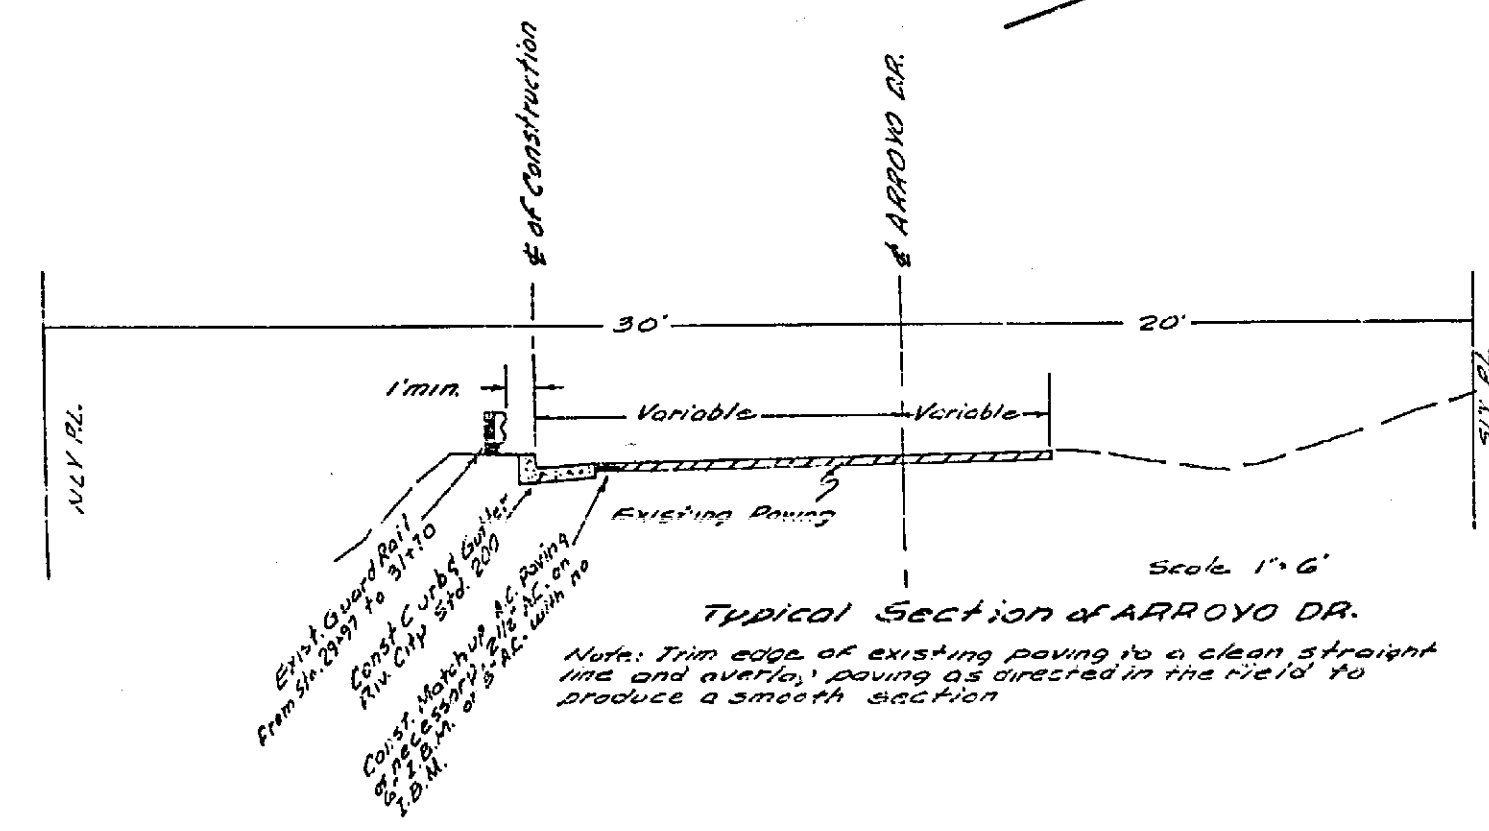

City Bench Mark
 Railroad Spike in Power Pole #8073-1, Northern side ARROYO DR, 100'
 Easterly of E. of Pavement of SEDGWICK AVE Elev. 963.77

J.F. Anderson 11-26-62

△ 4-19-63
 Curb grade and existing
 edge of Paving from D.M.
 30'-0" to 31'-0" have been
 checked to compare to
 no existing D.M. conditions
 considered by construction riding
 1/25/67 J.M.

STREET
 from SEDGWICK AVE to 300' ELY. on
 ARROYO DRIVE
 R.S. #652
 COL. MILB CLARK
 1"-40'

Rev. 1-10-62
 for G.A. Threl
 Dec 28, 1962 1 1
 R-634
 2196

