


CREST AVENUE IMPROVEMENT DISTRICT ASSESSMENT DISTRICT NO. 110

MAP SHOWING THE LAND INCLUDED WITHIN THE ASSESSMENT DISTRICT TO BE BENEFITED BY THE CONSTRUCTION OF CONCRETE CURBS AND GUTTERS AND THE GRADING AND PAVING OF STREETS.
A. C. Keith — County Surveyor — Riverside County, California.

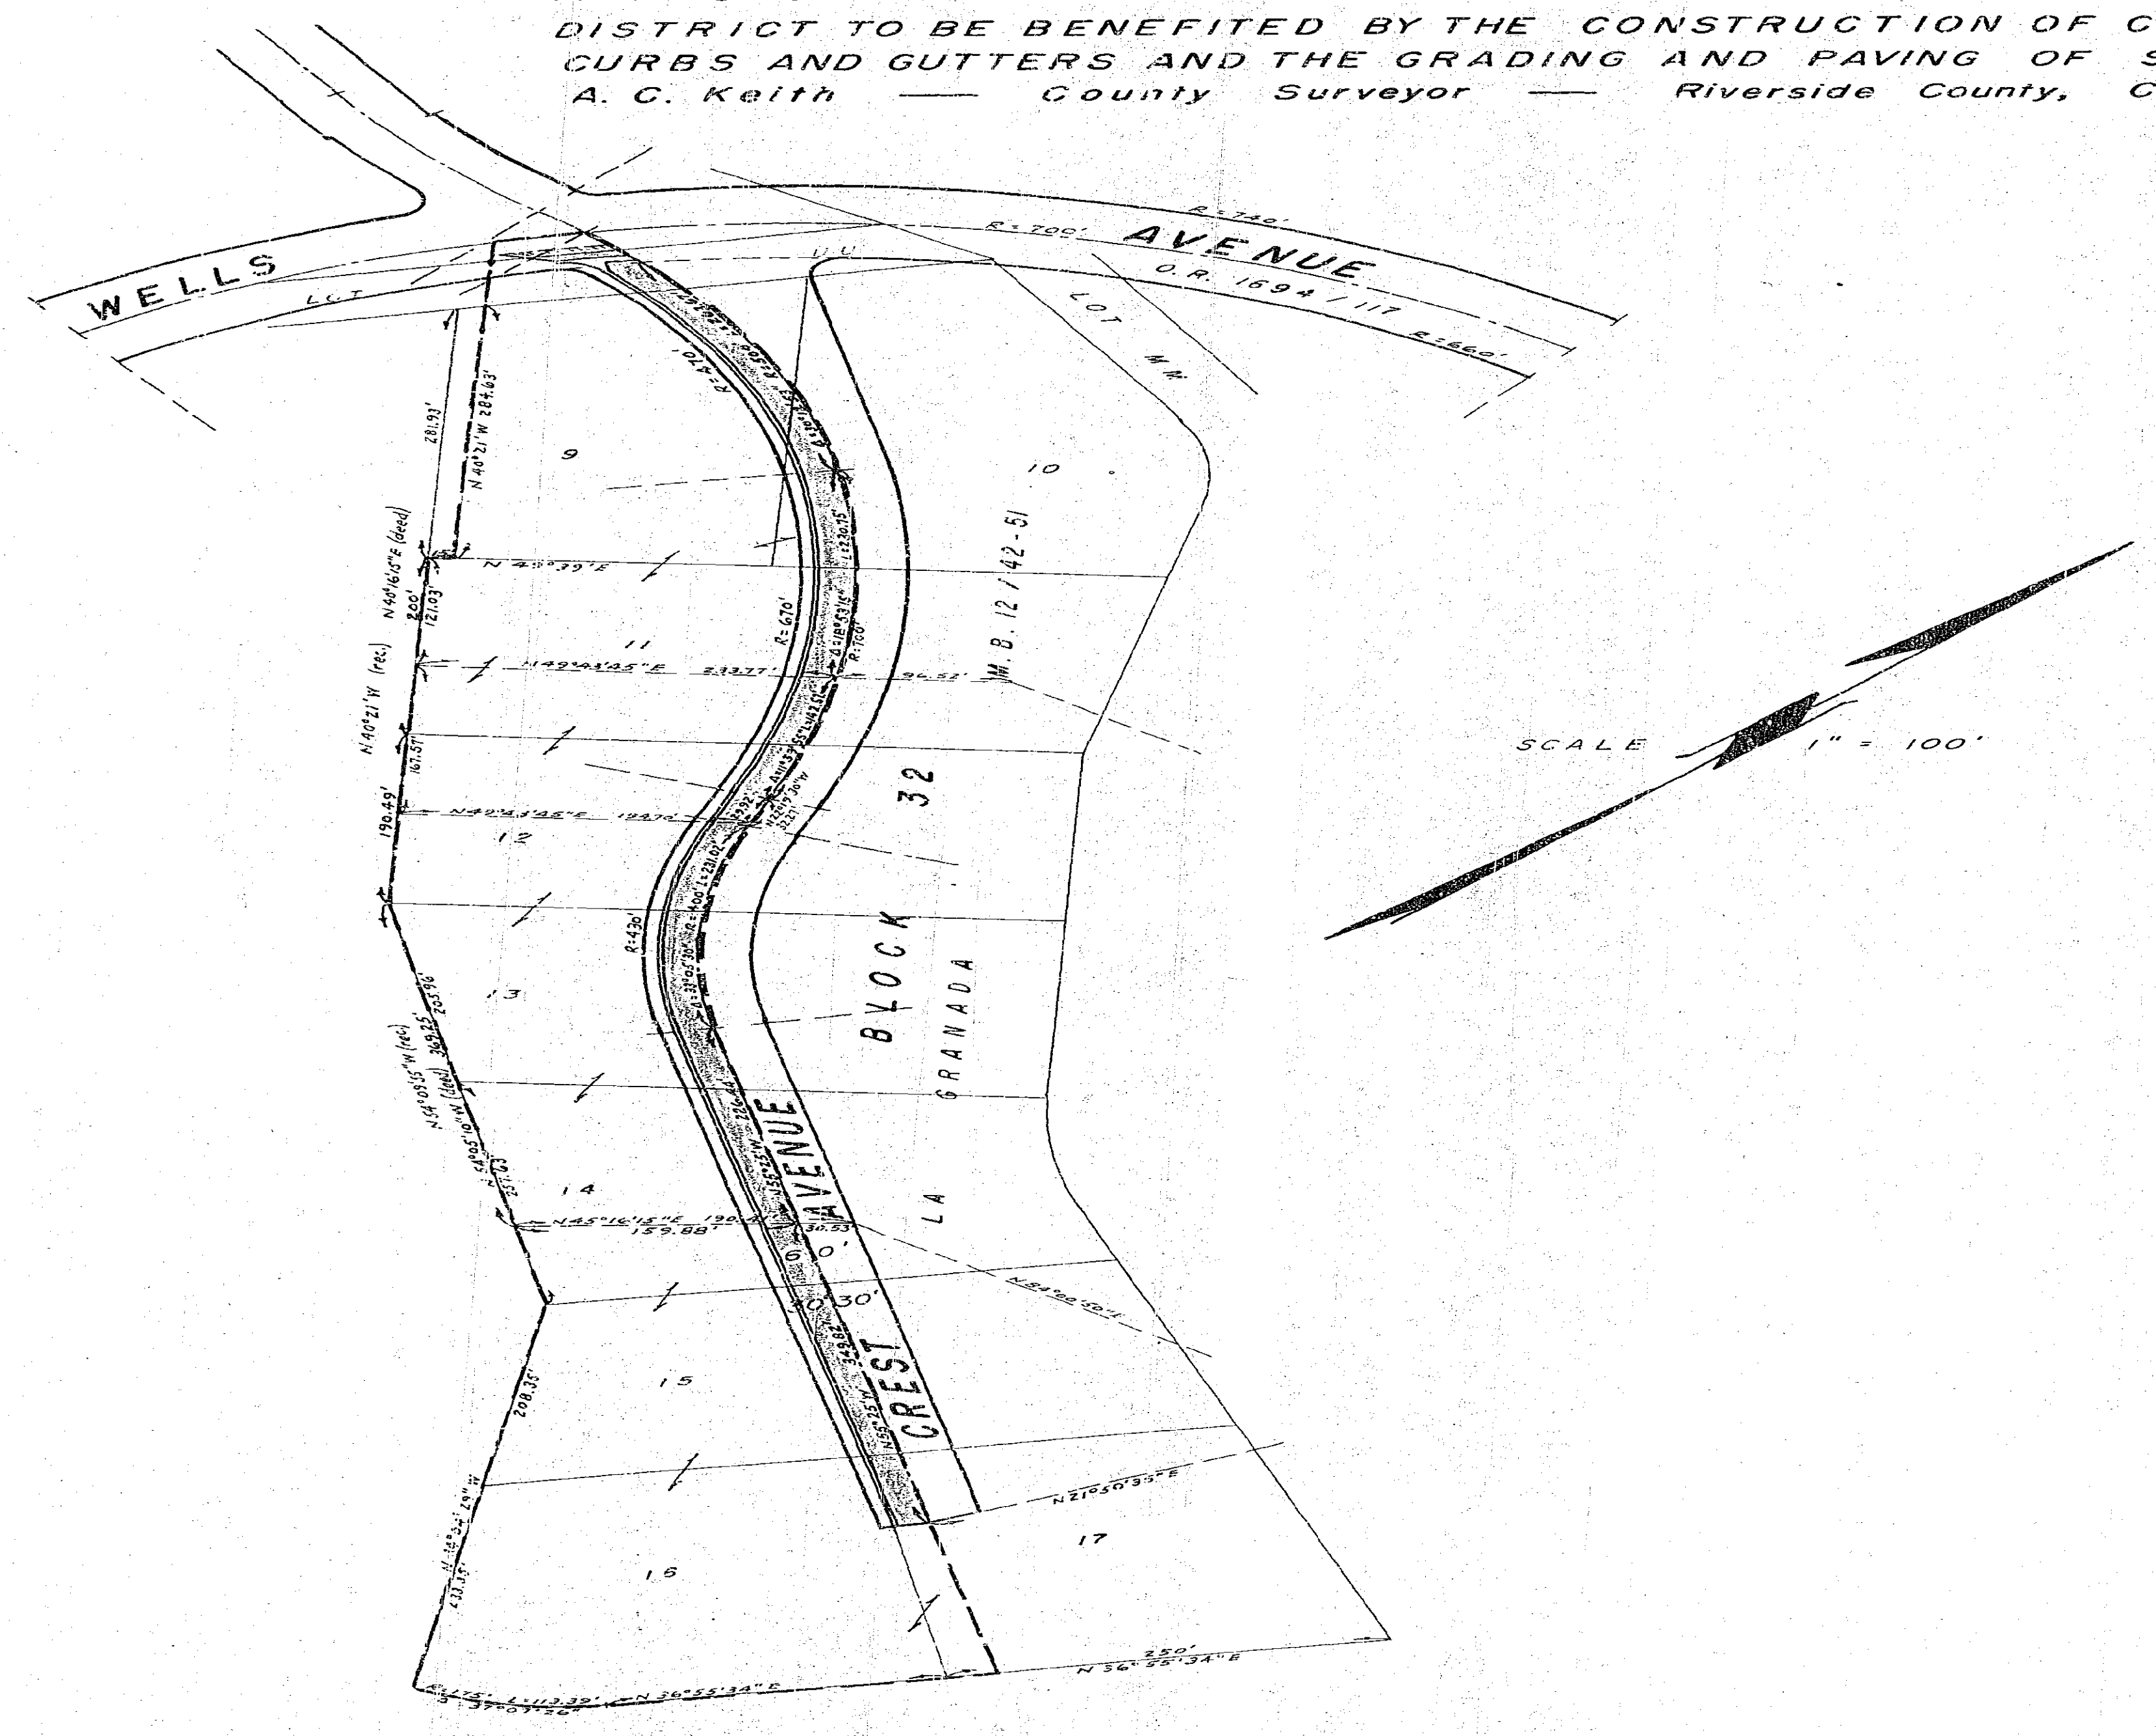


DIAGRAM

EXHIBITING THE CREST AVENUE IMPROVEMENT DISTRICT
ASSESSMENT DISTRICT NO. 11C

IN THE COUNTY OF RIVERSIDE ON WHICH WORK HAS BEEN DONE UNDER THE OFFICIAL CONTRACT OF THE COUNTY SURVEYOR OF SAID COUNTY WITH CALIFORNIA ASPHALT CO. DATED FEBRUARY 5, 1962, FOR THE CONSTRUCTION OF CONCRETE CURB AND GUTTERS, CROSS-GUTTERS, AND THE GRADING AND PAVING OF THE STREET, AS IS MORE PARTICULARLY DESCRIBED IN SAID CONTRACT TO WHICH REFERENCE IS MADE FOR FURTHER PARTICULARS. SAID DIAGRAM ALSO SHOWS THE RELATIVE LOCATION OF EACH LOT PORTION OR LOT PIECE OR PARCEL OF LAND ASSESSED FOR THE WORK DONE NUMBERED IN INK TO CORRESPOND TO THE INK NUMBERS IN THE ASSESSMENT AS SHOWN HEREIN. FIGURES NEXT TO PROPERTY LINES SHOW LENGTH OF SAID LINES IN FEET. THE MARK (X) MEANS FEET. PROPERTY LINES THAT DIFFER FROM THE RECORDED SUBDIVISIONS ARE SHOWN BY BROKEN LINES. THE DISTRICT BENEFITED IS BOUNDED BY A HEAVY DASHED LINE. PROPERTY COVERED BY THIS ASSESSMENT IS SHOWN ON THE FOLLOWING RECORDED MAP:

PORTION OF BLK 32
LA GRANADA TRACT
MB 12/12-51

HEREIN THE LEGEND OF THE DIFFERENT KINDS OF WORK PERFORMED IS SHOWN AS FOLLOWS:

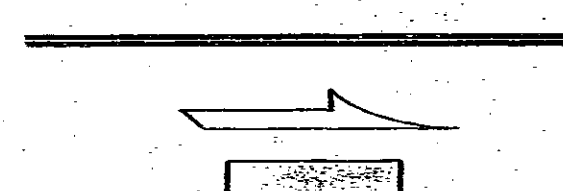	<p>CONCRETE CURB AND GUTTER</p> <p>CONCRETE CROSS-GUTTER</p> <p>GRADING, PAVING, MISC. ROADWORK</p>
---	---

COUNTY SURVEYOR OF THE COUNTY OF RIVERSIDE:
THE FOLLOWING KINDS OF WORK DONE BY CALIFORNIA ASPHALT CO.
UNDER CONTRACT DATED FEBRUARY 5, 1962, PURSUANT TO RESOLUTION
OF INTENTION NO. 11C-F ADOPTED BY THE BOARD OF SUPERVISORS OF
THE COUNTY OF RIVERSIDE ON NOVEMBER 13, 1961:

3803	C.Y.	ROADWAY EXCAVATION
1110	C.Y.	IMPORTED BASE MATERIAL
2.53	TONS	LIQUID ASPHALT, SC-1
1100.47	TONS	PLANT-MIXED SURFACING
1292	L.F.	CONCRETE CURB AND GUTTER
175.10	S.F.	CONCRETE CROSS-GUTTER
	L.S.	FINISH ROADWAY

I HEREBY CERTIFY THAT THE ABOVE WORK WAS DONE IN ACCORDANCE
WITH LINES AND GRADES FURNISHED BY ME AND THAT THE DIAGRAM
OF THE ASSESSMENT DISTRICT FOR THE SAME IS CORRECT.

A. C. Smith
COUNTY SURVEYOR
OF THE COUNTY OF RIVERSIDE

RECORDED AT _____ O'CLOCK
THIS _____ DAY OF _____ 1962

COUNTY SURVEYOR
OF THE COUNTY OF RIVERSIDE

R-649 Sh. 1750-F