



B.M. ELEV. 778.96 1/2" IRON BAR IN POLE #R810T STA. 6+22.5
 B.M. ELEV. 771.84 1/2" IRON BAR IN POLE #3296J STA. 13+58.5
 F.B. 814 / 24 - 33
 SCALE: HOR. 1" = 50'
 VERT. 1" = 5'

PROFILE	REVISED
DATE	REVISED
BY	REVISED
BY	REVISED

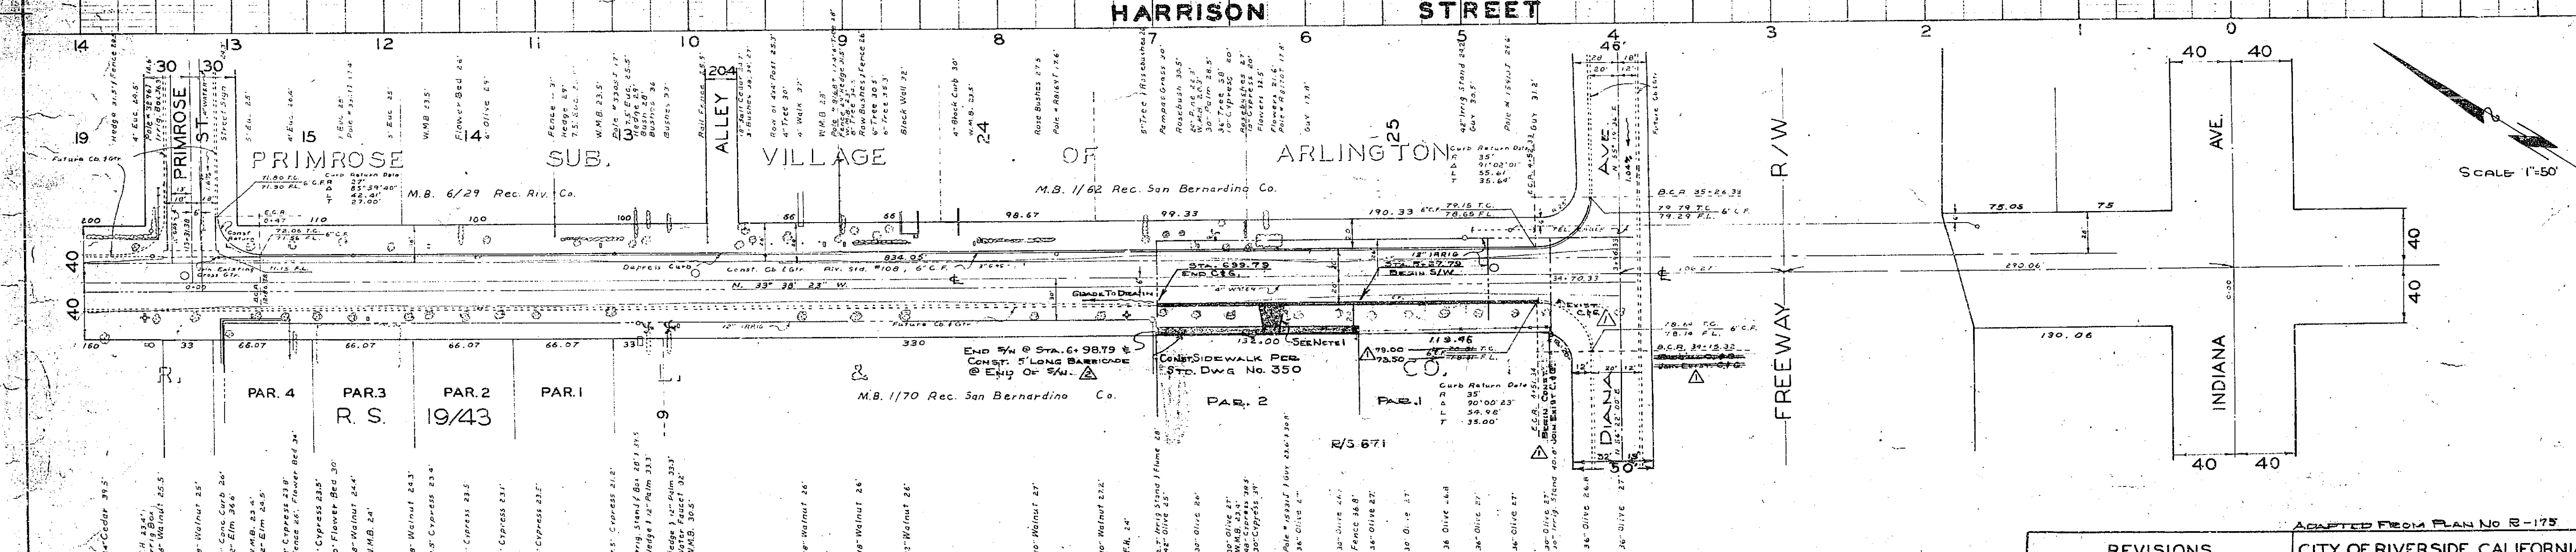

PLAN	REVISED
DATE	REVISED
BY	REVISED
BY	REVISED

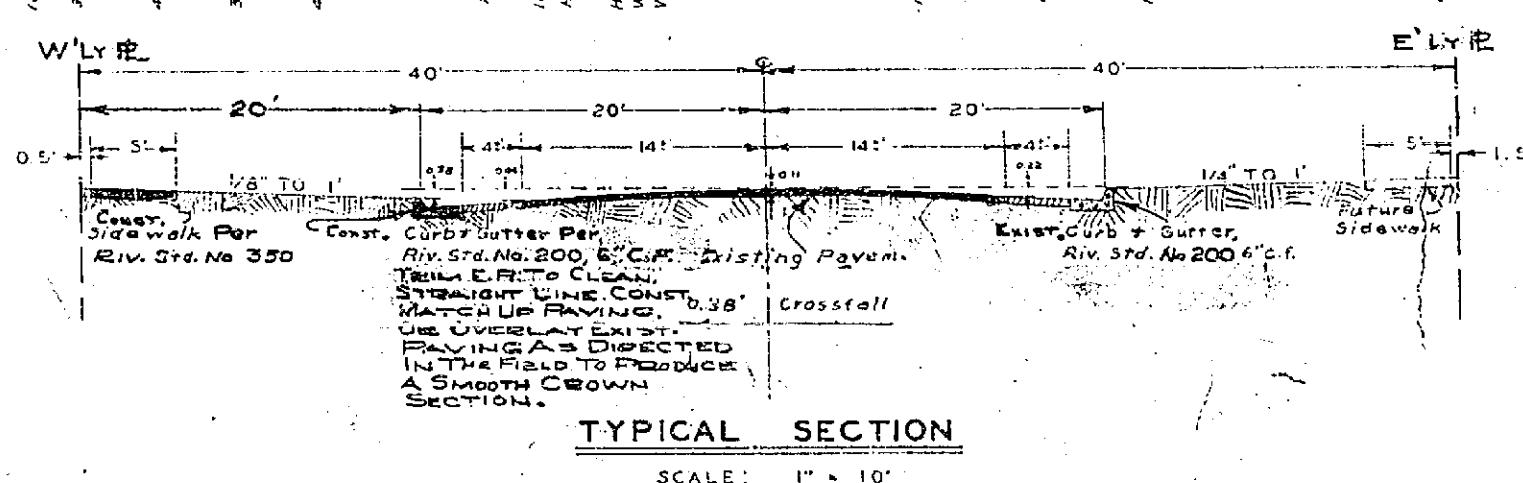

NOTES:
 1. DRIVEWAY TO BE PERM. STD. DWG. NO. 302
 SIZE AND LOCATION TO BE DETERMINED BY OWNER

REVISIONS			CITY OF RIVERSIDE CALIFORNIA DEPARTMENT OF PUBLIC WORKS
MARK	DATE	DESCRIPTION	
Δ	3-15-65	CHANGED C.R. TO EXIST. & REV. GRADE TO CONFORM WITH EXISTING GRADE.	HARRISON STREET 671-677 North
Δ	3-23-65	ADDED BARRIERS S/W. LOCATED FROM A.K.W. D.A.P. 3-23-65	

DESIGNED BY DAP
 DRAWN BY A.F.W.
 CHECKED BY [Signature]
 APPROVED BY [Signature]

A-660
 SHEET 1 OF 1

