

DIAGRAM OF THE PROPERTY AFFECTED OR BENEFITED BY THE WORK IN THE FOOTHILL AVENUE IMPROVEMENT DISTRICT.

REVISIONS			CITY OF RIVERSIDE, CALIFORNIA DEPARTMENT OF PUBLIC WORKS	
MARK	DATE	DESCRIPTION		
			FOOTHILL AVENUE IMPROVEMENT DISTRICT	
DESIGNED BY		SUBMITTED BY	APPROVED BY	PROJ. NO. 6042
DRAWN BY		PARK DEPT. TRAFFIC DIV.	<i>[Signature]</i>	R-691-B
CHECKED BY		RECOMMENDED BY	DATE 9-17-61	SHEET 2 OF 2

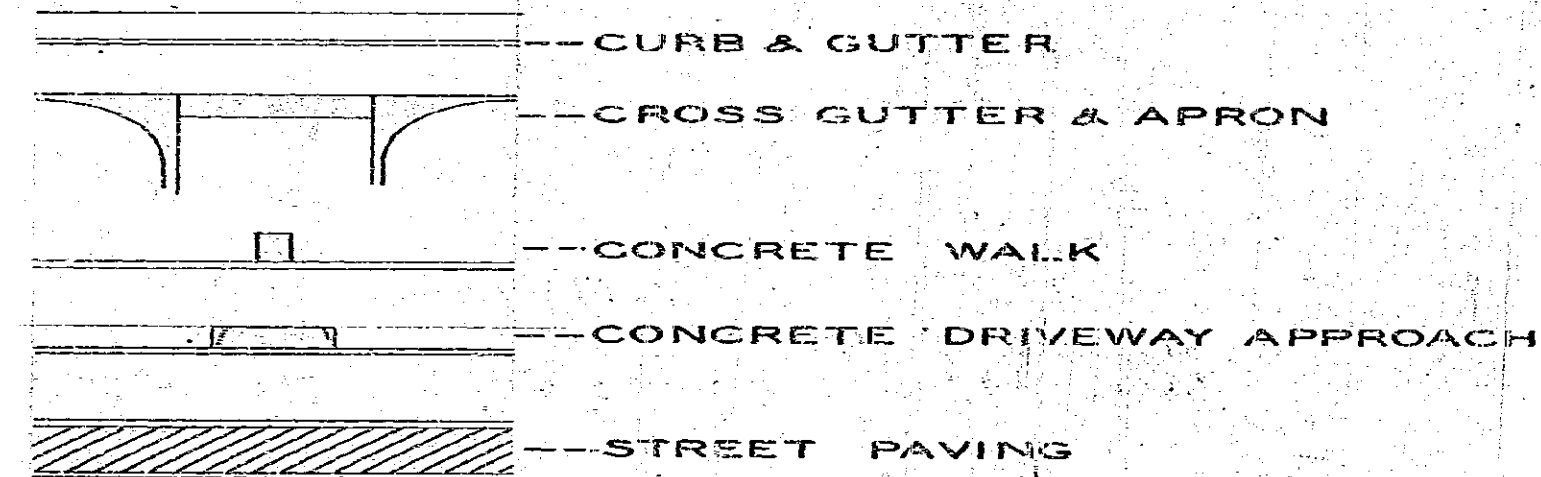
ASSESSMENT NO. 501

DIAGRAM

EXHIBITING FOOTHILL AVENUE IMPROVEMENT DISTRICT,
IN THE CITY OF RIVERSIDE, CALIFORNIA, AND THE WORK WHICH HAS BEEN DONE
PURSUANT TO THE CONTRACT BETWEEN THE SUPERINTENDENT OF STREETS OF
SAID CITY AND E.L. YEAGER CONSTRUCTION CO. DATED JUNE 3, 1964,
FOR THE CONSTRUCTION OF STREET IMPROVEMENTS

AS IS MORE PARTICULARLY DESCRIBED IN SAID CONTRACT, TO WHICH REFERENCE
IS HEREBY MADE FOR FURTHER PARTICULARS.
SAID DIAGRAM ALSO SHOWS EACH SEPARATE LOT OR PARCEL OF LAND WITHIN THE
LIMITS OF THE ASSESSMENT DISTRICT, AND THE DIMENSIONS OF EACH SUCH LOT OR
PARCEL OF LAND, AND THE RELATIVE LOCATION OF THE SAME TO THE WORK DONE.
EACH LOT OR PARCEL OF LAND IS NUMBERED IN RED INK TO CORRESPOND TO THE
RED INK NUMBERS IN THE ASSESSMENT.
HEREIN FIGURES NEXT TO PROPERTY LINES SHOW LENGTH OF SAID LINES IN FEET
AND DECIMALS THEREOF.
THE MARK (C) MEANS FEET.
PROPERTY LINES THAT DIFFER FROM THE RECORDED SUBDIVISIONS ARE SHOWN BY
BROKEN LINES.
THE DISTRICT BENEFITED IS BOUNDED BY A HEAVY DASHED LINE.
PROPERTY INCLUDED IN THIS ASSESSMENT IS SHOWN ON THE FOLLOWING RECORDED
MAPS:
SIERRA FOOTHILL TRACT, M.B. 24, PGS. 62 & 63, RIV. CO. REC.
ALCAZAR, M.B. 16, PGS. 31-34, RIV. CO. REC.

HEREIN THE DIFFERENT KINDS OF WORK
PERFORMED ARE SHOWN AS FOLLOWS:



HERE FOLLOWS A STATEMENT OF AMOUNTS OF
DIFFERENT KINDS OF WORK DONE PURSUANT TO
THE HERE-IN-BEFORE IDENTIFIED CONTRACT
AND TO RESOLUTION OF INTENTION NO. 9908,
ADOPTED BY THE CITY COUNCIL OF THE CITY
OF RIVERSIDE, CALIFORNIA ON THE 18TH DAY
OF FEBRUARY, 1964.

---	L.S. ROAD EXCAVATION
500	L.F. RESET FENCE
5	EA. ADJUST CLEANOUTS TO GRADE
3	EA. ADJUST MANHOLES TO GRADE
3,831	L.F. CURB & GUTTER - 6" CURB FACE
61	S.F. CONCRETE WALK
5,281	S.F. CONCRETE DRIVEWAY APPROACH
1,000	S.F. CROSS GUTTER AND APRON
1,311.80	TON AGGREGATE BASE
1,021.45	TON ASPHALT CONCRETE
64,900	S.F. SEAL COAT

I HEREBY CERTIFY THAT THE ABOVE WORK WAS DONE IN ACCORDANCE
WITH LINES AND GRADES FURNISHED OR APPROVED BY ME, AND THAT
THE DIAGRAM OF THE ASSESSMENT DISTRICT AND THE QUANTITIES
OF WORK SHOWN HEREON ARE CORRECT.

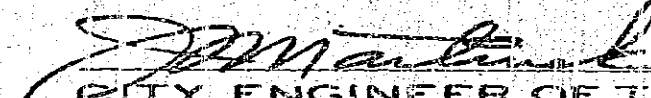

CITY ENGINEER OF THE
CITY OF RIVERSIDE, CALIFORNIA

DIAGRAM RECEIVED:

THIS DAY OF , 19

SUPERINTENDENT OF STREETS OF THE
CITY OF RIVERSIDE, CALIFORNIA

RECORDED:

AT O'CLOCK, .M.,
THIS DAY OF , 19

SUPERINTENDENT OF STREETS OF THE
CITY OF RIVERSIDE, CALIFORNIA