


BENCH MARK: Elev 781.799
 * on bolt of P.M. S.W. Cor. of Magnolia & Monroe St.

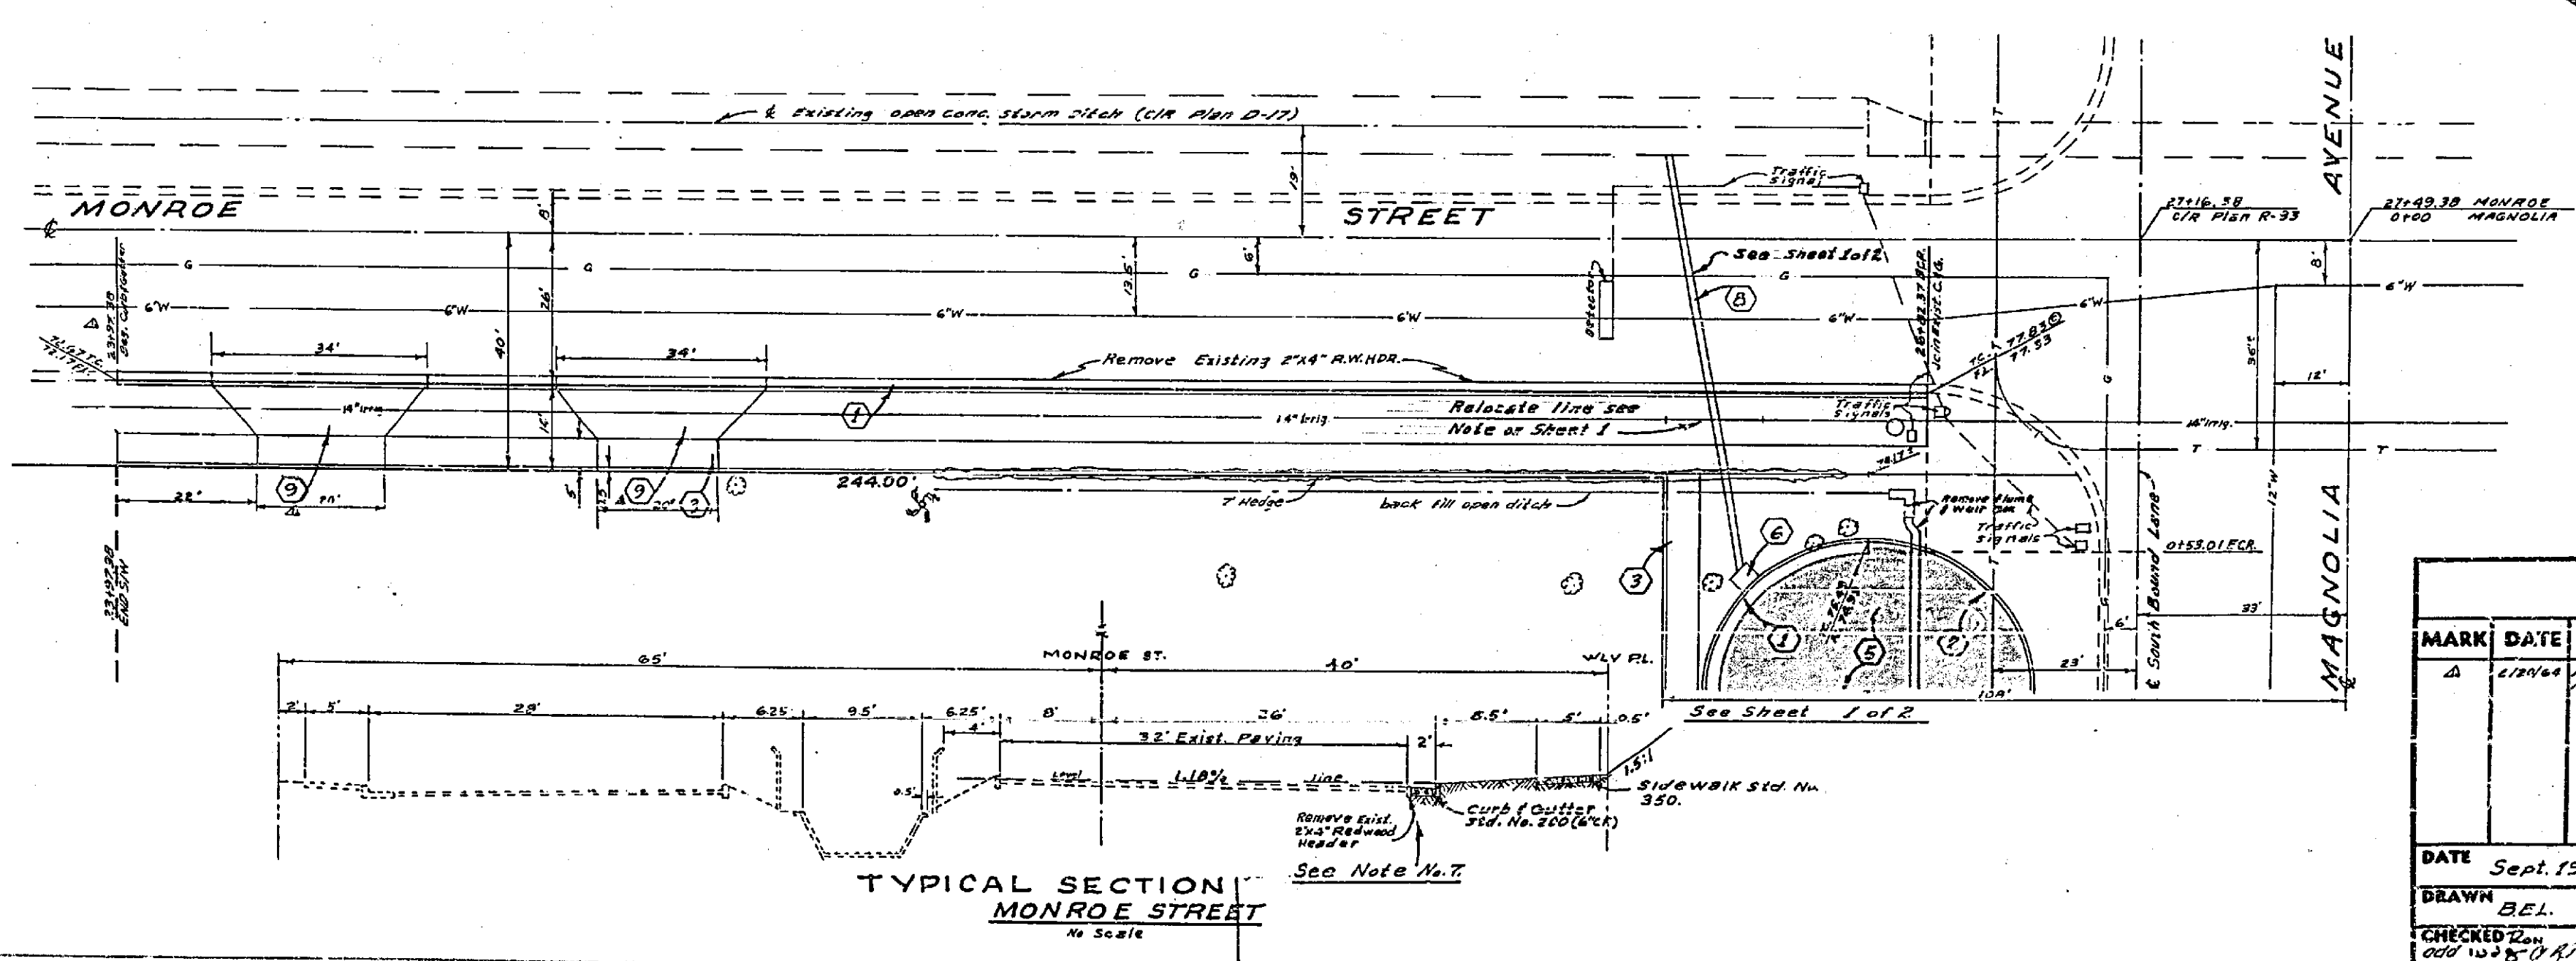

REVISION		
MARK	DATE	DESCRIPTION
Δ	1/18/64	Added SW Approach, reduced SW Approach, changed size of curb, etc. (See Note No. 1 & 2)

ALBERT A. WEBB ASSOCIATES
 CIVIL ENGINEERS - RIVERSIDE, CALIFORNIA
 APPROVED: *[Signature]* DATE: 7/1/63
 CITY OF RIVERSIDE, CALIFORNIA
 DEPARTMENT OF PUBLIC WORKS
STREET PLAN & PROFILE
MONROE STREET
WLY OF MAGNOLIA
 ZONING CASE 63-623

DATE: Sept. 1963 SCALE: 1" = 20'
 DRAWN: BEL. W.D. 63-157
 CHECKED: [Signature] F.B.
 APPROVED BY: *[Signature]* NO. R-741
 DIRECTOR OF PUBLIC WORKS
 DATE: 10-28-63 SHEET 2 OF 2

DWG. No. 63-157A

PROFILE	
DATE	BY

PLAN	
DATE	BY

