


TYPICAL SECTION - HOLE AVE.
STA. 20+64.76 to STA. 22+03.50
SCALE 1"=10'

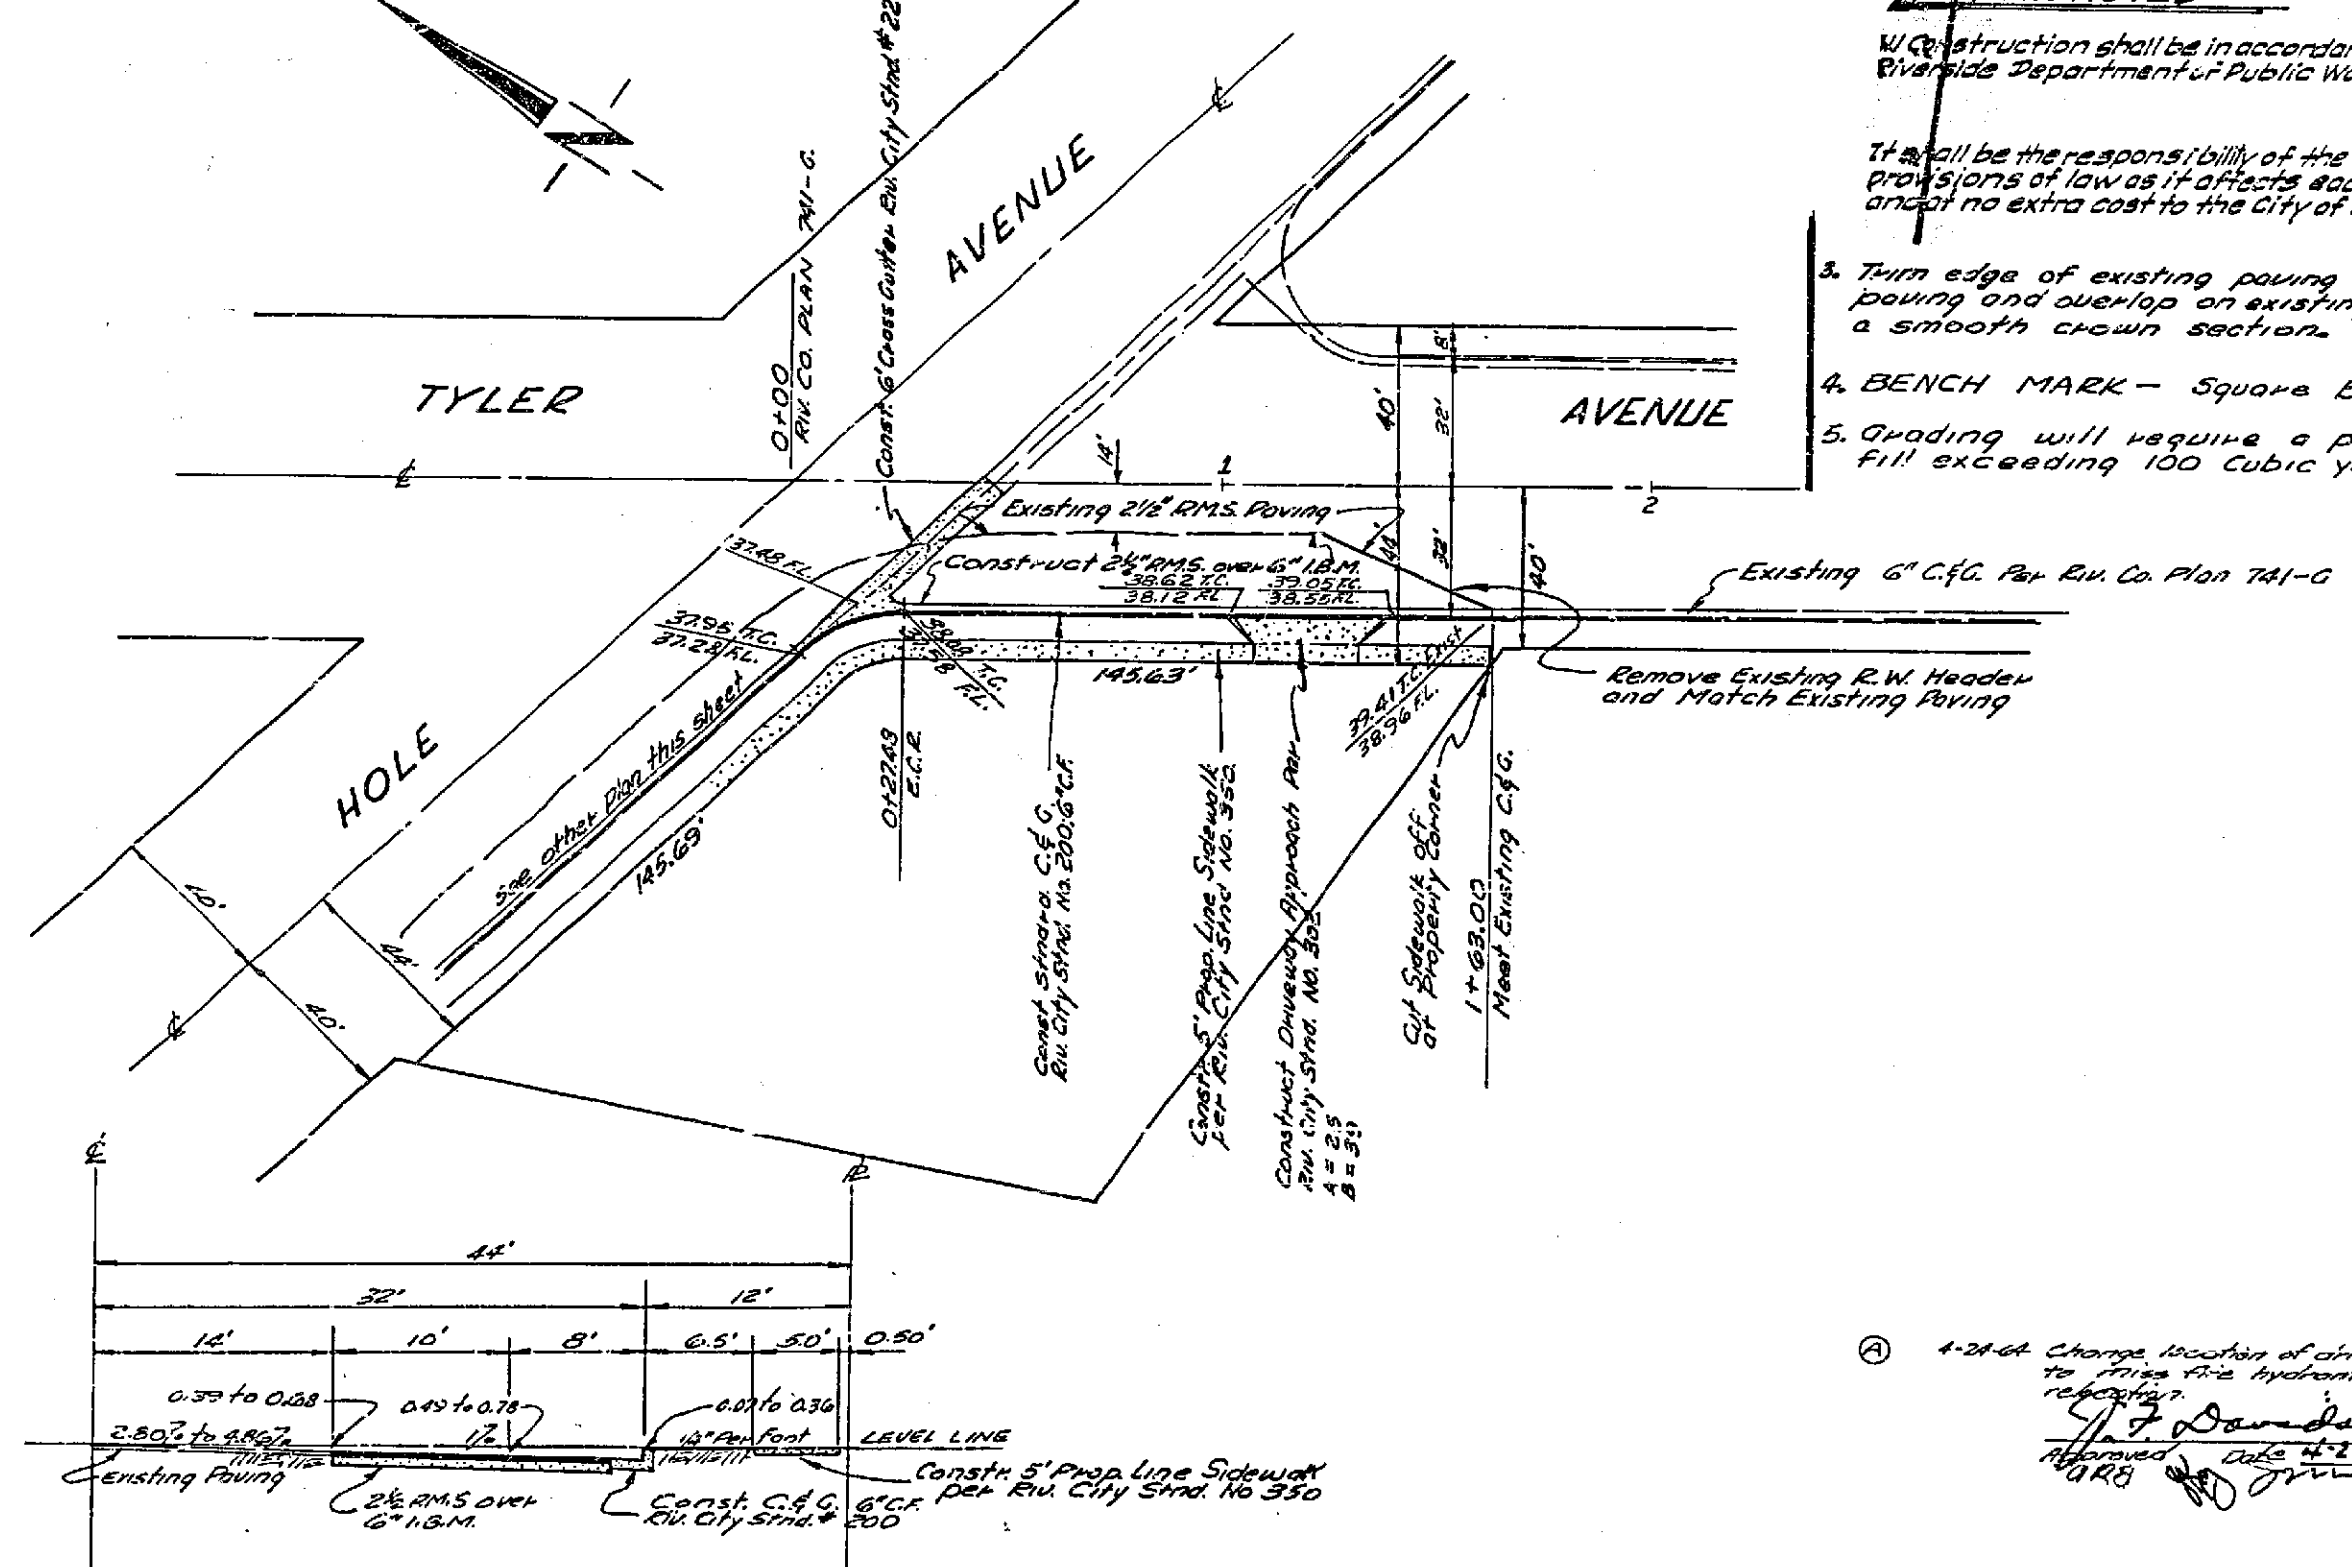

TYPICAL SECTION - TYLER AVE.
STA. 0+27.68 to STA. 1+63.00
SCALE 1"=10'

- GENERAL NOTES**
1. Construction shall be in accordance with Standards and Specifications No. 461 of the City of Riverside Department of Public Works.
 2. It shall be the responsibility of the Contractor to clear the Right of Way in accordance with the provisions of laws as it affects each utility, including irrigation lines and appurtenances, and no extra cost to the City of Riverside.
 3. Turn edge of existing paving to clean straight line. Construct match-up paving and overlap on existing paving as directed in the field to produce a smooth crown section.
 4. BENCH MARK - Square Bolt at Intersection Hole & Tyler. Elev. 738.62.
 5. Grading will require a permit under ordinance 3093 for a cut or fill exceeding 100 cubic yards, or a fill over one foot in depth.

J. F. DAVIDSON - CIVIL ENGINEER
R.E. NO. 862
RIVERSIDE, CALIFORNIA

APPROVED BY: *J.F. Davidson* DATE 2-5-1964

CITY OF RIVERSIDE, CALIFORNIA
DEPARTMENT OF PUBLIC WORKS

STREET PLAN & PROFILE
HOLE AVE. - TYLER AVE.

1"=40' 1"=4'
VERT. SCALE

R-785

1 of 2

MISSING