





SEE SHEET PWG (2)

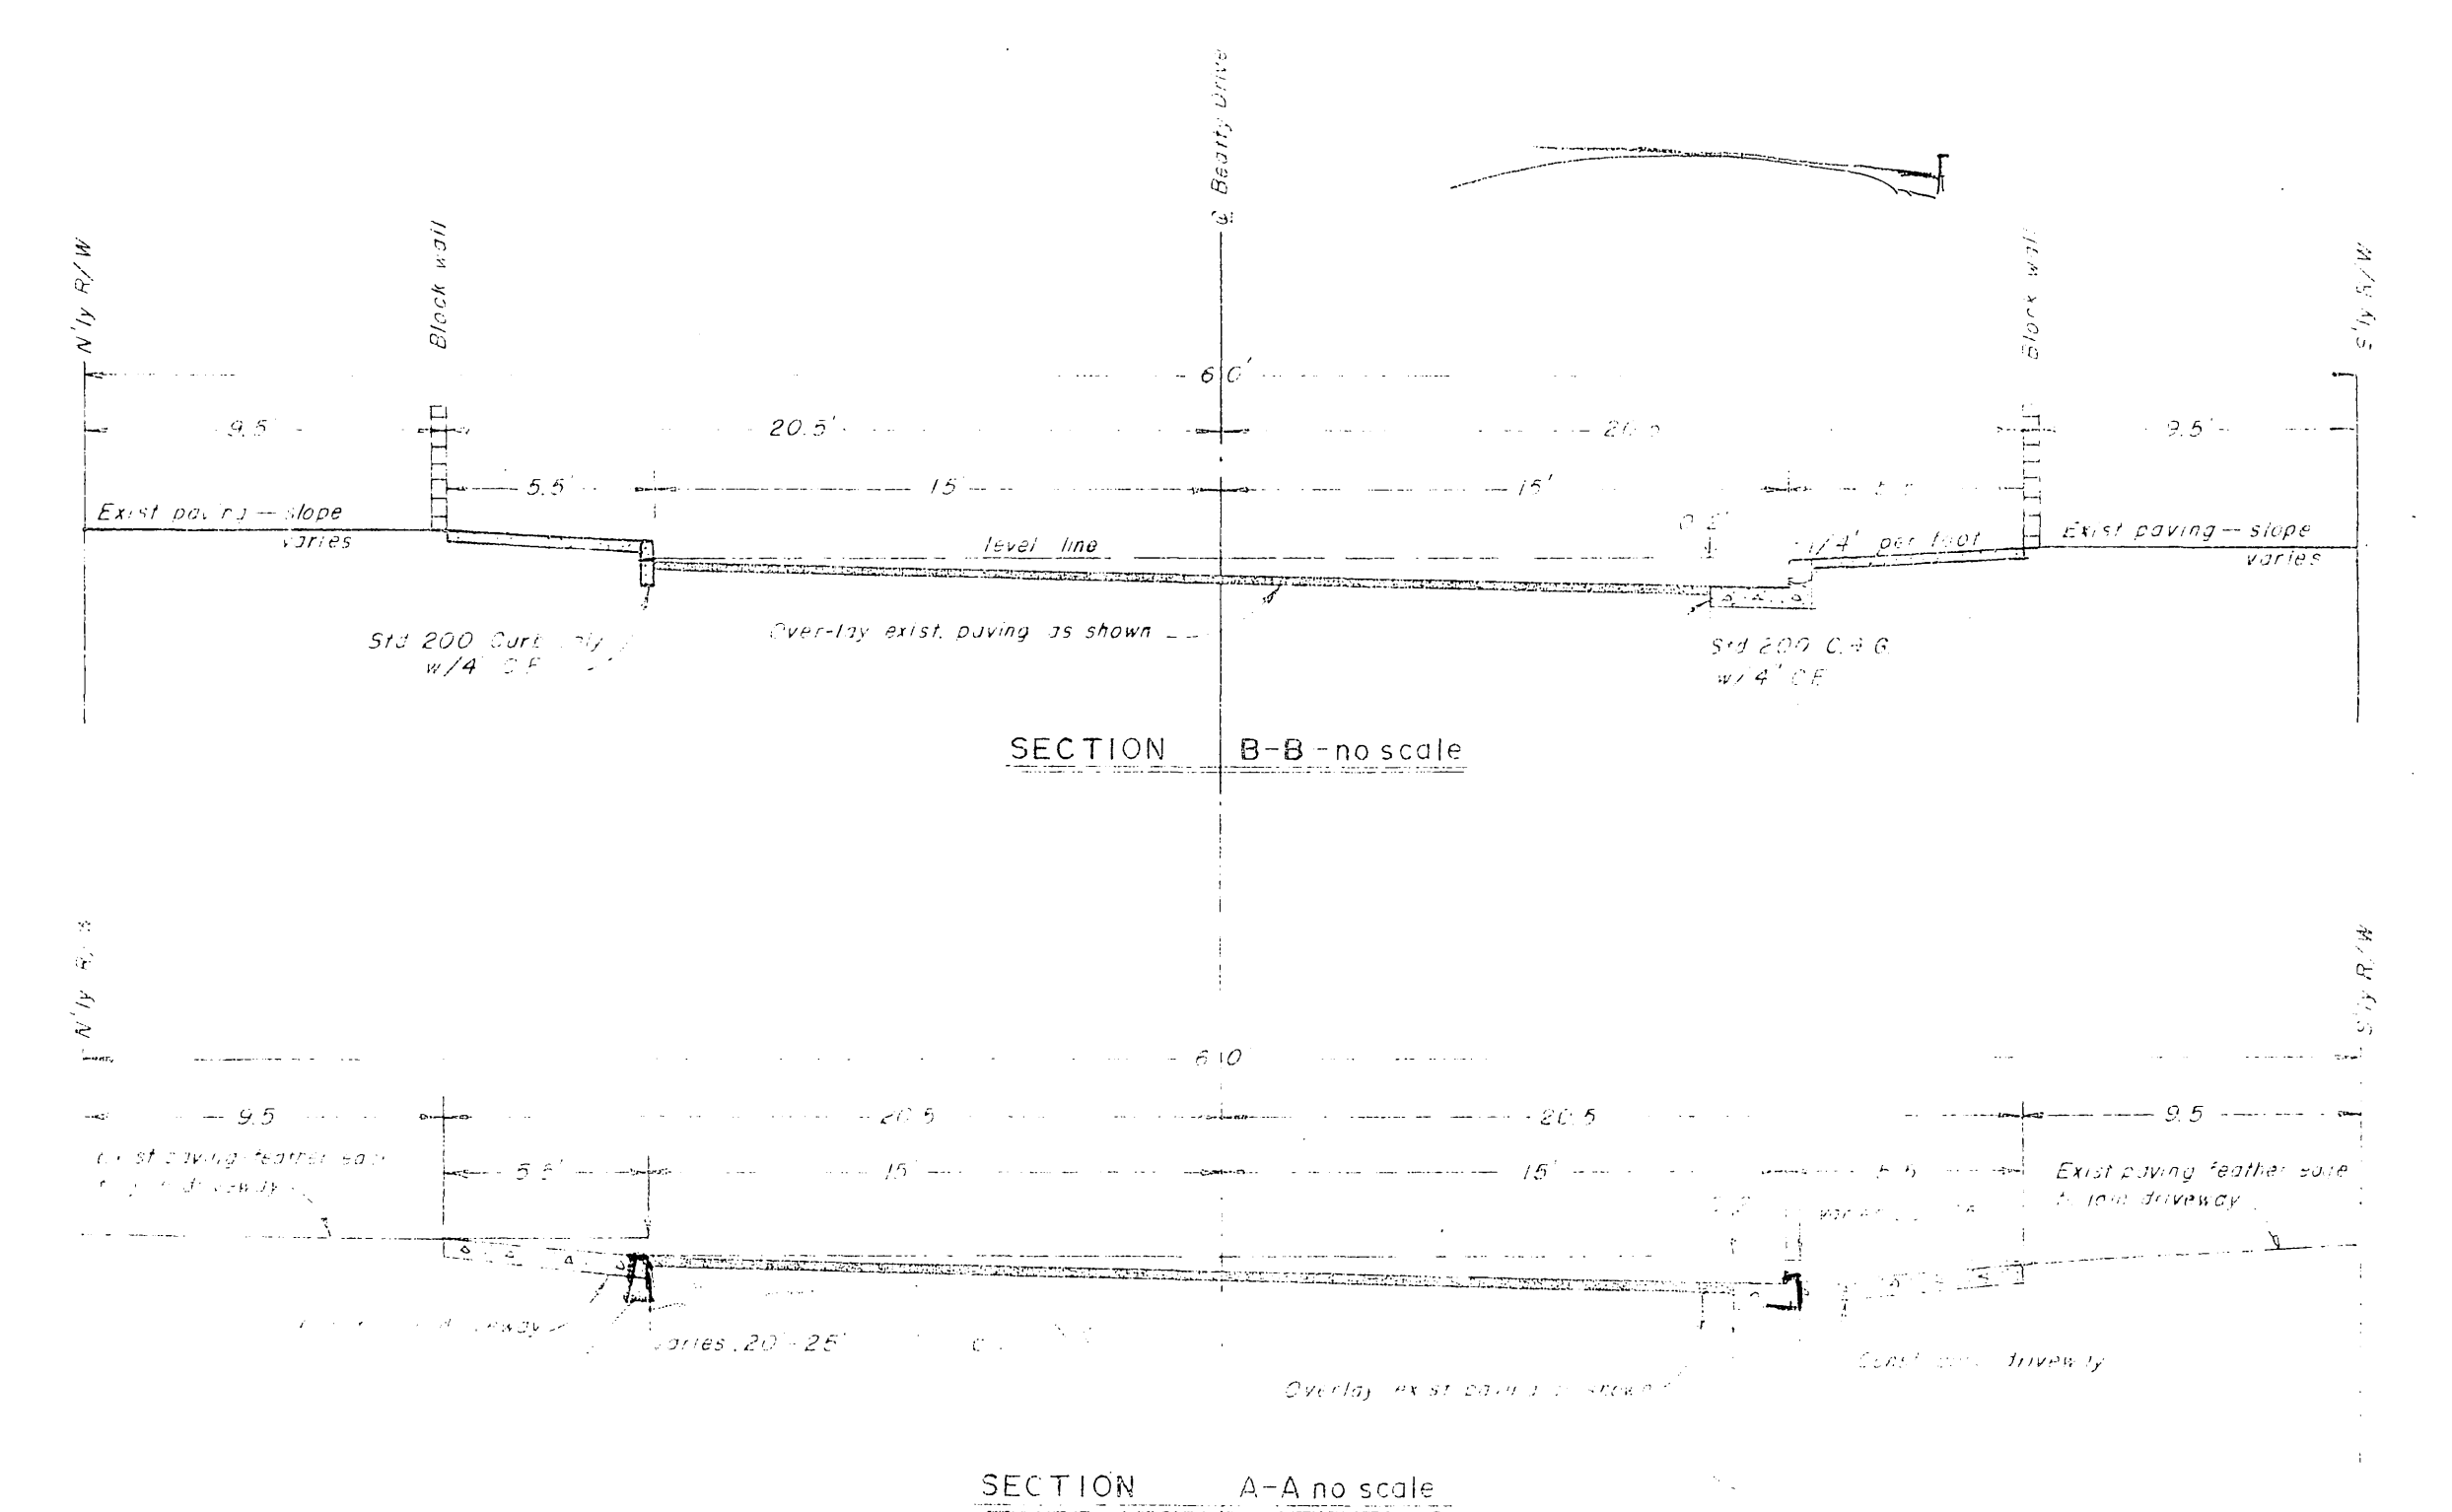

Handwritten note: *Hand-pipe carrying passed into the approaches.*


Handwritten date: *12/26/04*

INDEXED

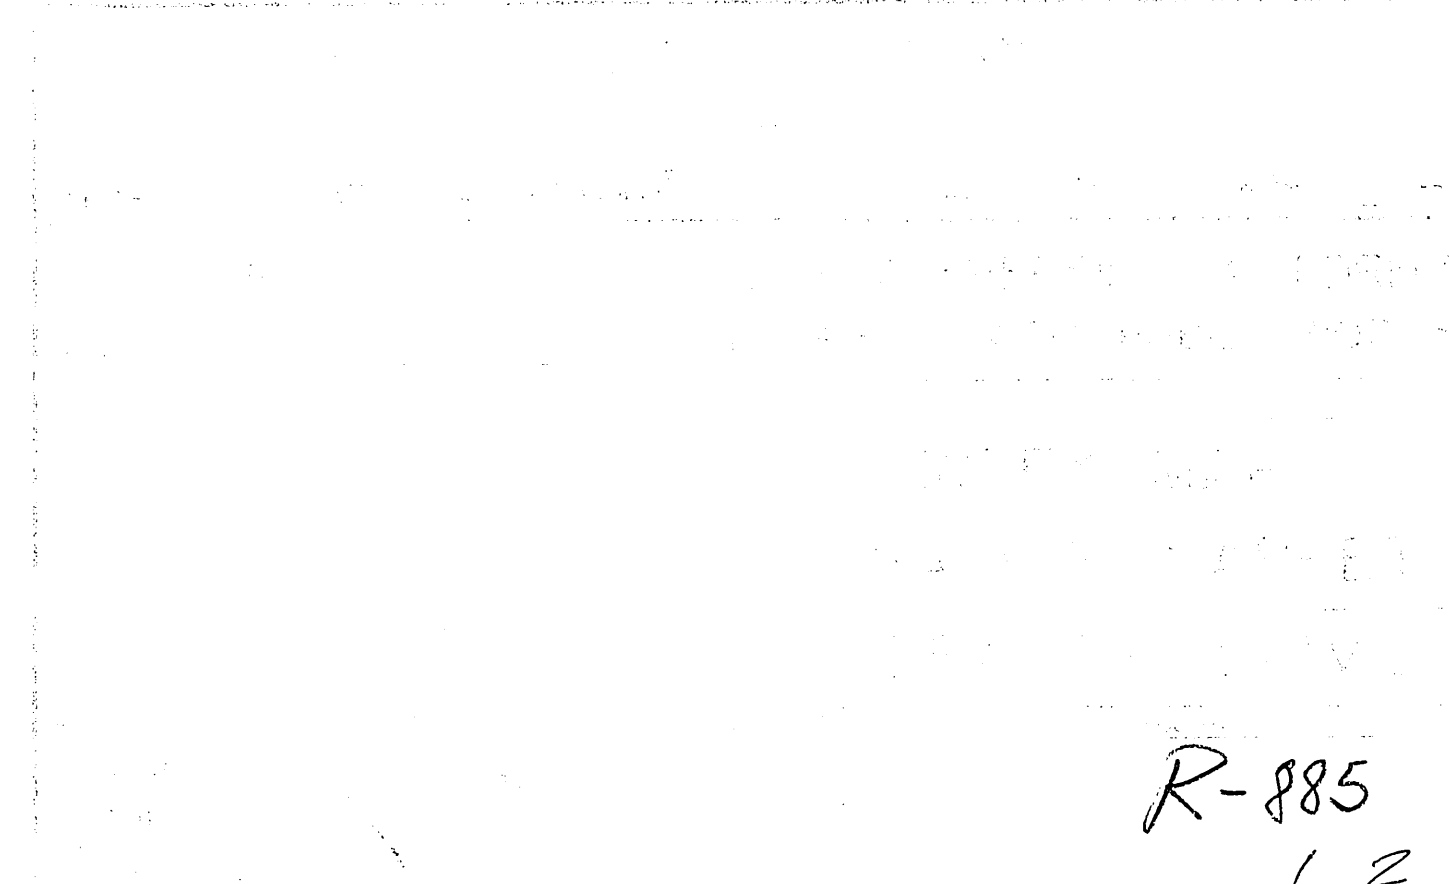


R-885
12
PLAN CHECK SET FOR DPW

Sign
Bar

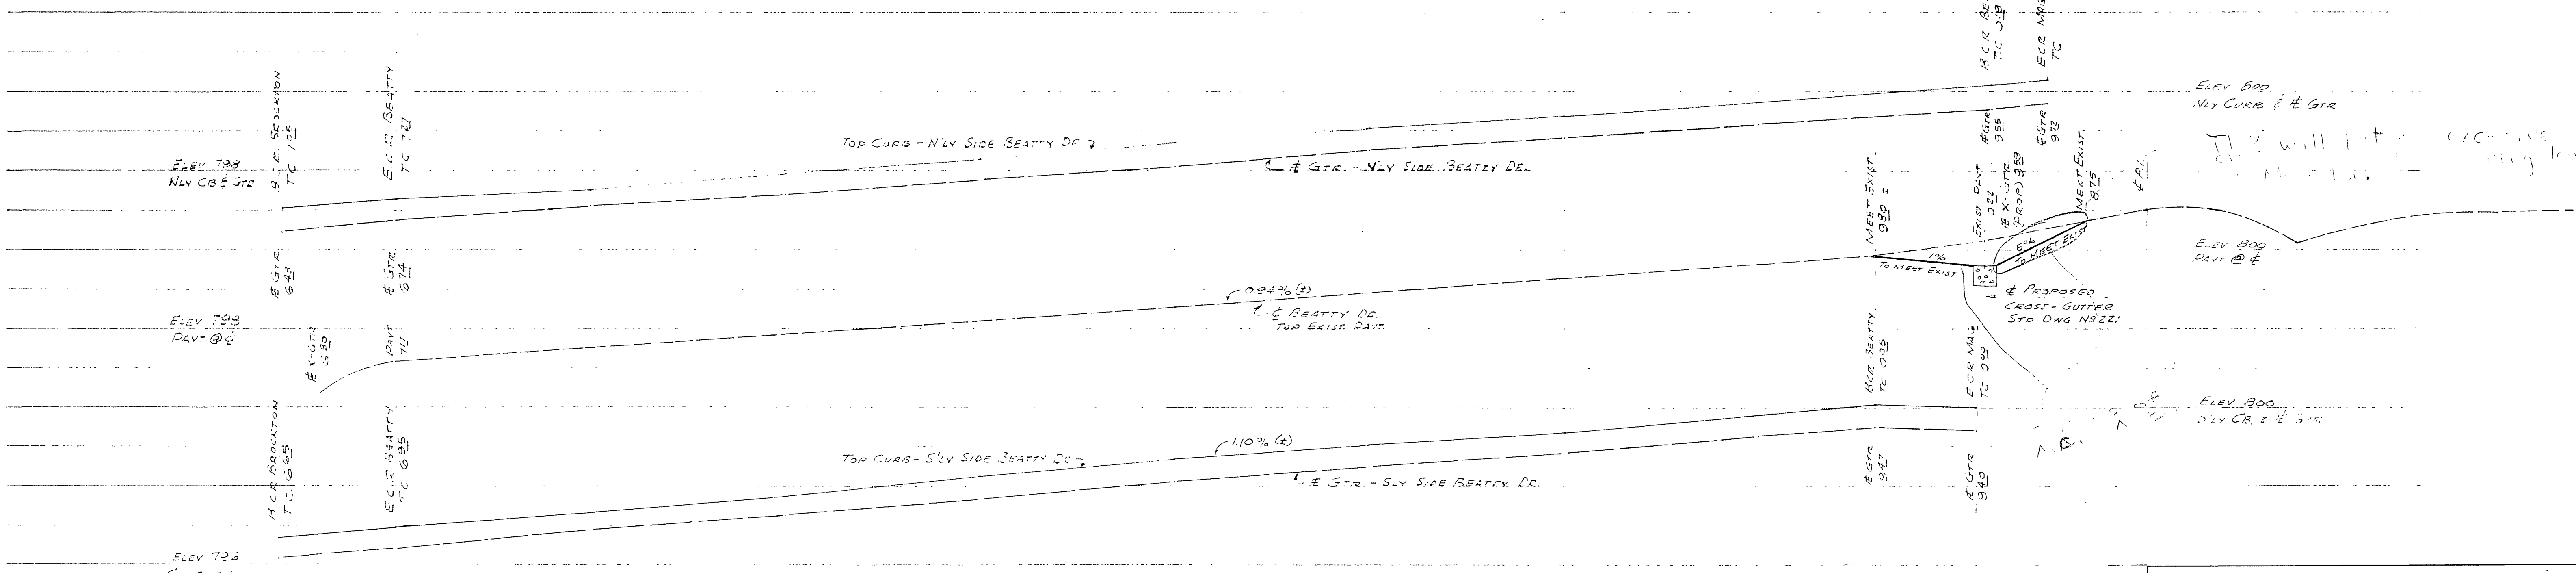

PROFILES

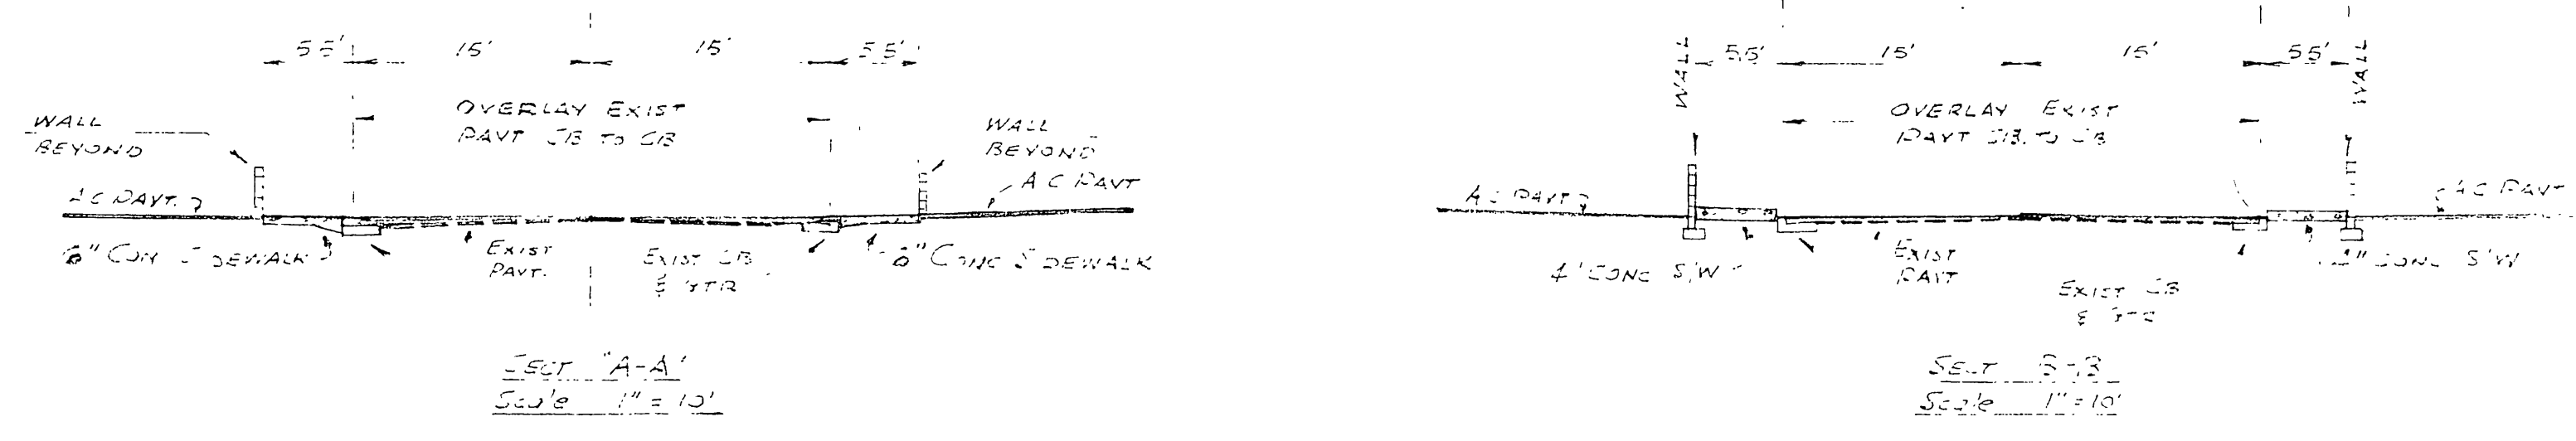



E. L. YEAGER COMPANY
ENGINEERS & CONSTRUCTORS
P. O. Box 87 RIVERSIDE, CALIF.

SAGE'S MARKETS
MAGNOLIA CENTER

| | | |
|------------------------------|----------------|------------------|
| DATE Rev. 4-22-63 3-14-63 | SCALE 1" = 20' | DWG. NO. |
| DRAWN C.F.F. | CHECKED A.M.S. | WORK ORDER 2-172 |
| APPROVED J.S.Y. | FIELD BOOK | SHEET 1 OF 1 |

DRAWINGS, LAYOUTS AND IDEAS SHOWN HEREON ARE THE PROPERTY OF E. L. YEAGER COMPANY AND ARE NOT TO BE REPRODUCED OR USED WITHOUT WRITTEN CONSENT.

1. Provide...
Beatty Dr. ...

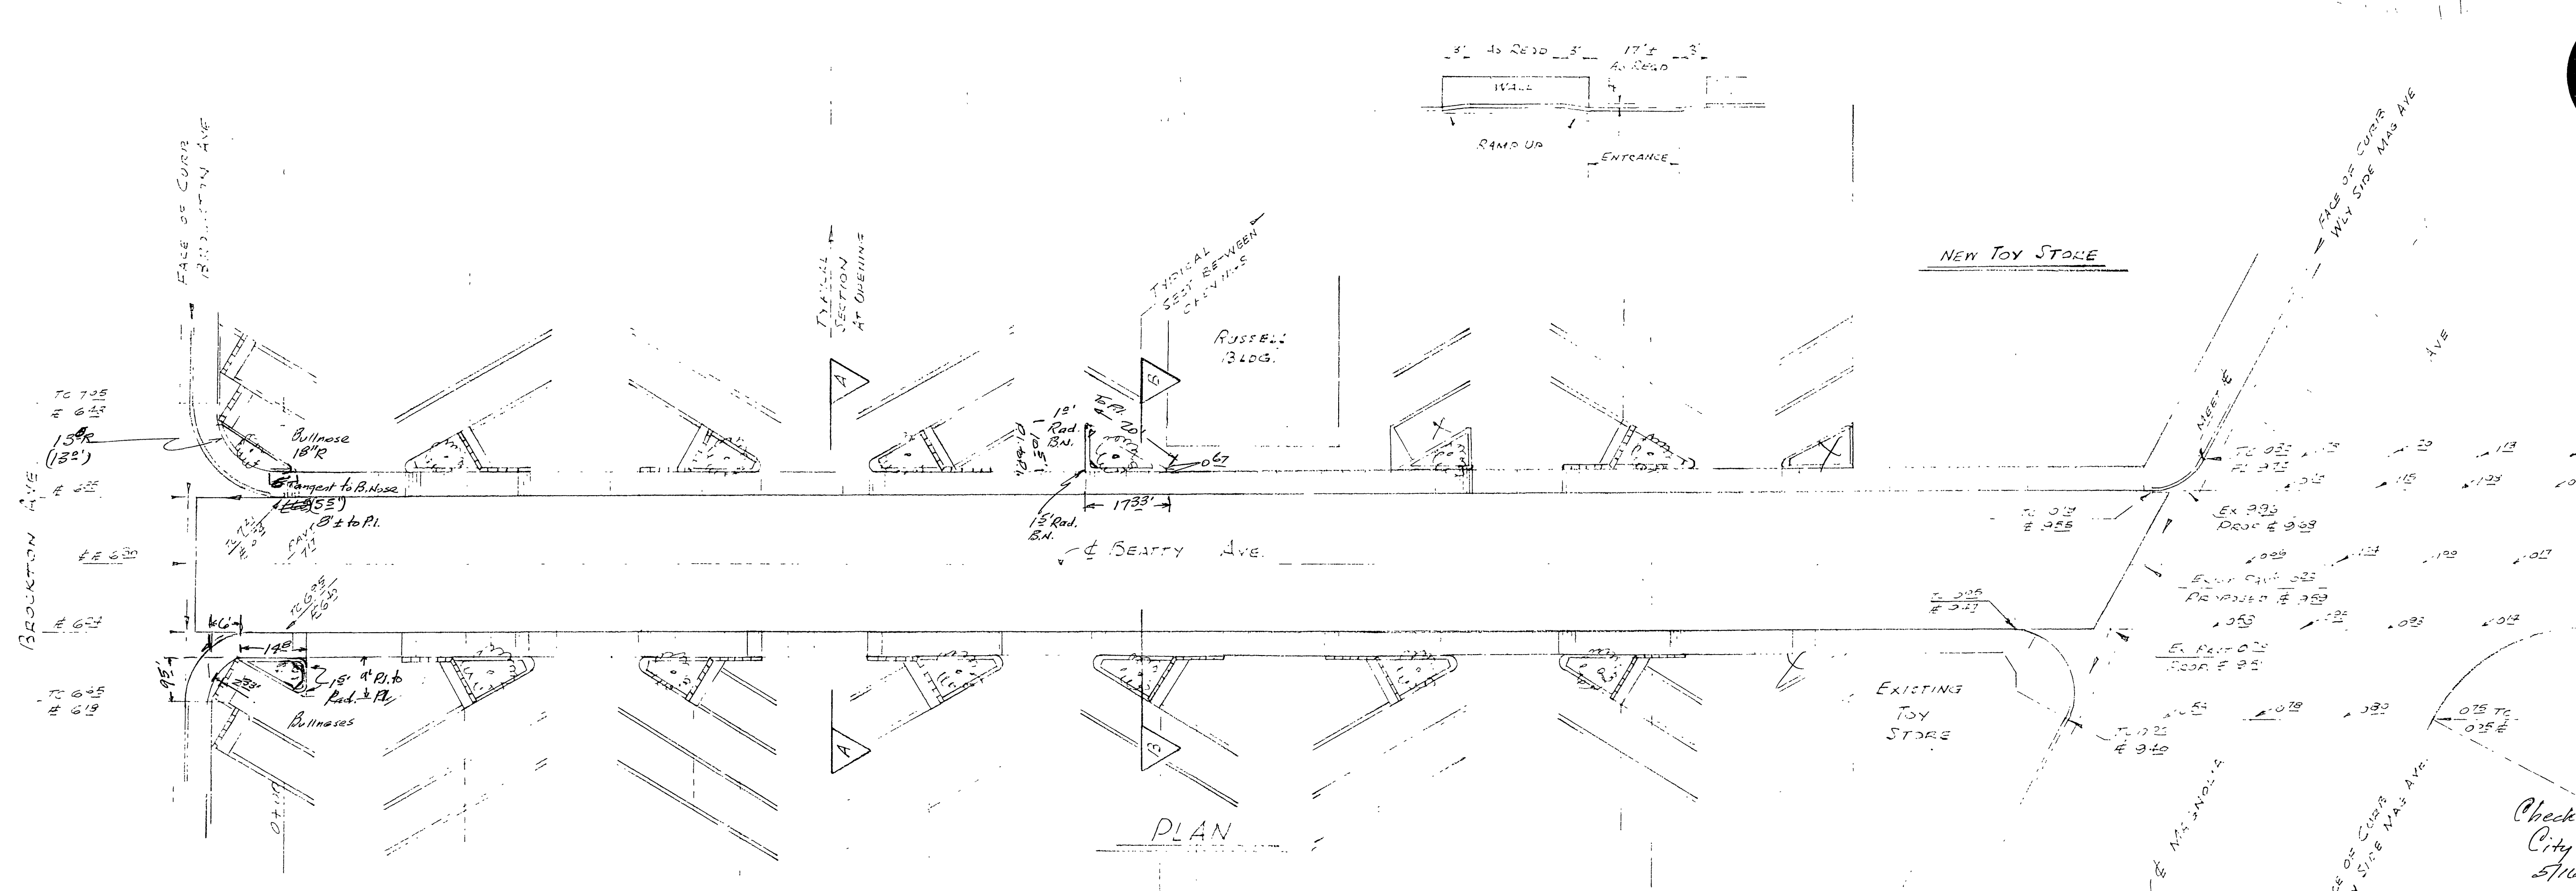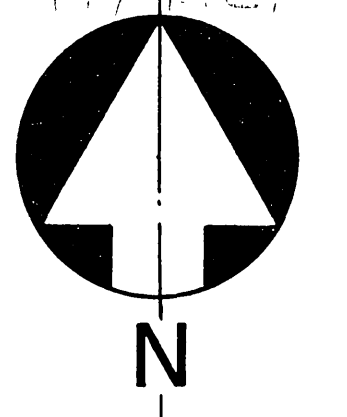

RECEIVED
MAY 31 1963
DEPT. OF PUBLIC WORKS

Check Print for D.P.W.
City of Riverside
Strules. 077 → WDG.

RECEIVED APR 9 1963
R-885

2172