
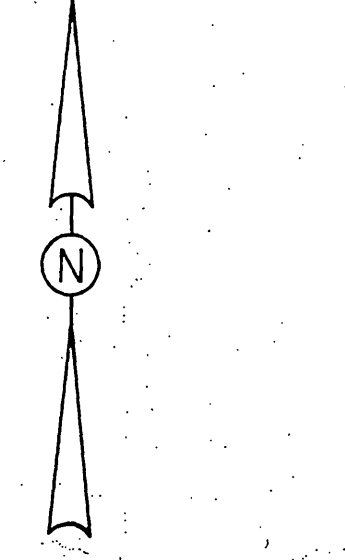
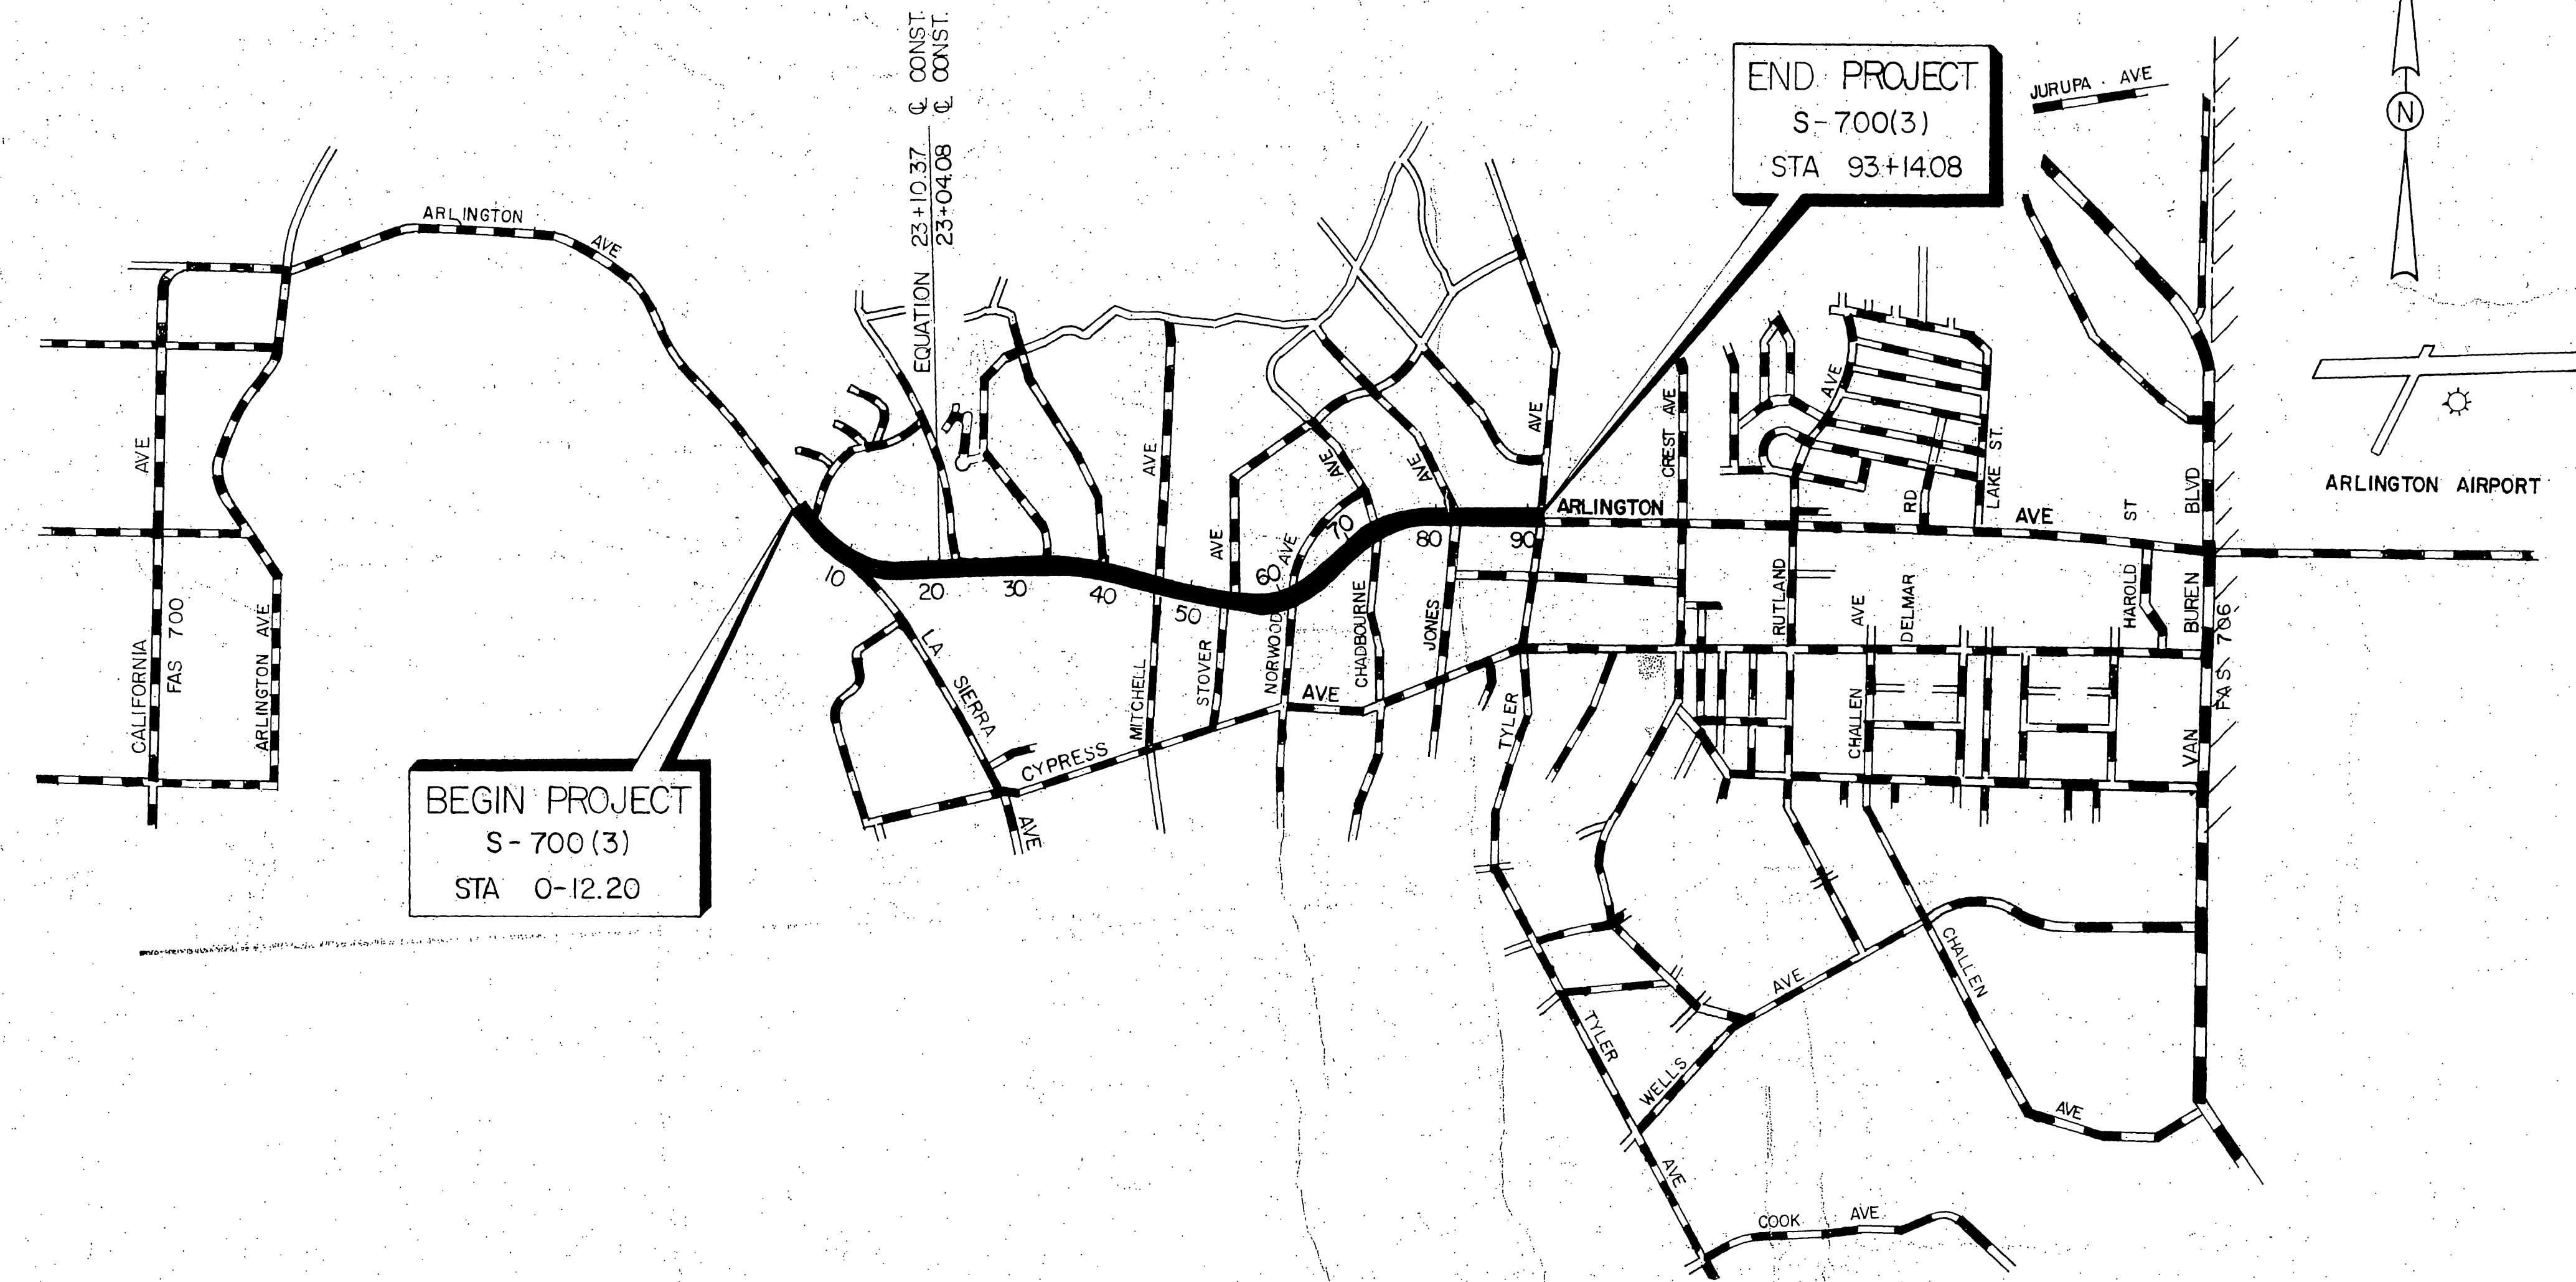


DIST	COUNTY	PROJECT		
VIII	RIV	S-700(3)	1	25

INDEX OF SHEETS

SHEET NO. 1	TITLE PAGE
" 2-3	TYPICAL SECTIONS
" 4-10	PLAN & PROFILE
" 11	PROFILE SHEET
" 12-14	INTERSECTION DETAILS
" 15	DRAINAGE STRUCTURES
" 16	STRUCTURE LIST
" 17-24	STANDARD DETAILS
" 25	FEDERAL CONSTRUCTION IDENTIFICATION SIGNS
" 1-85	CROSS SECTIONS

STATE OF CALIFORNIA
DEPARTMENT OF PUBLIC WORKS
DIVISION OF HIGHWAYS
PLANS FOR CONSTRUCTION ON
RIVERSIDE
COUNTY HIGHWAY
FEDERAL AID SECONDARY PROJECT
NO S-700 (3)
 ARLINGTON AVENUE
 BETWEEN 3.1 MILES AND 1.4 MILES WEST OF RIVERSIDE

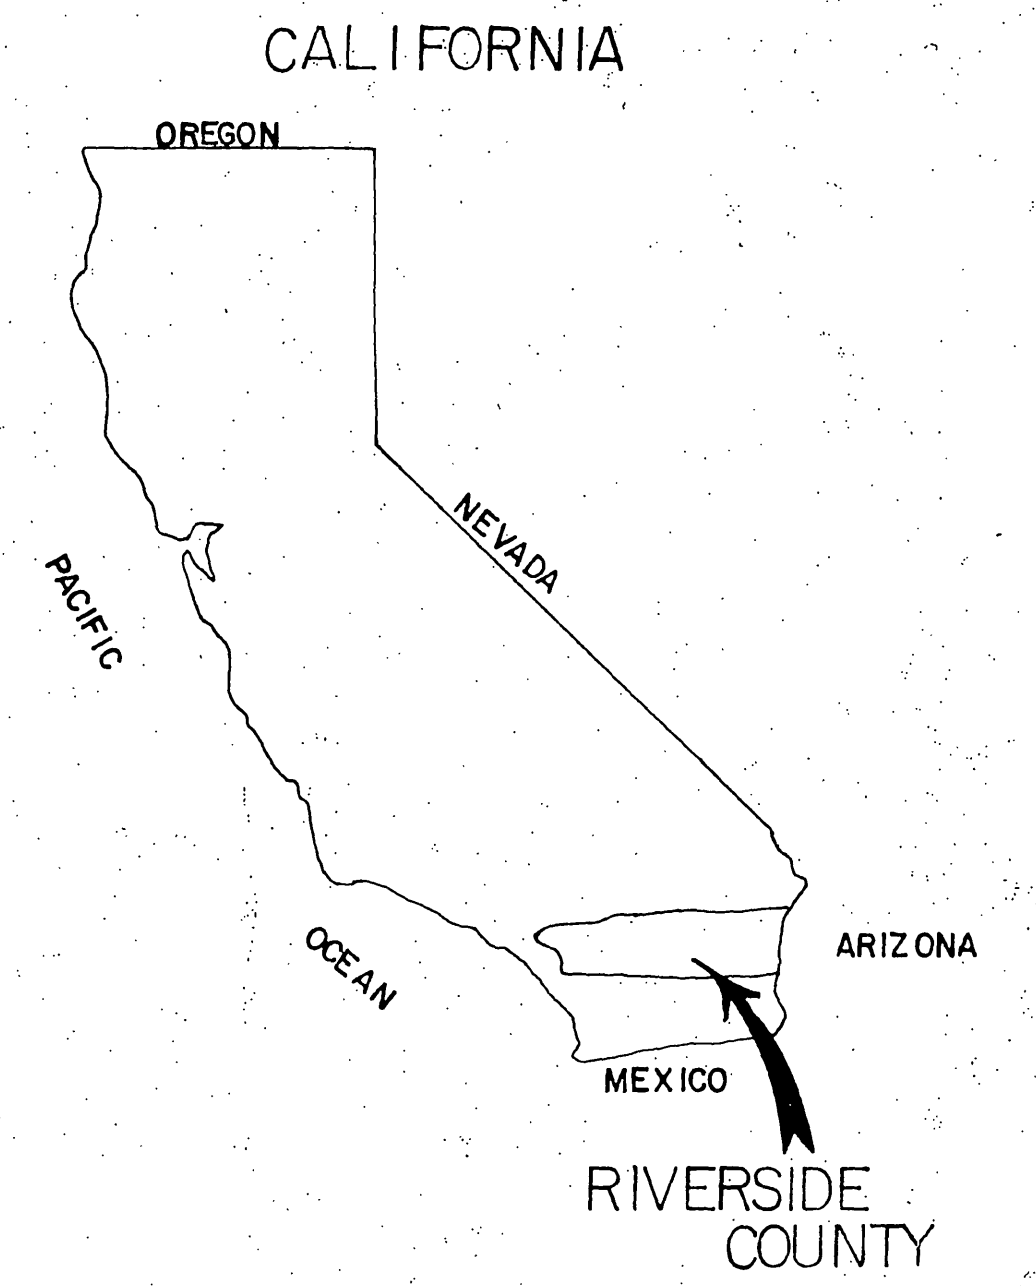

CITY OF RIVERSIDE

BEGIN PROJECT
S-700(3)
STA 0-12.20

END PROJECT
S-700(3)
STA 93+14.08

EQUATION 23+10.37 C. CONST.
23+04.08 C. CONST.

AS BUILT
BY *Norman J. Davis*
NO CORRECTIONS THIS SHEET

COUNTY OF RIVERSIDE

a. c. Keith
ROAD COMMISSIONER

Norman J. Davis
CHAIRMAN BOARD OF SUPERVISORS

STATE OF CALIFORNIA

J. C. Womack
DISTRICT ENGINEER

APPROVED: AUGUST 28, 1961

J. C. Womack
ENGINEER OF FEDERAL SECONDARY ROADS

By: *Tom B. Bate*
STATE HIGHWAY ENGINEER
CIVIL ENGINEER LICENSE NO. 12345

CONVENTIONAL SIGNS


COUNTY LINE	-----	TRAVELED WAY	-----
CITY OR TOWN LIMITS	-----	RAILROAD	-----
TOWNSHIP LINE	-----	LEVEE	-----
SECTION LINE	-----	CULVERTS	-----
GRANT LINE	-----	DROP INLET	-----
FENCE	-----	POWER POLE	-----
GUARD RAIL	-----	POWER TOWER	-----
UNFENCED PROPERTY	-----	TELEGRAPH OR TELEPHONE POLE	-----
RIGHT OF WAY LINE	-----	MARSH	-----
BASE OR SURVEY LINE	-----		

SCALE IN MILES
0 1/2 1
NET LENGTH 1.768 MILES
9332.57 FEET


DIST	COUNTY	ROUTE	SEC	SHEET NO	TOTAL SHEETS
VIII	RIV.	700	(3)	2	25

DESIGN DESIGNATION
 A.D.T. (59) 4700 D=60 %
 A.D.T. (79) 14,000 T=4.7 %
 D.H.V. 2130 V=50


APPROVED August 28, 1961
 DIST. ENG. DIST. VIII
 ENGINEER OF PUBLIC SECONDARY ROADS
 A. C. Keith
 A. C. KEITH COUNTY ROAD COMMISSIONER

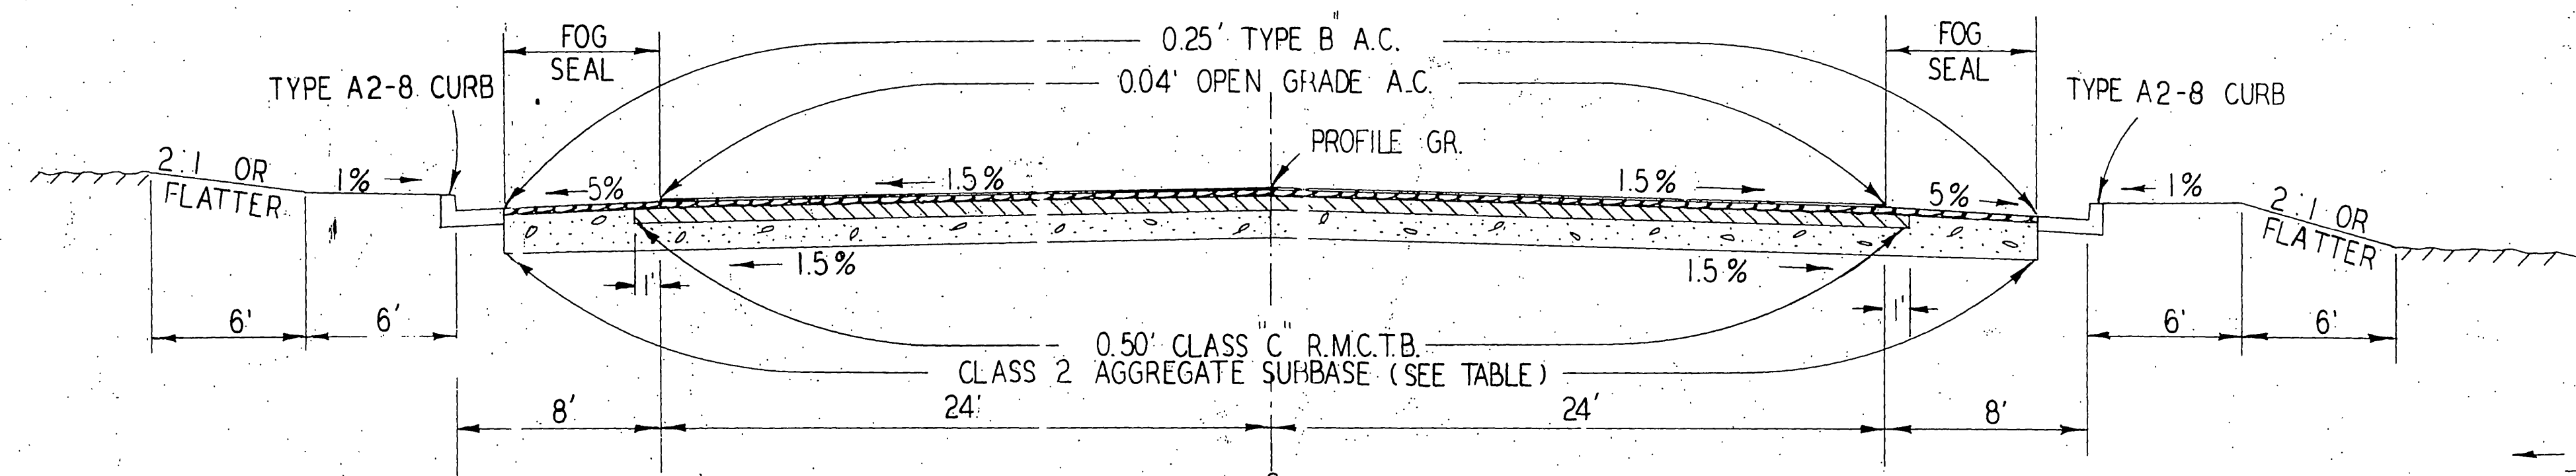


(STA 0-12.20)
 BEGIN OF PROJECT TO STA 8+24.17
 STA 23+04.08 TO END OF PROJECT
 (STA 93+14.08)

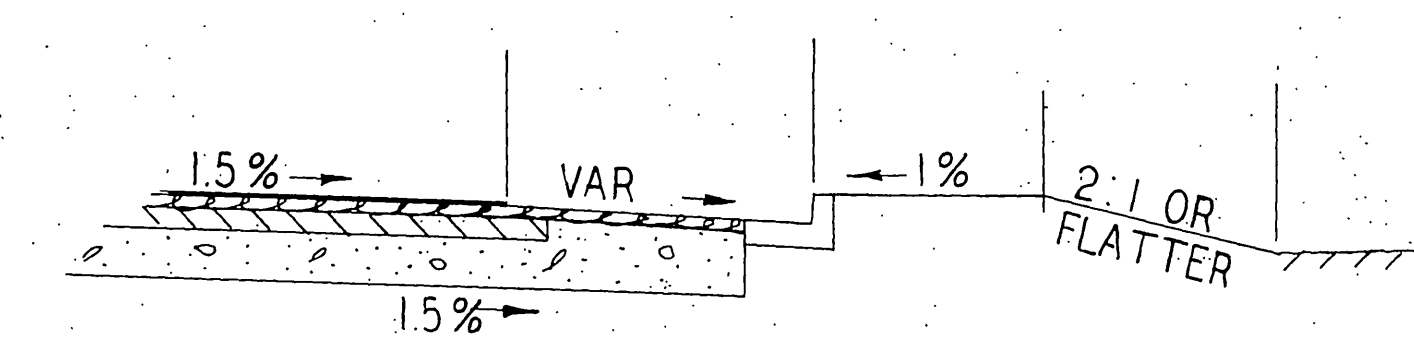


STA 91+40+ TO END OF PROJECT

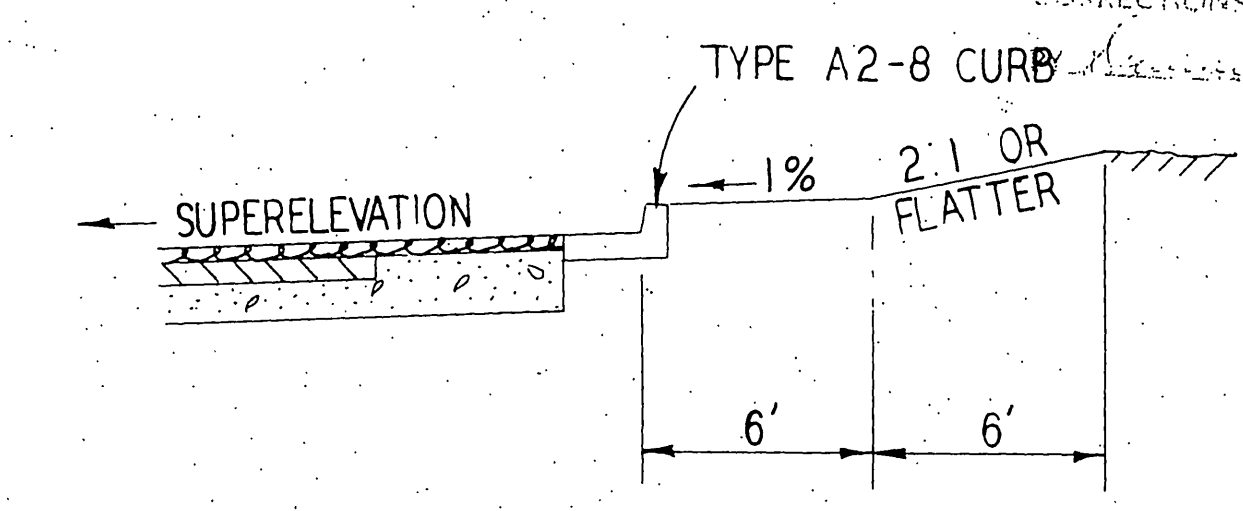


SUPERELEVATION

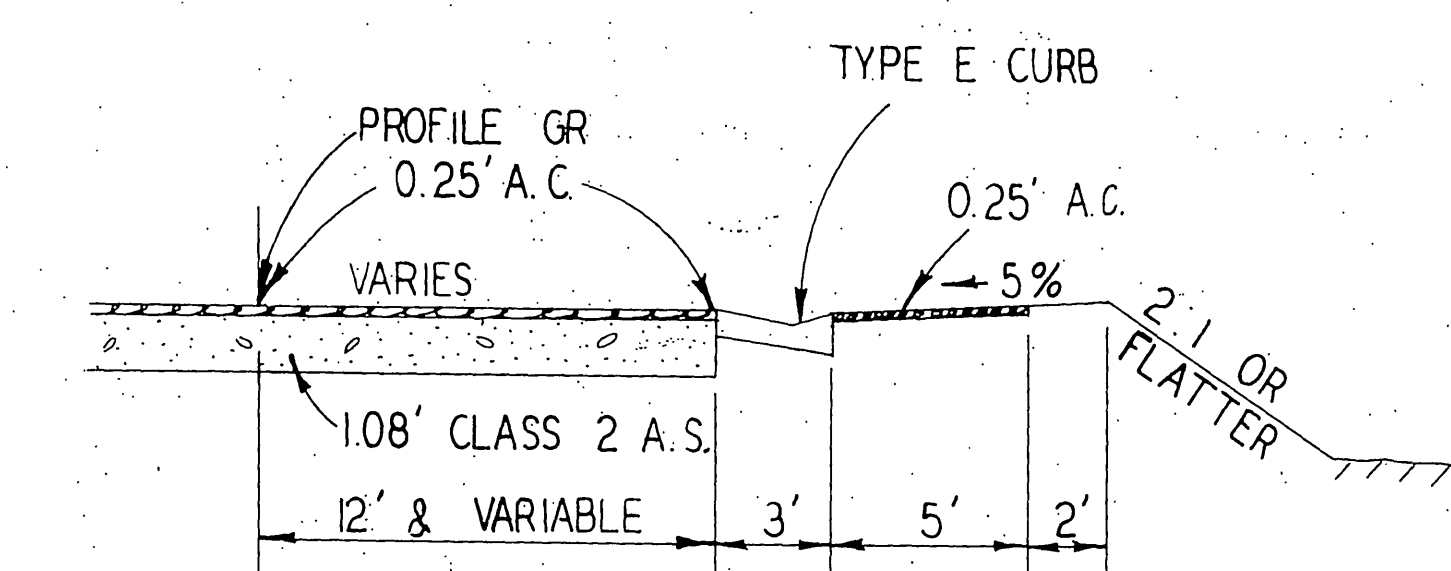


15+41.12 ACCEL TO 20+95.13 ACCEL

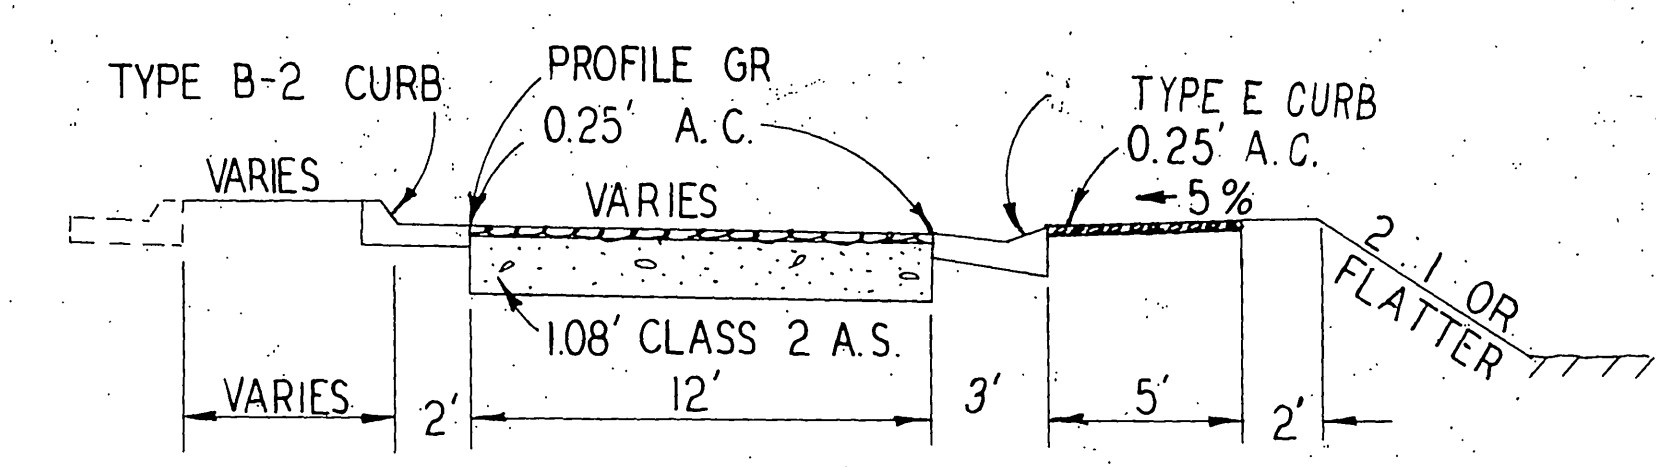

12+47.07 DECEL TO 17+35.07 DECEL

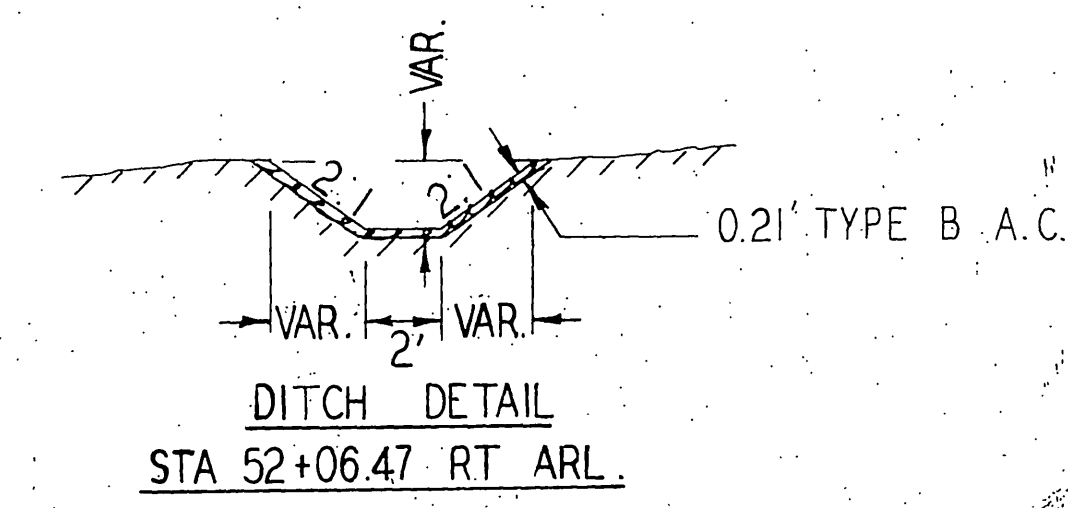

DITCH DETAIL
 STA 52+06.47 RT ARL

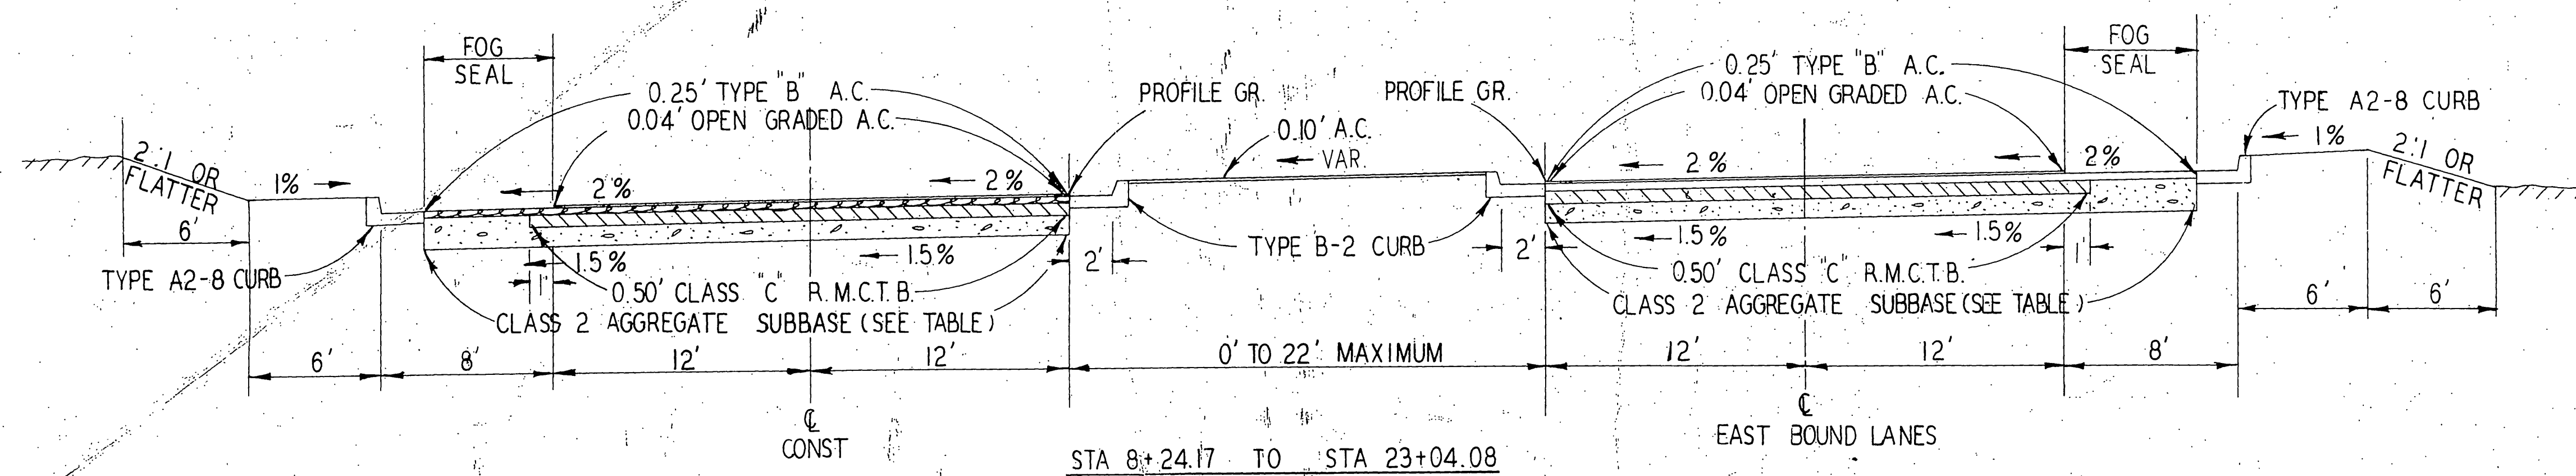

STA 8+24.17 TO STA 23+04.08
 EAST BOUND LANES


AGGREGATE SUBBASE
 (INCLUDES R.M.C.T.B. PORTIONS)

STATION	TO	STATION	THICKNESS
0-12.20		73+00	1.08'
73+00		93+14.08	1.50'
93+14.08		93+14.08	2.25'

DIMENSIONS ARE SUBJECT TO TOLERANCES SPECIFIED IN THE STANDARD SPECIFICATIONS

- LEGEND
- ASPHALT CONC. (A.C.)
 - OPEN GRADED ASPHALT OVER TYPE A, B, OR C ASPHALT CONC. (OP. GR. A.C.)
 - AGGREGATE SUBBASE
 - ORIGINAL GRD.
 - ROAD-MIXED CEMENT TREATED BASE





VIII-RIV-700(3)
TYPICAL ROAD SECTIONS
ARLINGTON AVENUE
 SCALE 1"=5'

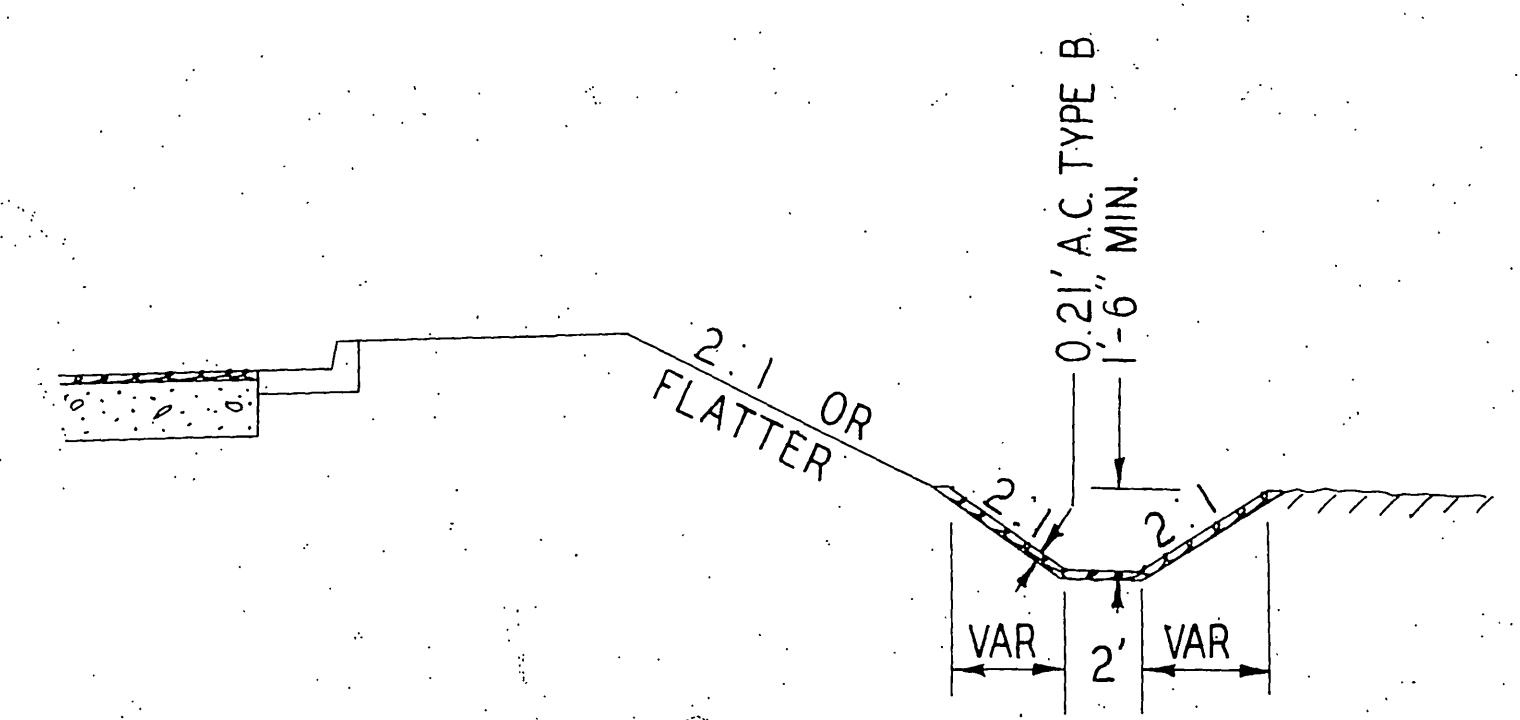

DITCH DETAIL
 0-12.20 TO 12+47.07 ARLINGTON RT.
 12+47.07 TO 16+35.44 DECEL. LANE RT.
 6+00 TO 7+10 LA SIERRA LT.
 7+26 TO 7+99.02 LA SIERRA LT.

APPROVED *August 28, 1961*
R. B. Stone
 ENGINEER OF FEDERAL SECONDARY ROADS
a. c. Keith
 A. C. KEITH COUNTY ROAD COMMISSIONER


AS BUILT
 BY *R. B. Stone*
 NO CORRECTIONS THIS SHEET

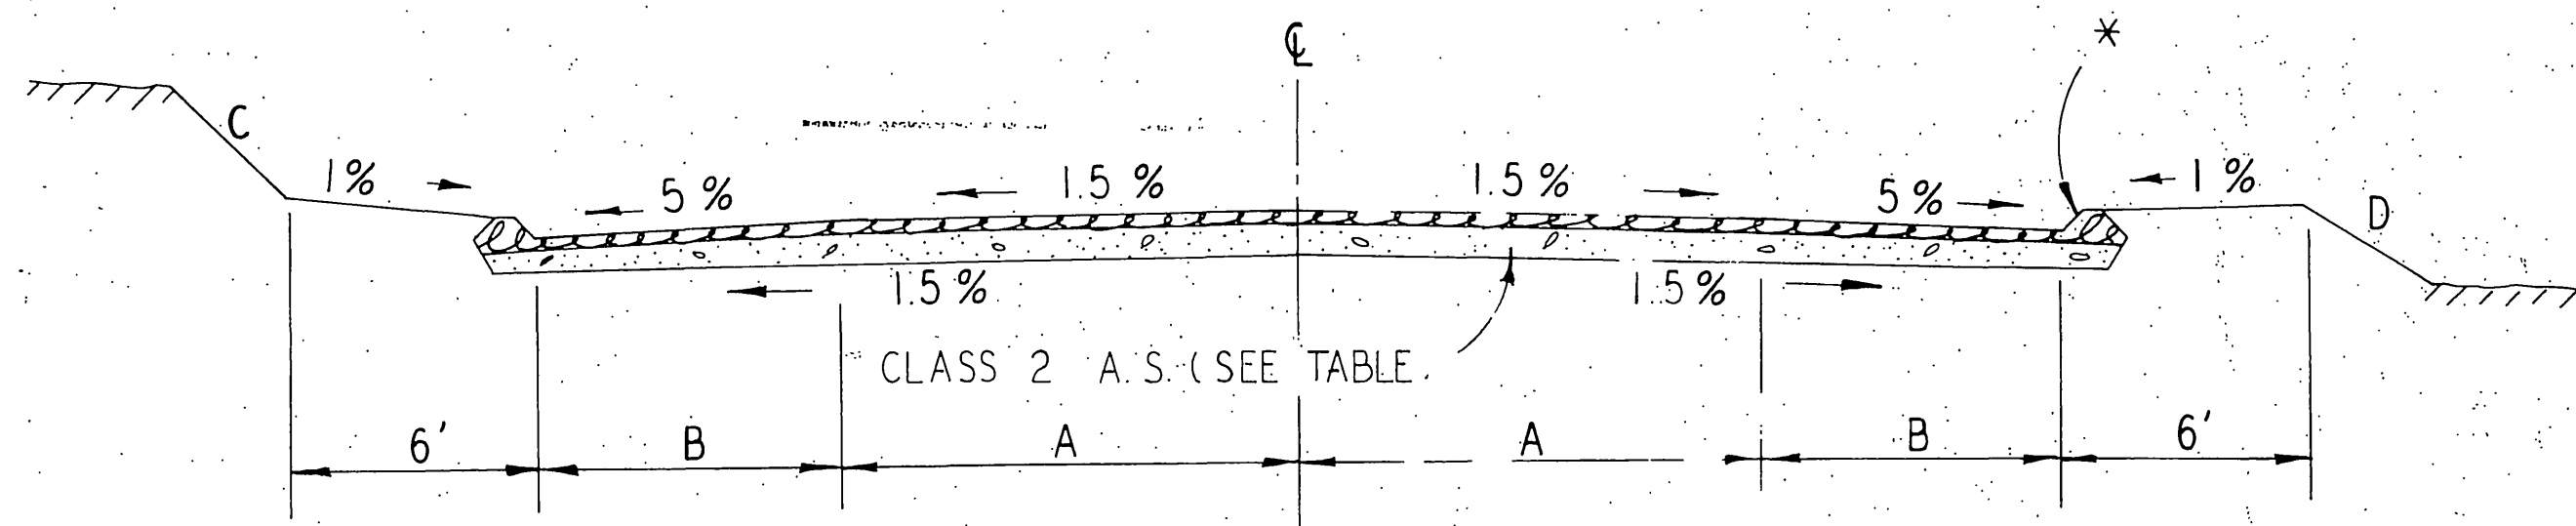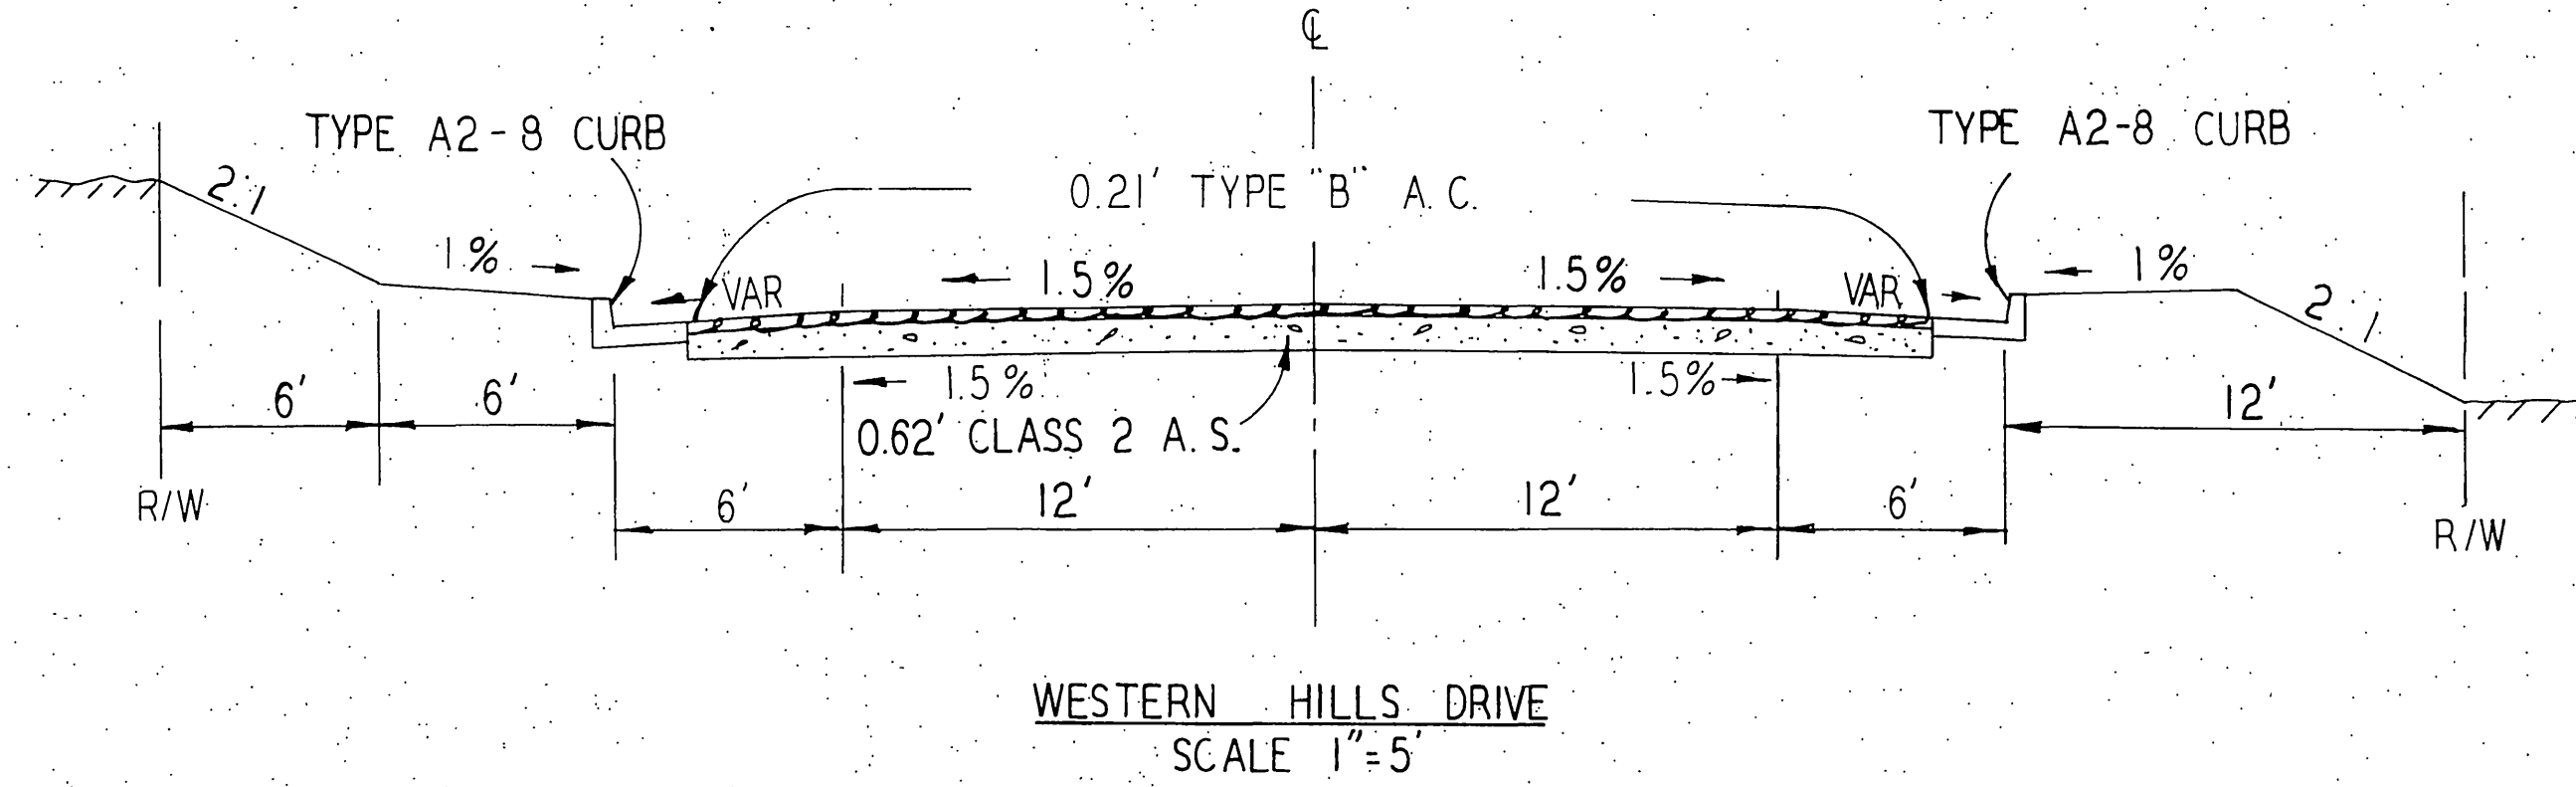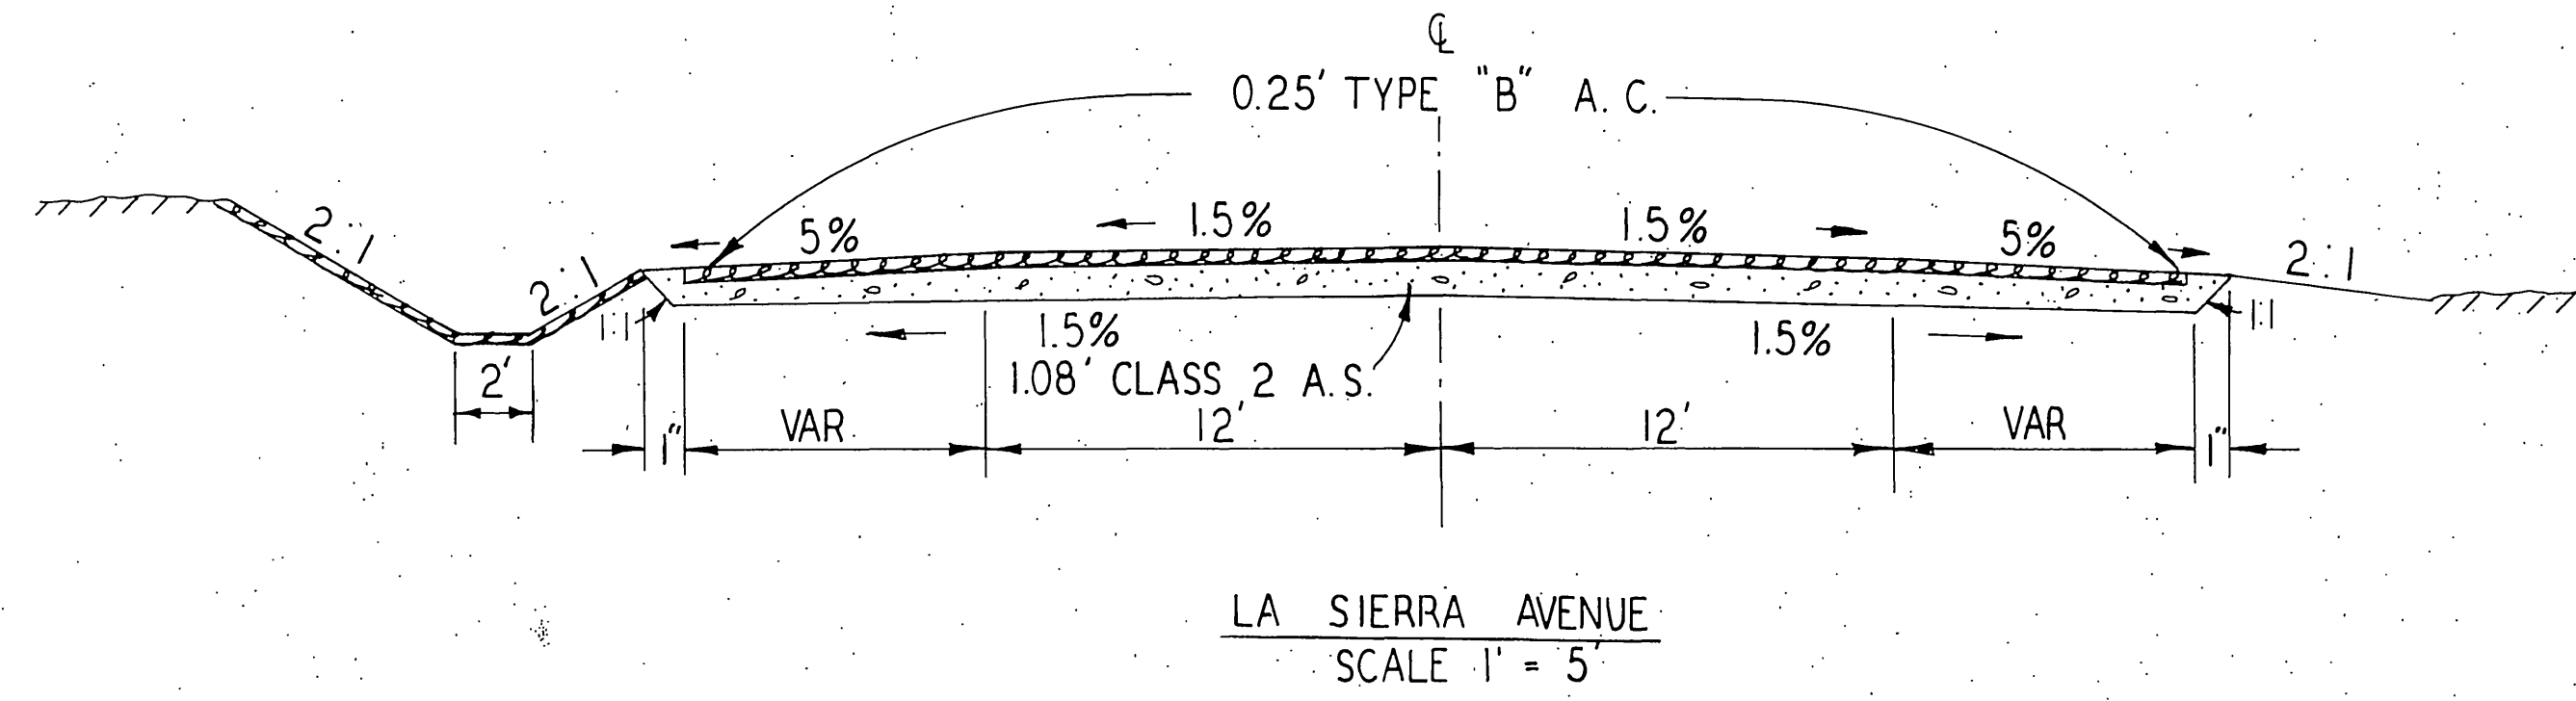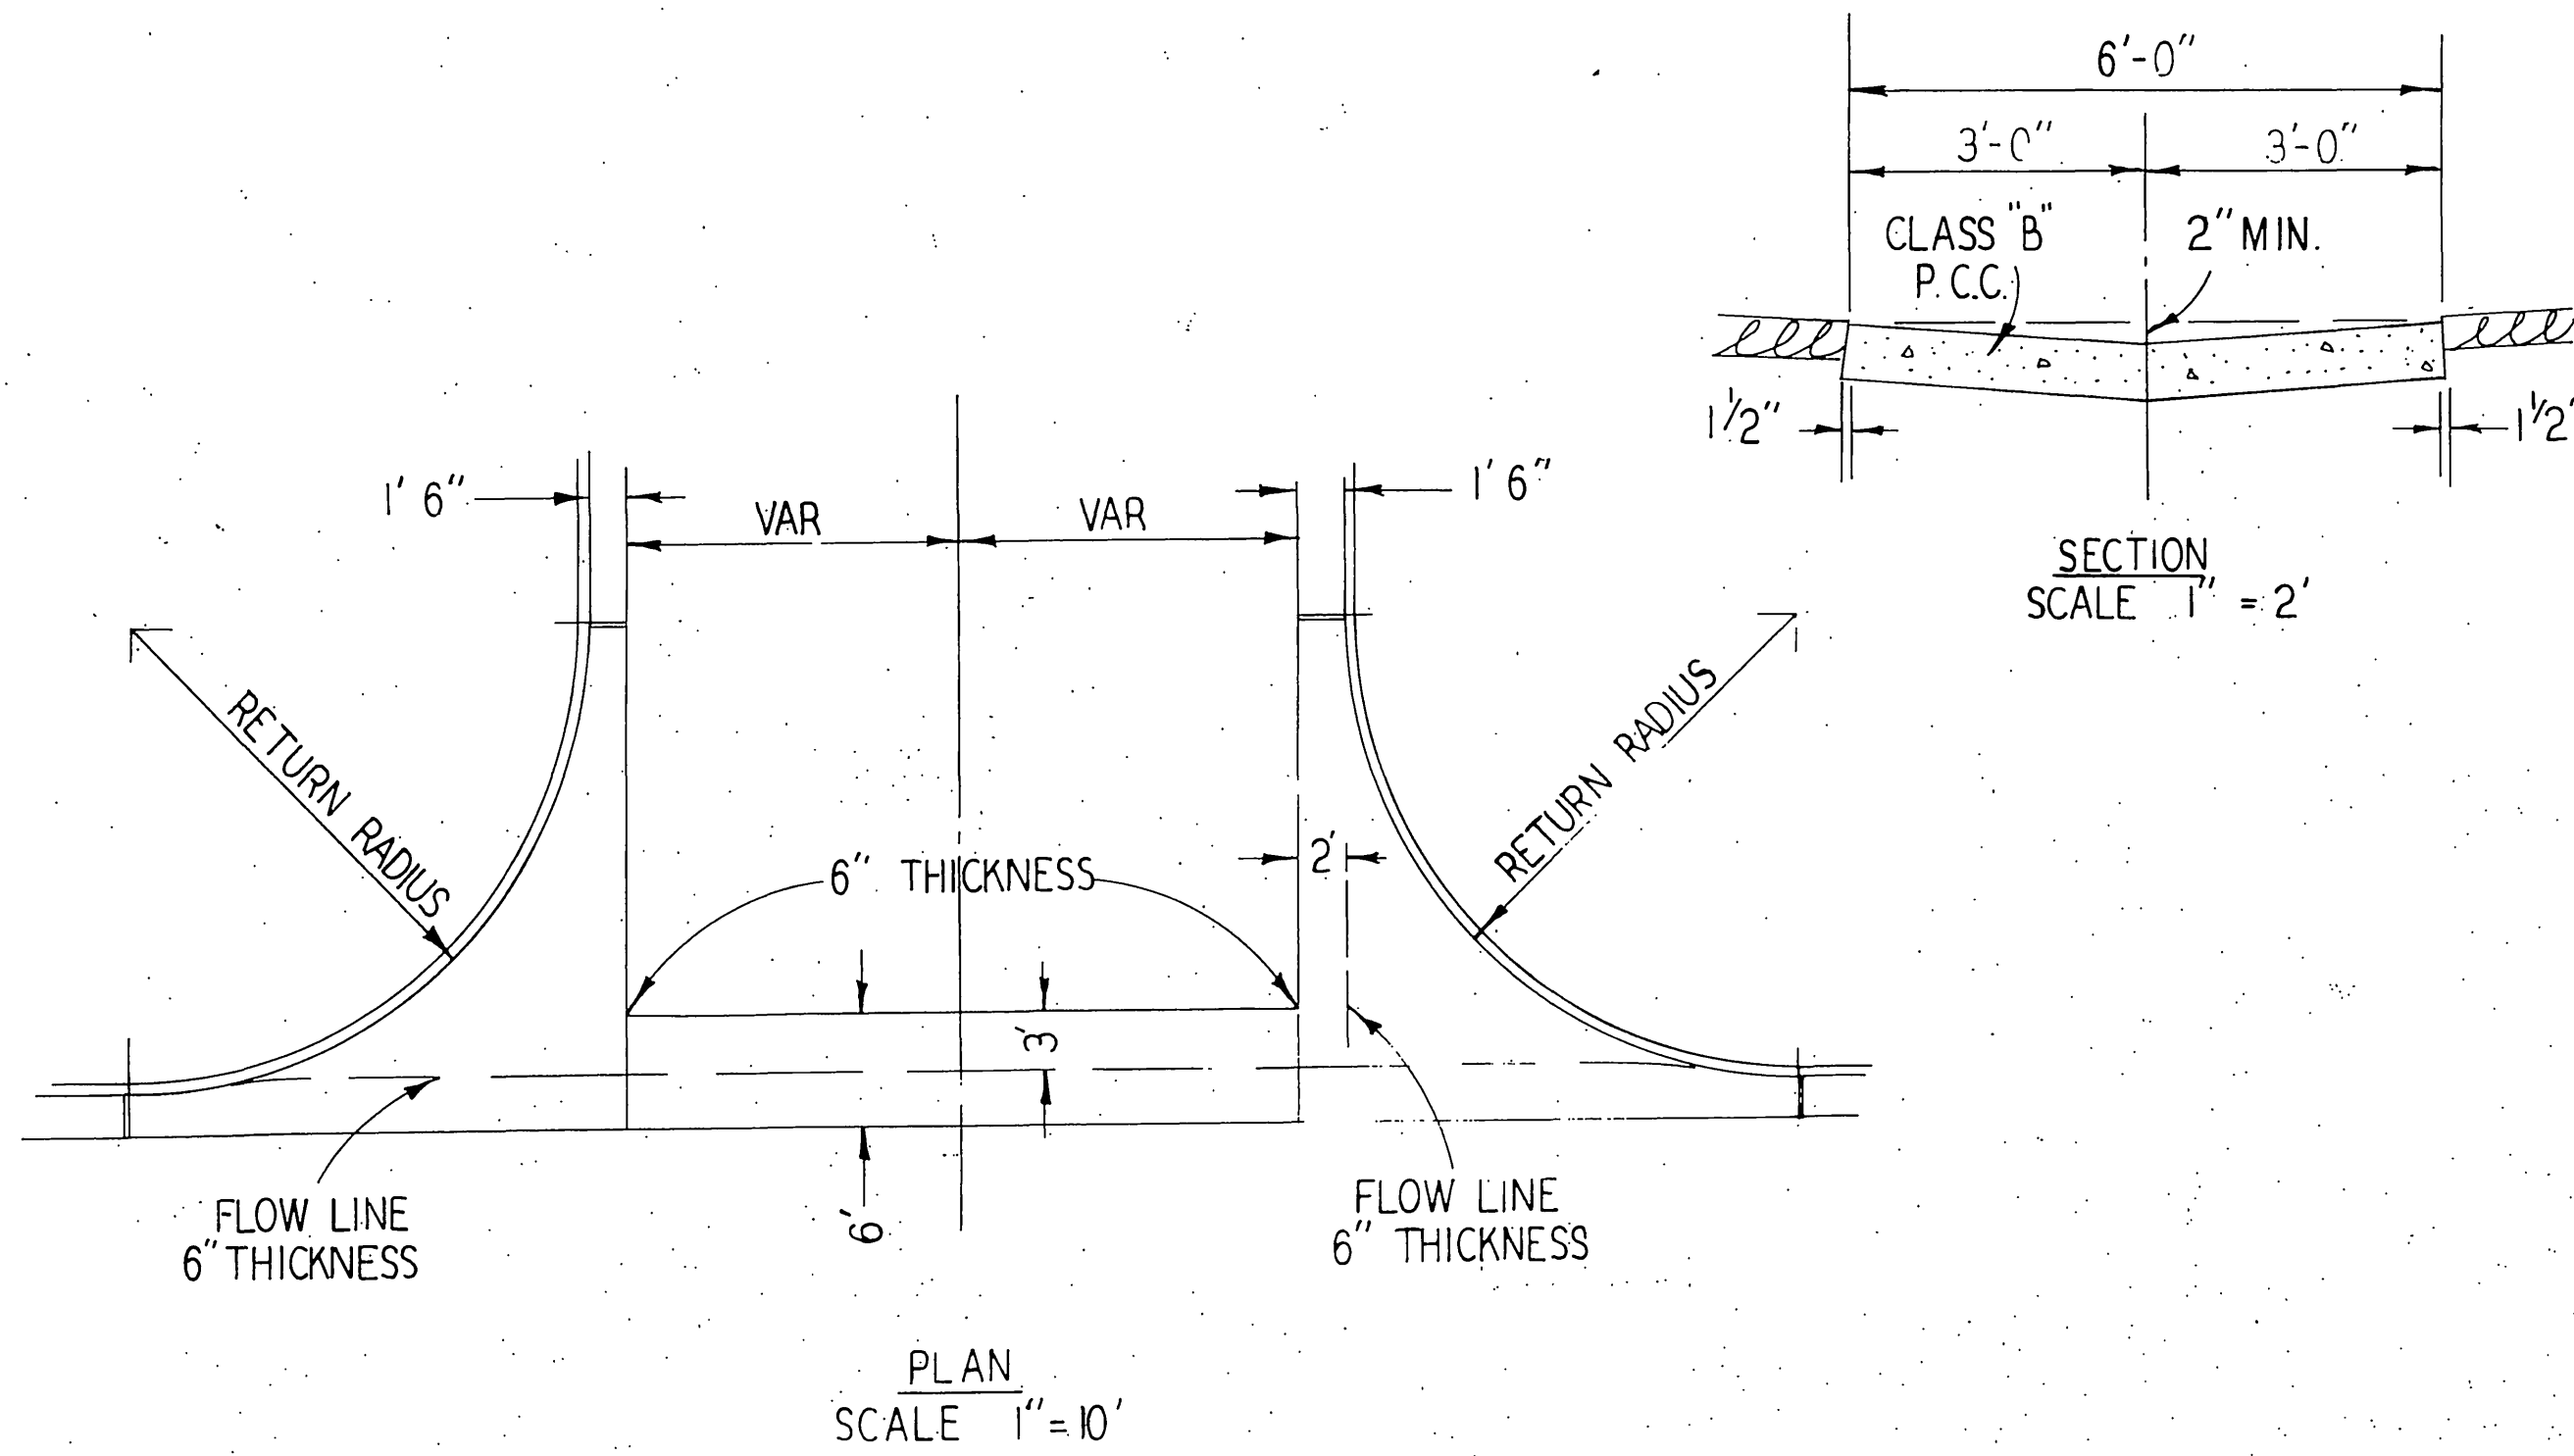

STREET	A	B	PVT	A.S.	C	D
WESTERN AVE	12'	6'	0.21'	0.83'	2:1	2:1
VALLEY DRIVE	12'	6'	0.21'	0.87'	2:1	2:1
SANDY LANE	12'	10'	0.25'	1.08'	2:1	2:1
MITCHELL AVE NLY	12'	8'	0.21'	0.71'	2:1	2:1
MITCHELL AVE SLY	12'	10'	0.21'	0.71'	2:1	2:1
STOVER AVE NLY	12'	6'	0.21'	0.62'	1:1	2:1
STOVER AVE SLY	12'	6'	0.21'	0.62'	1:1	2:1
NORWOOD AVE NLY	12'	6'	0.21'	0.54'	1:1	2:1
NORWOOD AVE SLY	12'	6'	0.21'	0.54'	1:1	2:1
CHADBOURNE AVE NLY	12'	6'	0.21'	1.12'	1:1	2:1
CHADBOURNE AVE SLY	12'	6'	0.21'	1.12'	1:1	2:1
JONES AVE NLY	12'	6'	0.21'	1.04'	1:1	2:1
JONES AVE SLY	12'	10'	0.21'	1.04'	1:1	2:1

NOTE: DIMENSIONS ARE SUBJECT TO TOLERANCES SPECIFIED IN THE STANDARD SPECIFICATIONS

NOTES
 DELINEATORS TO BE SINGLE UNIT 3" DIA. RED STIMSONITE IN ALUMINUM MOUNTS, OR 5" SQUARE RED SCOTCHLITE ON ALUMINUM SHEET; AS DIRECTED BY THE ENGINEER. A W 21 R 9 LIGHT CLUSTER SHALL BE FURNISHED AND MOUNTED ON CENTERLINE POST OVER THE RAIL MEMBER. RAIL TIMBER TO BE NO. 1 D.F. S4S AND TO RECEIVE TWO (2) COATS OUTSIDE WHITE PAINT - POSTS REWOOD S4S.
 SET POST 1'-6" MIN. IN GRD.

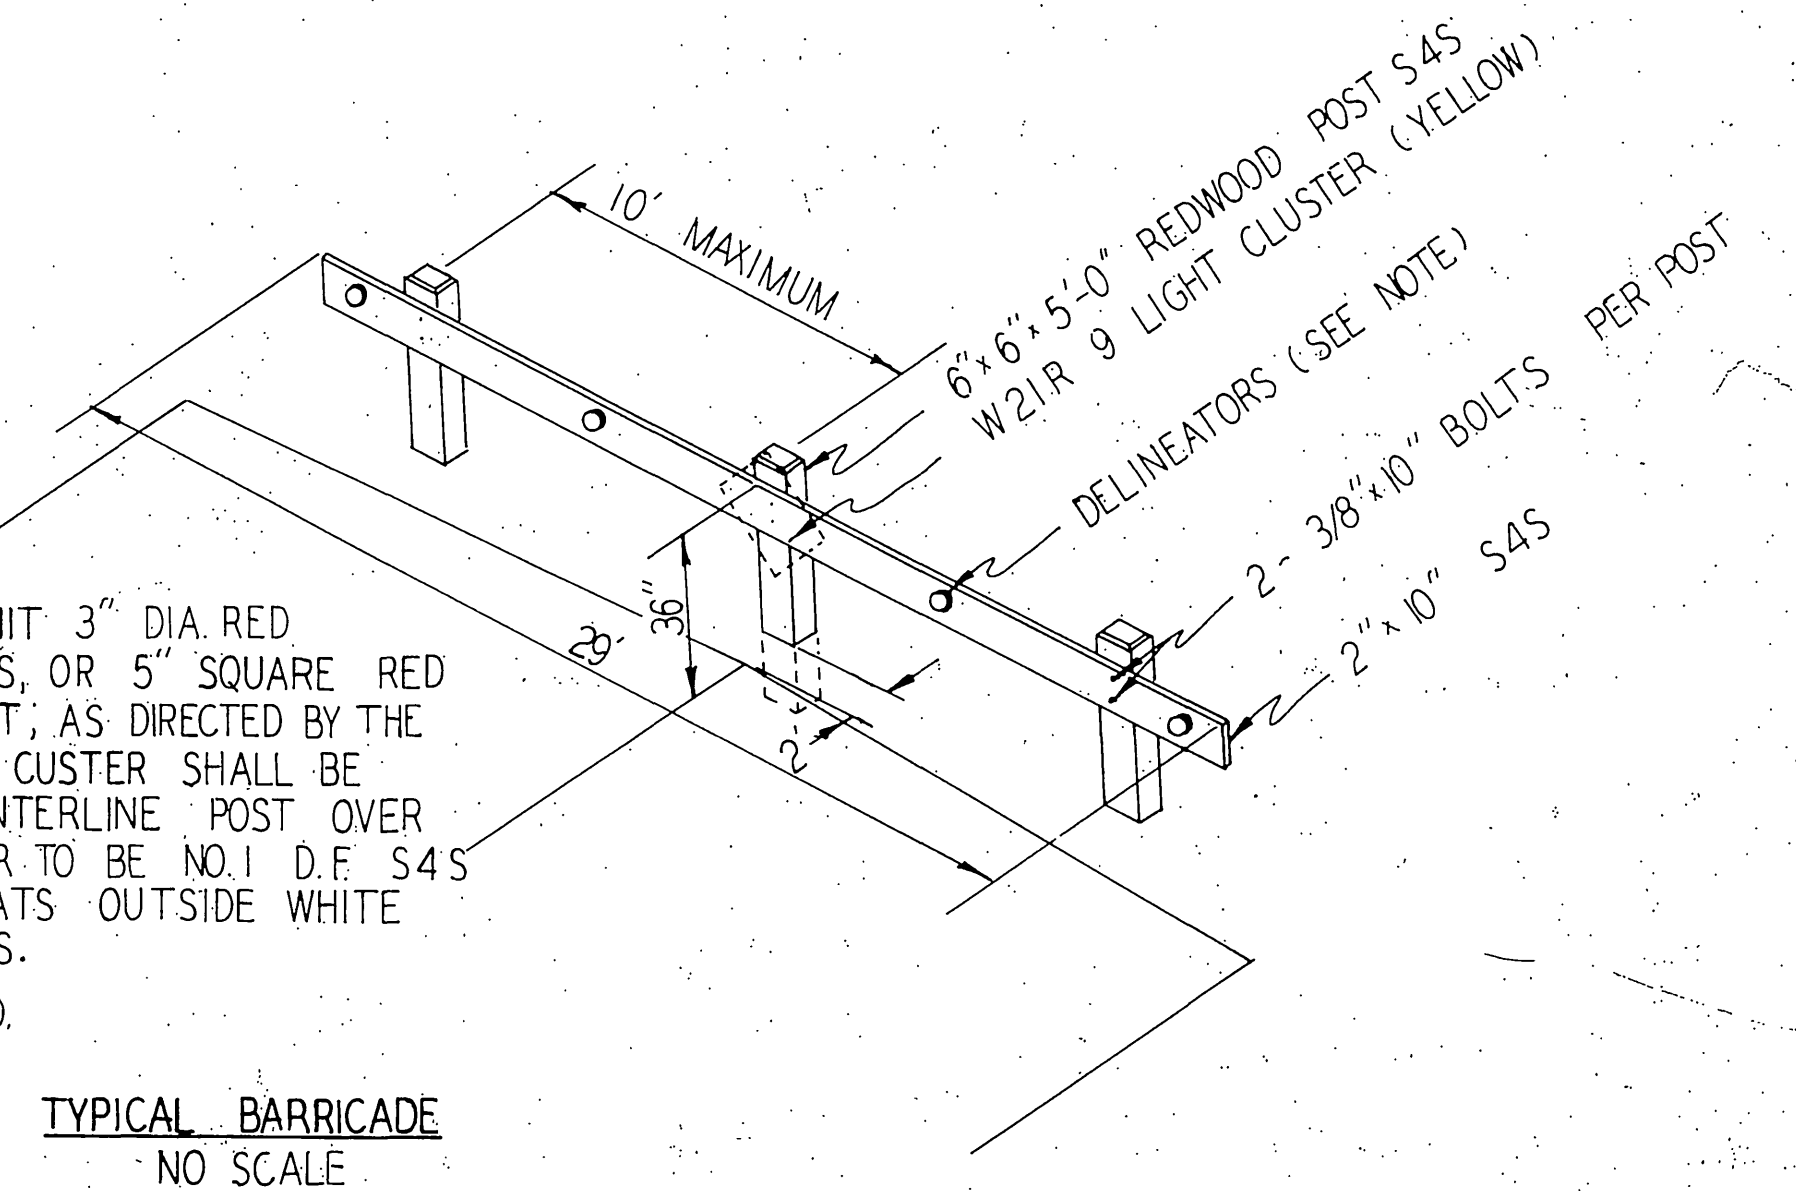

* NO DIKES ON WESTERN AVE SANDY LANE

VIII-RIV-700
TYPICAL ROAD SECTIONS
ARLINGTON AVENUE
 SCALE 1" = 5'

AS BUILT

CORRECTIONS THIS SHEET
BY *Ernie R. Brown*

CURVE DATA
W.B. STATIONING E.P.
Δ = 55°20'30"
R = 1200'
T = 629.24'
L = 1159.07'



DIST	COUNTY	ROUTE	SEC	SHEET NO	TOTAL SHEETS
VIII	RIV.	700	(3)	4	25

APPROVED *August 28, 1961*
DIST ENG DIST VIII
ENGINEER OF FEDERAL SECONDARY ROADS
A. C. KEITH COUNTY ROAD COMMISSIONER

WESTGATE TRACT

M. B. 34 / II RIV. CO.

R. S. 20 / 78 RIV. CO.

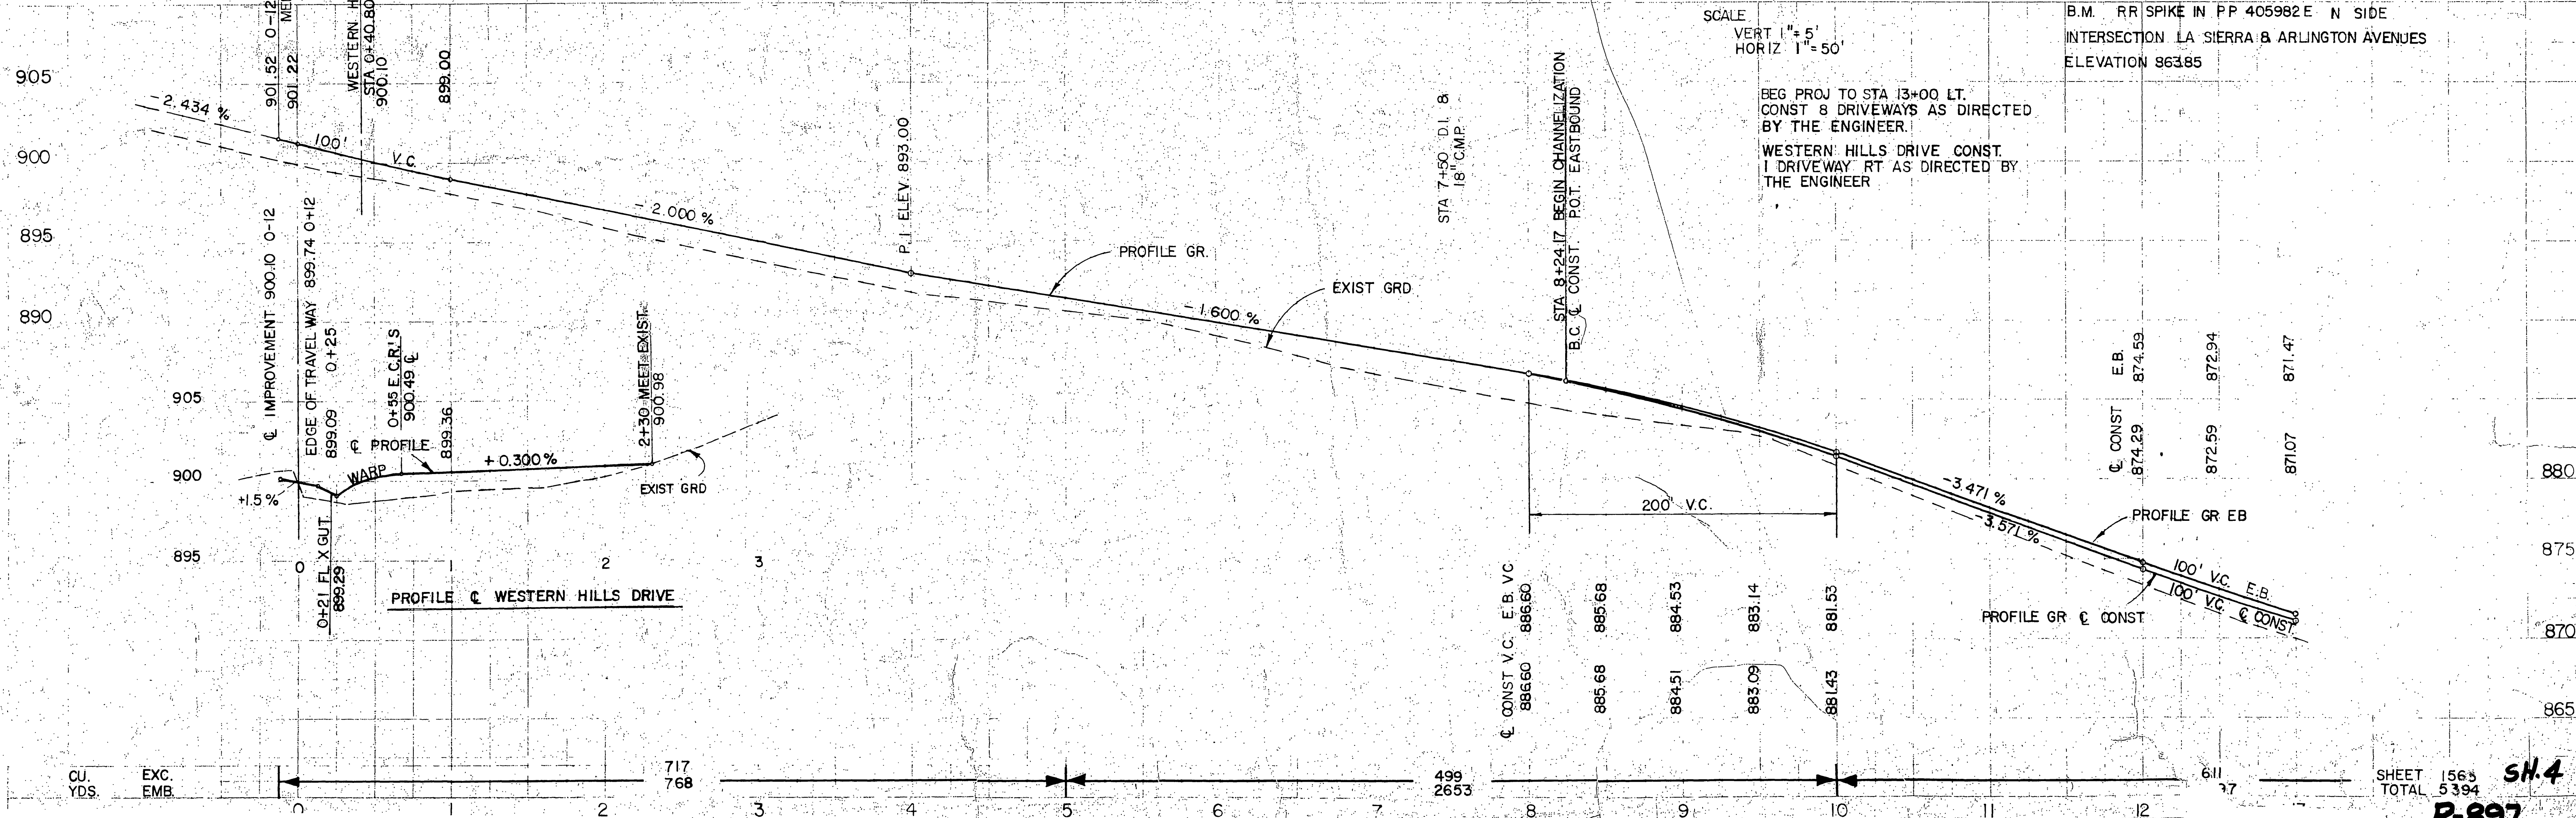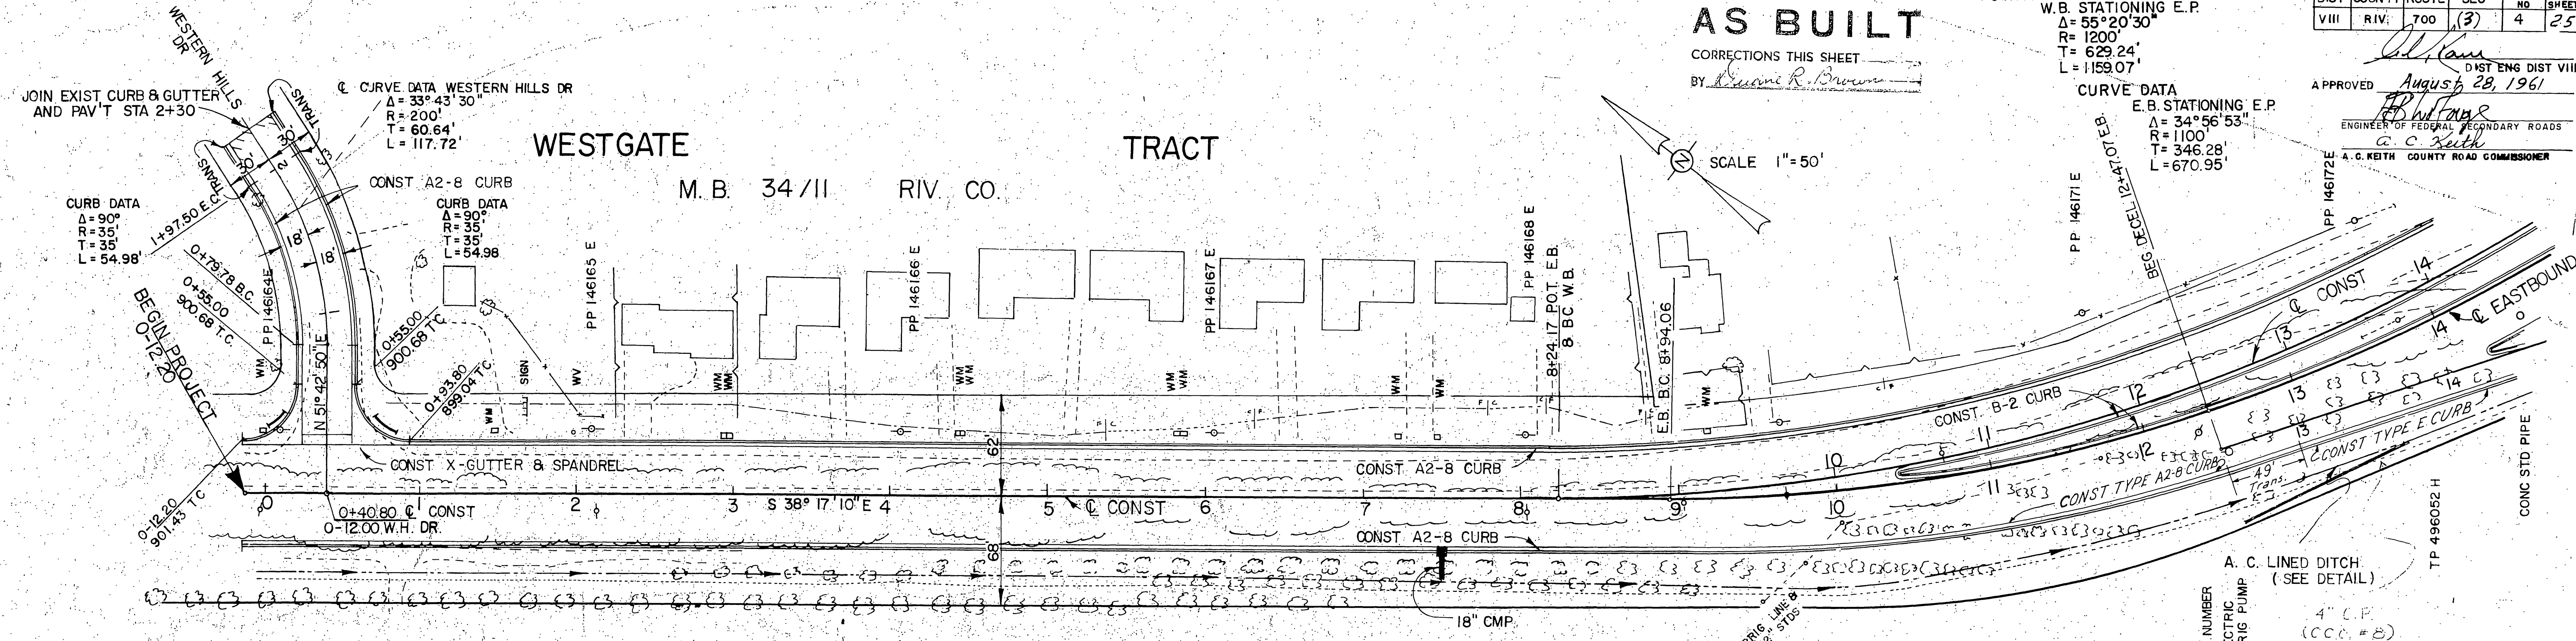

CU. YDS. 717 768
EXC. EMB.


499 2653

SHEET TOTAL 5394
SH.4
R-897

DIST	COUNTY	ROUTE	SEC	SHEET NO.	TOTAL SHEETS
VIII	RIV.	700	(3)	5	25

APPROVED: *[Signature]*
 DIST. ENG. DIST. VIII
 August 28, 1979
 ENGINEER OF FEDERAL SECONDARY ROADS
 A.C. KEITH COUNTY ROAD COMMISSIONER

AS BUILT
 CORRECTIONS THIS SHEET
[Signature]

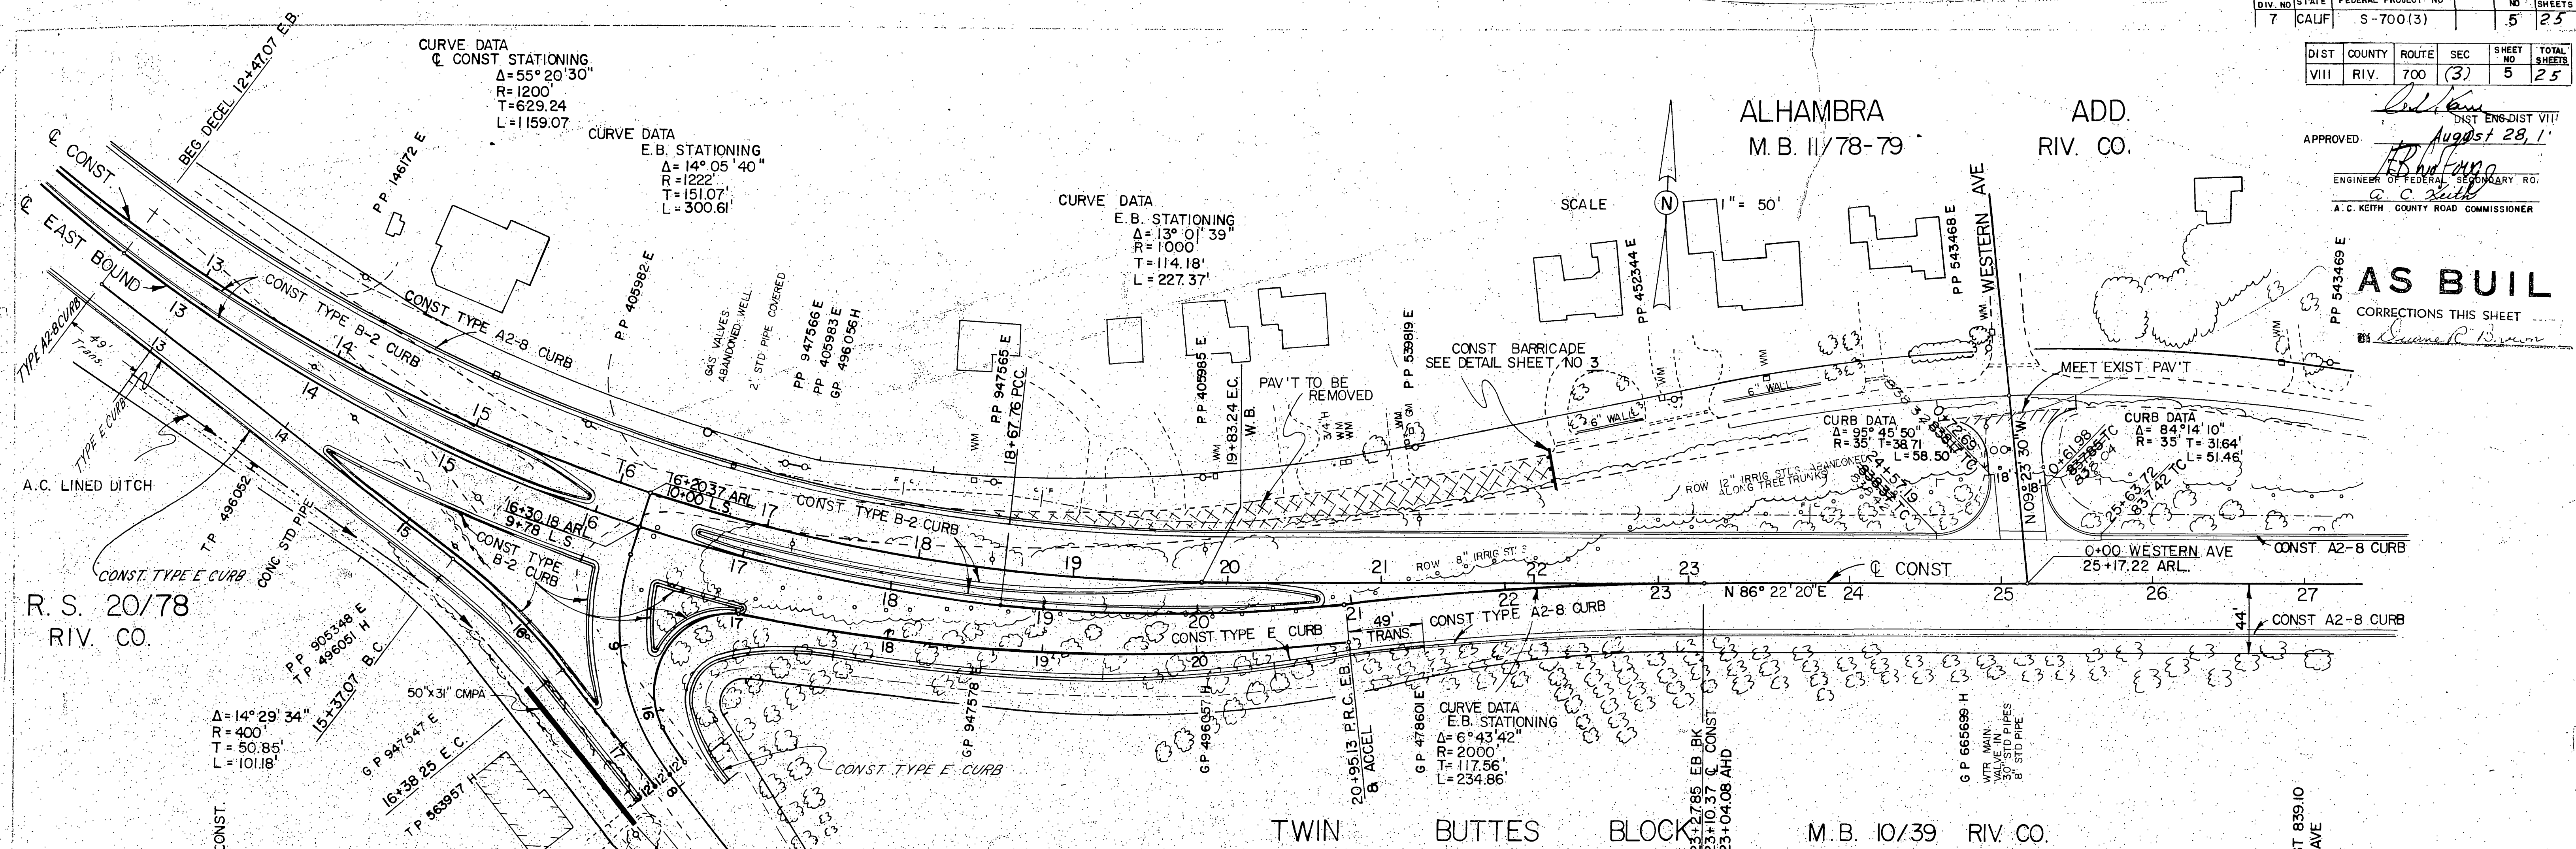

CURVE DATA
 C. CONST. STATIONING
 $\Delta = 55^\circ 20' 30''$
 $R = 1200'$
 $T = 629.24'$
 $L = 1159.07'$

CURVE DATA
 E.B. STATIONING
 $\Delta = 14^\circ 05' 40''$
 $R = 1222'$
 $T = 151.07'$
 $L = 300.61'$



CURVE DATA
 E.B. STATIONING
 $\Delta = 13^\circ 01' 39''$
 $R = 1000'$
 $T = 114.18'$
 $L = 227.37'$

SCALE
 1" = 50'

SCALE
 VERT. 1" = 5'
 HORT. 1" = 50'

B.M. CHISELED CROSS S.W. CONC DRIVE
 N.E. CORNER WESTERN AVE & ARLINGTON AVE
 ELEVATION 839.02

STA 13+00 TO STA 27+00 LT
 CONST 4 DRIVEWAYS AS DIRECTED
 BY THE ENGINEER.
 LA SIERRA AVE LT CONST
 2 DRIVEWAYS AS DIRECTED
 BY THE ENGINEER

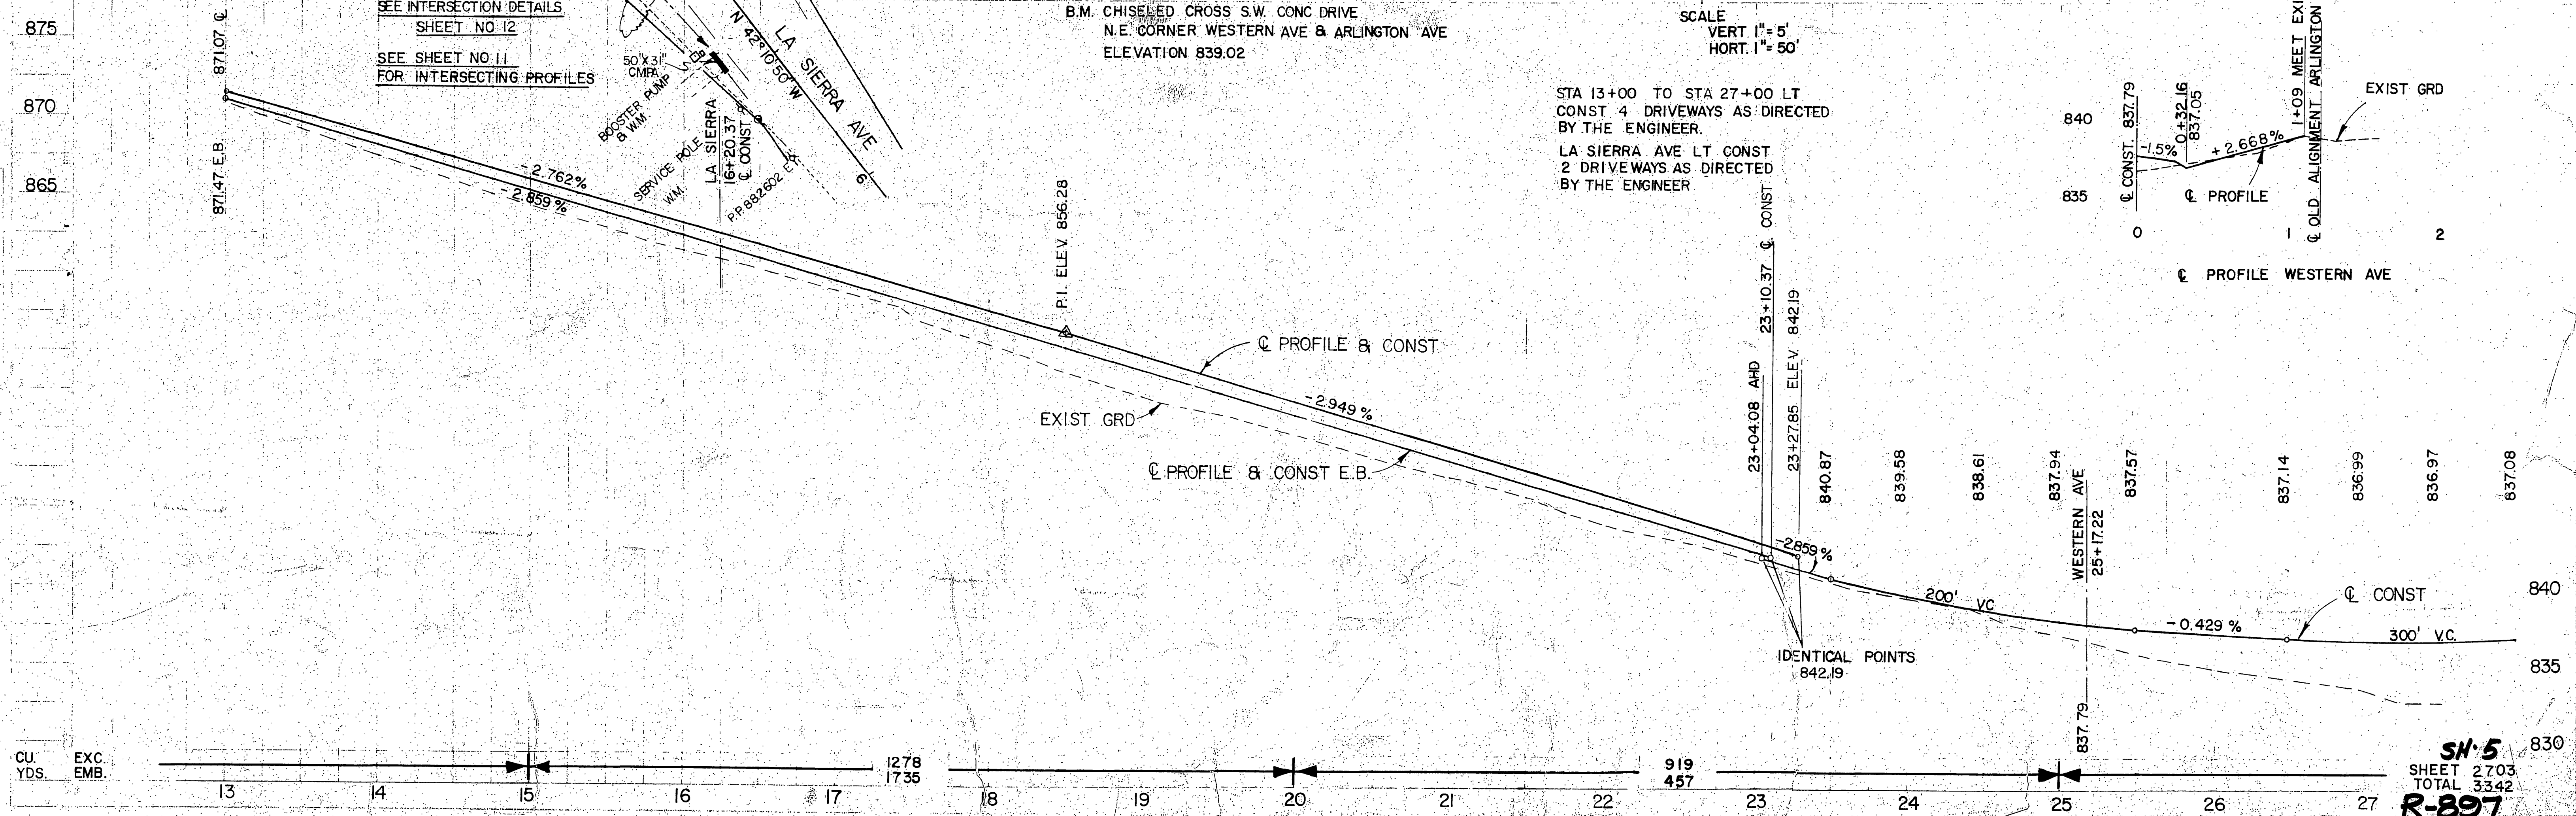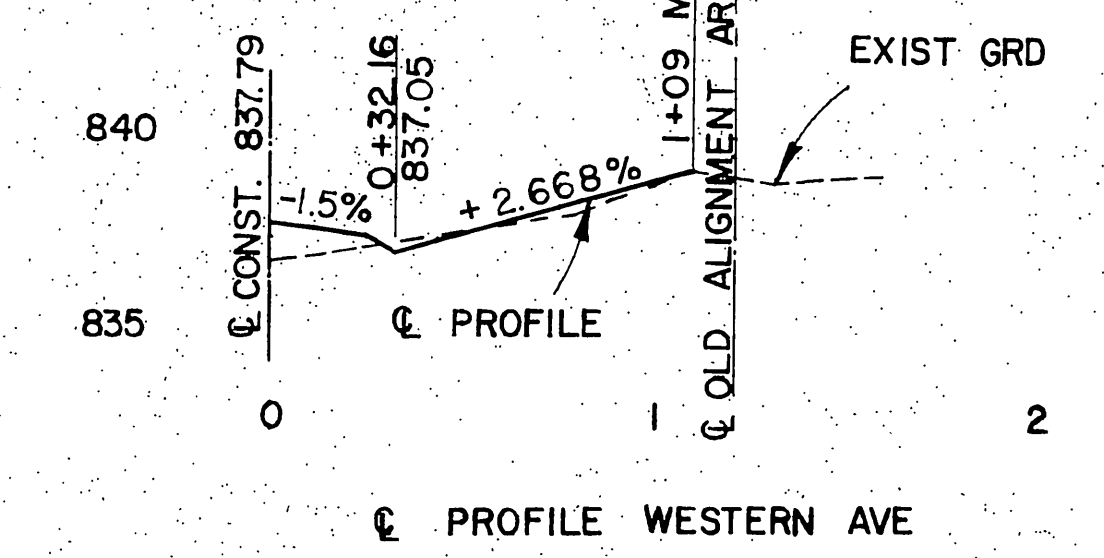


ALAHAMBRA ADDITION

M. B. 11/78-79 RIV. CO.

DIST	COUNTY	ROUTE	SEC	SHEET NO.	TOTAL SHEETS
VIII	RIV.	700	(3)	6	25

APPROVED *[Signature]*
 DIST. ENGR. DIST. VIII
 August 28, 1961
 ENGINEER OF FEDERAL SECONDARY ROADS
 A.C. KEITH COUNTY ROAD COMMISSIONER

AS BUILT
 CORRECTIONS THIS SHEET
 BY *[Signature]*

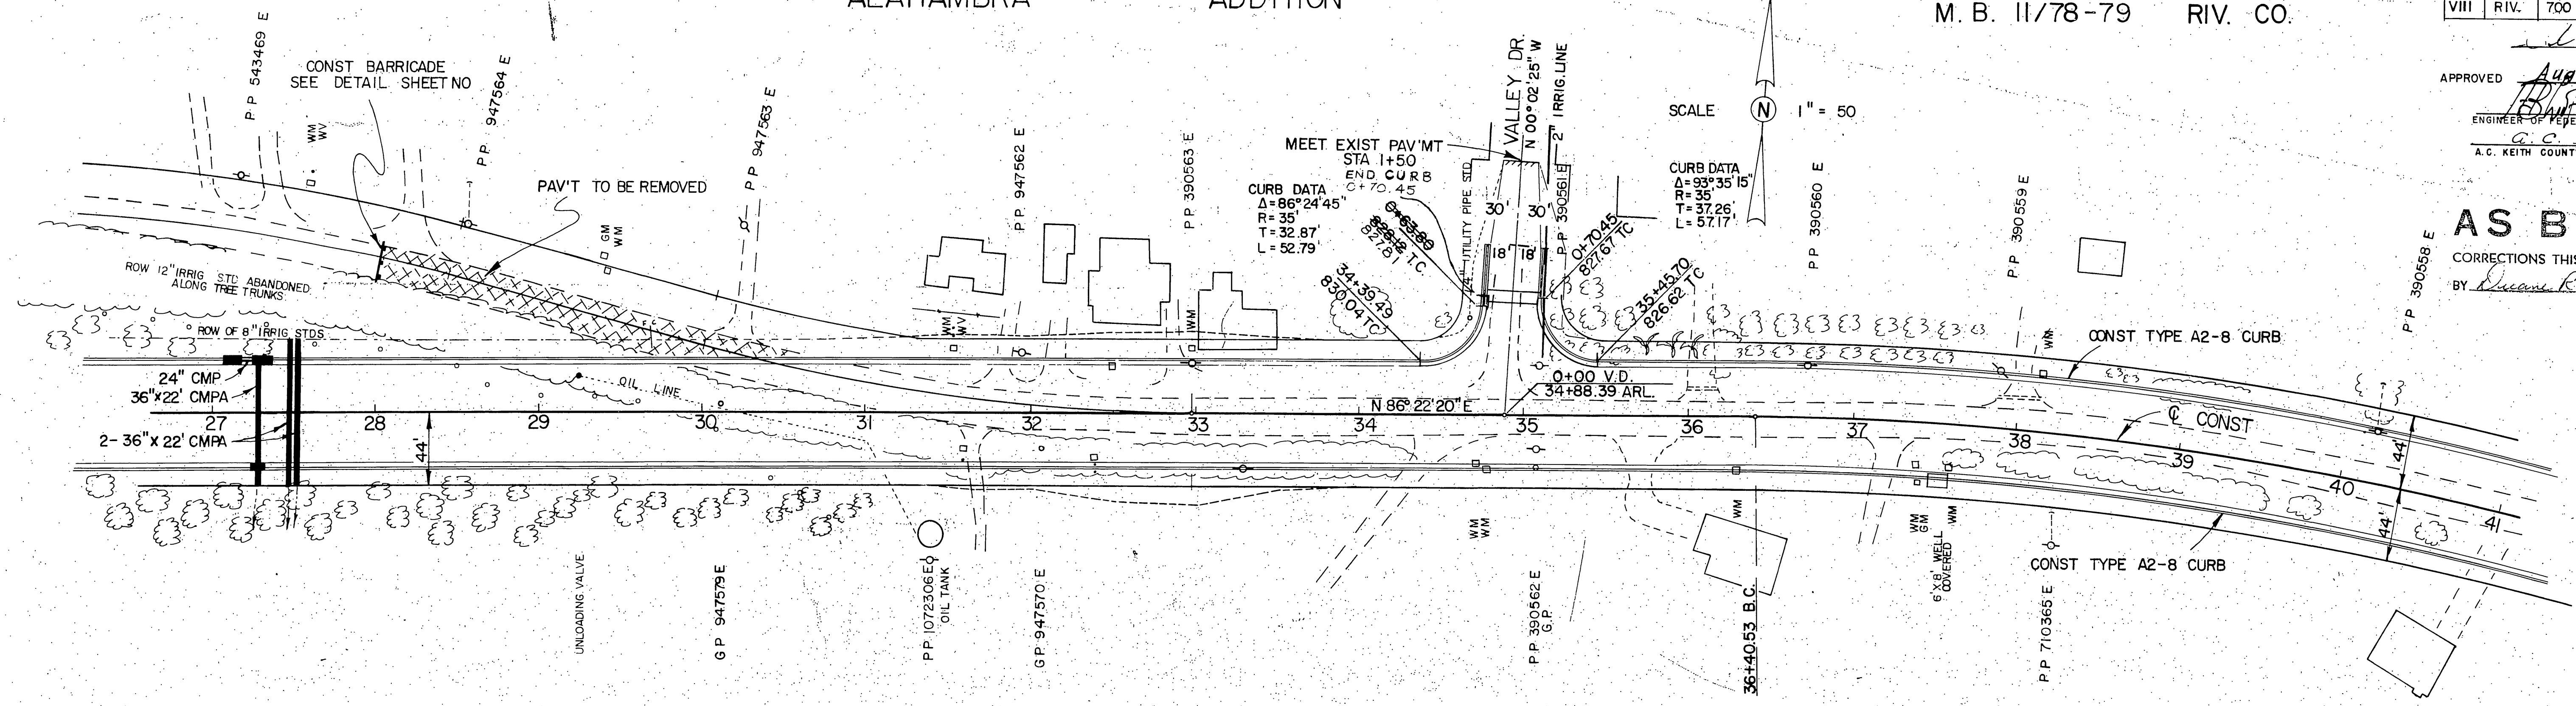


TWIN BUTTES BLOCK M. B. 10/39 RIV. CO.

B.M. CHISELED X.N.E. CORNER CONCRETE PORCH
 60' LT STA 36+30 HOUSE 10894
 ELEV 827.49

SCALE
 VERT 1" = 5'
 HORT 1" = 50'

STA 27+00 TO STA 41+00 CONST.
 6 DRIVEWAYS LT. AND 4 DRIVEWAYS RT.
 AS DIRECTED BY THE ENGINEER.
 VALLEY DRIVE CONST 1 DRIVEWAY RT.
 AS DIRECTED BY THE ENGINEER.

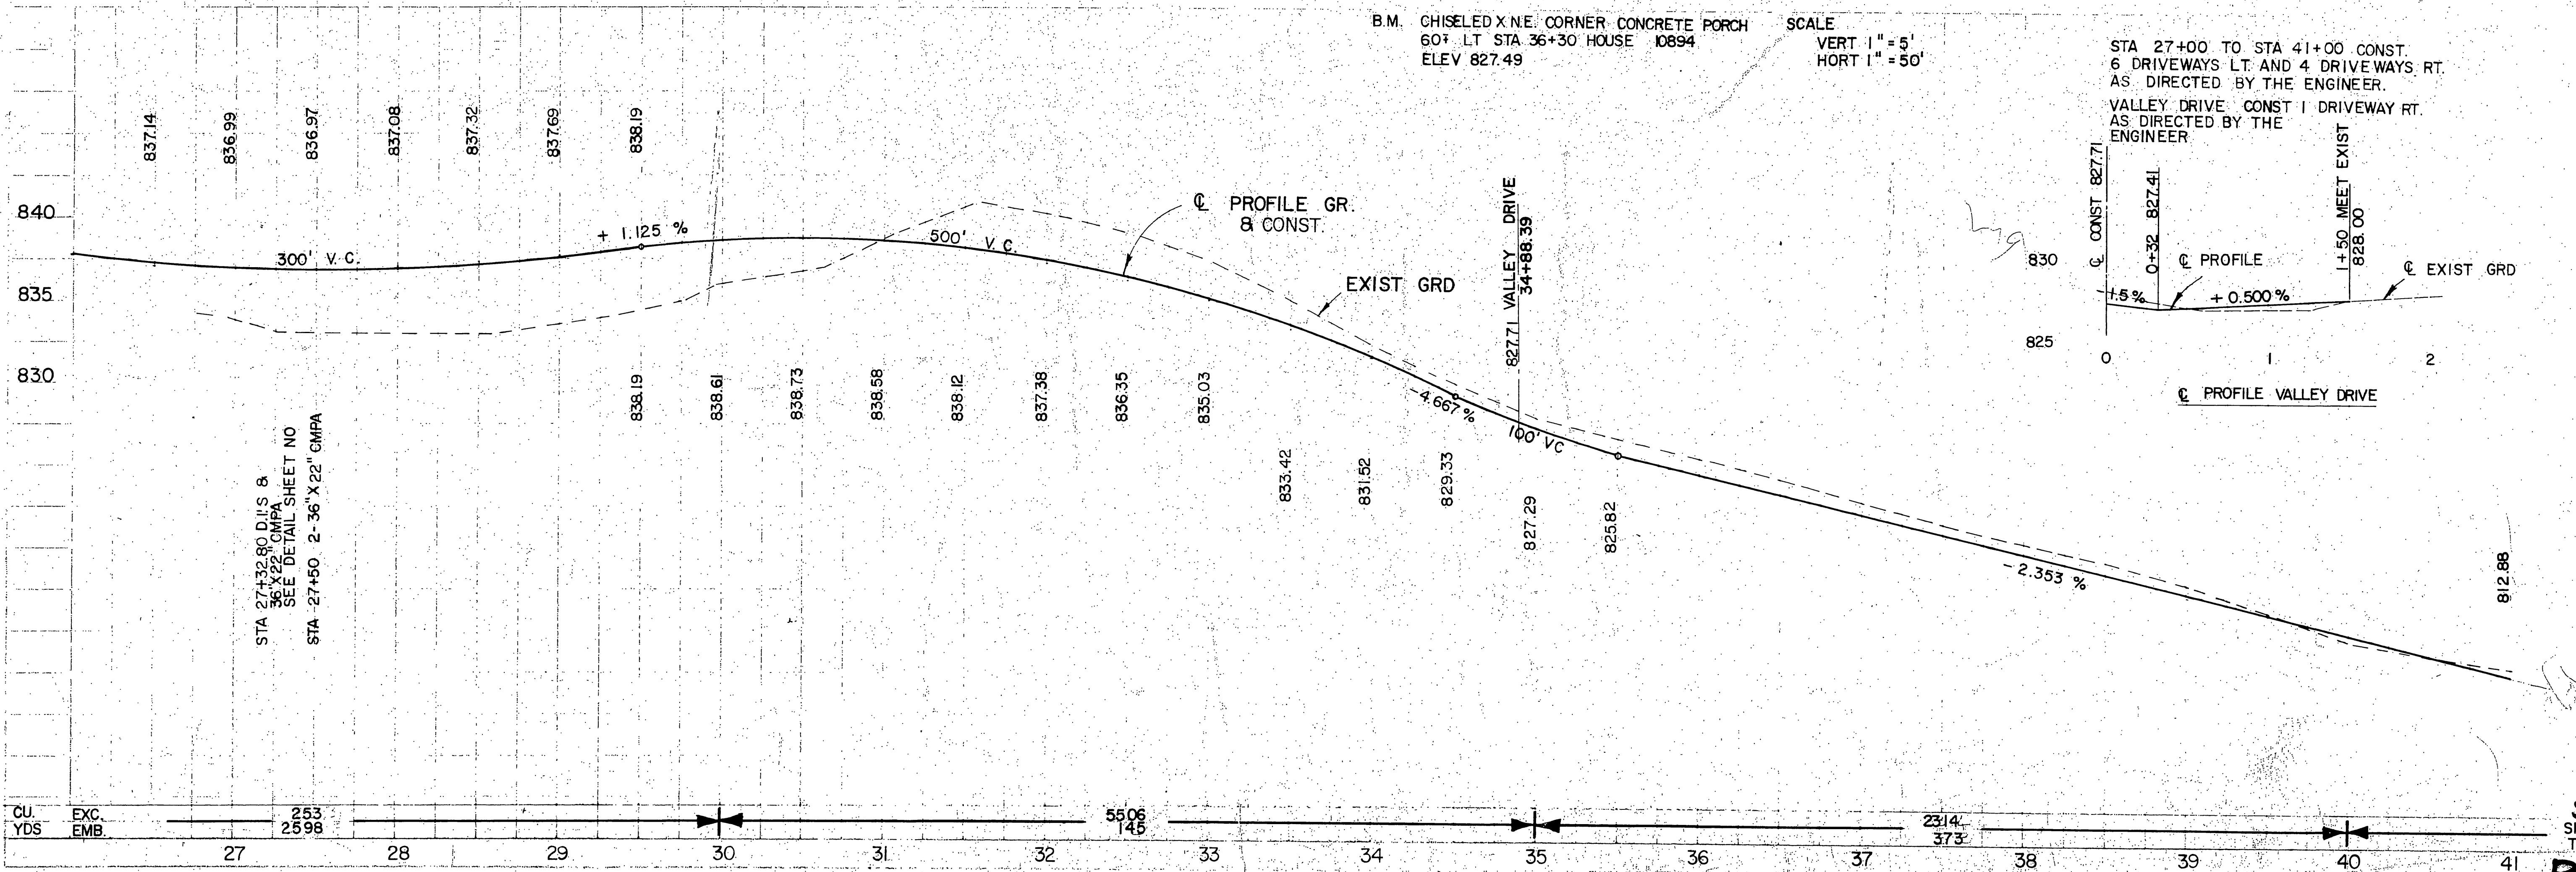


DIST.	COUNTY	ROUTE	SEC.	SHEET	TOTAL
VIII	RV	700	(3)	9	23

LA GRANADA M.B. 12/49 RIV. CO.

LA GRANADA M.B. 12/49 RIV. CO.


APPROVED: *[Signature]*
 August 28, 1961
 ENGINEER OF FEDERAL SECONDARY ROADS
 A. C. KEITH COUNTY ROAD COMMISSIONER

AS BUILT
 CORRECTIONS THIS SHEET
 BY *[Signature]*

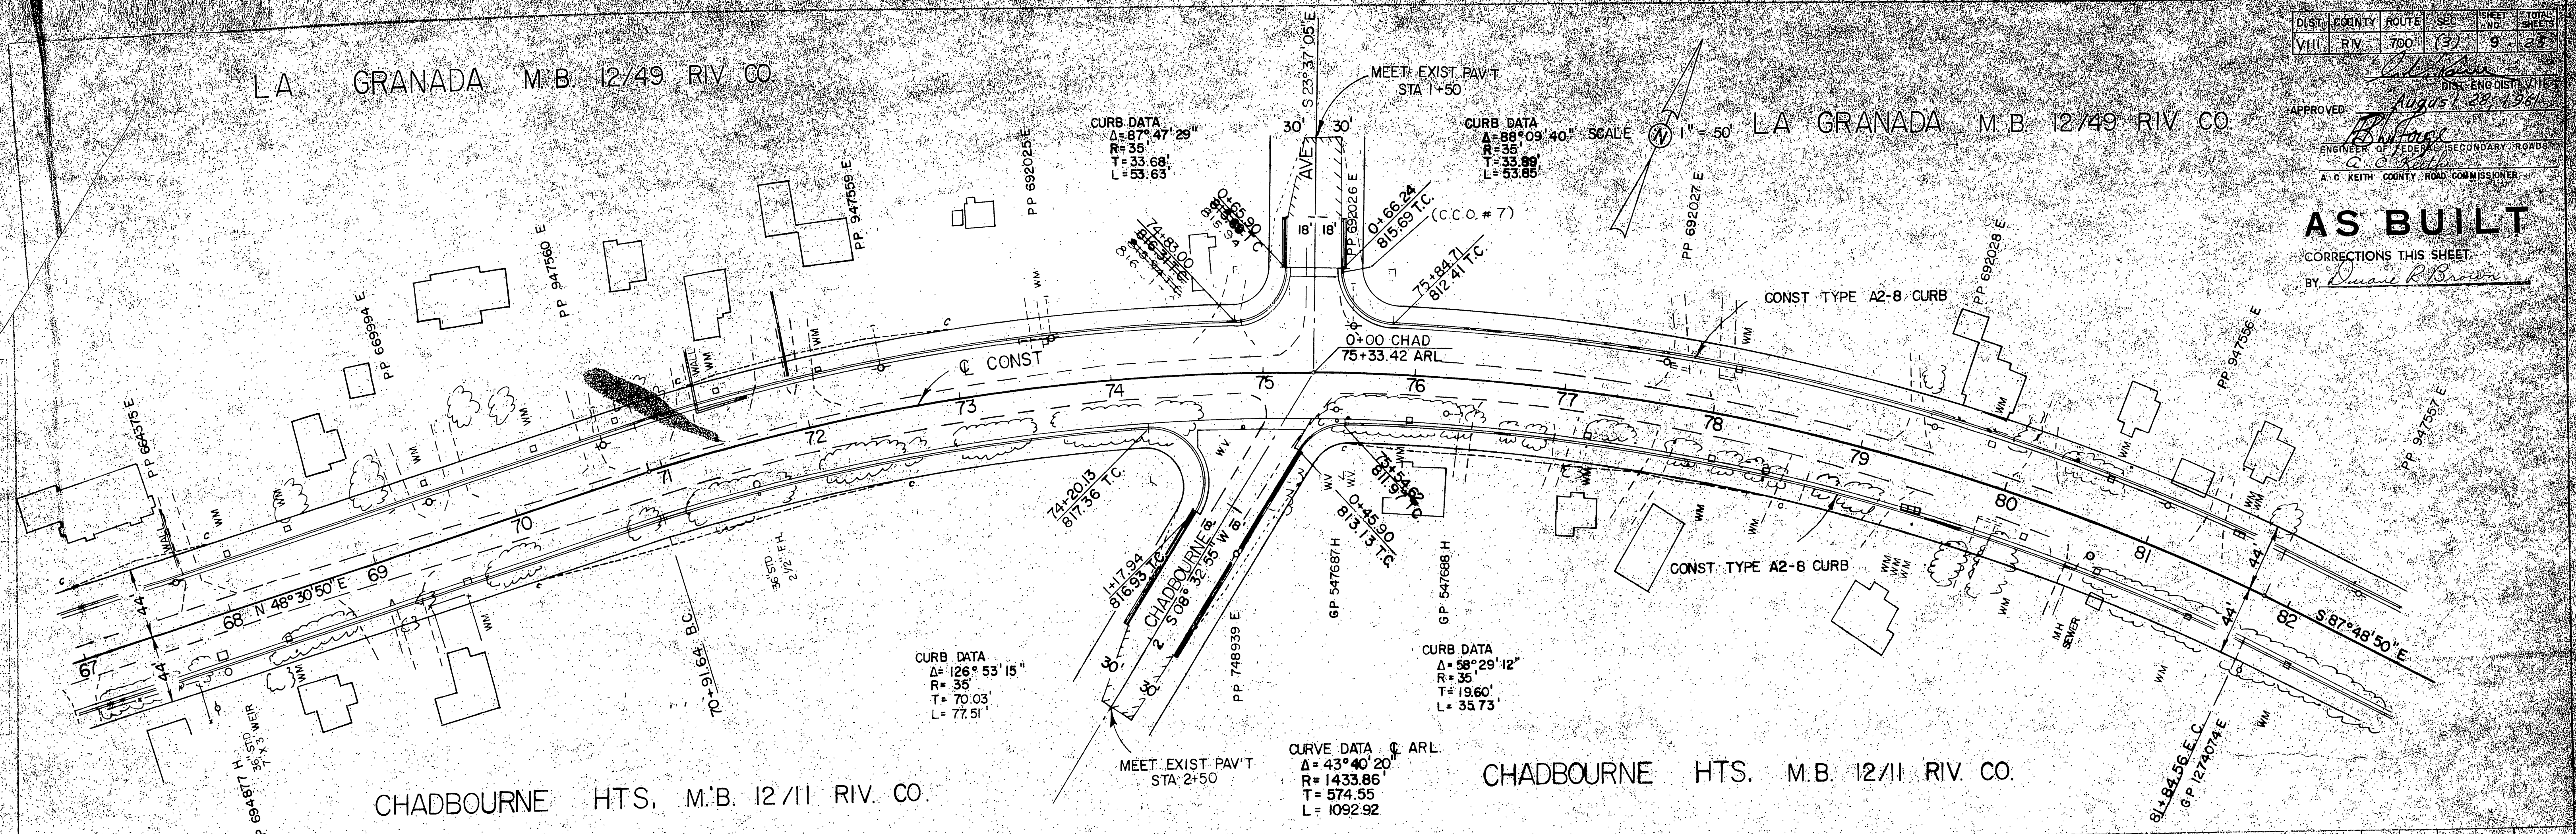

CHADBOURNE HTS. M.B. 12/11 RIV. CO.

CHADBOURNE HTS. M.B. 12/11 RIV. CO.

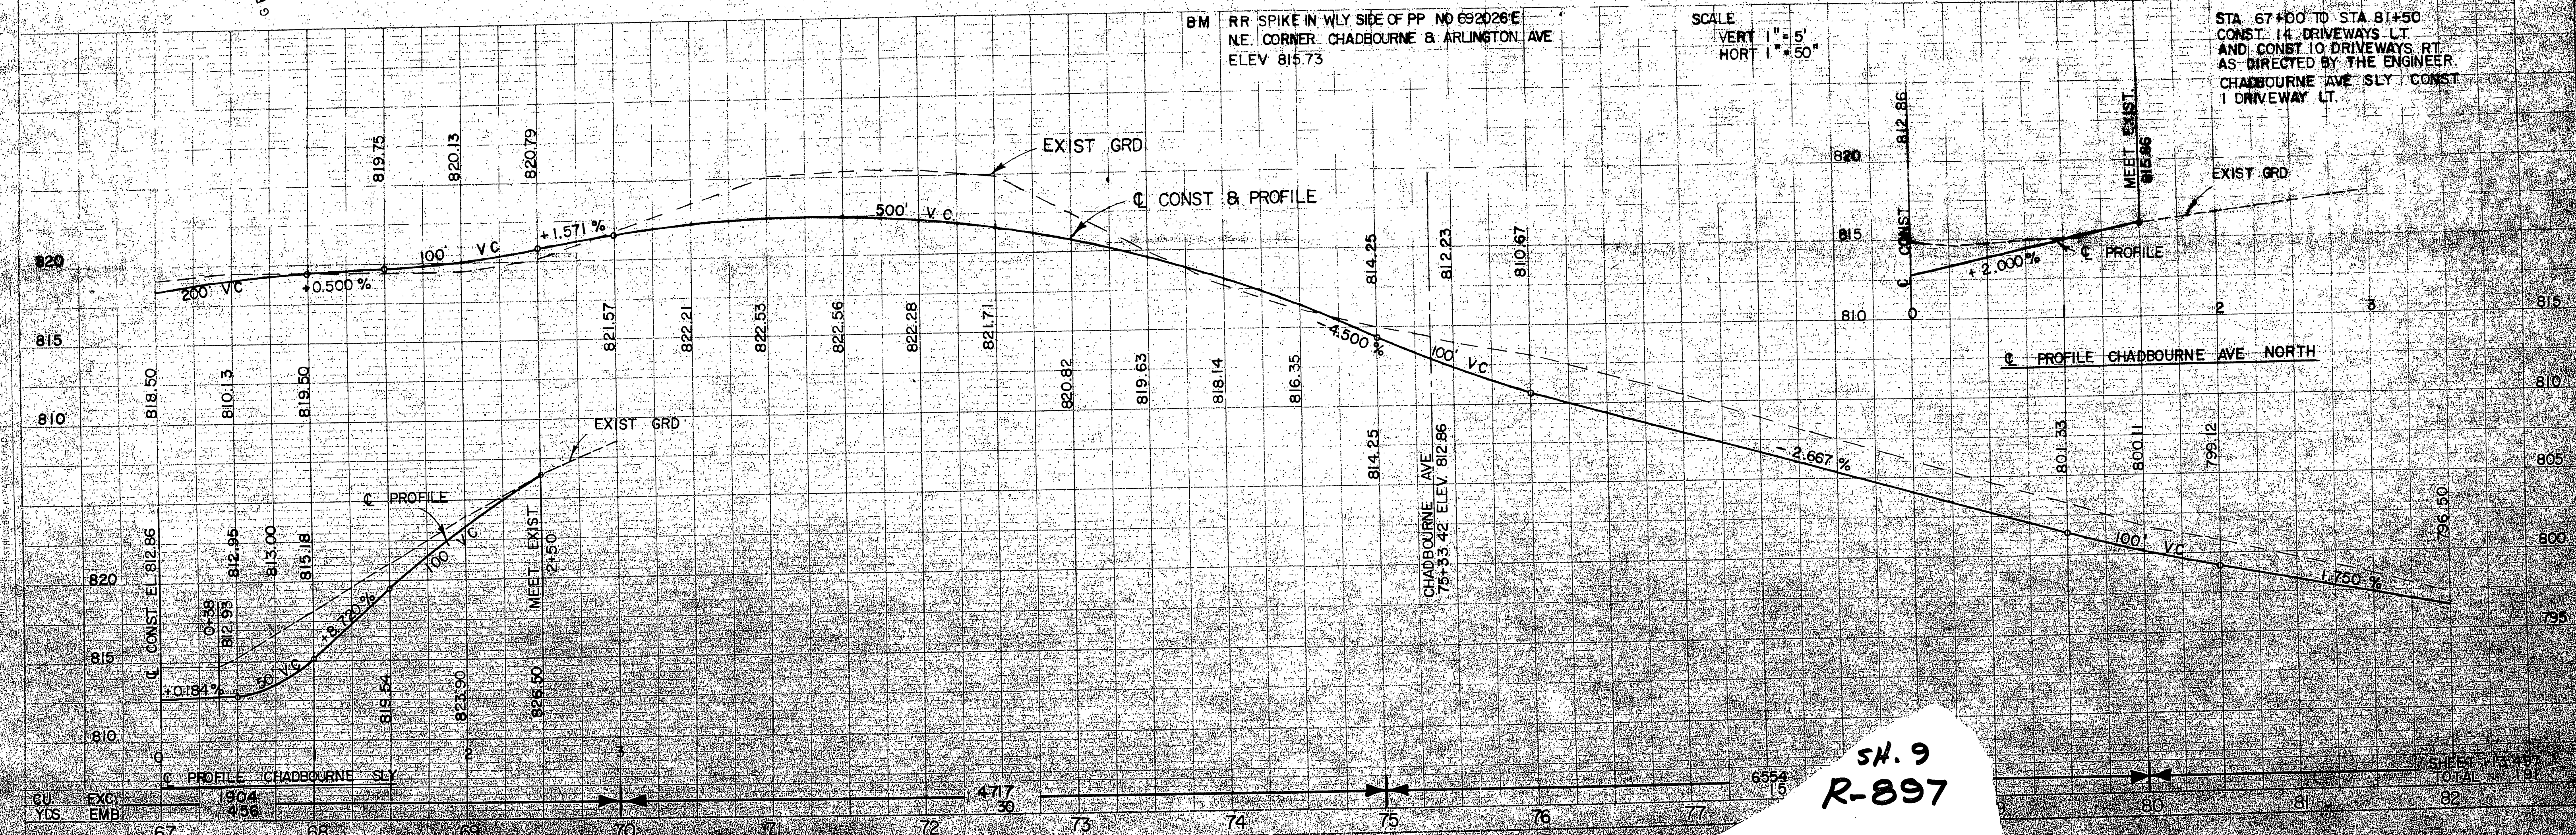

SH. 9
 R-897

SHEET 9 OF 23
 TOTAL SHEETS

LA GRANADA M.B. 12/49 RIV. CO.

CURVE DATA @ ARL.
 $\Delta = 1^{\circ} 41' 35''$
 $R = 17,500'$
 $T = 258.57'$
 $L = 517.11'$


CURB DATA
 $\Delta = 117^{\circ} 39' 00''$
 $R = 35'$
 $T = 57.85'$
 $L = 71.87'$

CURB DATA
 $\Delta = 62^{\circ} 21' 00''$
 $R = 35'$
 $T = 21.16'$
 $L = 38.09'$


CURB DATA
 $\Delta = 85^{\circ} 54' 32''$
 $R = 35'$
 $T = 52.58'$
 $L = 52.48'$

APPROVED: *[Signature]*
 August 28, 1961
 DIST-ENG DIST-VIII
 ENGINEER OF FEDERAL SECONDARY ROADS
 A. C. Keith
 A. C. KEITH COUNTY ROAD COMMISSIONER

AS BUILT
 BY *[Signature]*
 NO CORRECTIONS THIS SHEET

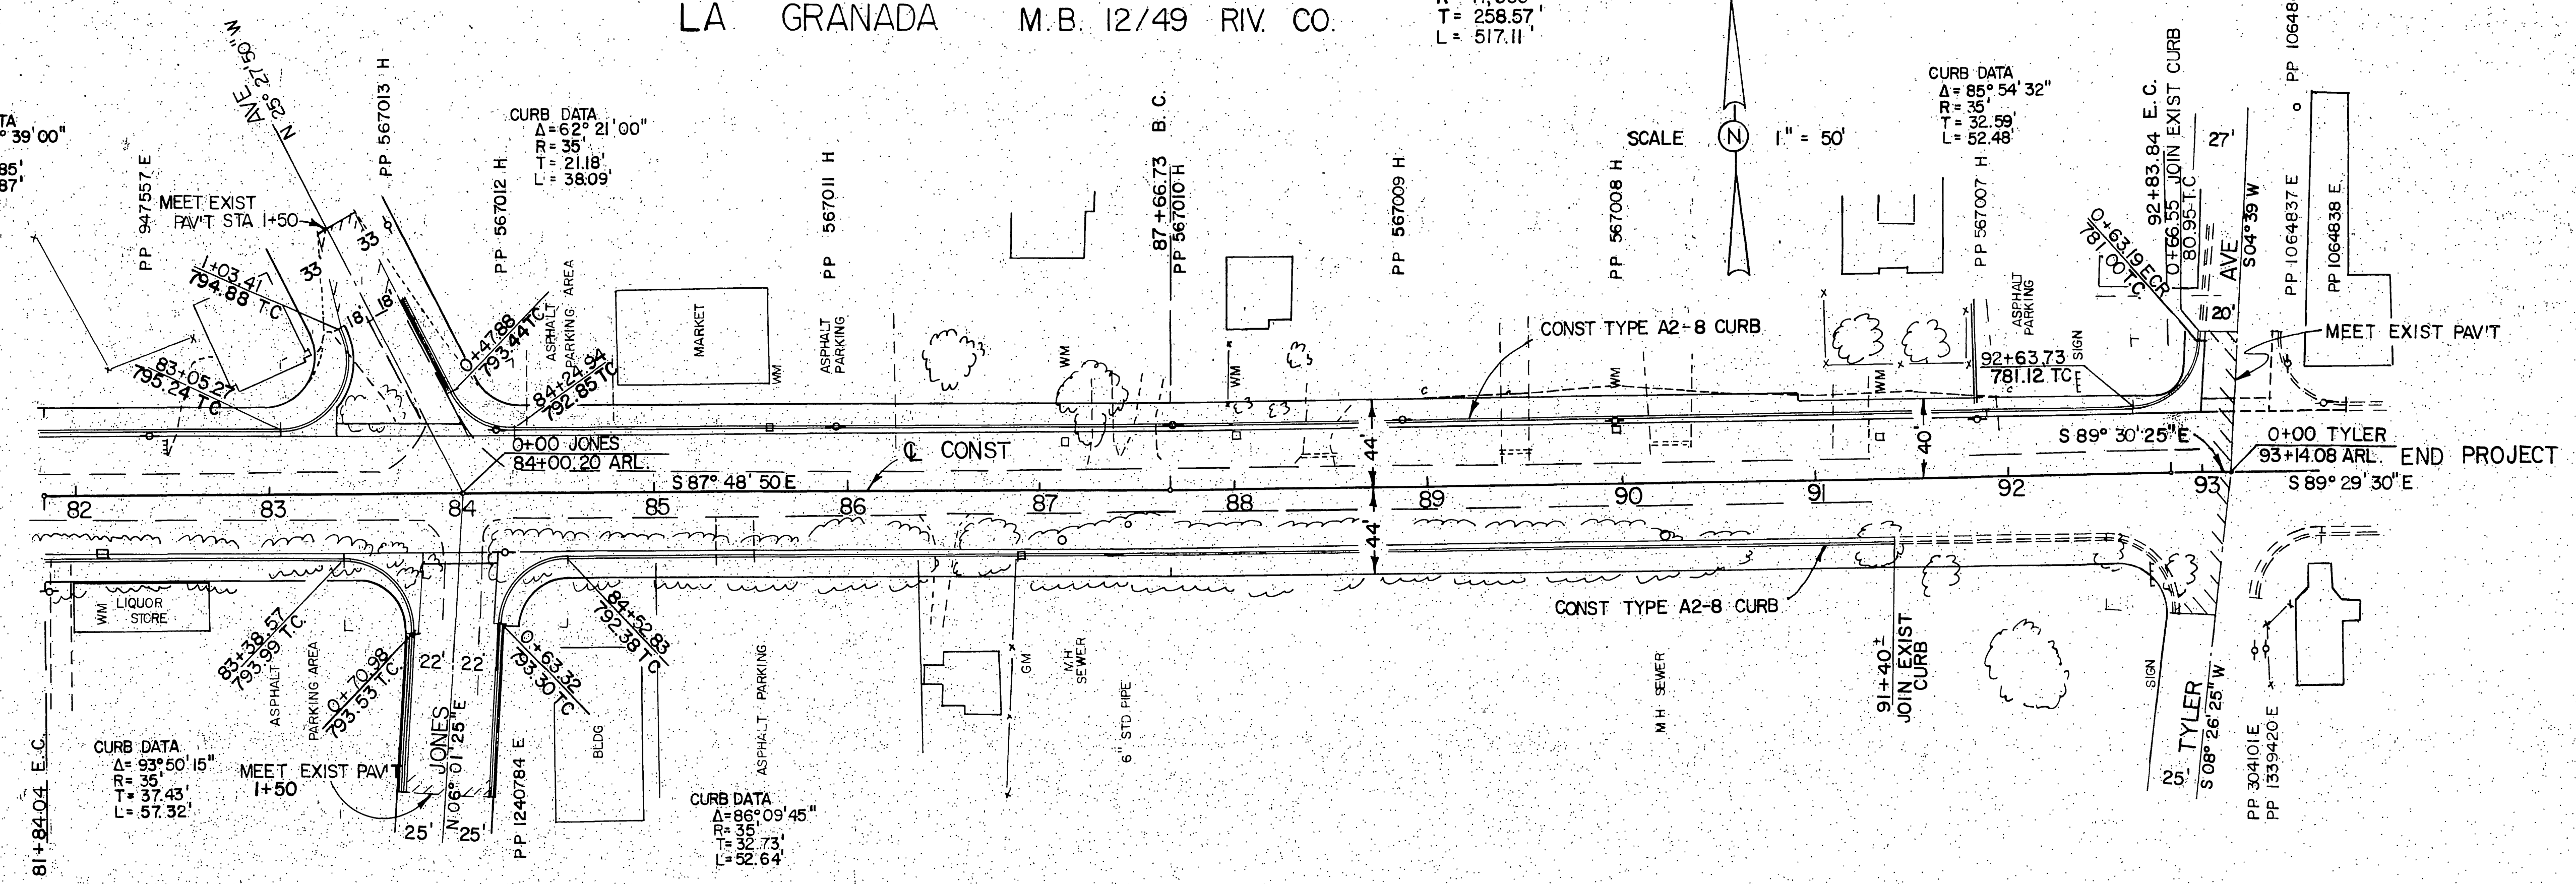


LA GRANADA M.B. 12/42 RIV. CO.

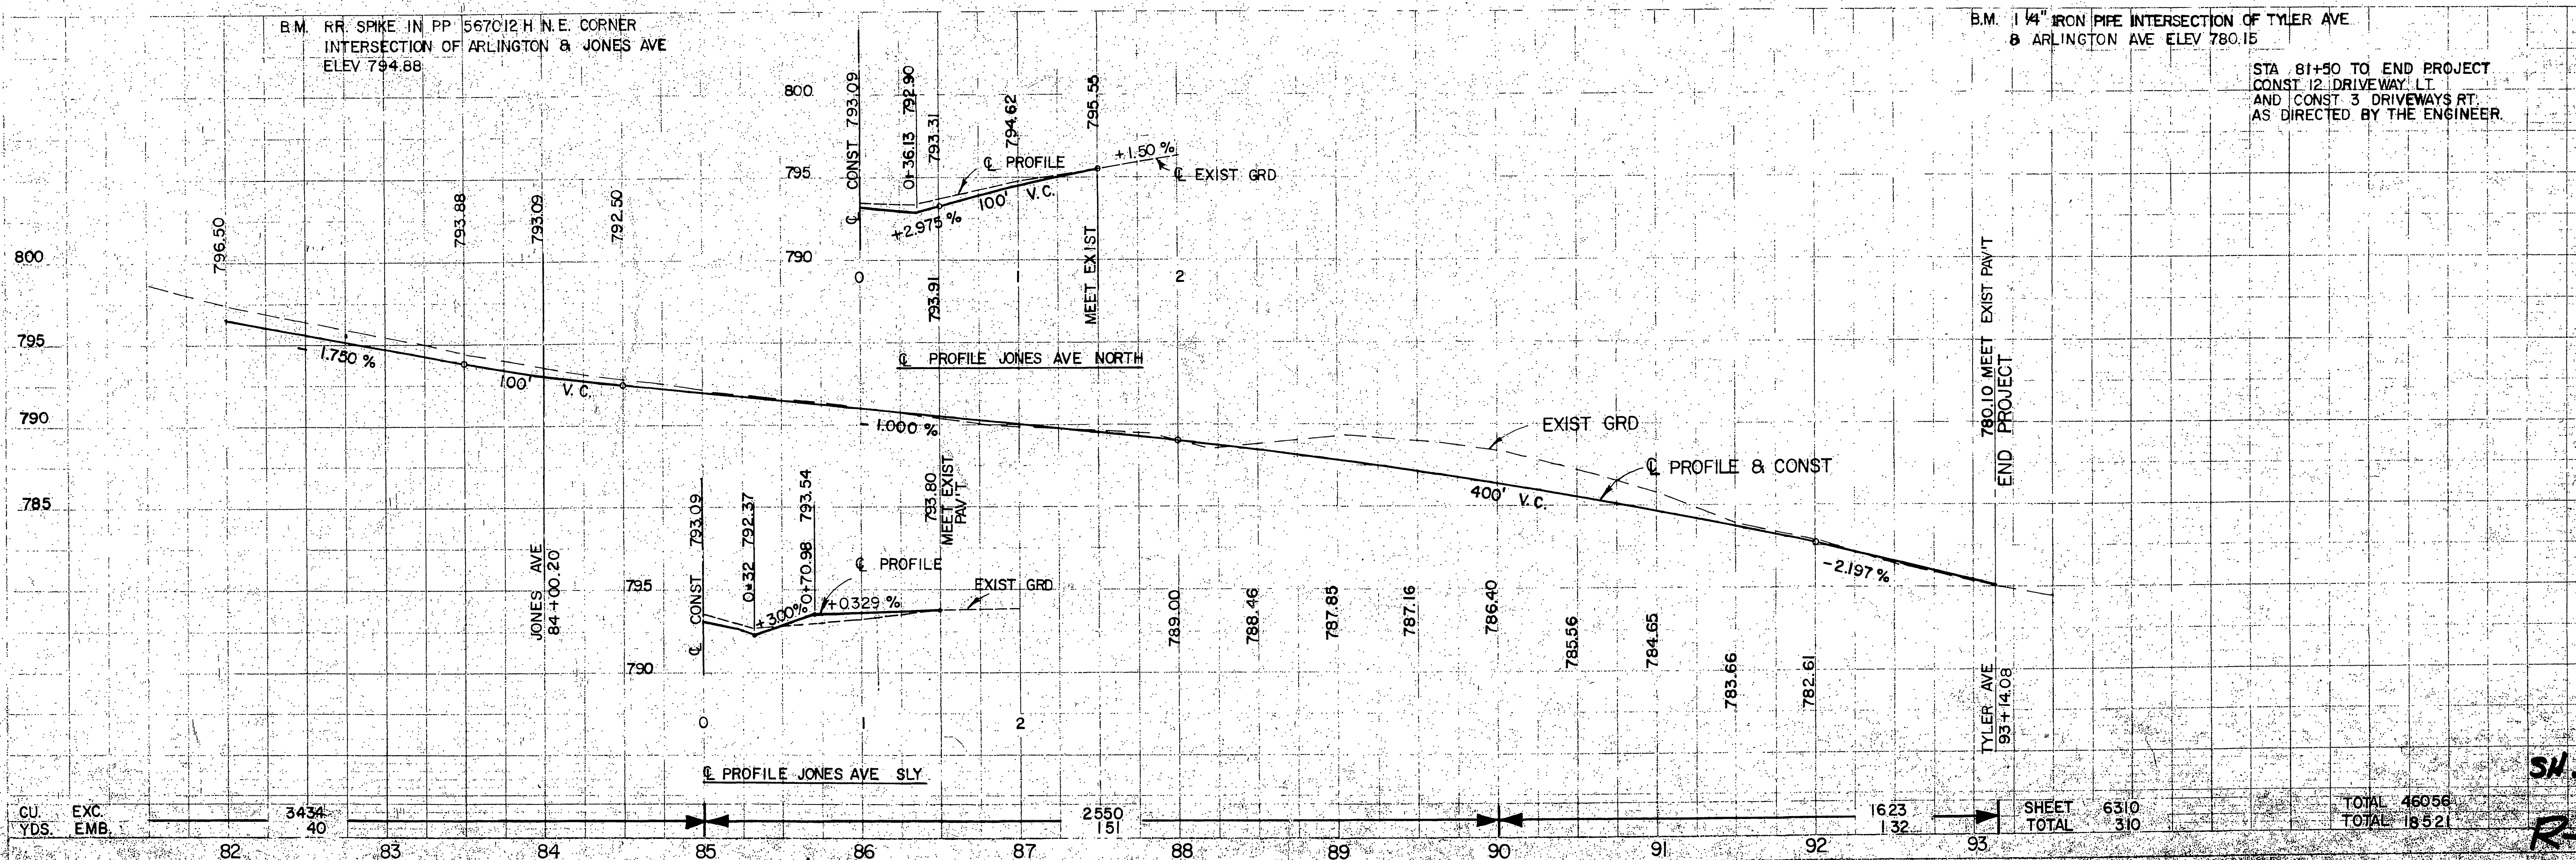

AS BUILT
 BY *William R. Brown*
 NO CORRECTIONS THIS SHEET

FINAL SURVEY
 SURVEYED: _____
 TEMPLATE: _____
 NOTE BOOK: _____
 AREAS CHECKED: _____
 NO. _____

ORIGINAL SURVEYED
 SURVEY PLOTTED: _____
 NOTE BOOK: _____
 AREAS CHECKED: _____
 NO. _____

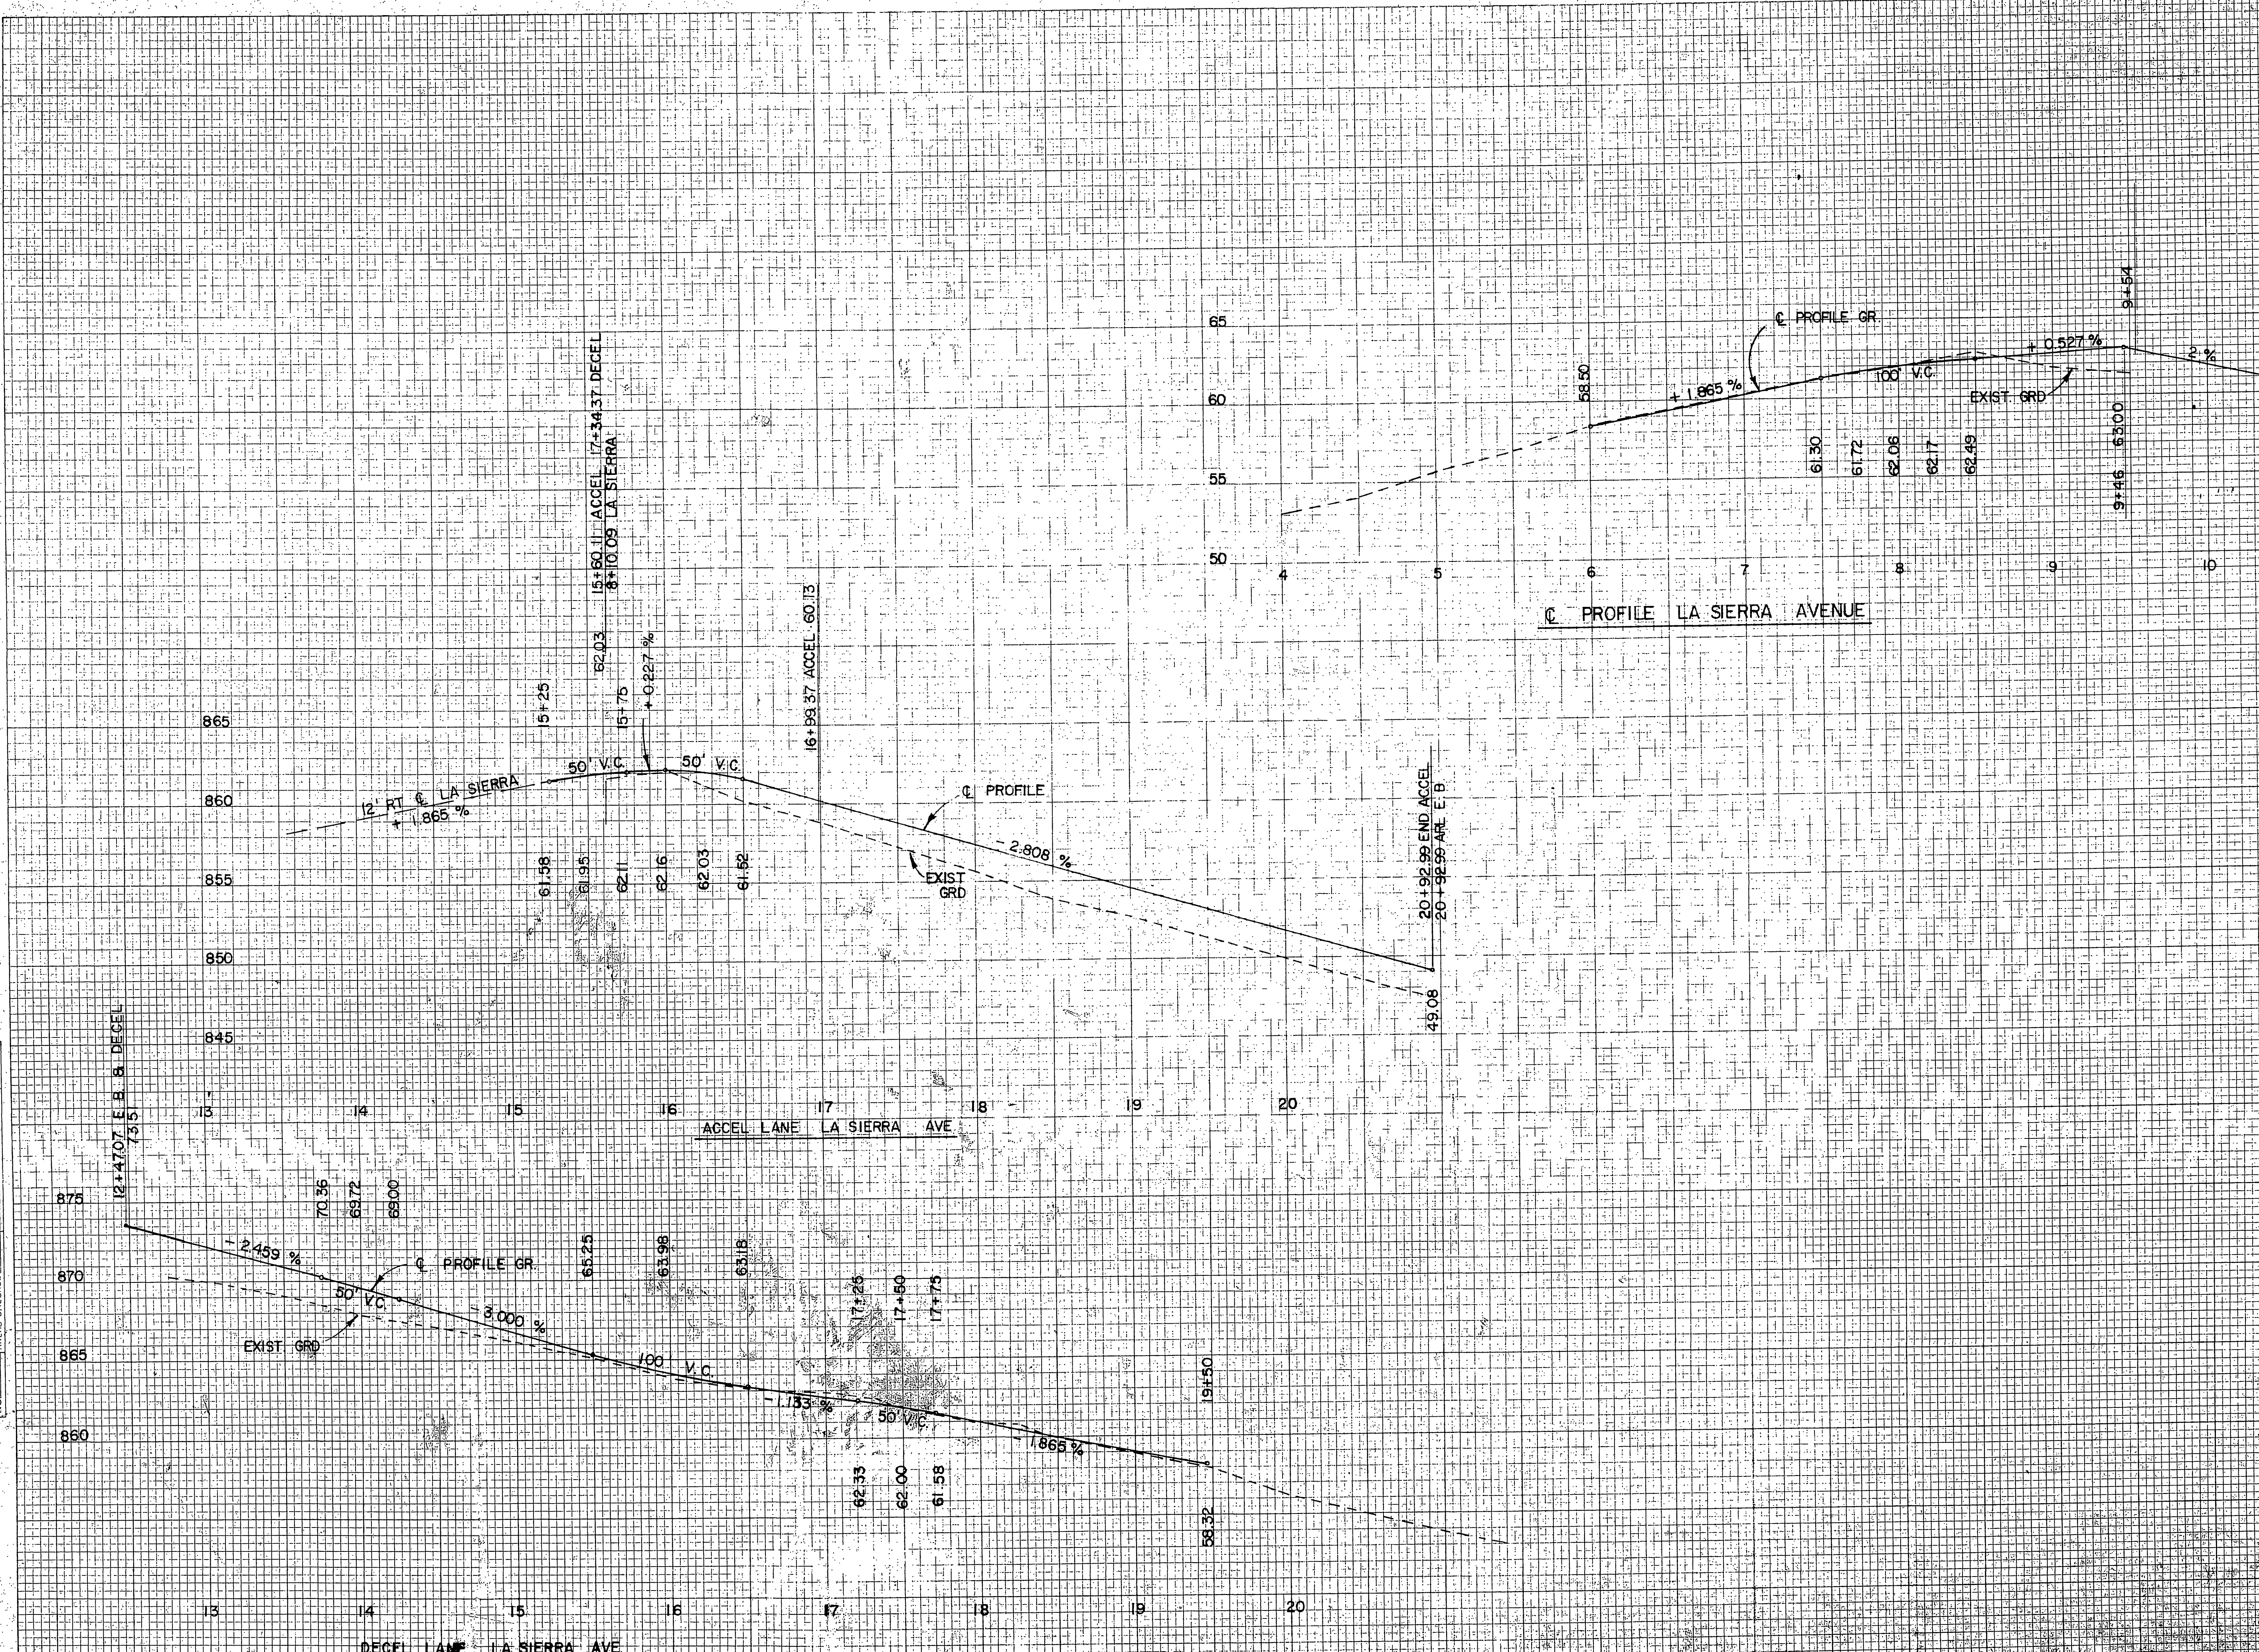


SH. 11
 R-897

DIST	COUNTY	ROUTE	SEC	SHEET NO	TOTAL SHEETS
VIII	RIV	700	(3)	12	25

APPROVED *[Signature]*
 August 28, 1961
 ENGINEER OF FEDERAL SECONDARY ROADS
 A.C. KEITH COUNTY ROAD COMMISSIONER


AS BUILT
 BY *Dwight R. Brown*
 NO CORRECTIONS THIS SHEET

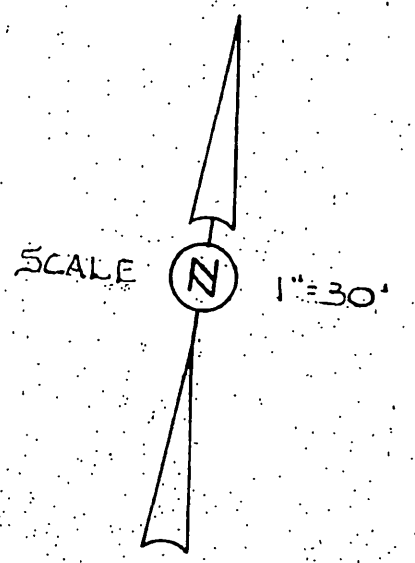

☉ CURVE DATA
 $\Delta = 34^\circ 56' 53''$
 $R = 1100'$
 $T = 346.78$
 $L = 670.95'$

☉ CURVE DATA E.B.
 $\Delta = 14^\circ 05' 40''$
 $R = 1222'$
 $T = 151.07'$
 $L = 300.61'$

☉ CURVE DATA E.B.
 $\Delta = 13^\circ 01' 39''$
 $R = 1000'$
 $T = 114.18'$
 $L = 227.37'$

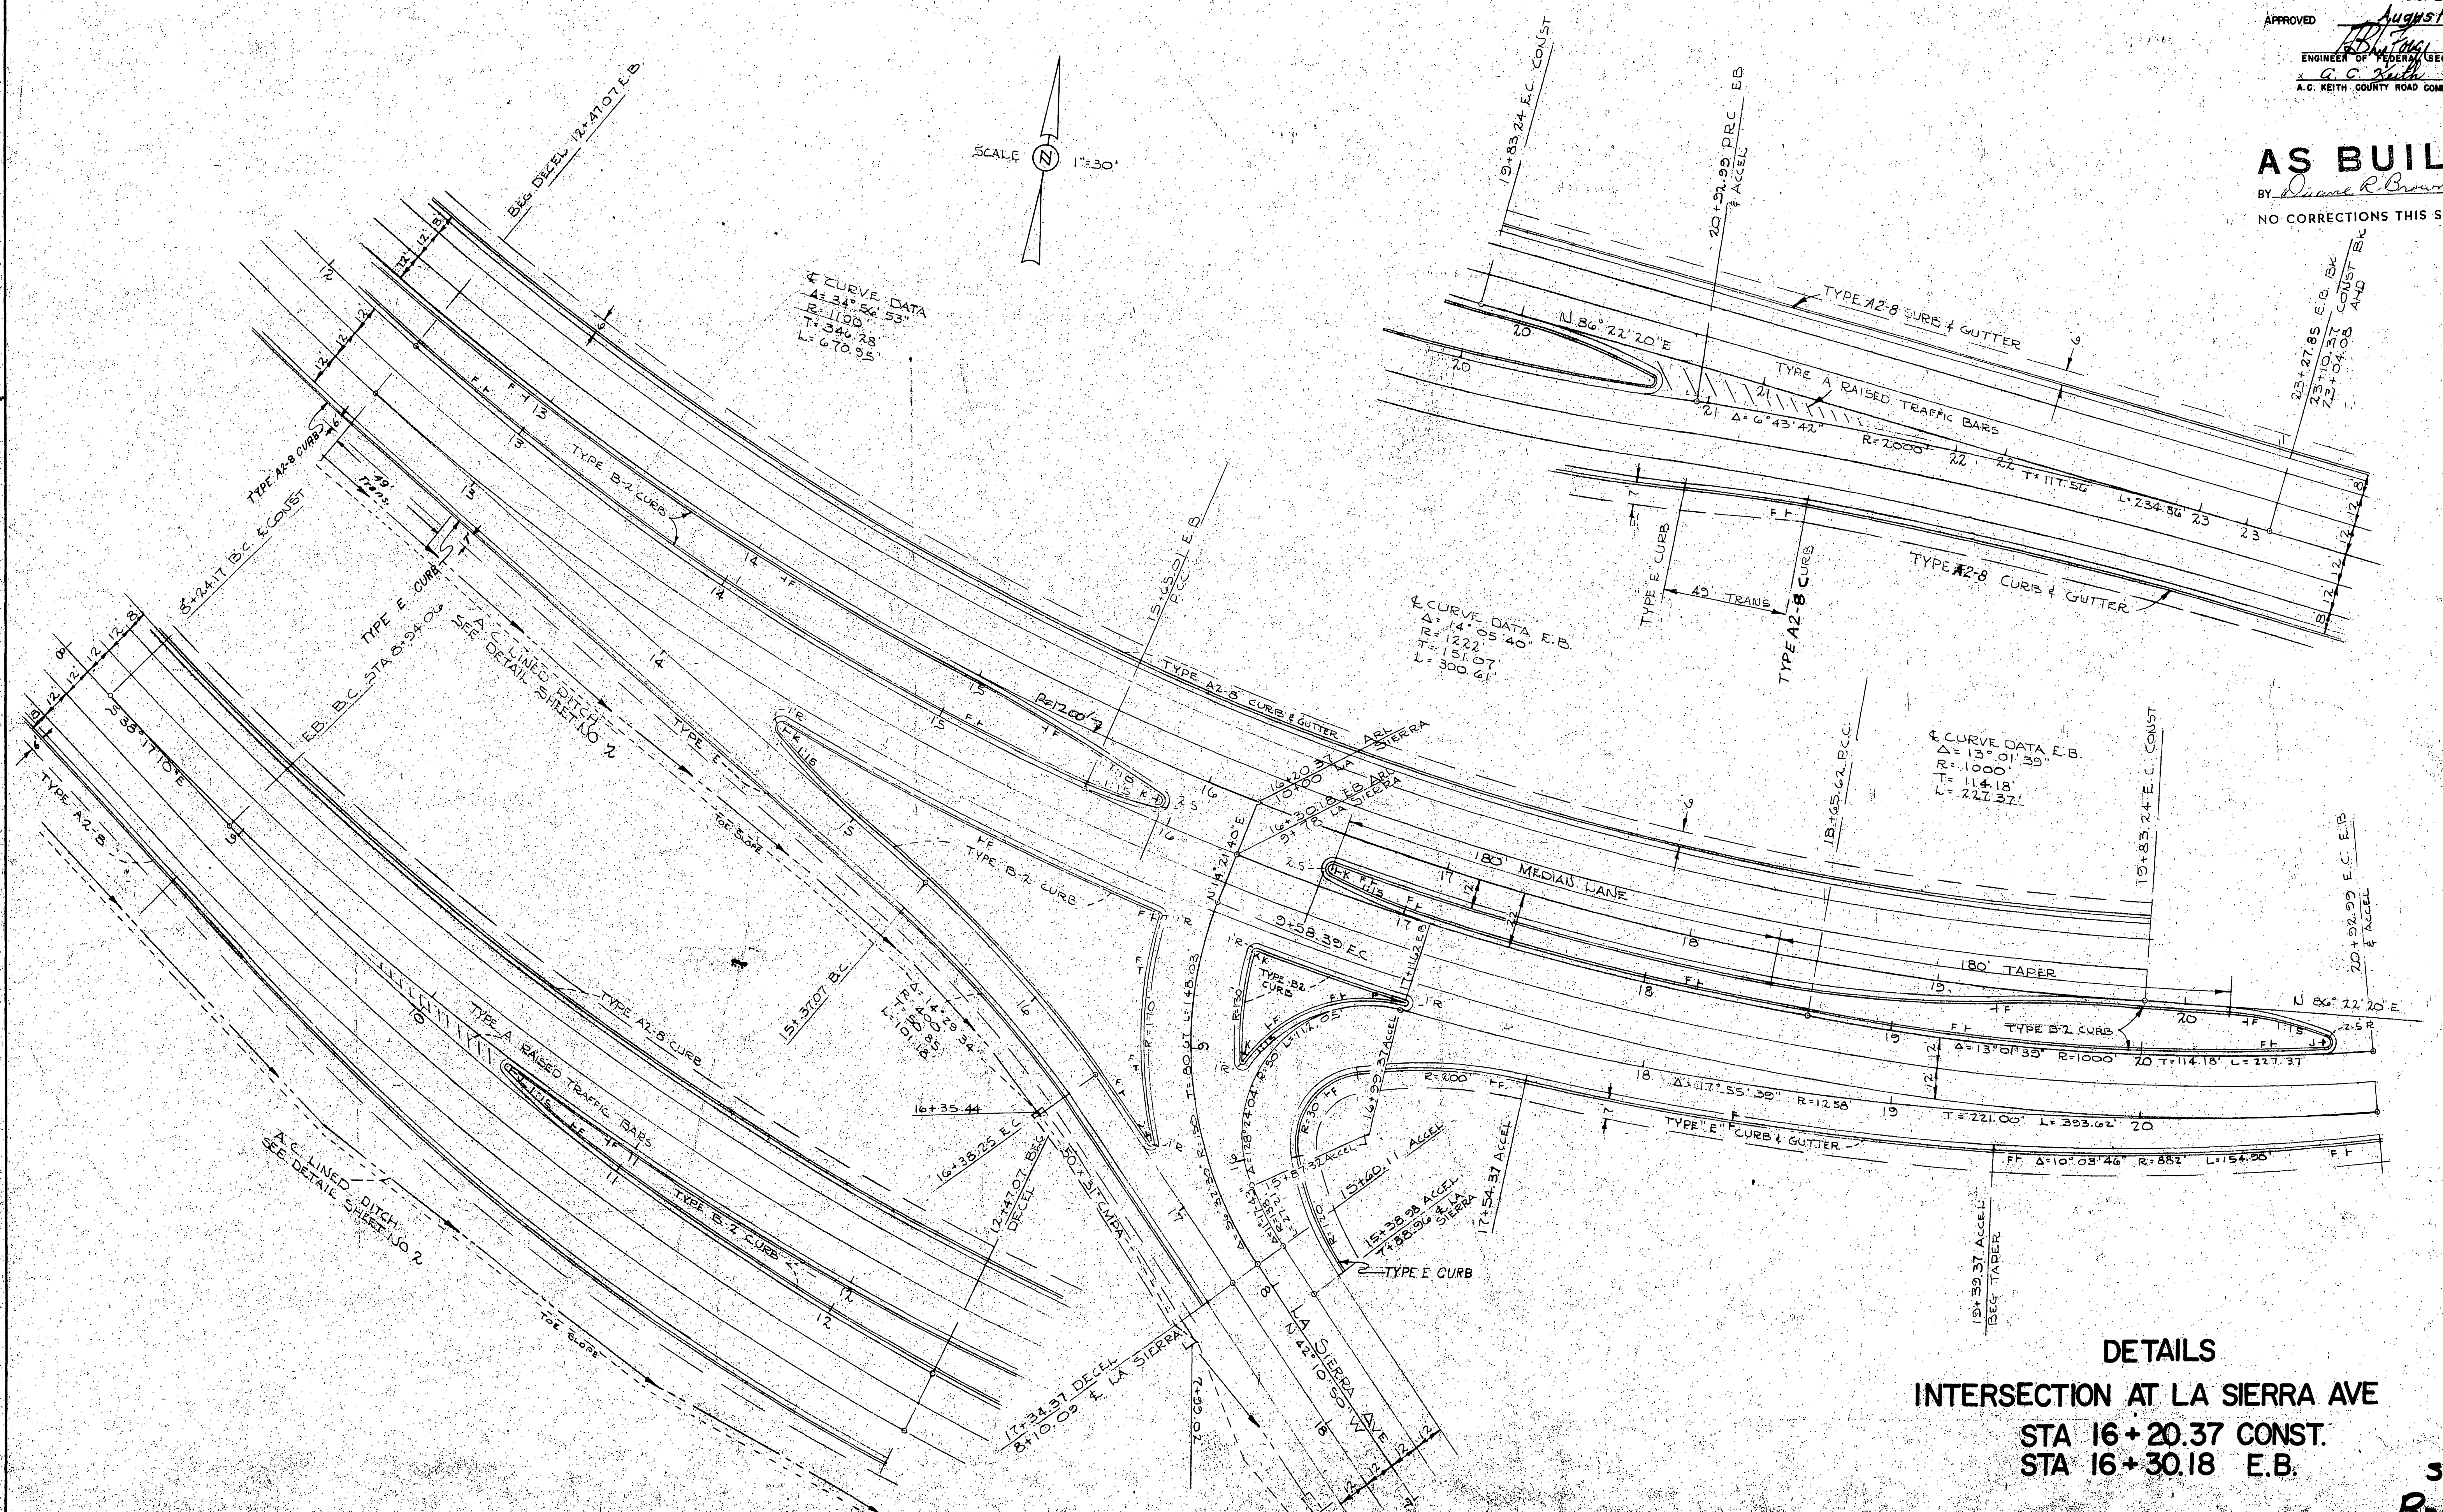

DETAILS
INTERSECTION AT LA SIERRA AVE
 STA 16+20.37 CONST.
 STA 16+30.18 E.B.


SH. 12
 R-897

12

DIST	COUNTY	ROUTE	SEC	SHEET NO.	TOTAL SHEETS
VIII	RIV.	700	(3)	13	25

APPROVED *[Signature]*
 DIST. ENG. DIST. VIII.
 August 28, 1961
[Signature]
 ENGINEER OF FEDERAL SECONDARY ROADS
 A. C. Keith, COUNTY ROAD COMMISSIONER

AS BUILT
 BY *[Signature]*
 NO CORRECTIONS THIS SHEET

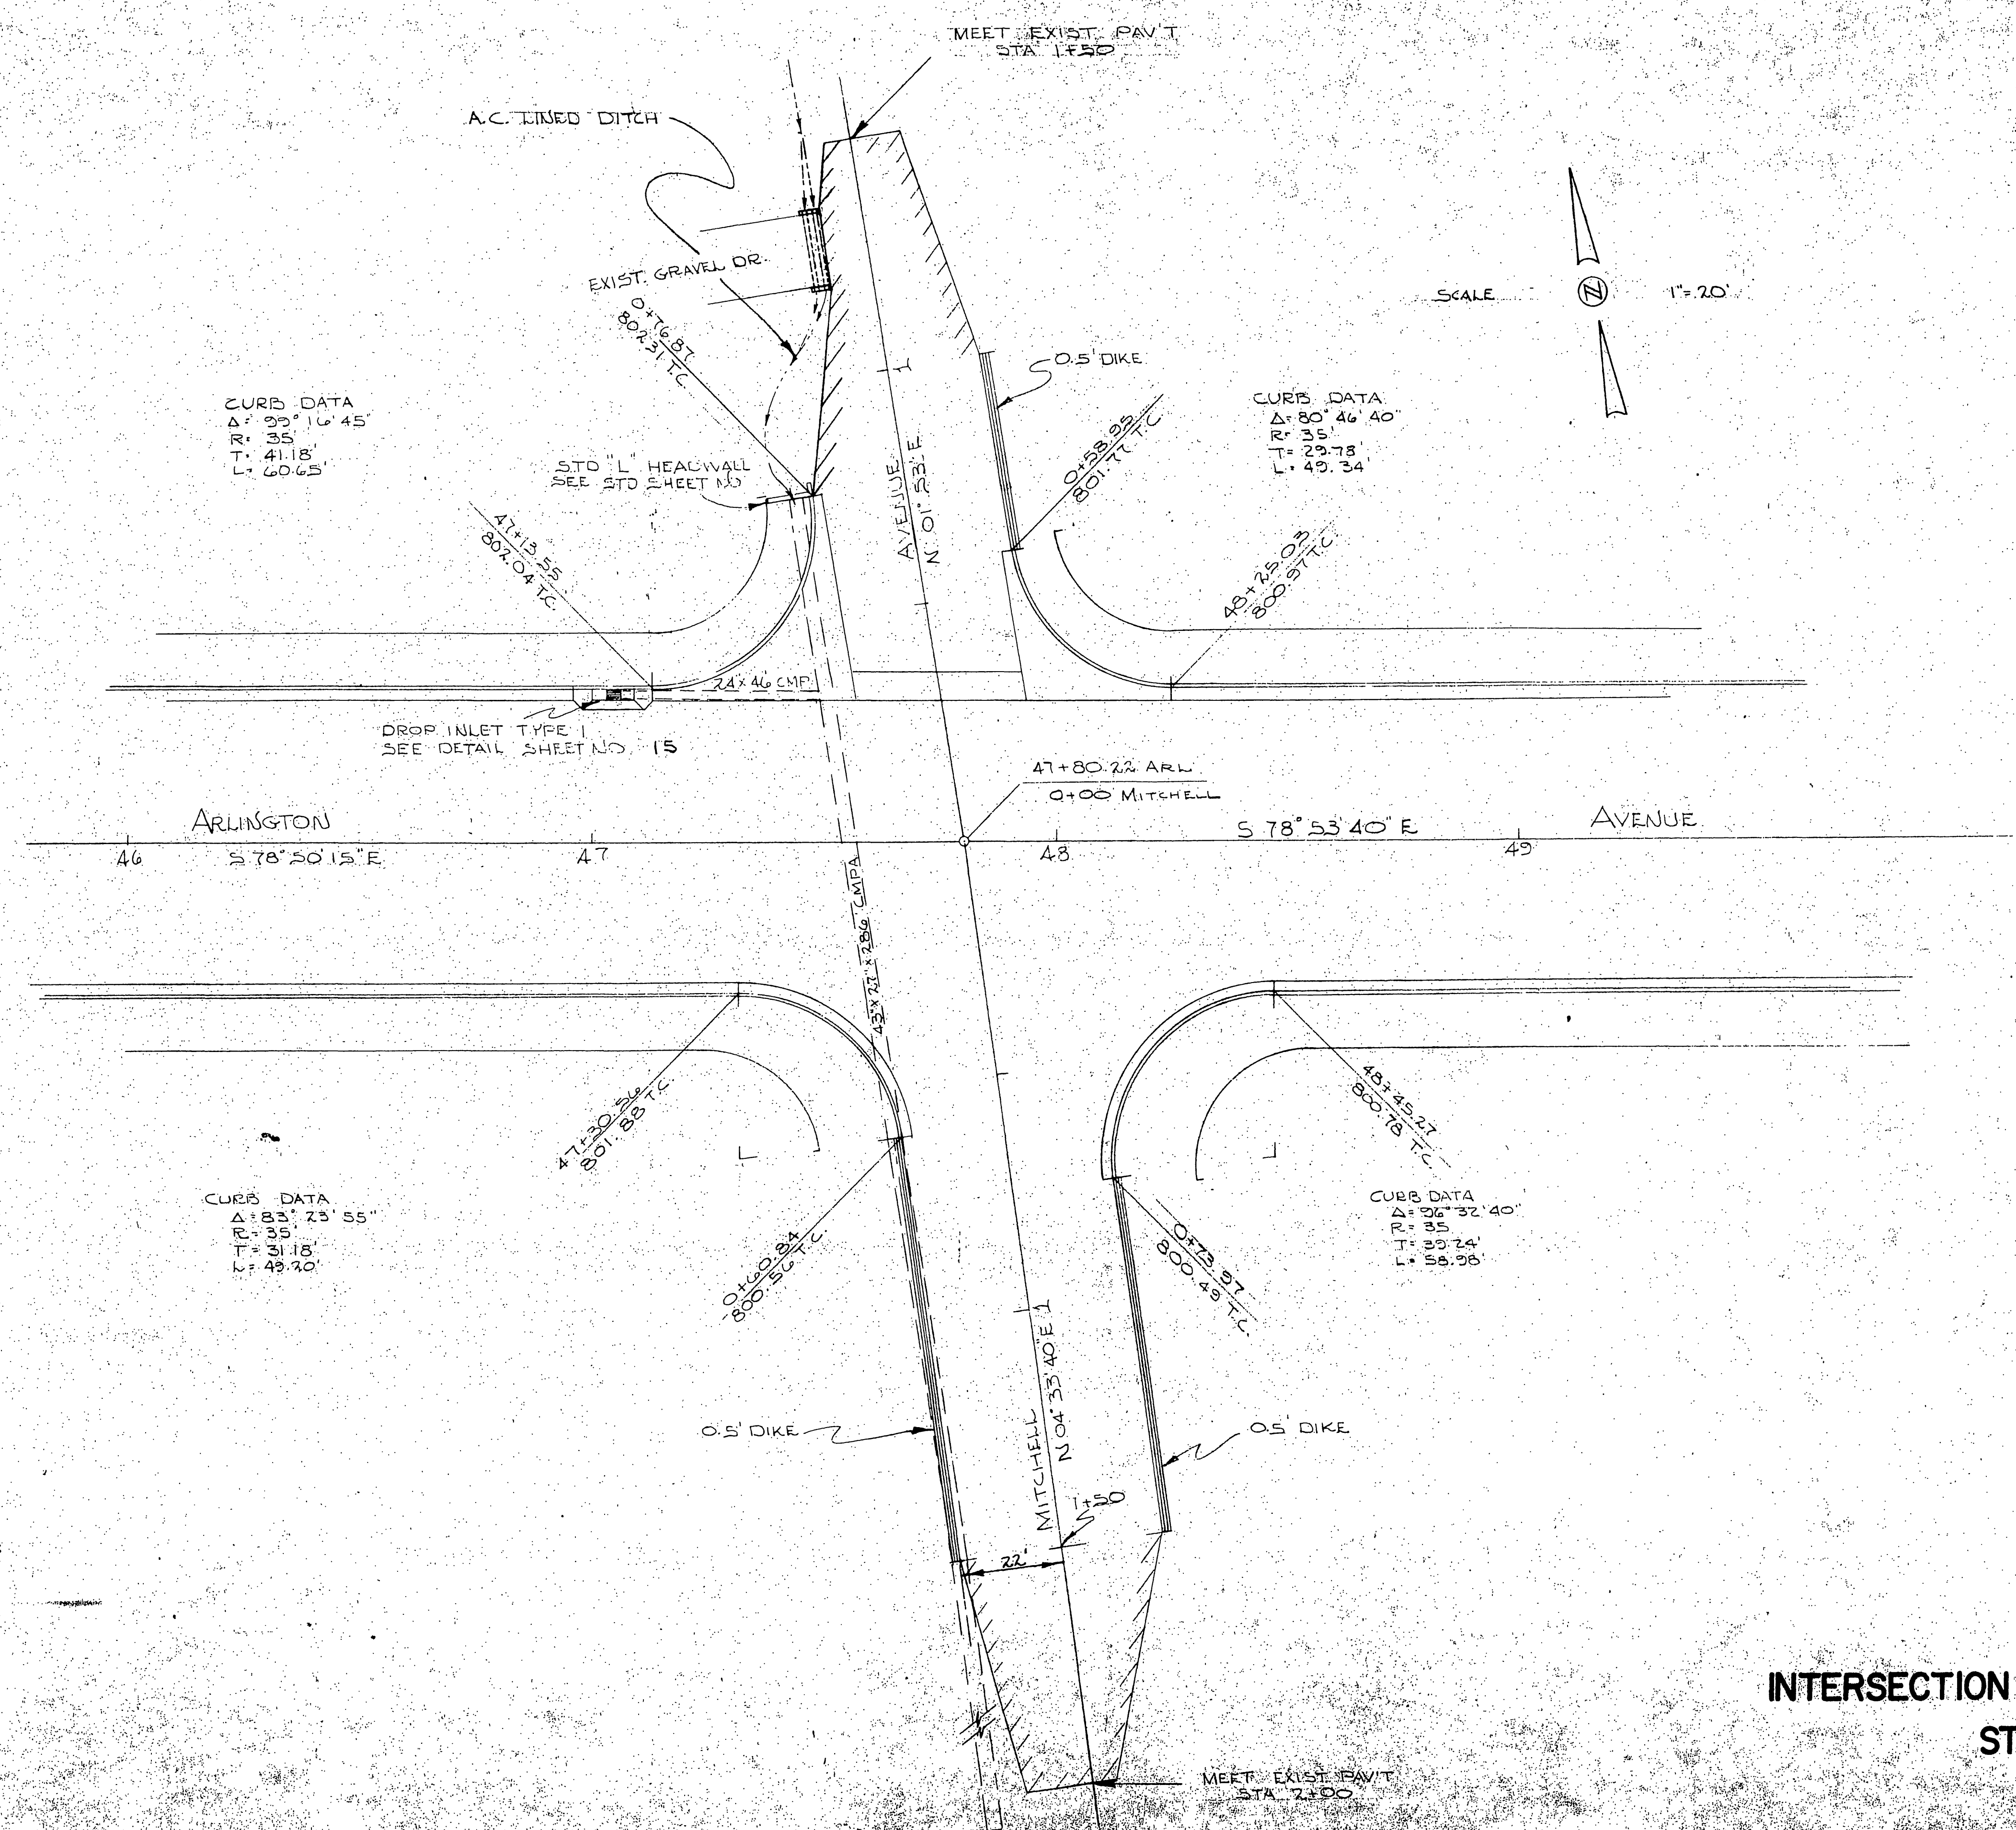

CURB DATA
 $\Delta = 33^{\circ} 16' 45''$
 $R = 35'$
 $T = 41.18'$
 $L = 60.65'$

CURB DATA
 $\Delta = 80^{\circ} 46' 40''$
 $R = 35'$
 $T = 29.78'$
 $L = 49.34'$

CURB DATA
 $\Delta = 83^{\circ} 23' 55''$
 $R = 35'$
 $T = 31.18'$
 $L = 49.70'$

CURB DATA
 $\Delta = 96^{\circ} 32' 40''$
 $R = 35'$
 $T = 29.74'$
 $L = 58.98'$

DETAILS
 INTERSECTION AT MITCHELL AVENUE
 STA. 47+80.22


SH. 13

R-897

DIST	COUNTY	ROUTE	SEC	SHEET NO	TOTAL SHEETS
VIII	RIV	700	(3)	14	25

APPROVED *[Signature]*
 DIST ENG DIST VIII
 August 28, 1961
 ENGINEER OF FEDERAL SECONDARY ROADS
 A. C. Keith
 COUNTY ROAD COMMISSIONER

AS BUILT
 BY *[Signature]*
 NO CORRECTIONS THIS SHEET

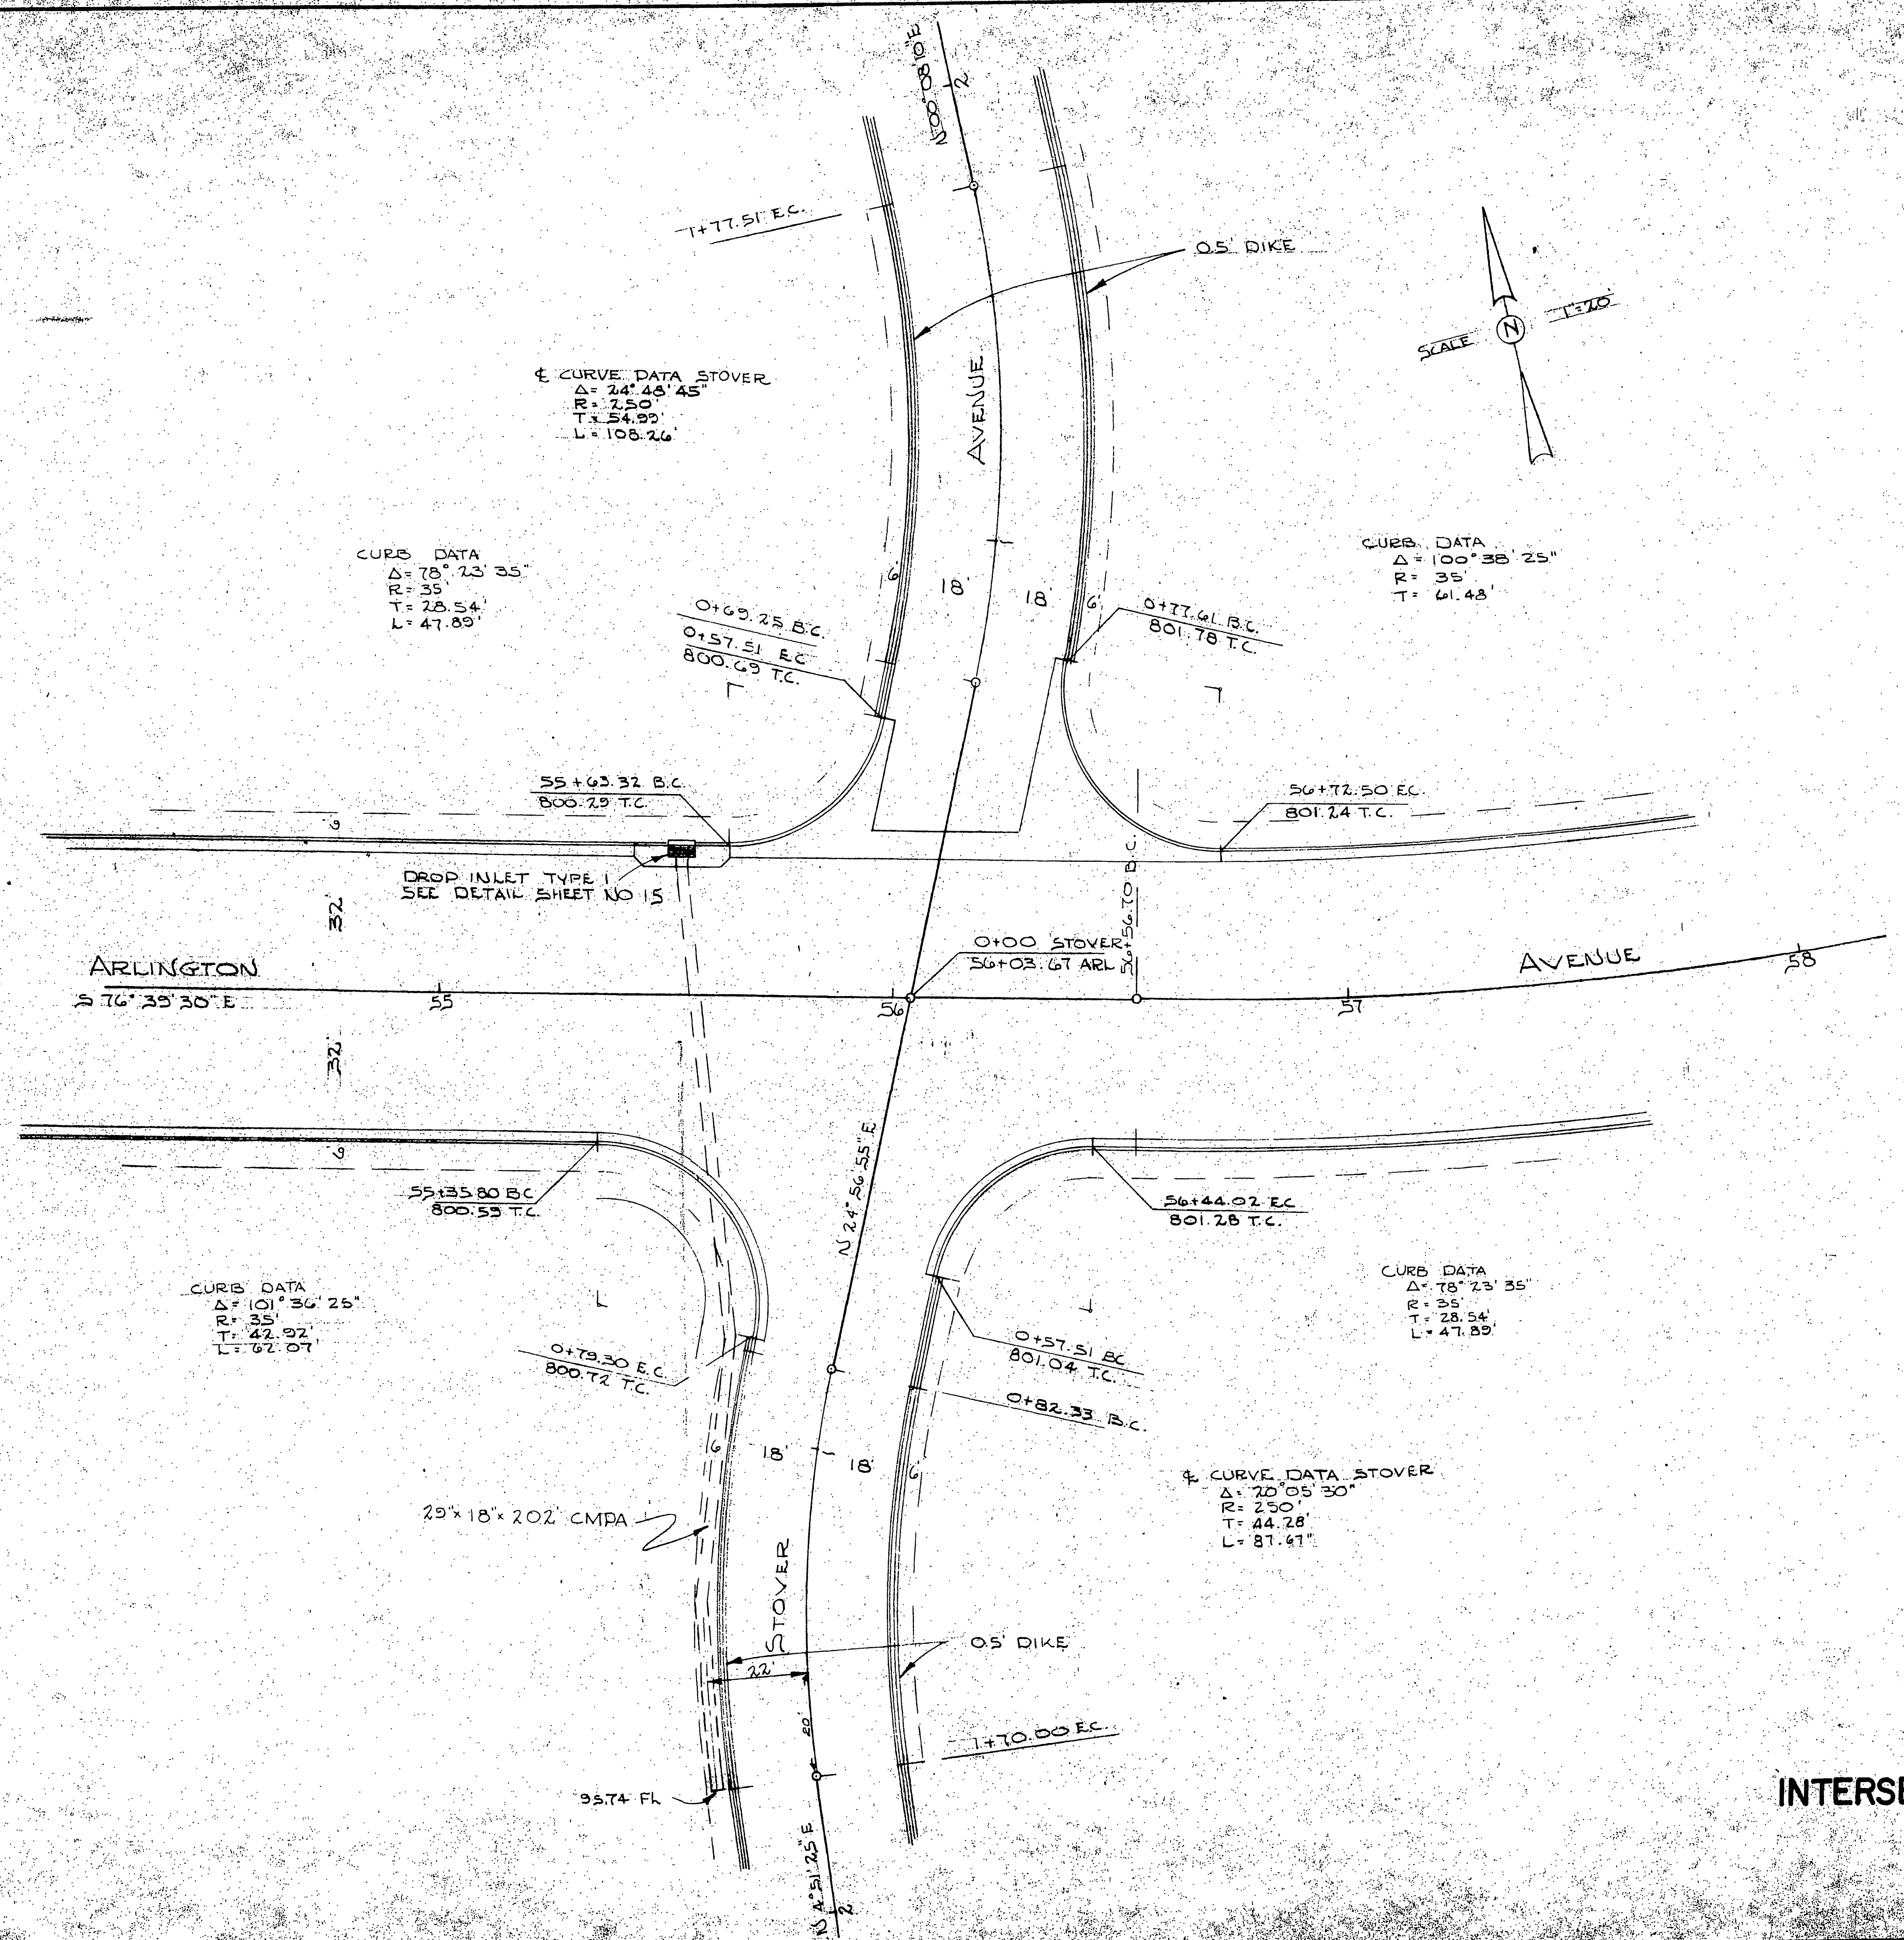

DETAILS
INTERSECTION AT STOVER AVENUE
STA 56+03.67

SH. 34
 R-897


4

Blair
 BRIDGE ENGINEER - CIVIL ENGINEER - LICENSE 8887
 APPROVED


W. K. ...
 DIST. ENG. DIST. VIII
 APPROVED August 28, 1961

A. C. Keith
 A. C. KEITH, COUNTY ROAD COMMISSIONER



AS BUILT
 BY *Duane R. Brown*
 NO CORRECTIONS THIS SHEET

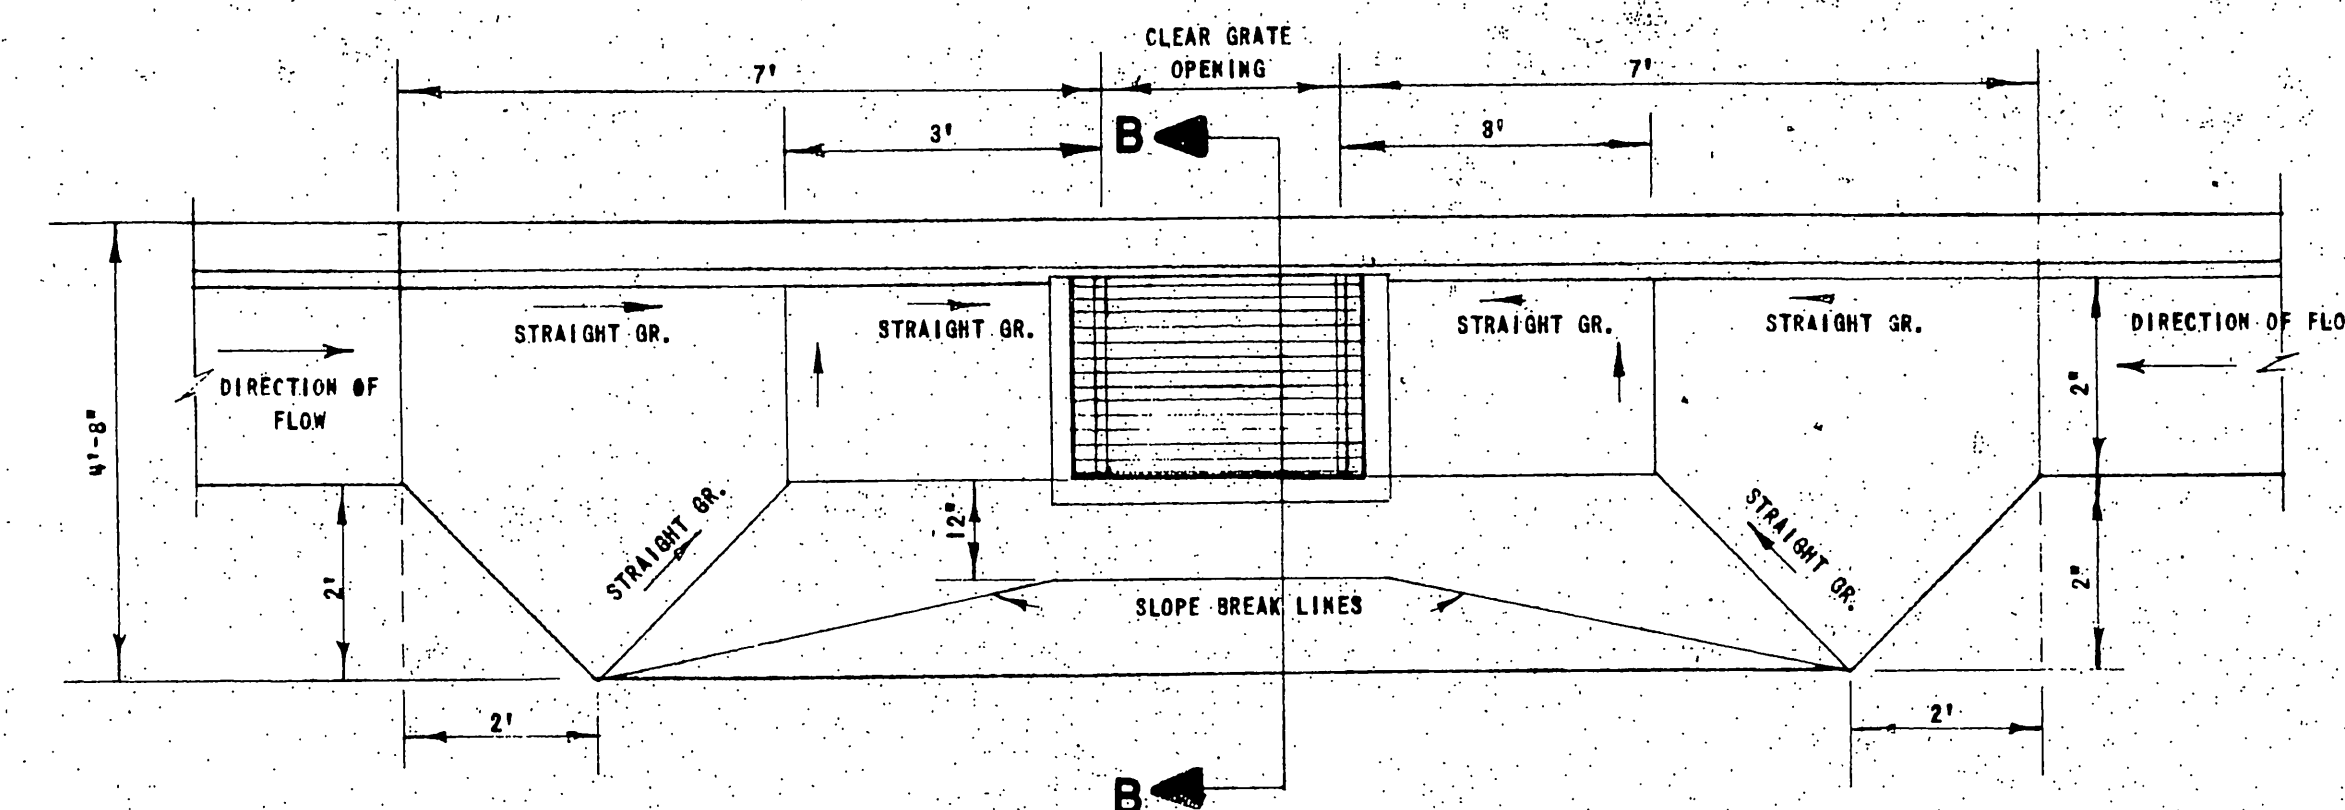


GUTTER DEPRESSION - SINGLE DROP INLET

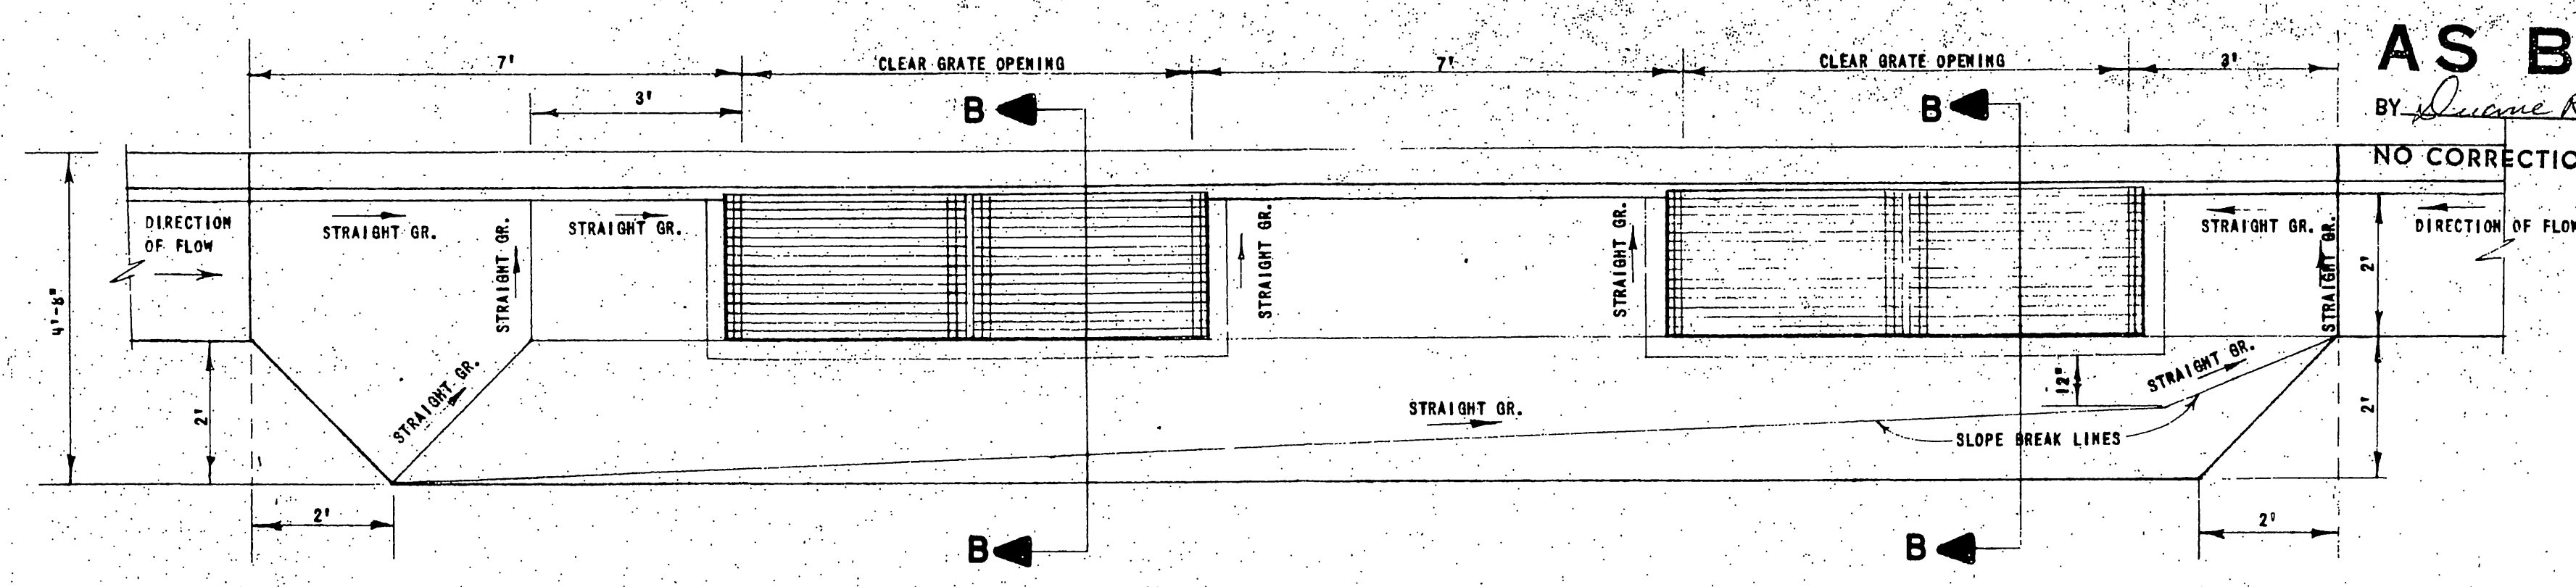



GUTTER DEPRESSION - TWO OR MORE DROP INLETS

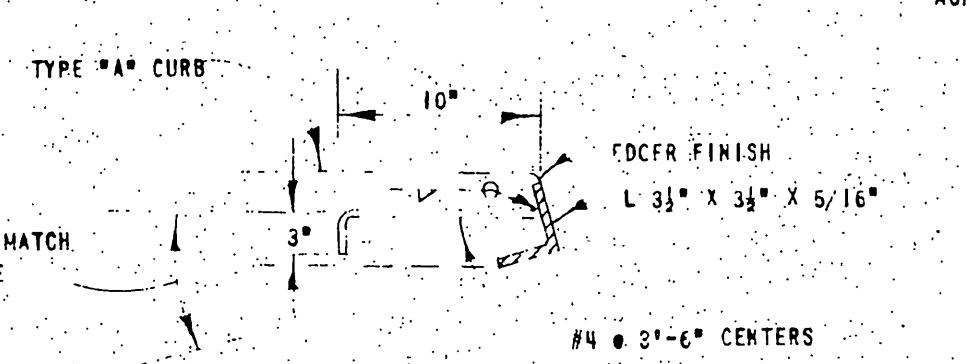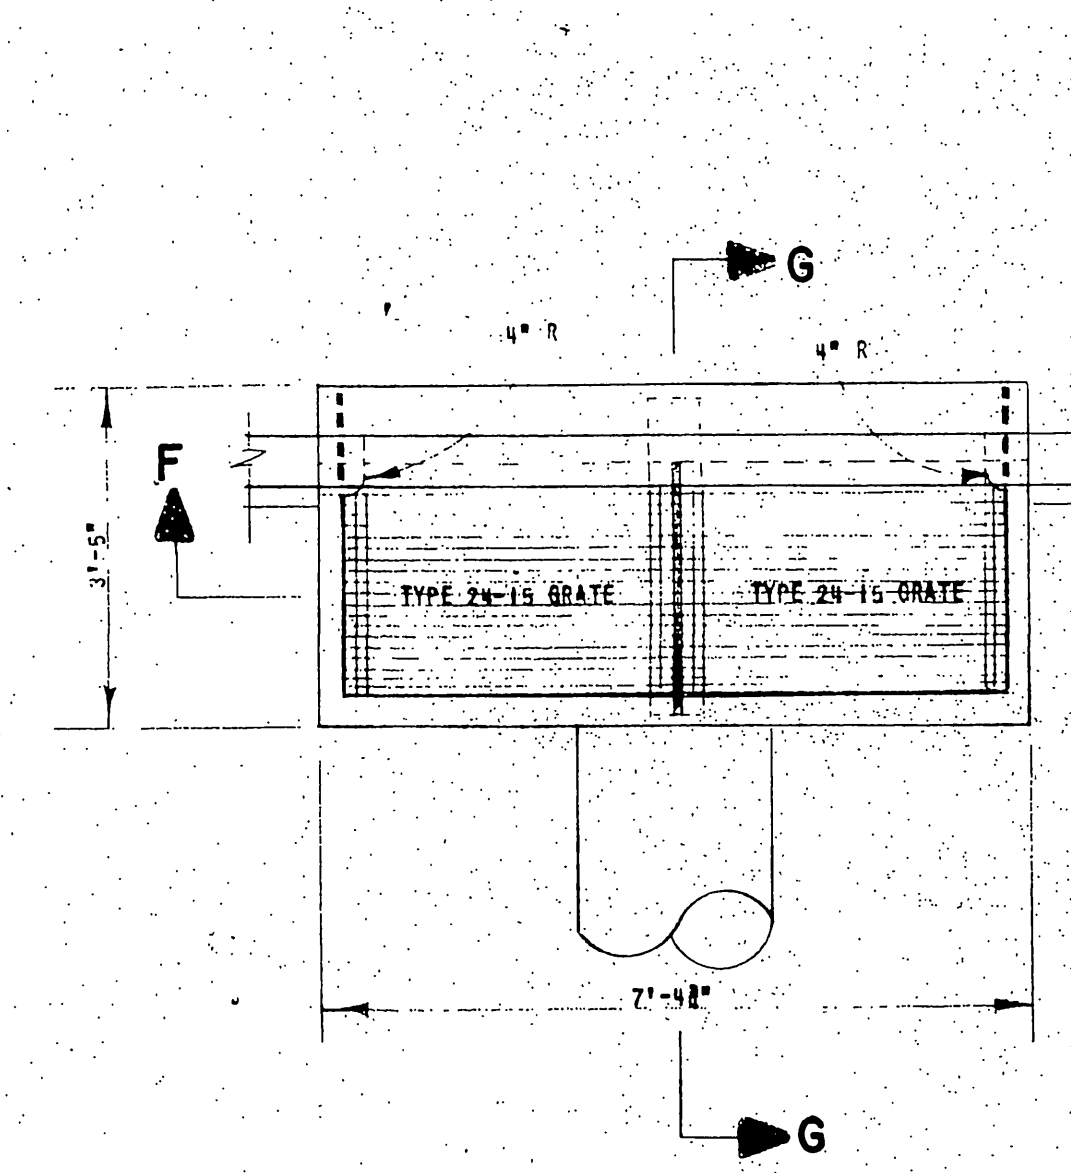


FACE ANGLE DETAIL

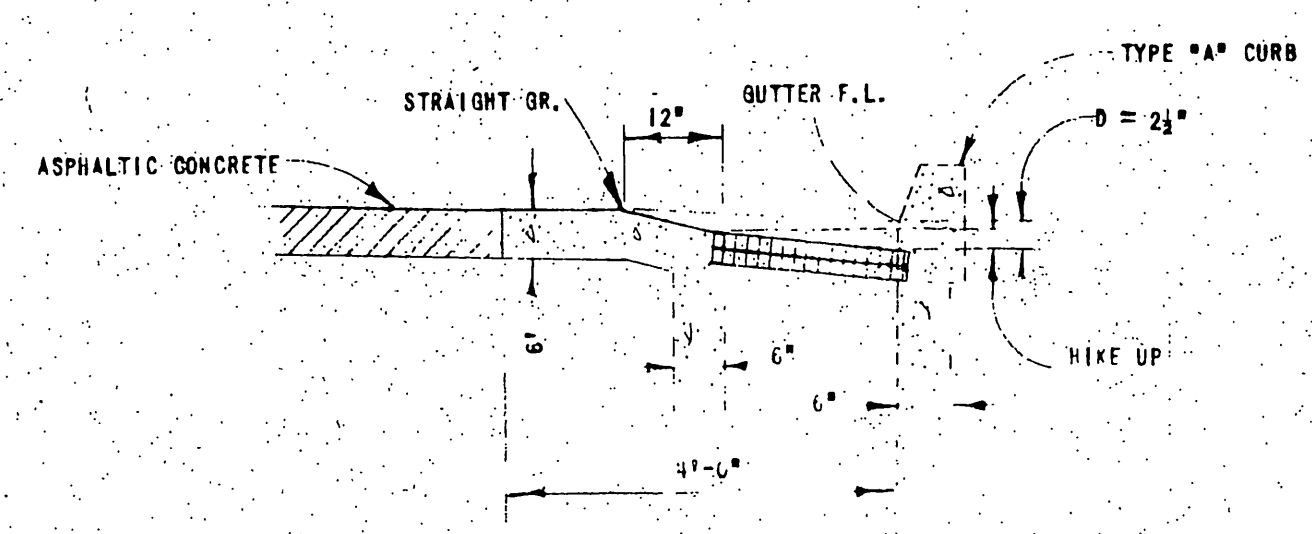

SECTION B-B

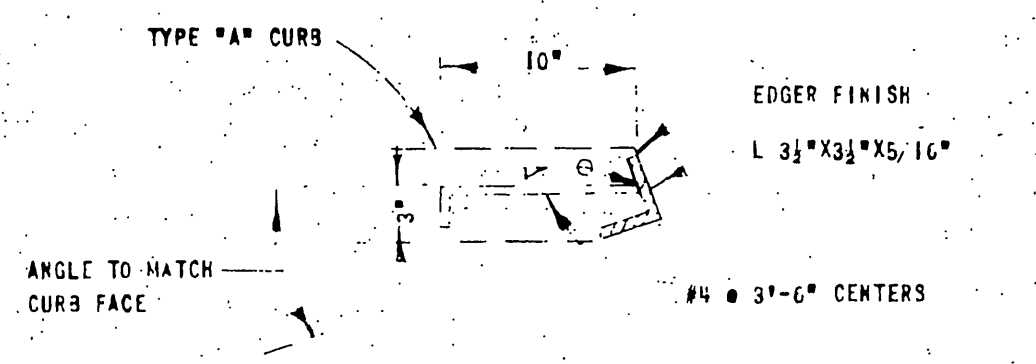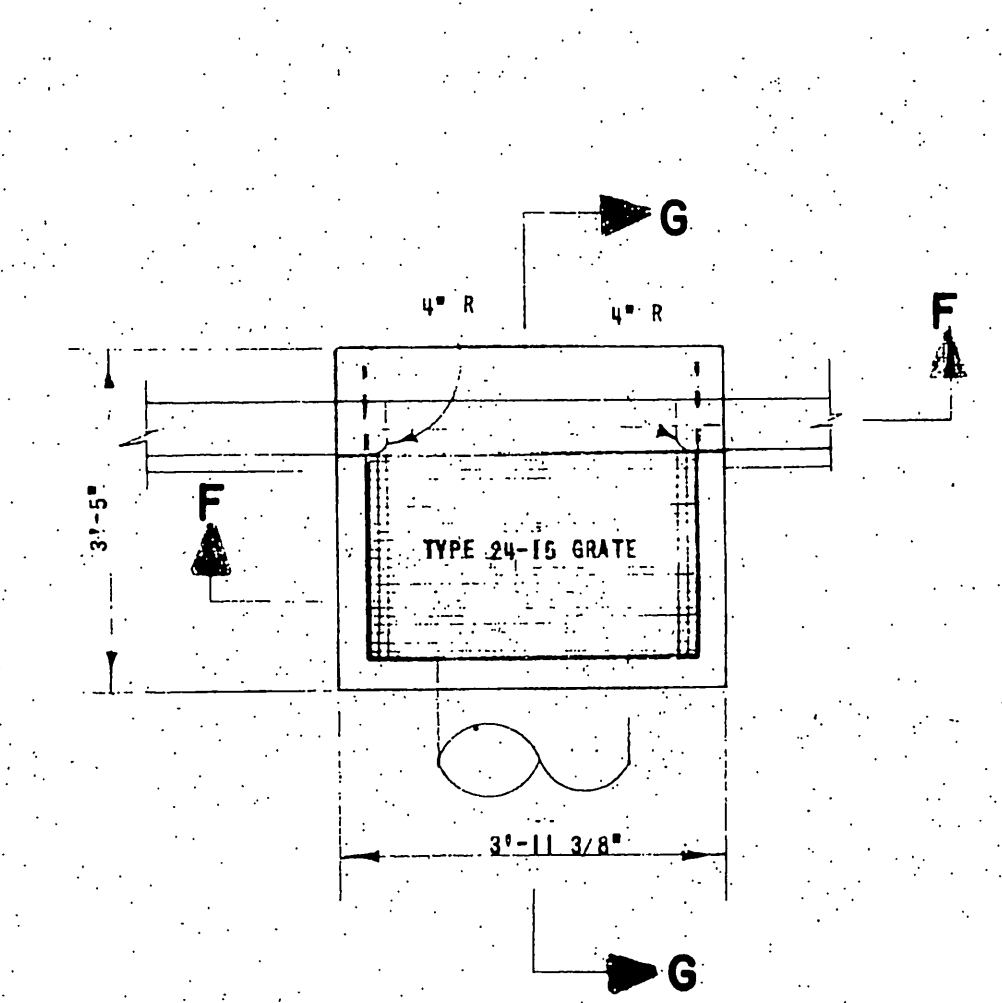

FACE ANGLE DETAIL

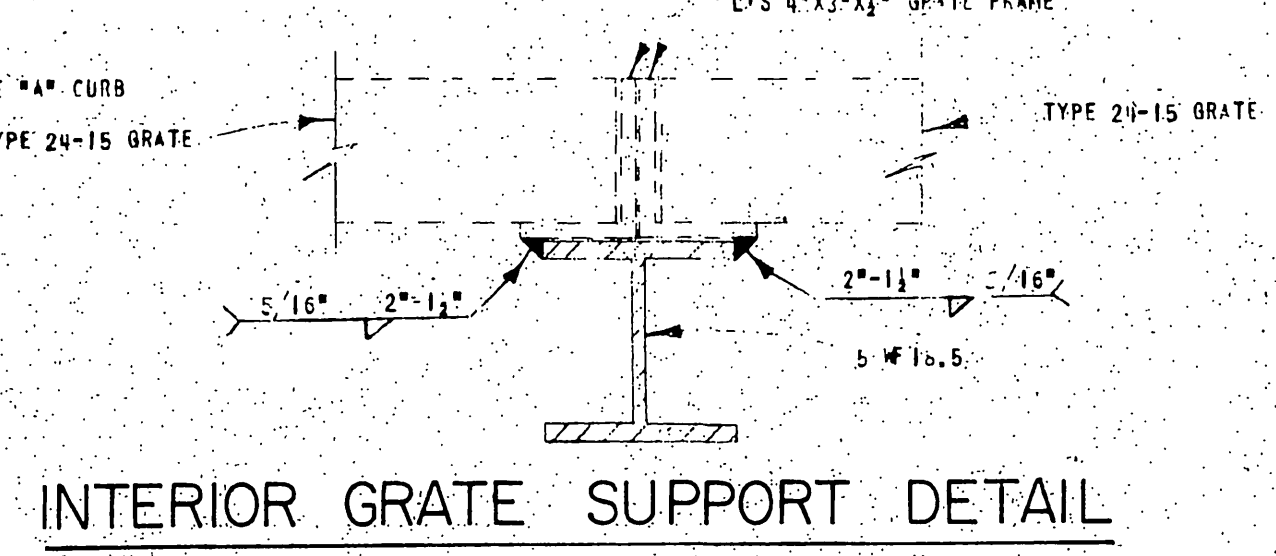

INTERIOR GRATE SUPPORT DETAIL

GENERAL NOTES

REINFORCING SHALL BE #4 BARS @ 18" ± CENTERS PLACED 12" CLEAR TO INSIDE OF BOX UNLESS OTHERWISE SHOWN.

STEPS - NONE REQUIRED WHERE H IS 3'-6" OR LESS. INSTALL ONE STEP 16" ABOVE FLOOR WHEN H IS MORE THAN 3'-6" AND LESS THAN 5'-0". WHERE H IS MORE THAN 5'-0" STEPS SHALL BE EVENLY SPACED AT 16" INTERVALS FROM 16" ABOVE FLOOR TO WITHIN 12" OF TOP OF BOX.

PIPE OR PIPES CAN BE PLACED IN ANY WALL.

EXCEPT FOR INLETS USED AS JUNCTION BOXES, BASIN FLOORS SHALL HAVE A MINIMUM SLOPE OF 12:3 FROM ALL DIRECTIONS TOWARD OUTLET PIPE AND SHALL HAVE A WOOD TROWEL FINISH.


CURB SECTION SHALL MATCH ADJACENT CURB.

ALTERNATIVE REINFORCED FLOOR WHEN DIRECTED BY THE ENGINEER.


GALVANIZING: SEE STANDARD SPECIFICATIONS OR SPECIAL PROVISIONS.

NO DEDUCTION IN STRUCTURE CONCRETE QUANTITIES WILL BE MADE FOR PIPE WALL THICKNESS.

SEE "STANDARD GRATE DETAILS" 077 FOR GRATE AND FRAME DETAILS.

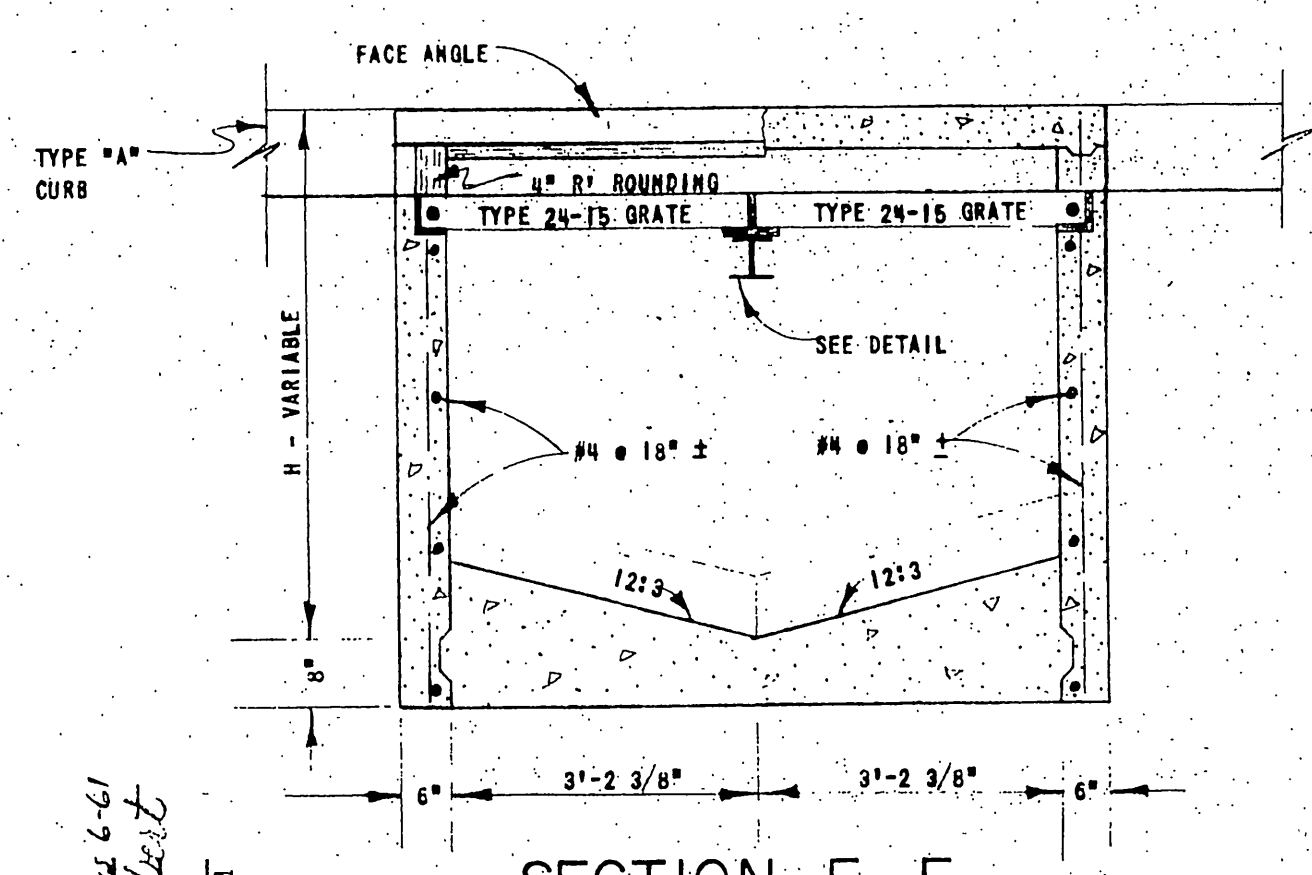


SECTION F-F

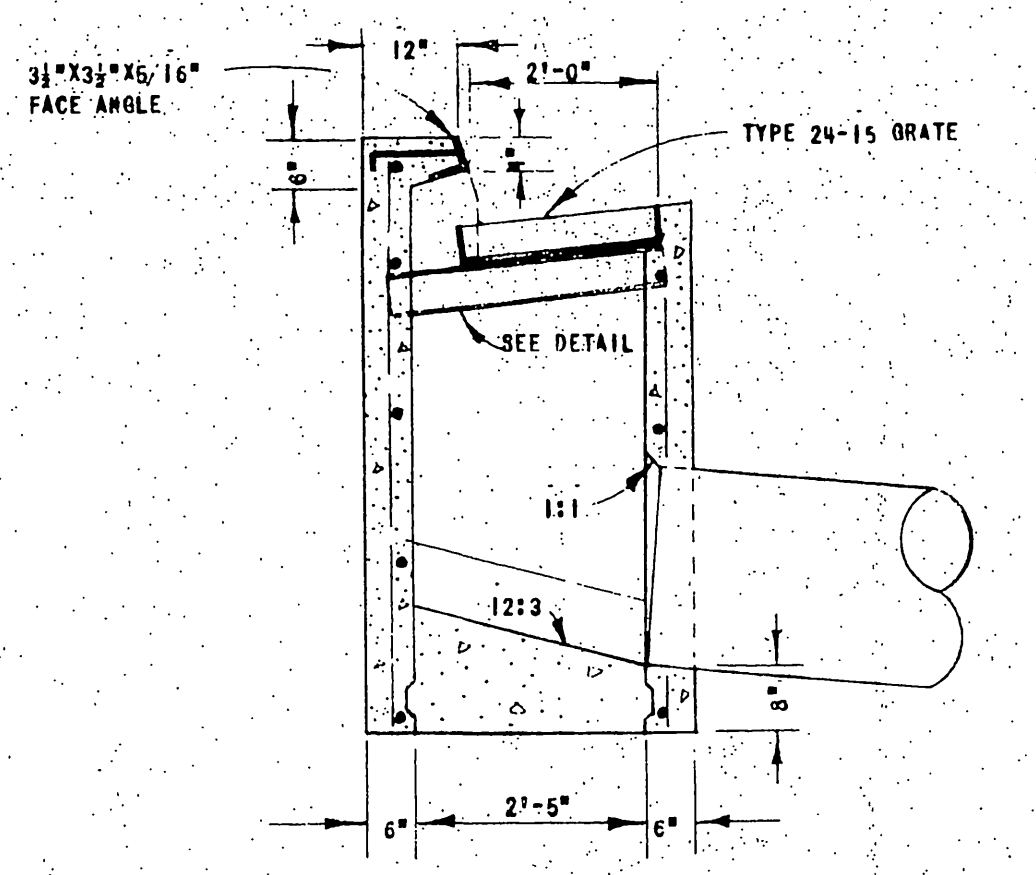


SECTION G-G

DROP INLET TYPE I

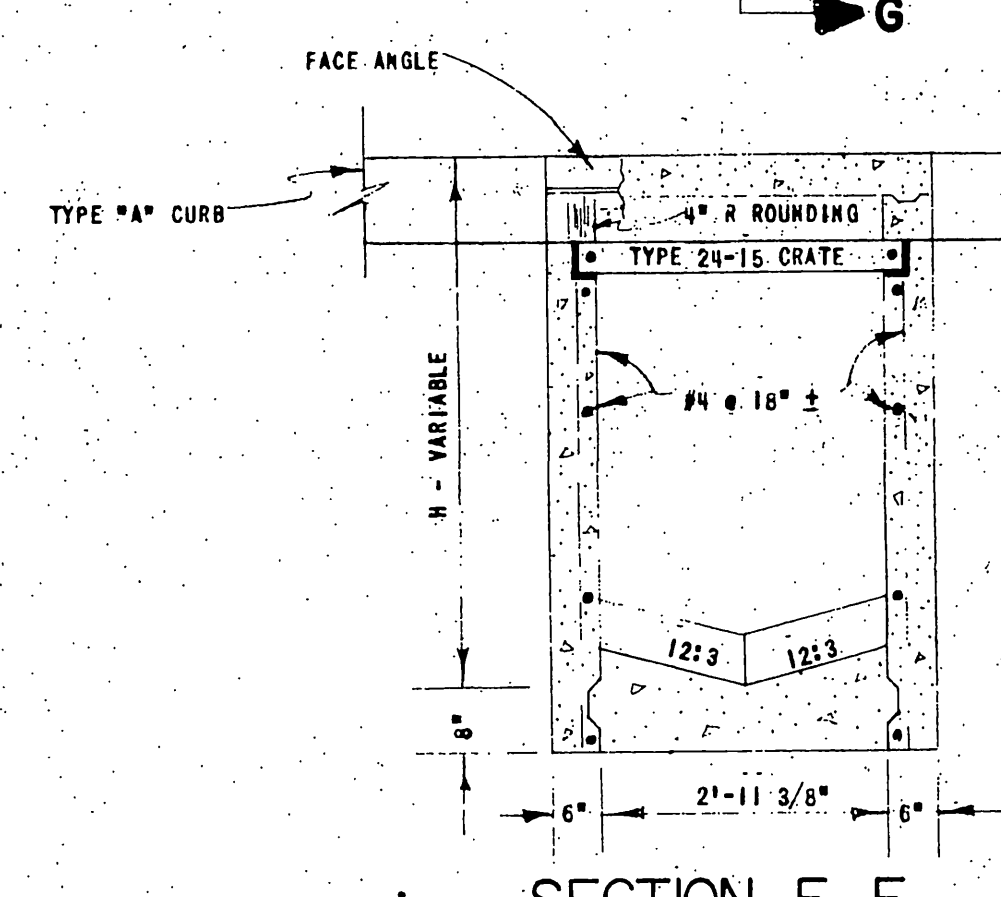

SECTION F-F

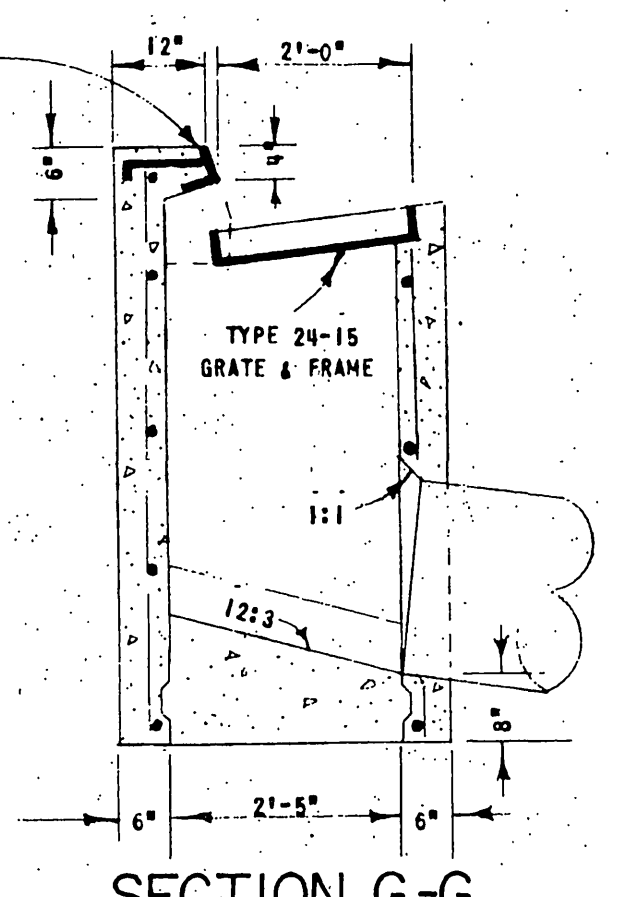

SECTION G-G

DROP INLET TYPE 2




MINOR
 DRAINAGE STRUCTURE DETAILS
 VIII - RIV - 700

Structural Details
 Checked By *Silvestro 6-61*
 Revised *W. K. ...*
 Approval Recommended


To accompany plans dated August 28, 1961

DISTRICT	COUNTY	ROUTE	SECTION	SHEET NO.	TOTAL SHEETS
VIII	Riv	700 (3)		17	25

Approval Recommended
 Assistant State Highway Engineer - Bridges
 Assistant State Highway Engineer - Operations
 Approved June 30, 1960
 State Highway Engineer
 Civil Engineer License No. 5945

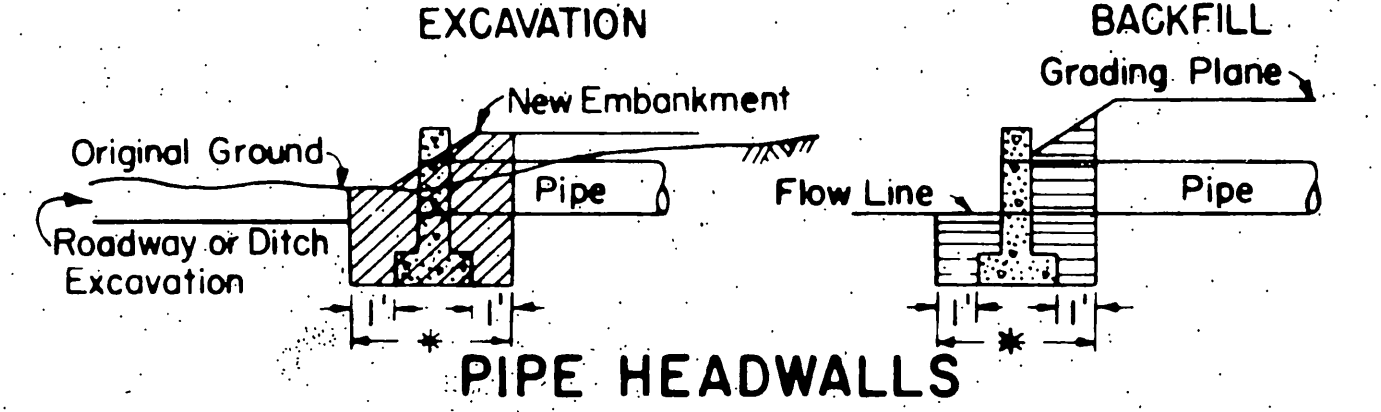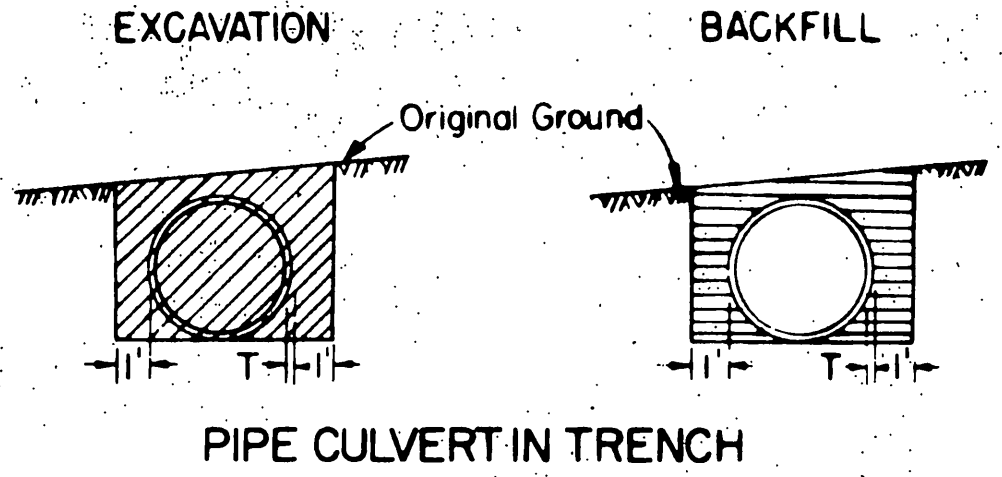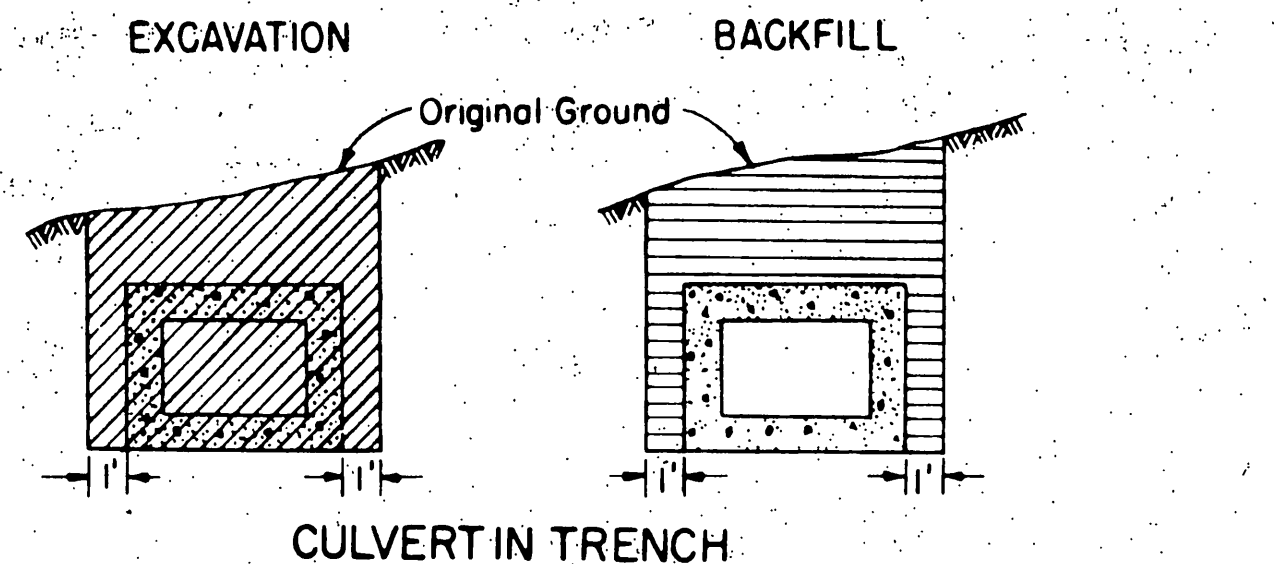


* When concrete is being paid for as Class A Concrete (Minor Structure) the cost of Excavation and Backfill is included in the price paid for Class A Concrete (Minor Structure).

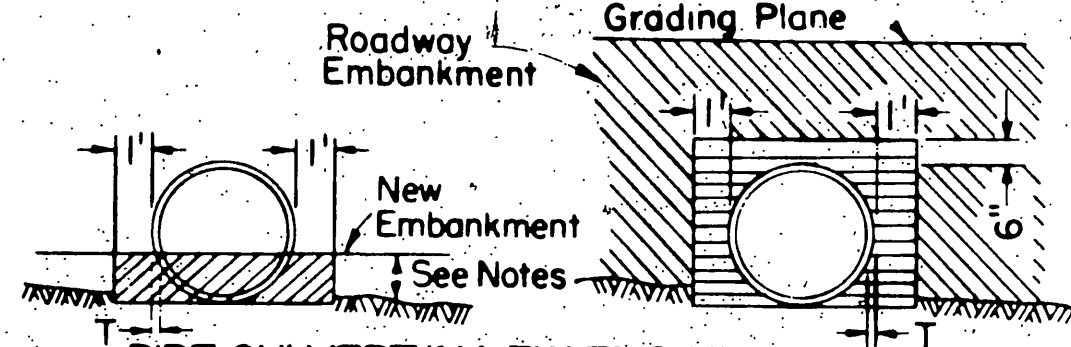





Height of Top of Embankment Before Excavating for Pipe Shall Be As Follows

- For pipe 24" dia or less: 6" above top of pipe, or 30" max.
- For C.M.P. over 24" to 90" dia.: 30" above bottom of pipe.
- For C.M.P. over 90" dia.: 1/3 point of dia. above bottom of pipe.
- For R.C.P. over 24" dia.: 30" above bottom of pipe.
- For field assembled plate culvert: 1/3 point of dia. above bottom of pipe.
- Structure Backfill 6" above top of pipe.
- For payment quantities excavation and backfill concrete pipe T = min. wall thickness as shown in A.A.S.H.O. M170 for Class III Pipe, Wall A.
- For C.M.P. T = 0.00



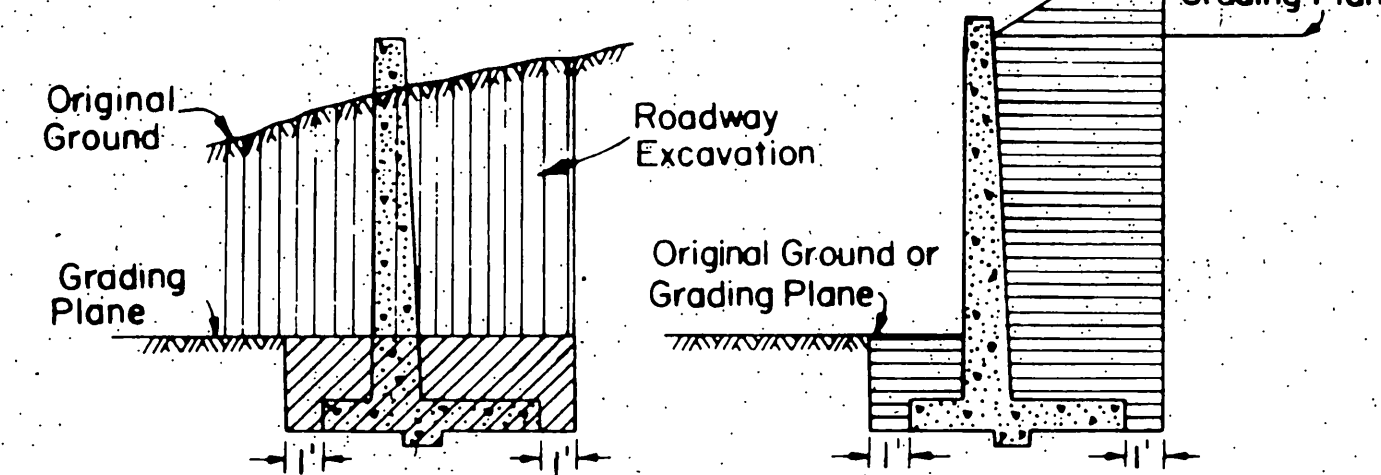


Note: If no roadway excavation is involved at the wall Structure excavation will be measured from the original ground.


PIPE CULVERTS, RODS & DEADMEN
 Except Underdrains & Overside Drains

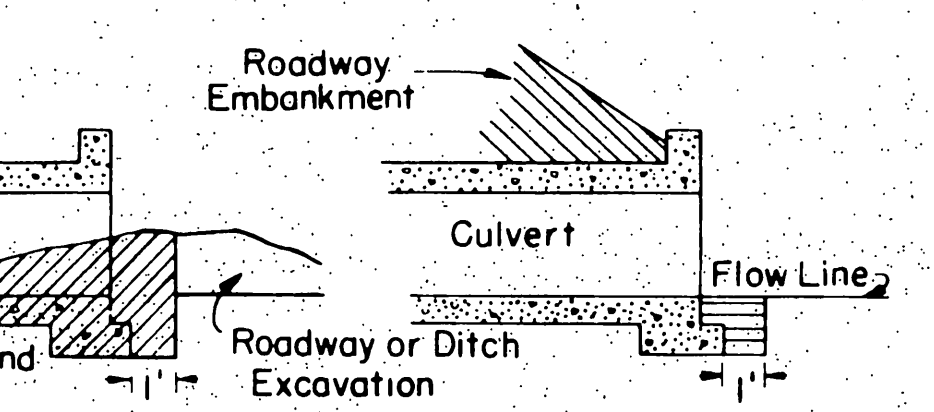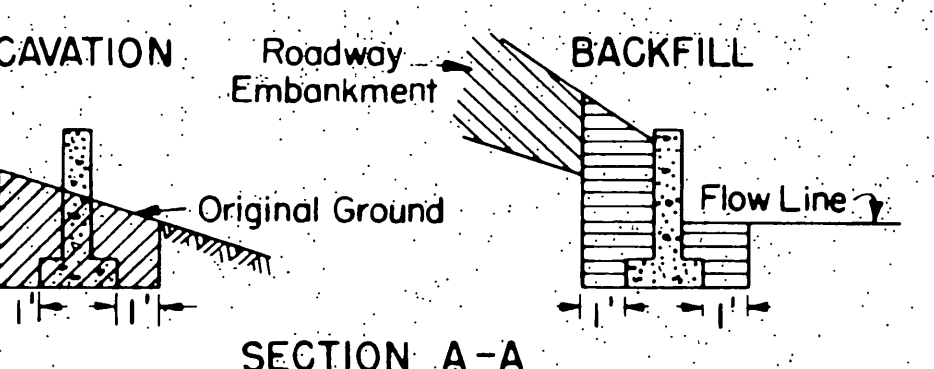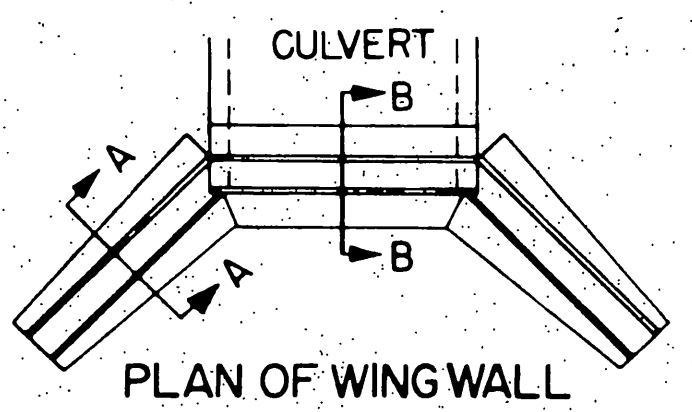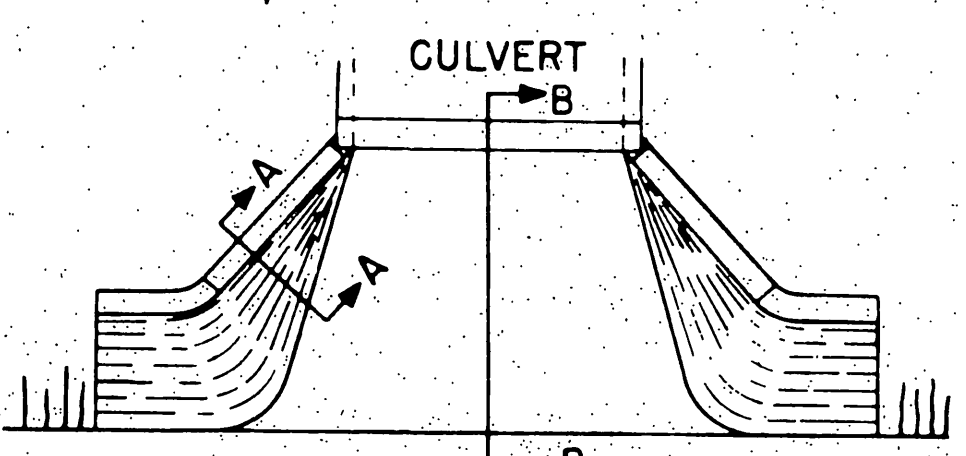




WING WALLS

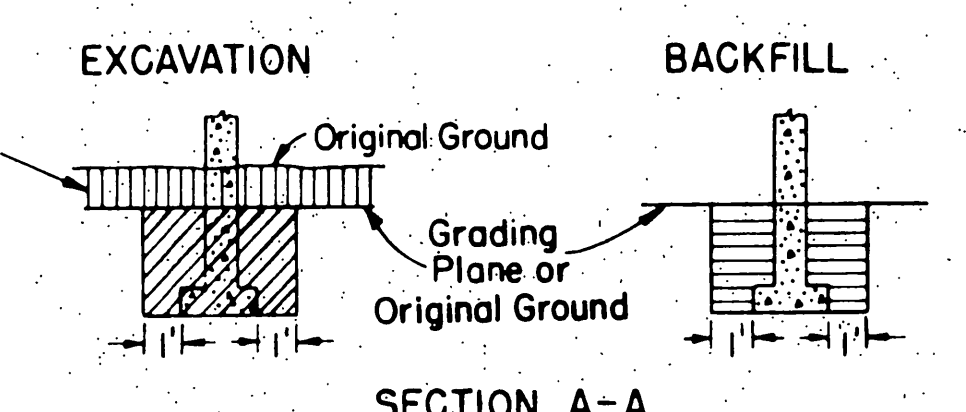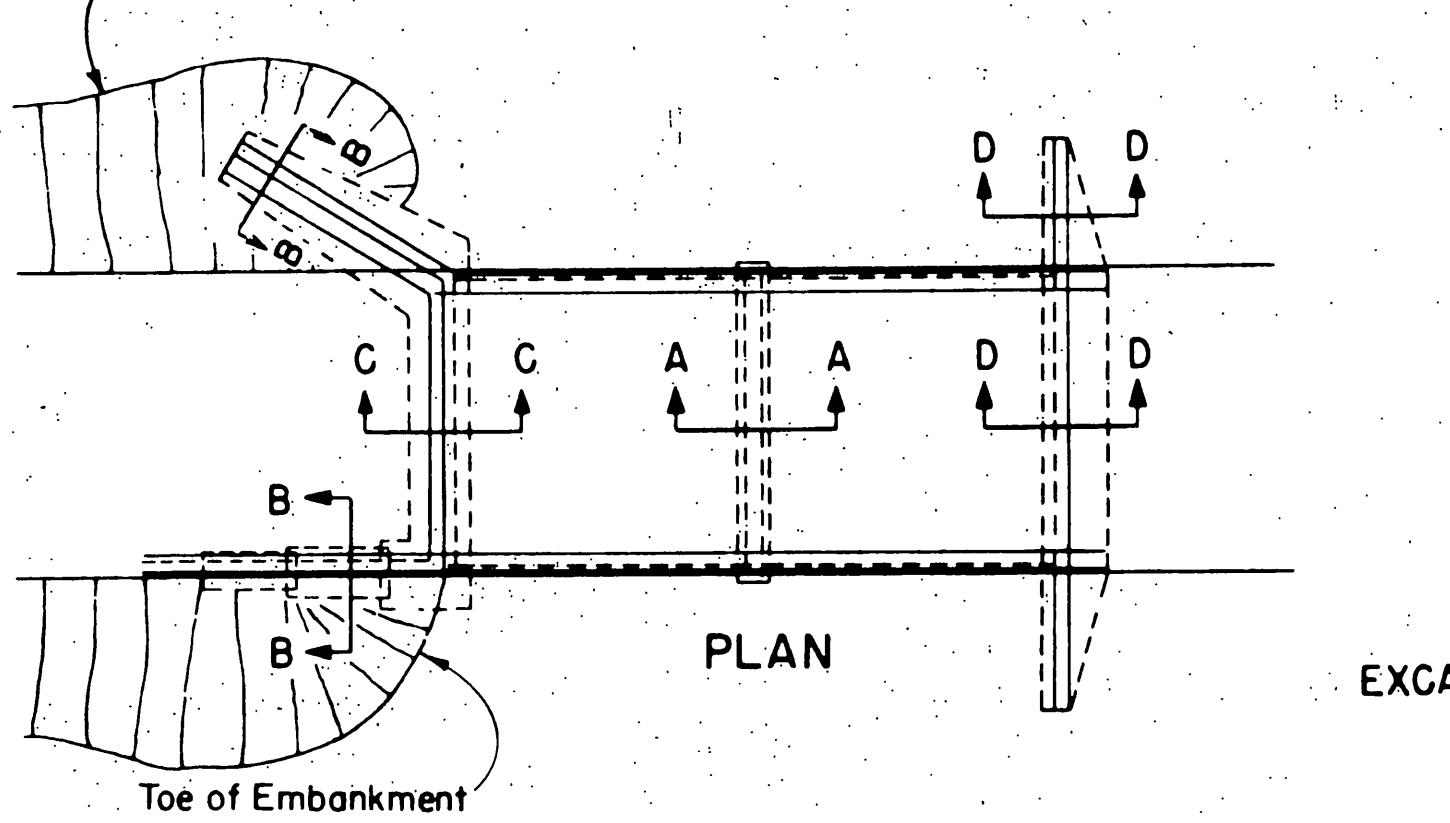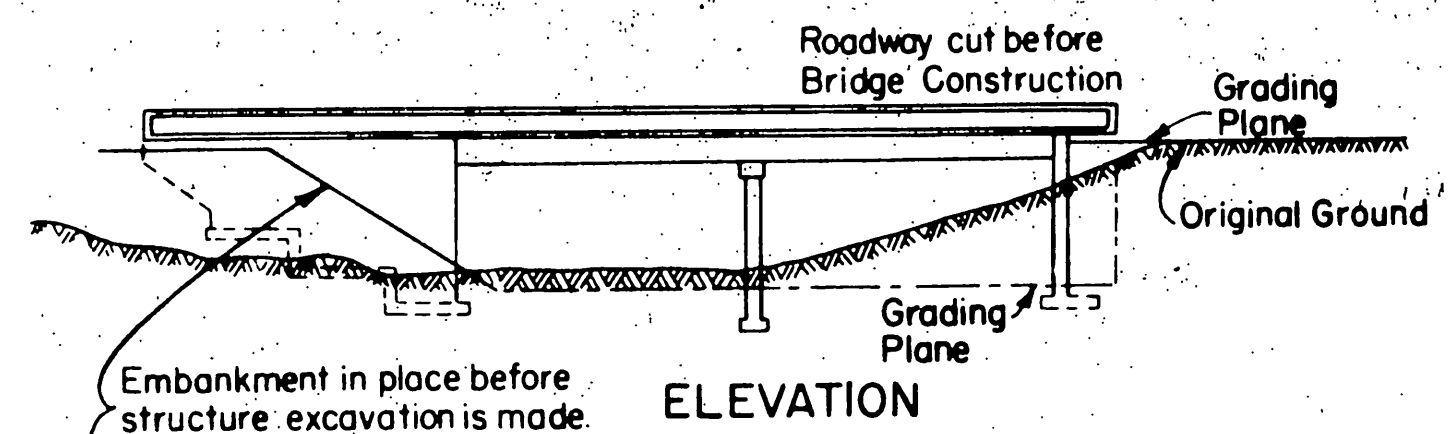

When bridge piers are in water course, quality and compaction requirements for backfill will be waived and full compensation for backfilling the excavation will be considered as included in the price paid for structure excavation.

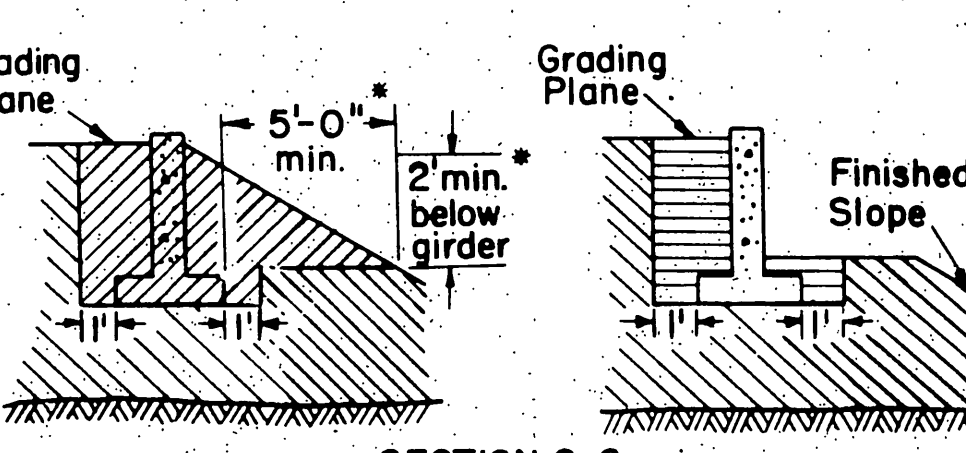




ABUTMENT IN EMBANKMENT

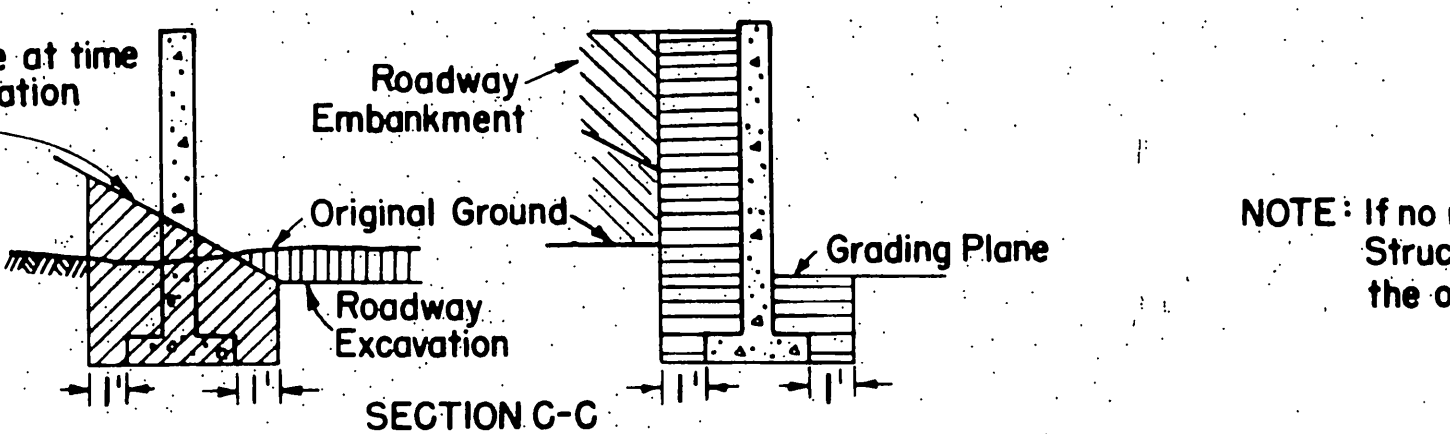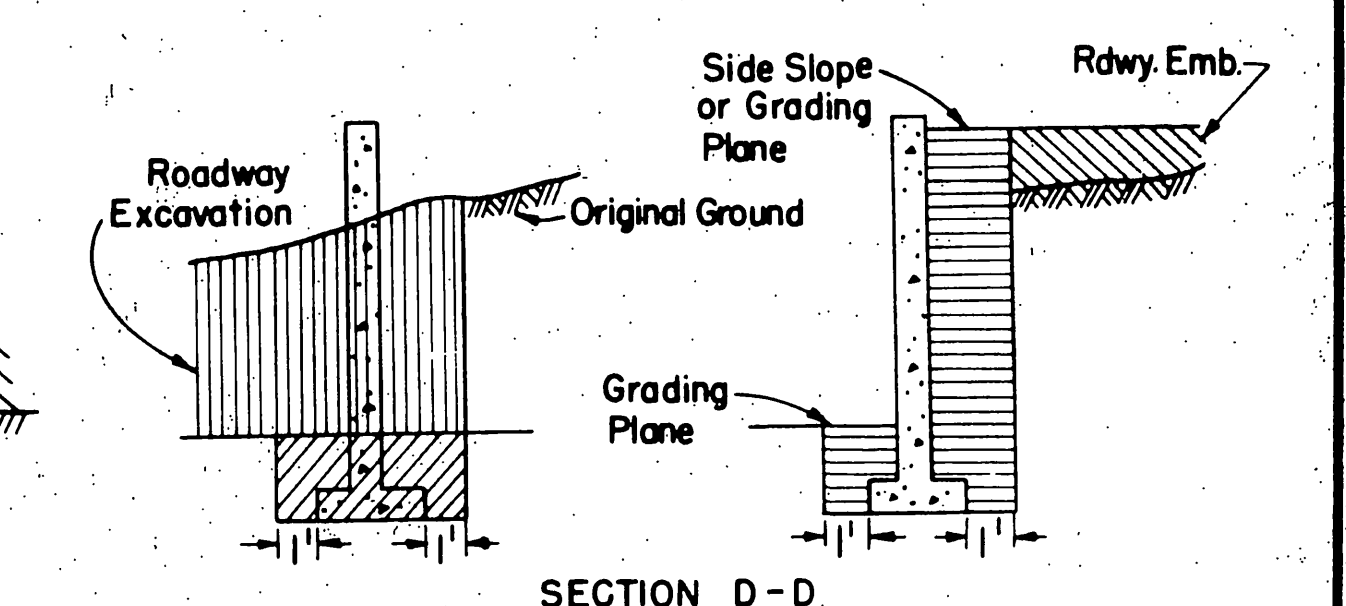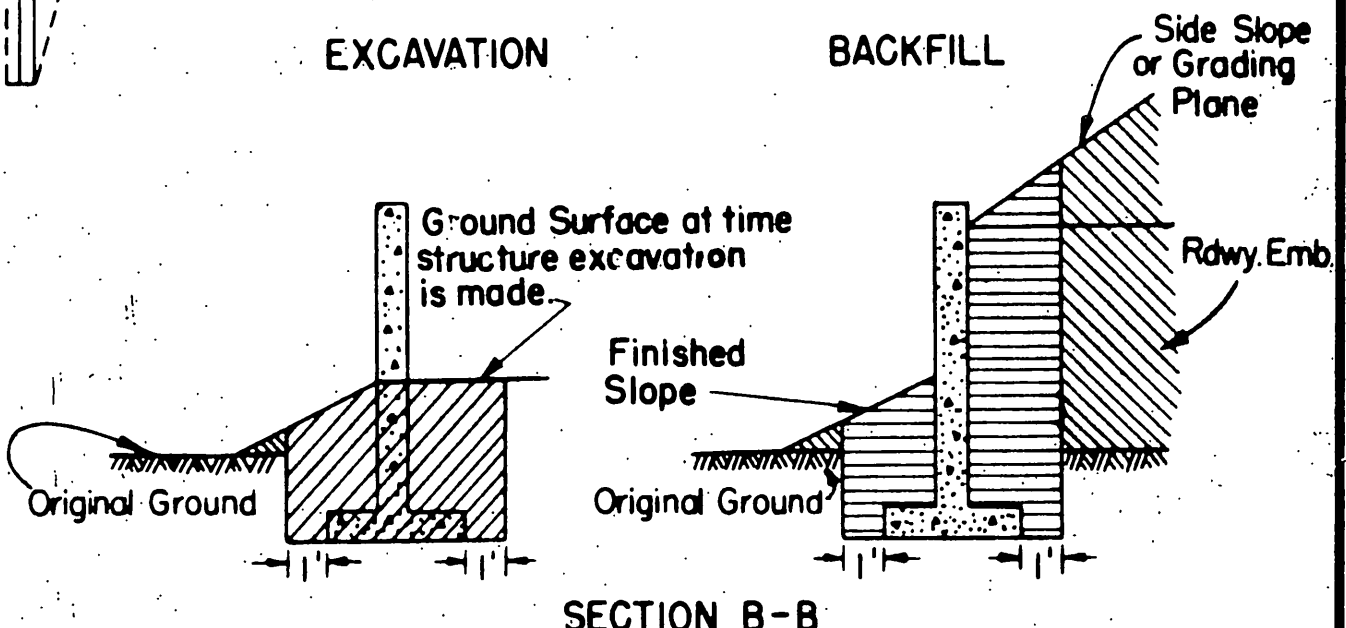


ABUTMENT IN ORIGINAL GROUND

BRIDGE PIERS, ABUTMENTS & ADJOINING WING WALLS

NOTE: If no roadway excavation is involved at bridge Structure excavation will be measured from the original ground.

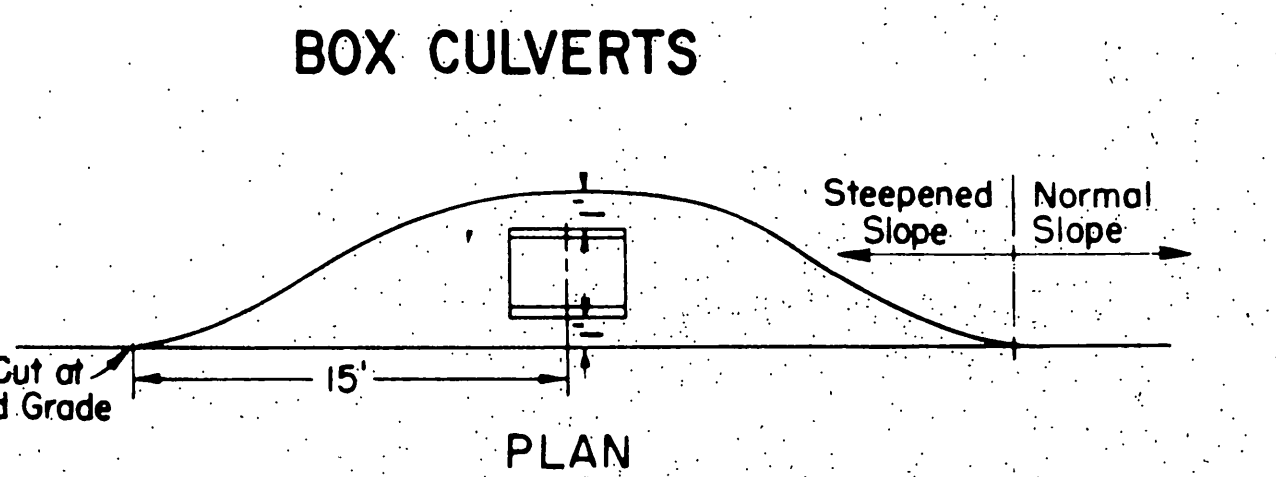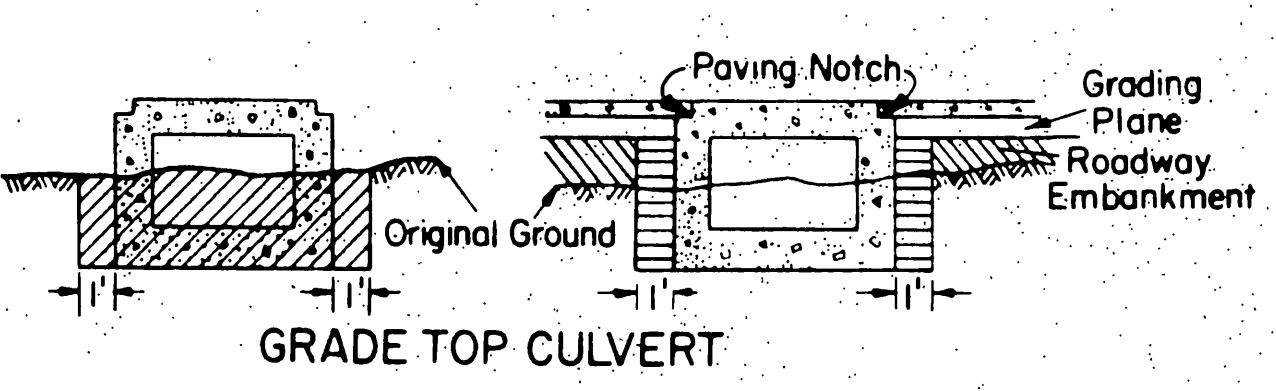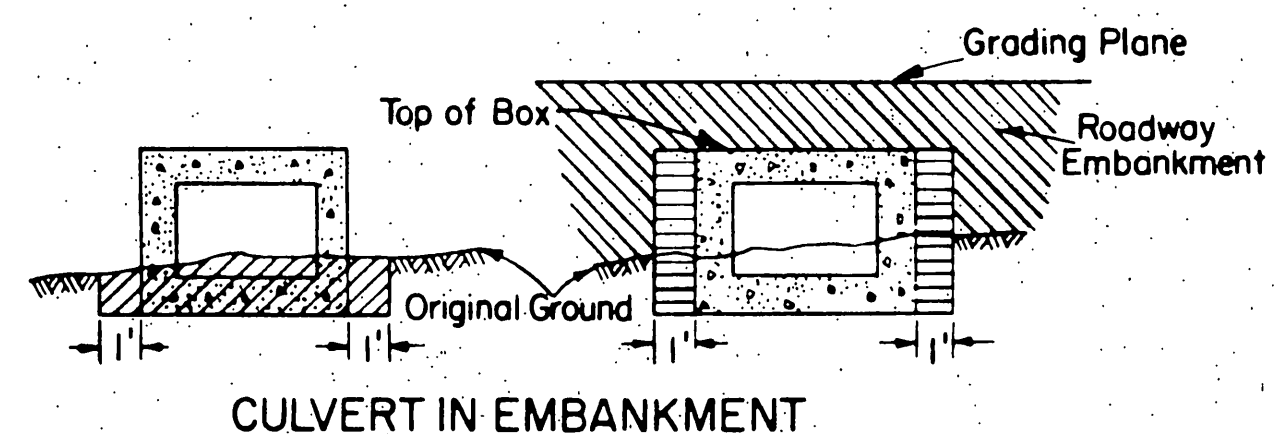


NOTE: Slopes and dimensions may vary to fit field conditions.

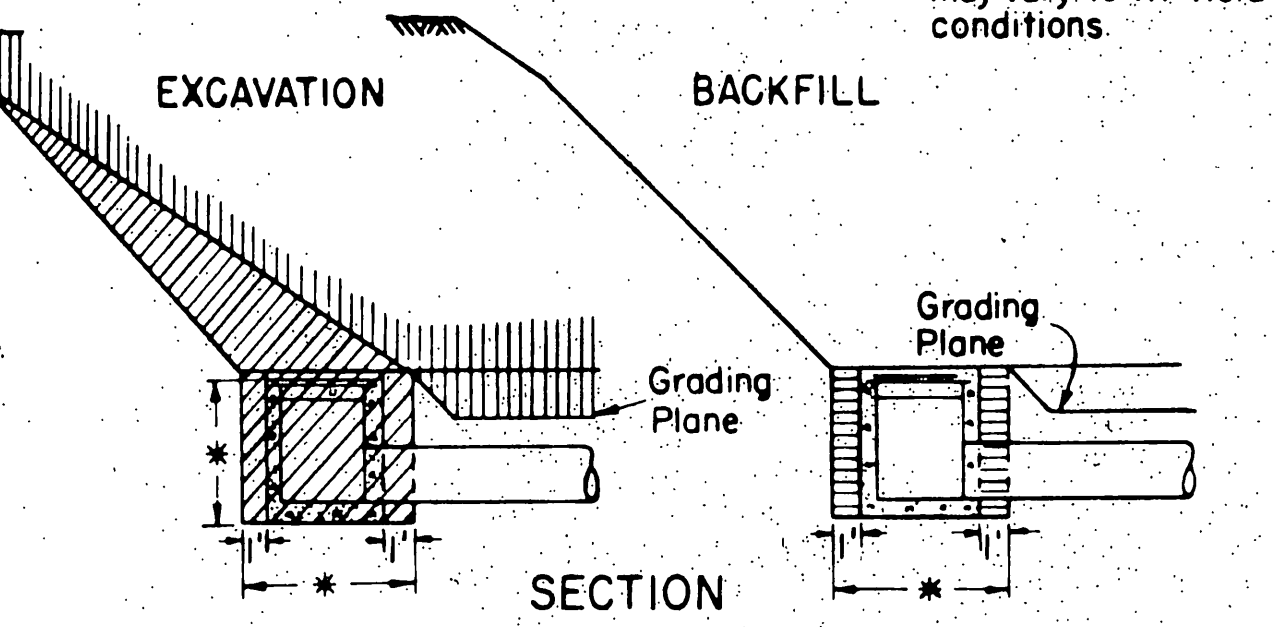


RECESSES AT CULVERT INLETS

* When concrete is being paid for as Class A Concrete (Minor Structure) the cost of Excavation and Backfill is included in the price paid for Class A Concrete (Minor Structure).

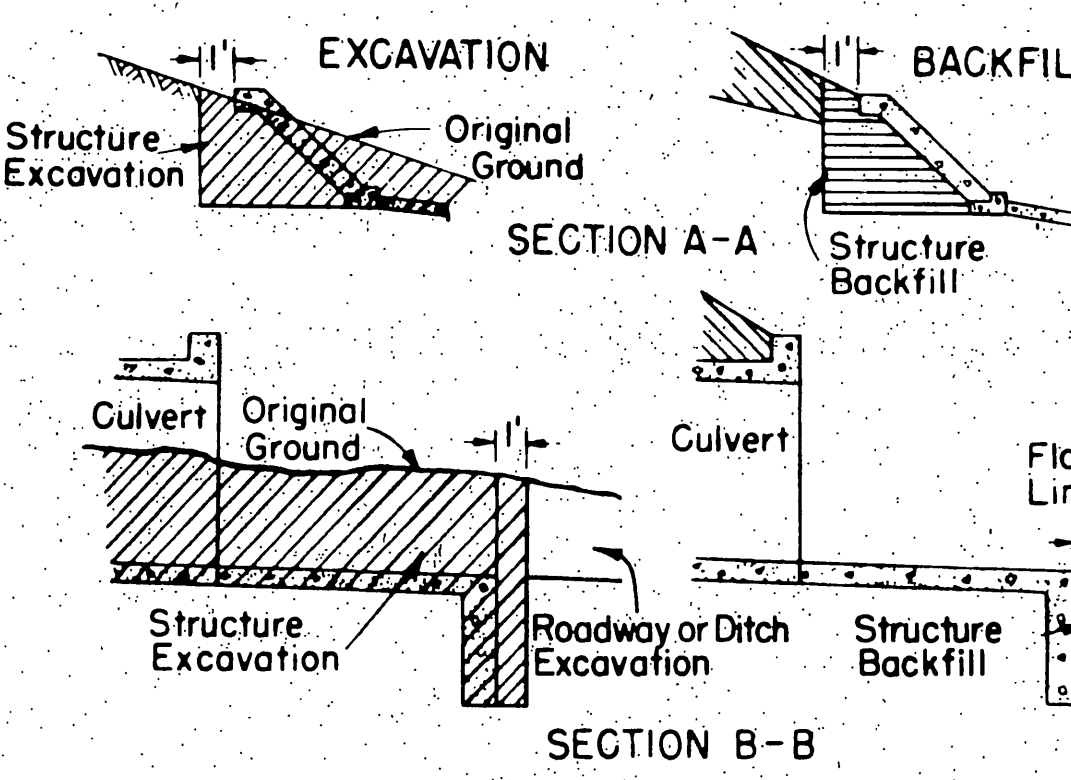


WARPED WING WALLS

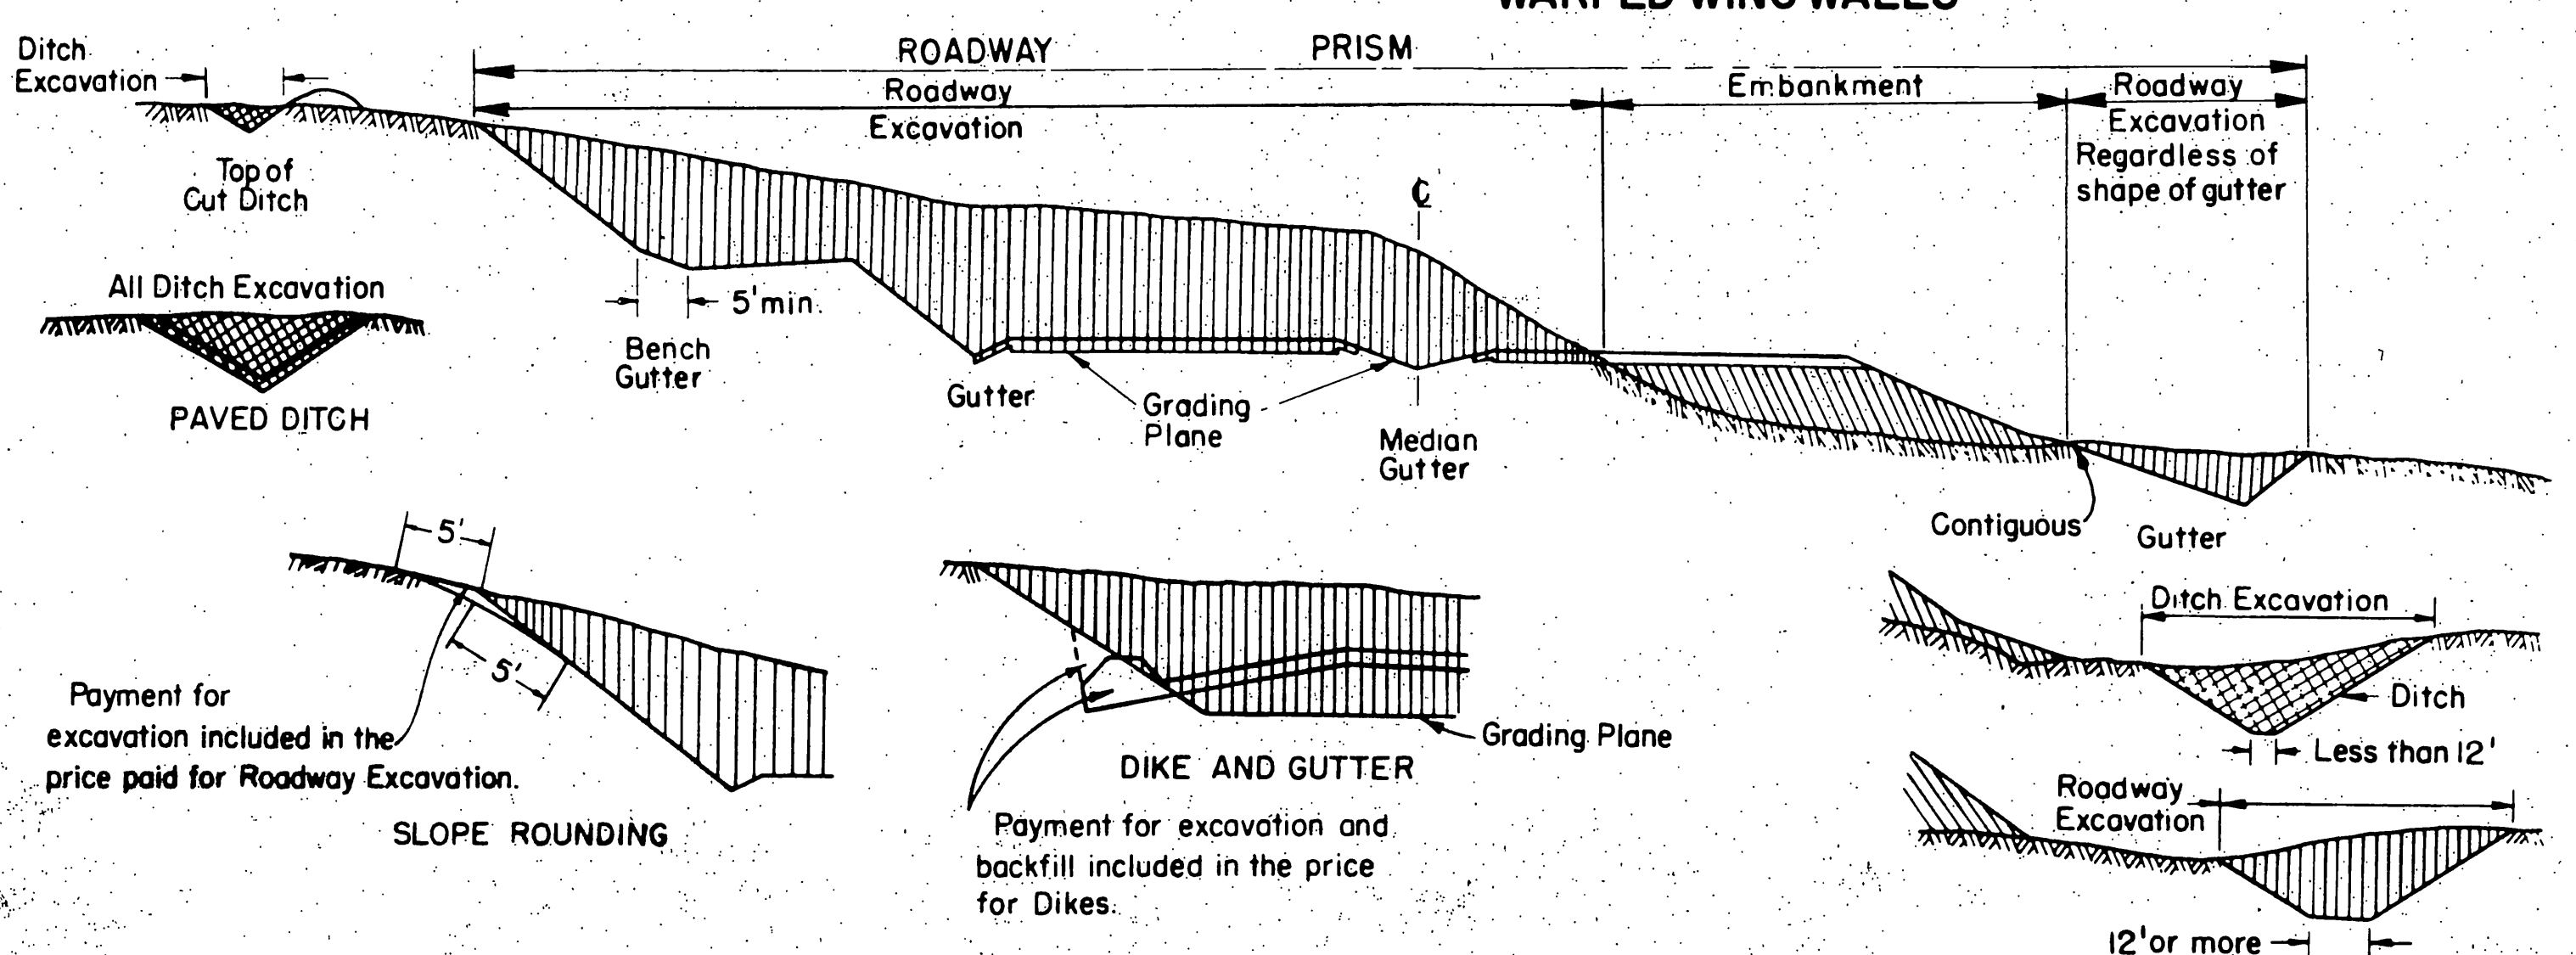


Payment for excavation included in the price paid for Roadway Excavation.

Payment for excavation and backfill included in the price for Dikes.

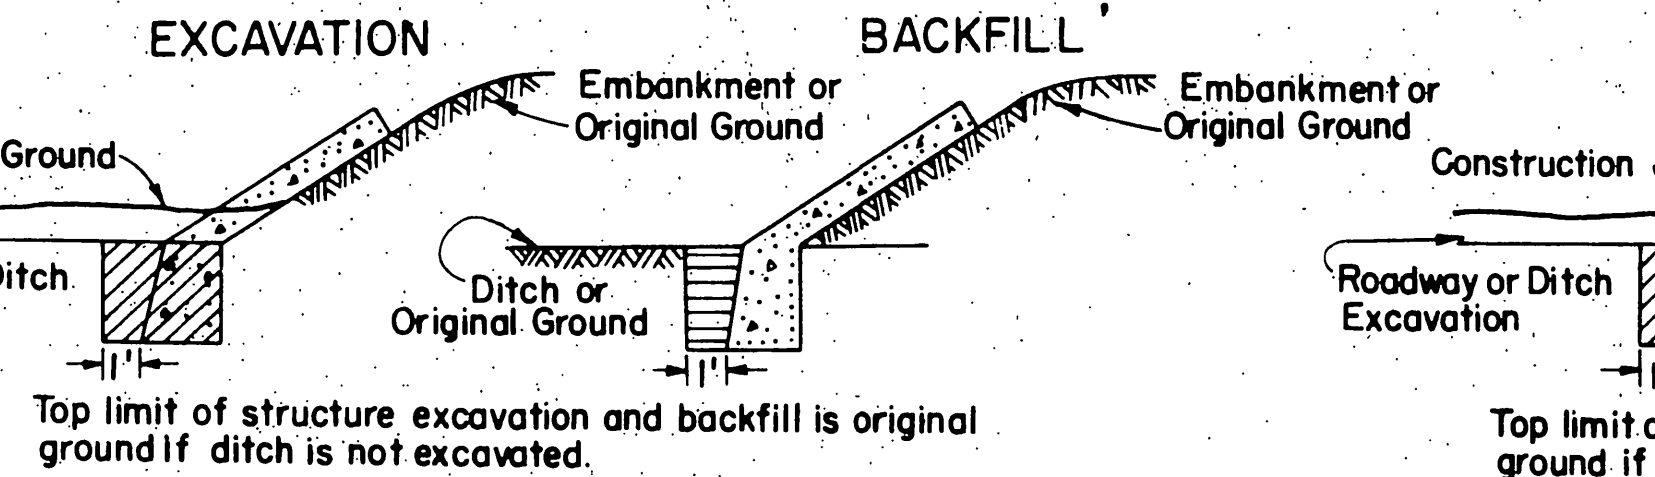

Top limit of structure excavation and backfill is original ground if ditch is not excavated.

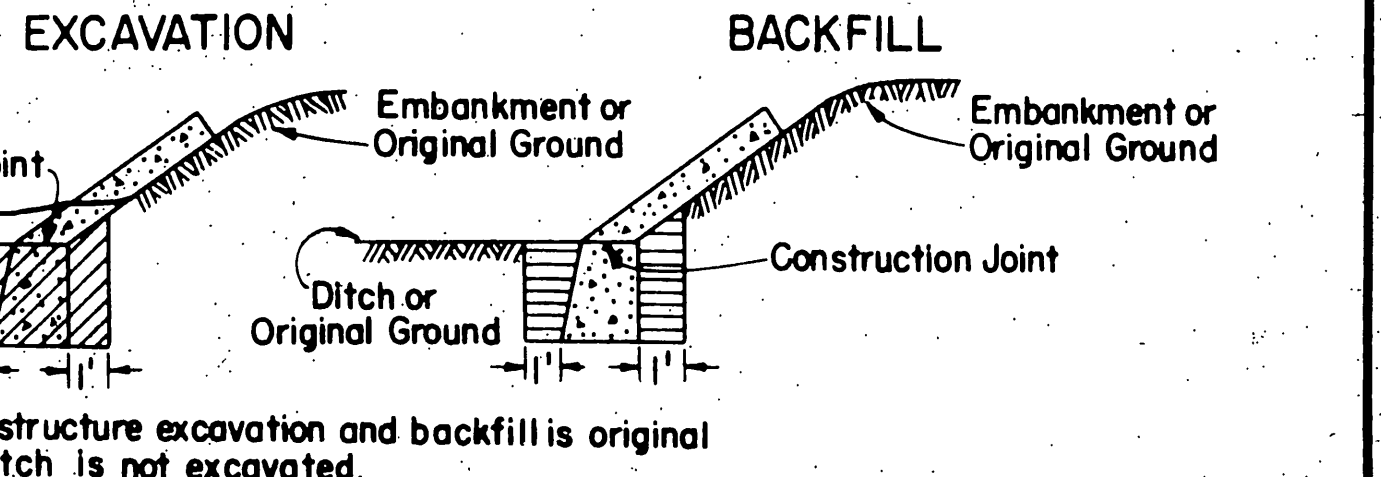

Top limit of structure excavation and backfill is original ground if ditch is not excavated.

LEGEND



	Structure Excavation		Roadway Excavation
	Structure Backfill		Roadway Embankment
	Ditch Excavation		Original Ground

To Accompany Plans Dated August 28, 1961

DIST.	COUNTY	ROUTE	SECTION	SHEET NO.	TOTAL SHEETS
VIII	Riv	100	(3)	18	25

Note: Compression caps and sills to be same dimension timber as struts. Timber for struts and sills shall be Douglas Fir common.


APPROVAL RECOMMENDED
 J. A. [Signature]
 CHIEF OF DESIGN
 APPROVED: July 10, 1957
 [Signature]
 STATE HIGHWAY ENGINEER
 CIVIL ENGINEER LICENSE NO. 2004

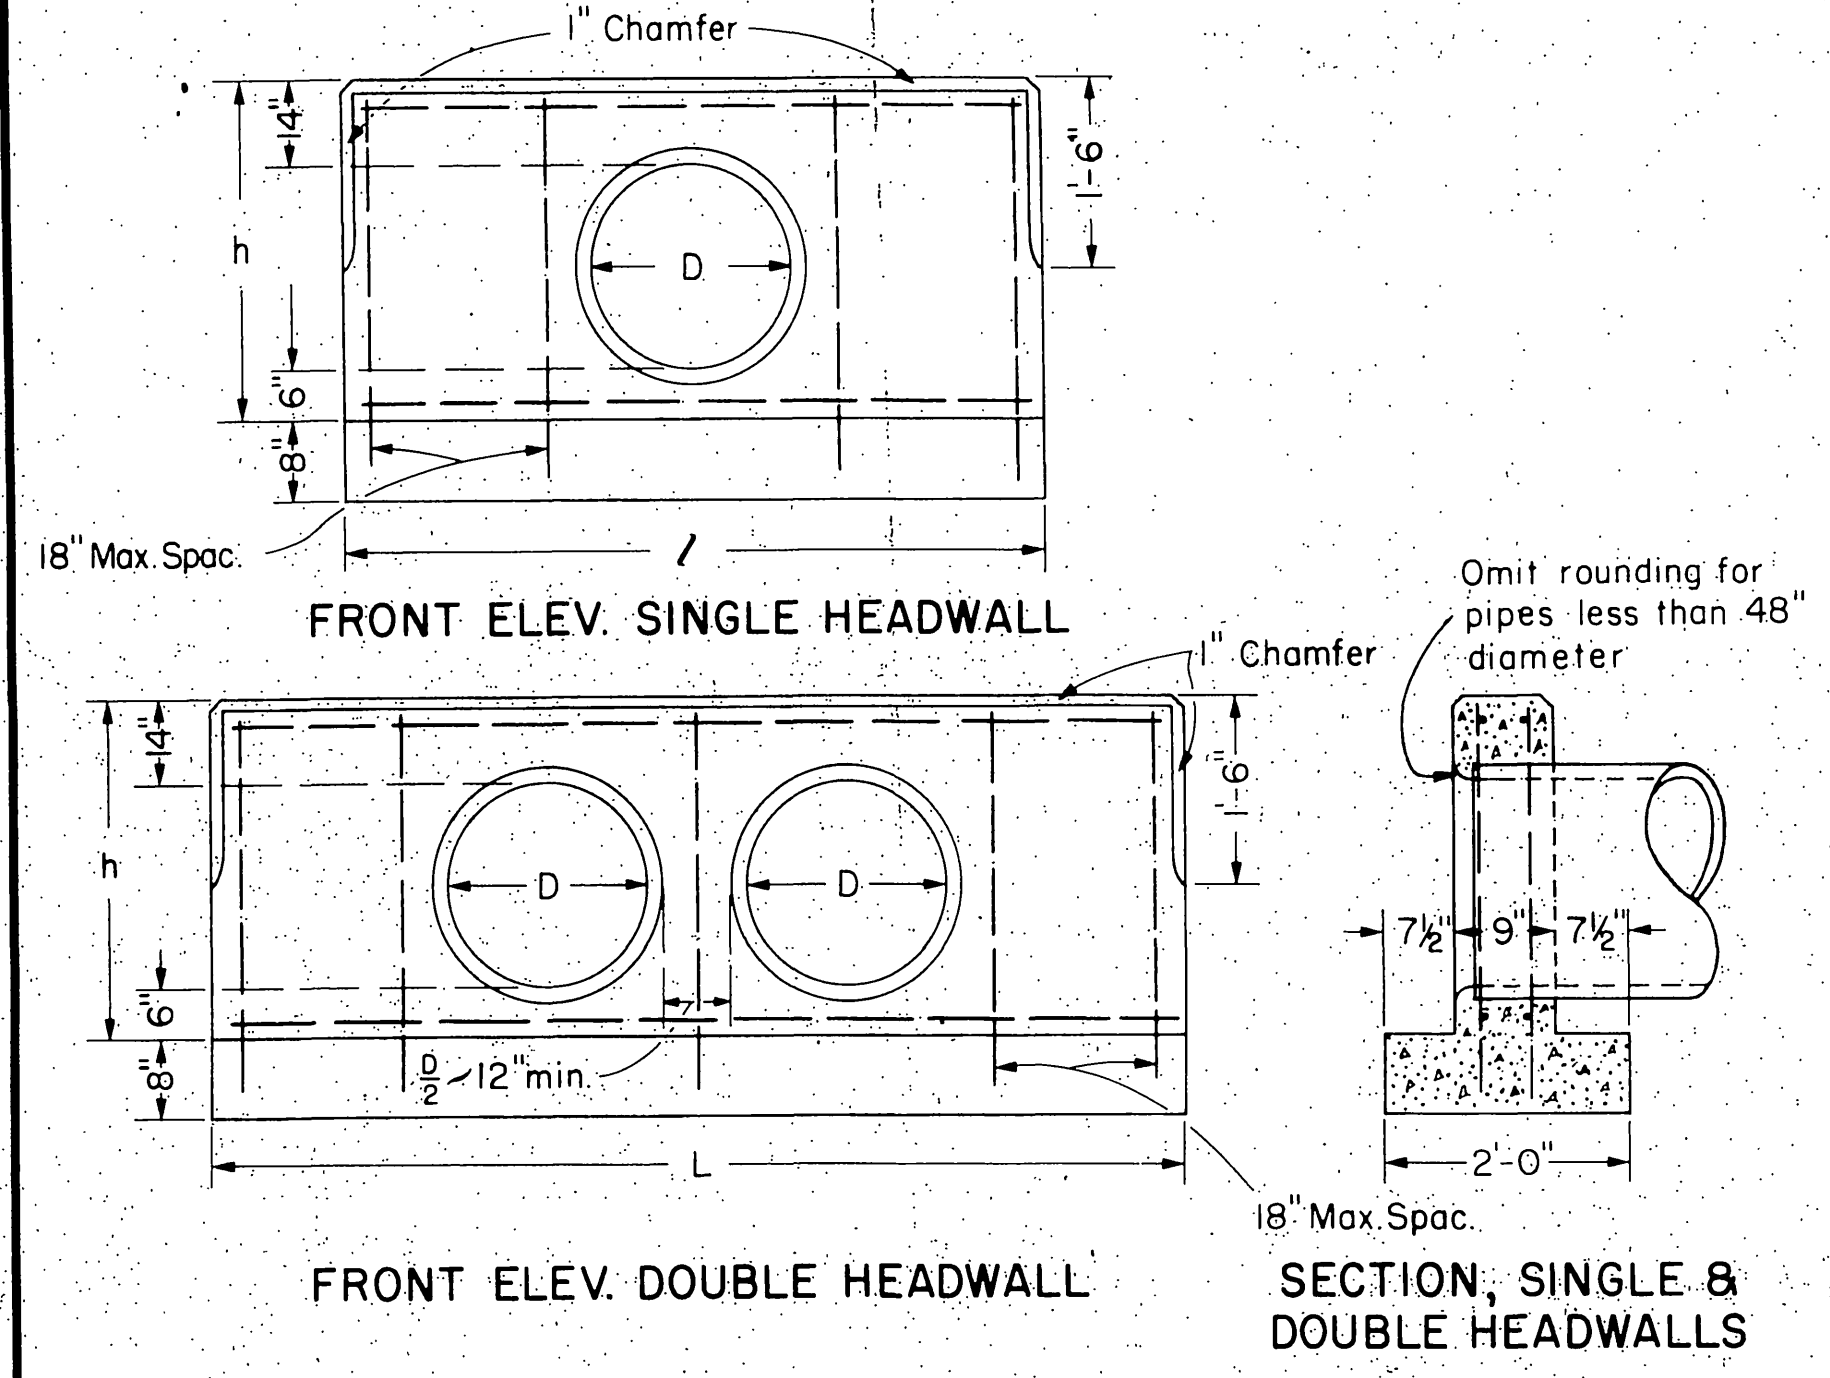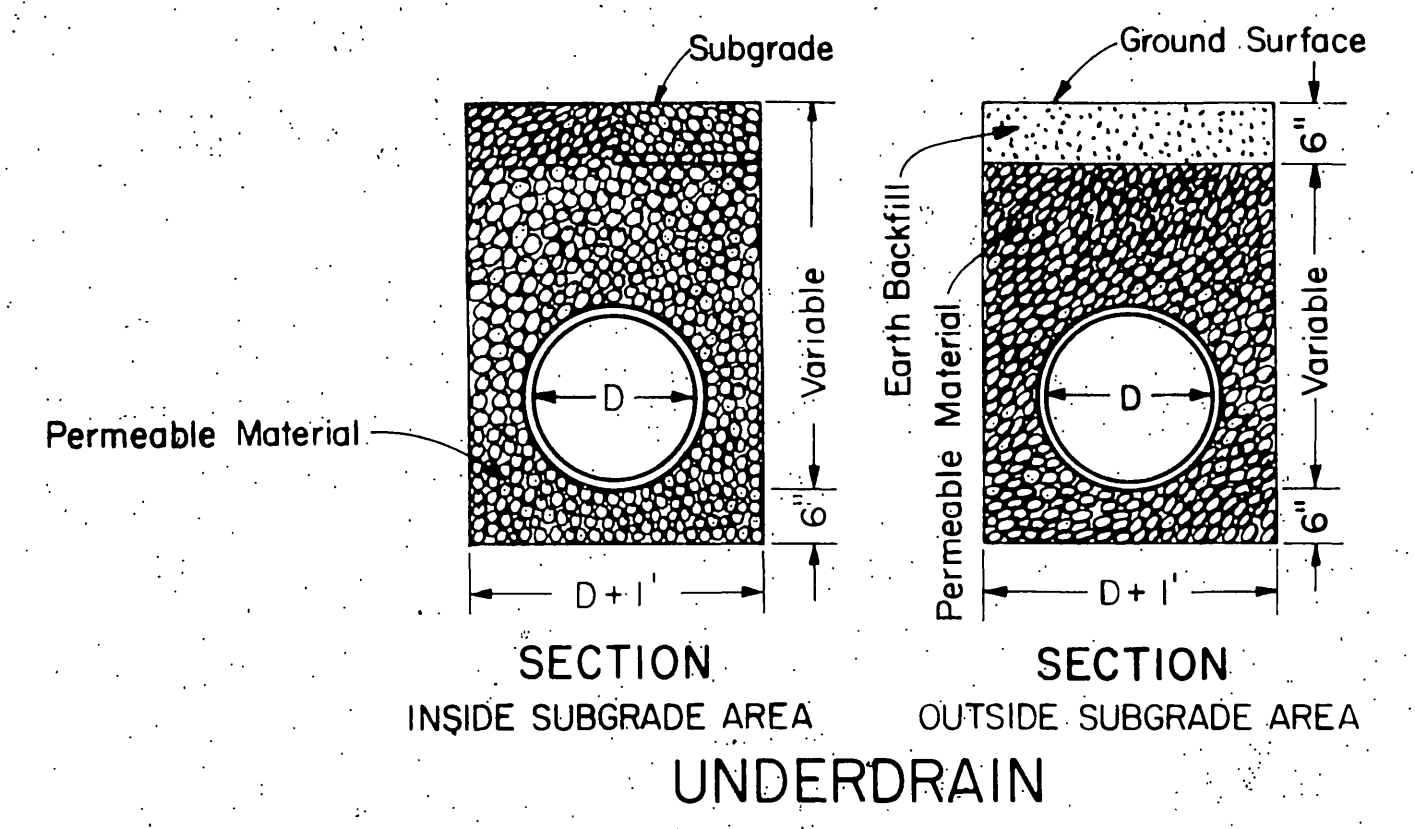

D	h	Single				Double			
		L	Vert. bars	Steel lbs.	Conc. C.Y.	L	Vert. bars	Steel lbs.	Conc. C.Y.
12	2-8	5-0	8	28	0.60	7-0	10	38	0.82
15	2-11	6-0	12	41	0.75	8-6	14	52	1.04
18	3-2	7-0	12	46	0.91	9-6	14	57	1.21
21	3-5	7-6	12	49	1.02	10-6	14	62	1.38
24	3-8	8-6	12	54	1.20	11-6	14	67	1.57
27	3-11	9-6	16	70	1.39	13-0	18	85	1.84
30	4-2	10-0	16	74	1.52	14-0	18	91	2.04
33	4-5	11-0	16	79	1.73	15-0	18	96	2.25
36	4-8	12-0	16	85	1.95	16-6	18	103	2.56
39	4-11	12-6	16	89	2.09	17-6	20	116	2.79
42	5-2	13-6	16	94	2.34	18-6	20	122	3.03
45	5-5	14-6	20	115	2.60	20-0	26	153	3.38
48	5-8	15-0	20	119	2.75	21-0	26	160	3.64
51	5-11	16-0	20	125	3.03	22-6	26	168	4.02
54	6-2	17-0	20	131	3.31	23-6	26	175	4.30

Use headwall tables for concrete pipe and for C.M.P.
 No deduction made in quantities for variations in thickness of pipe walls.
 All reinforcing steel #4 bars.


STRAIGHT HEADWALLS

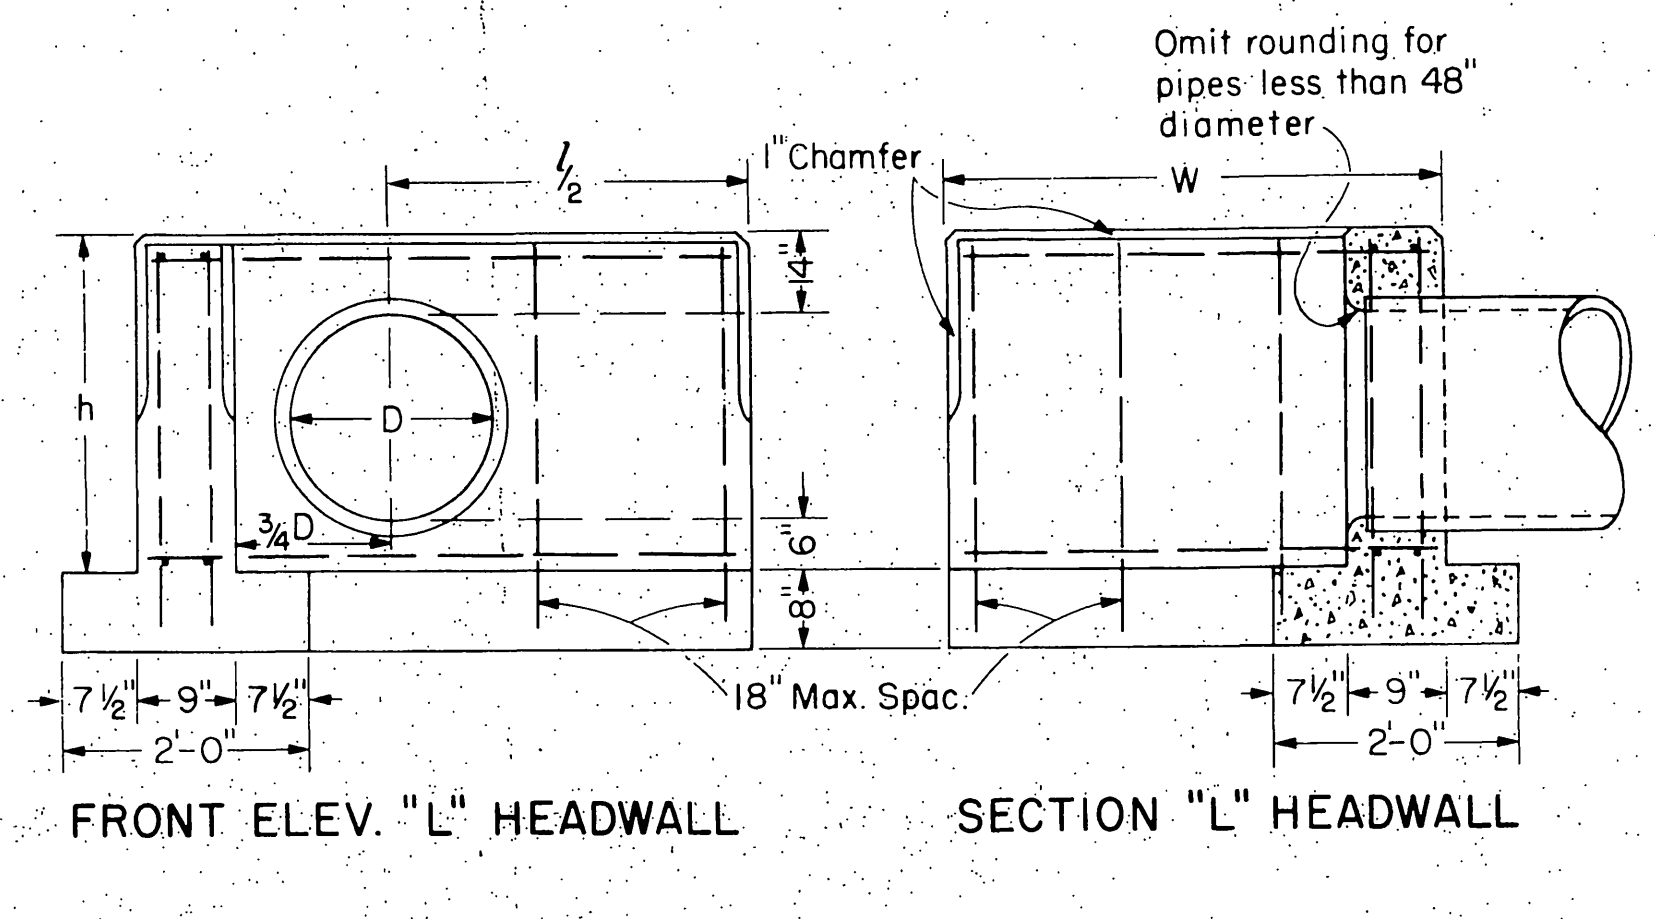

D	h	1/2	Length of W					Conc. C.Y.
			2'-0" to 3'-4"	3'-5" to 4'-10"	4'-11" to 6'-4"	6'-5" to 7'-10"	7'-11" to 9'-4"	
12	2-8	2-6	28+3W	32+3W			0.38+0.12W	
15	2-11	3-0	36+3W	41+3W			0.48+0.13W	
18	3-2	3-6	40+3W	45+3W			0.59+0.14W	
21	3-5	3-9	43+3W	48+3W			0.66+0.14W	
24	3-8	4-3	47+3W	52+3W	58+3W		0.78+0.15W	
27	3-11	4-9	57+3W	62+3W	68+3W		0.91+0.16W	
30	4-2	5-0	60+3W	66+3W	73+3W	78+3W	1.00+0.17W	
33	4-5	5-6	64+3W	71+3W	77+3W	83+3W	1.13+0.17W	
36	4-8	6-0	68+3W	75+3W	82+3W	88+3W	1.28+0.18W	
39	4-11	6-3		79+3W	86+3W	93+3W	1.39+0.19W	
42	5-2	6-9		83+3W	91+3W	98+3W	1.54+0.19W	
45	5-5	7-3			103+3W	111+3W	1.71+0.20W	
48	5-8	7-6			108+3W	116+3W	1.82+0.21W	
51	5-11	8-0				121+3W	2.00+0.21W	
54	6-2	8-6				127+3W	2.18+0.22W	

"L" HEADWALLS

PIPE CULVERT HEADWALLS

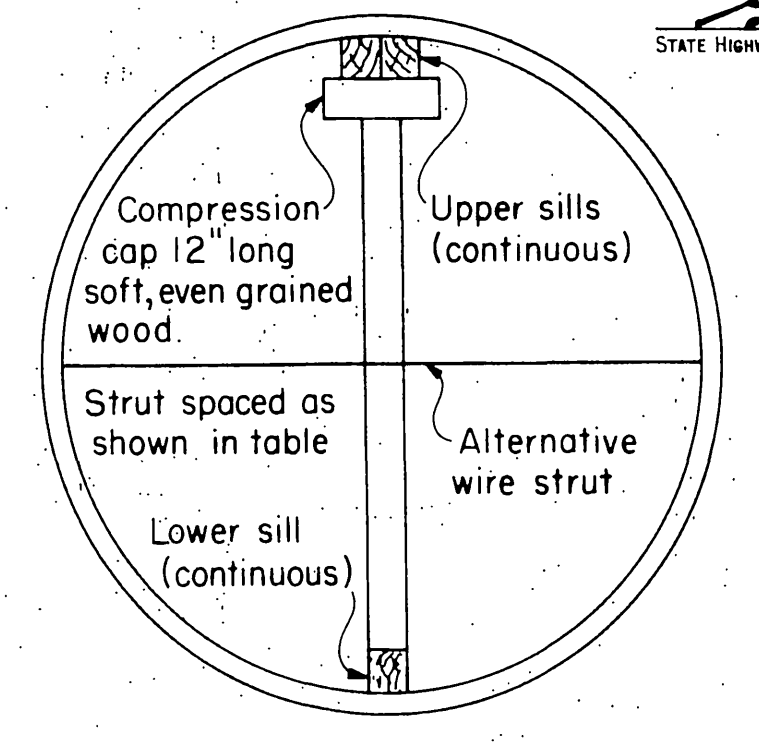

STRUT DETAILS

PIPE DIA.	STRUT SIZE	HEIGHT OF FILL IN FEET								
		0-20	30	40	50	60	70	80	100	
48"	4 x 4		5.0	3.5						
	4 x 6		6.0	5.0	4.0	3.5	3.0			
	6 x 8				6.0	5.0	4.5	4.0	3.5	
60"	4 x 4	6.0	4.0	3.0						
	4 x 6		6.0	4.5	3.5	3.0				
	6 x 6				5.5	4.5	4.0	3.5	3.0	
72"	4 x 4	5.0	3.0							
	4 x 6	6.0	5.0	3.5	3.0					
	6 x 6				6.0	4.5	4.0	3.5	3.0	
84"	6 x 6	6.0	6.0	5.0	4.0	3.5	3.0			
	6 x 8				5.0	4.5	4.0	3.5	3.0	
	8 x 8							4.5	3.5	
96"	6 x 6	6.0	5.5	4.5	3.5	3.0				
	6 x 8				5.5	4.5	4.0	3.5	3.0	
	8 x 8							4.5	4.0	3.0
108"	6 x 6	6.0	5.0	3.5	3.0					
	6 x 8				6.0	5.0	4.0	3.5	3.0	
	8 x 8							4.5	4.0	3.5
120"	6 x 6	6.0	4.0	3.0						
	6 x 8	6.0	5.5	4.0	3.5	3.0				
	8 x 8							5.0	4.0	3.5
132"	6 x 6	5.0	3.5							
	6 x 8	6.0	4.5	3.5	3.0					
	8 x 8				5.5	4.5	4.0	3.5	3.0	
144"	6 x 6	4.5	3.0							
	6 x 8	5.5	4.0	3.0						
	8 x 8				5.0	4.0	3.5	3.0		
156"	6 x 8	4.5	3.0							
	8 x 8				6.0	4.5	3.5	3.0		
168"	6 x 8	3.5								
	8 x 8	6.0	5.0	4.0	3.0					
180"	6 x 8	3.0								
	8 x 8	6.0	4.5	3.5						


STATE OF CALIFORNIA
 DEPARTMENT OF PUBLIC WORKS
 DIVISION OF HIGHWAYS

PIPE CULVERTS AND HEADWALLS








To accompany plans dated August 28, 1961

DISTRICT	COUNTY	ROUTE	SECTION	SHEET NO.	TOTAL SHEETS
VIII	RIV	100	(3)	19	25

Approval Recommended *J. D. Ragan*
 Engineer of Design
 Approved January 26, 1959
H. W. Meloy
 State Highway Engineer Civil Eng. License No. 2084

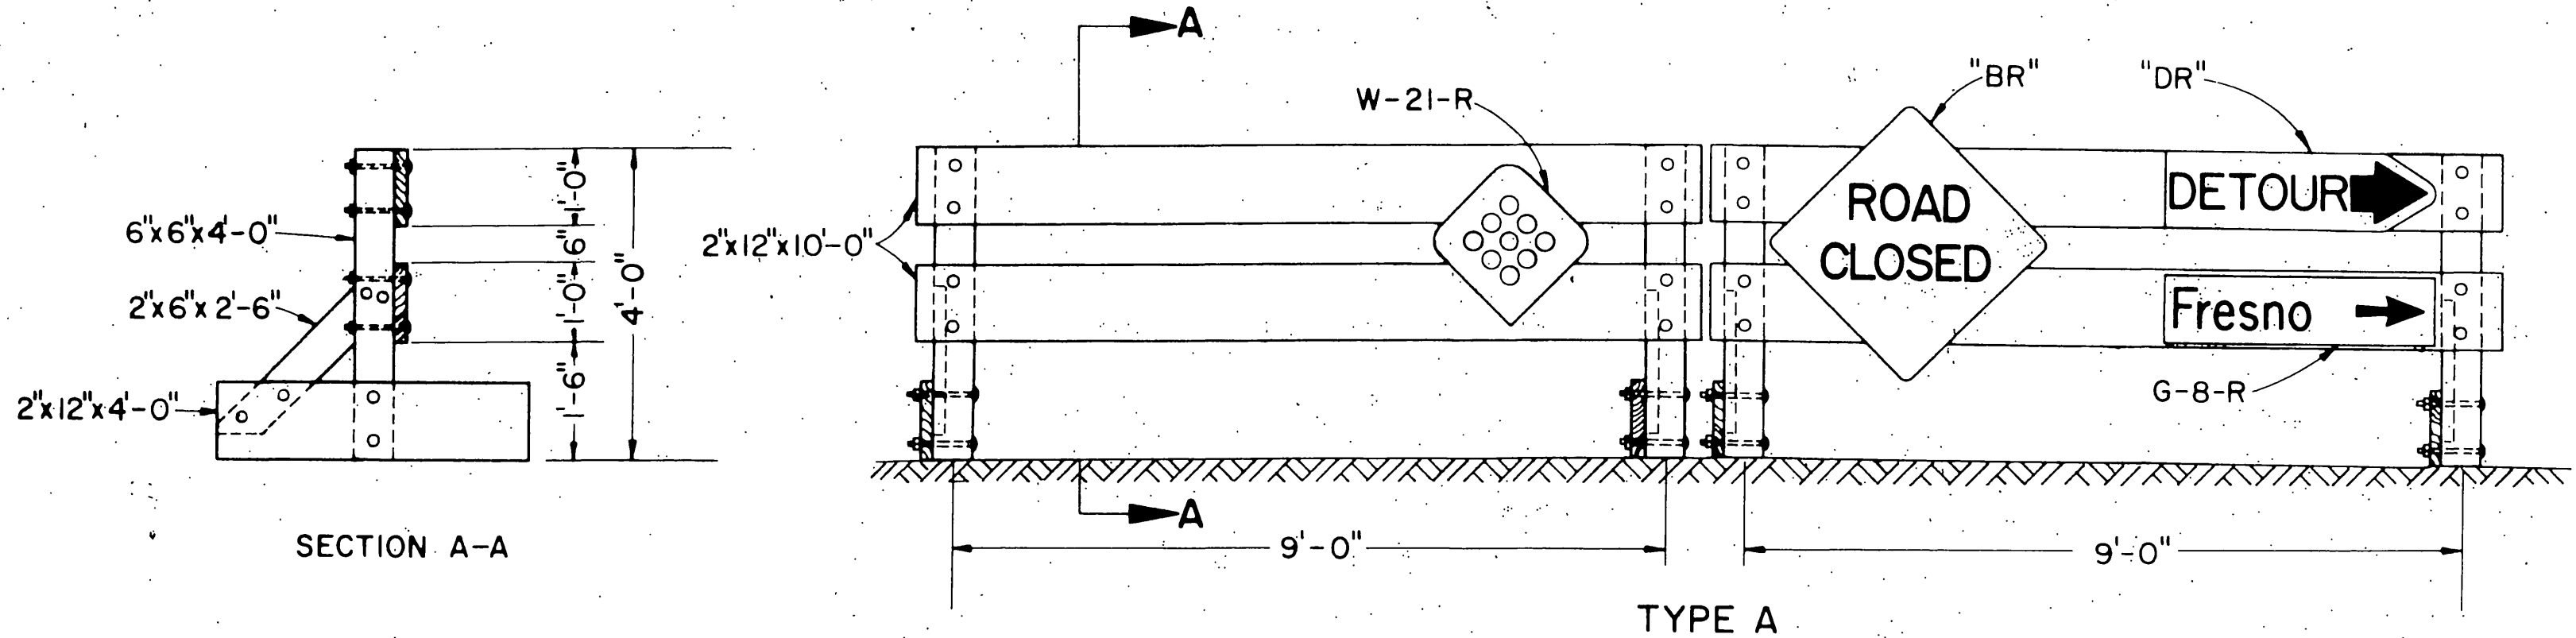

NOTE: Signs to be furnished by State.
 All timber to be S4S.
 Use 1/2" Carriage Bolts with cut washers and nuts.

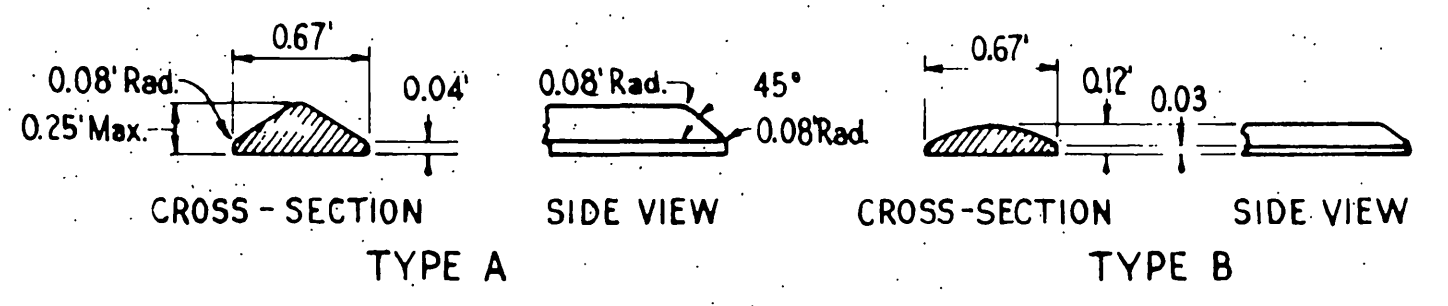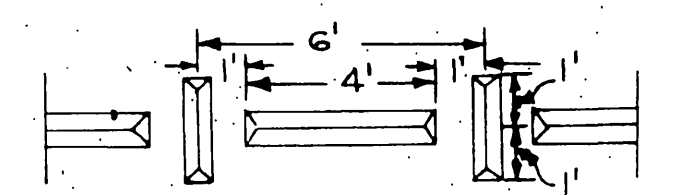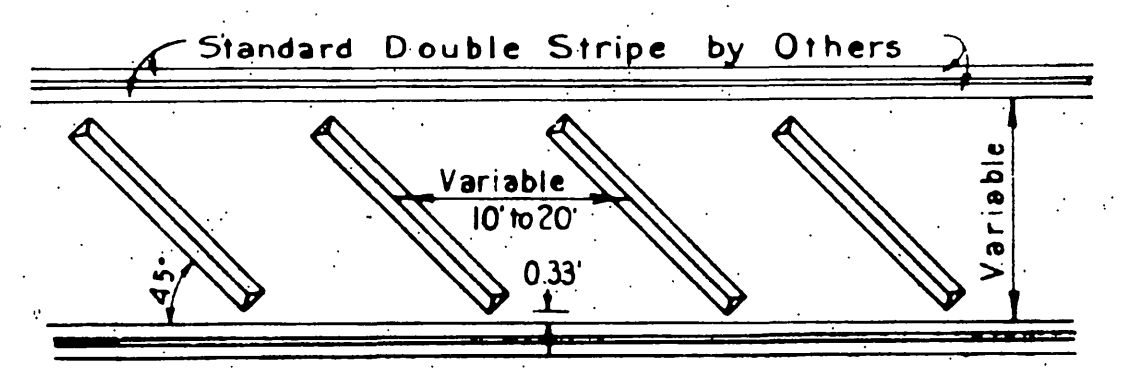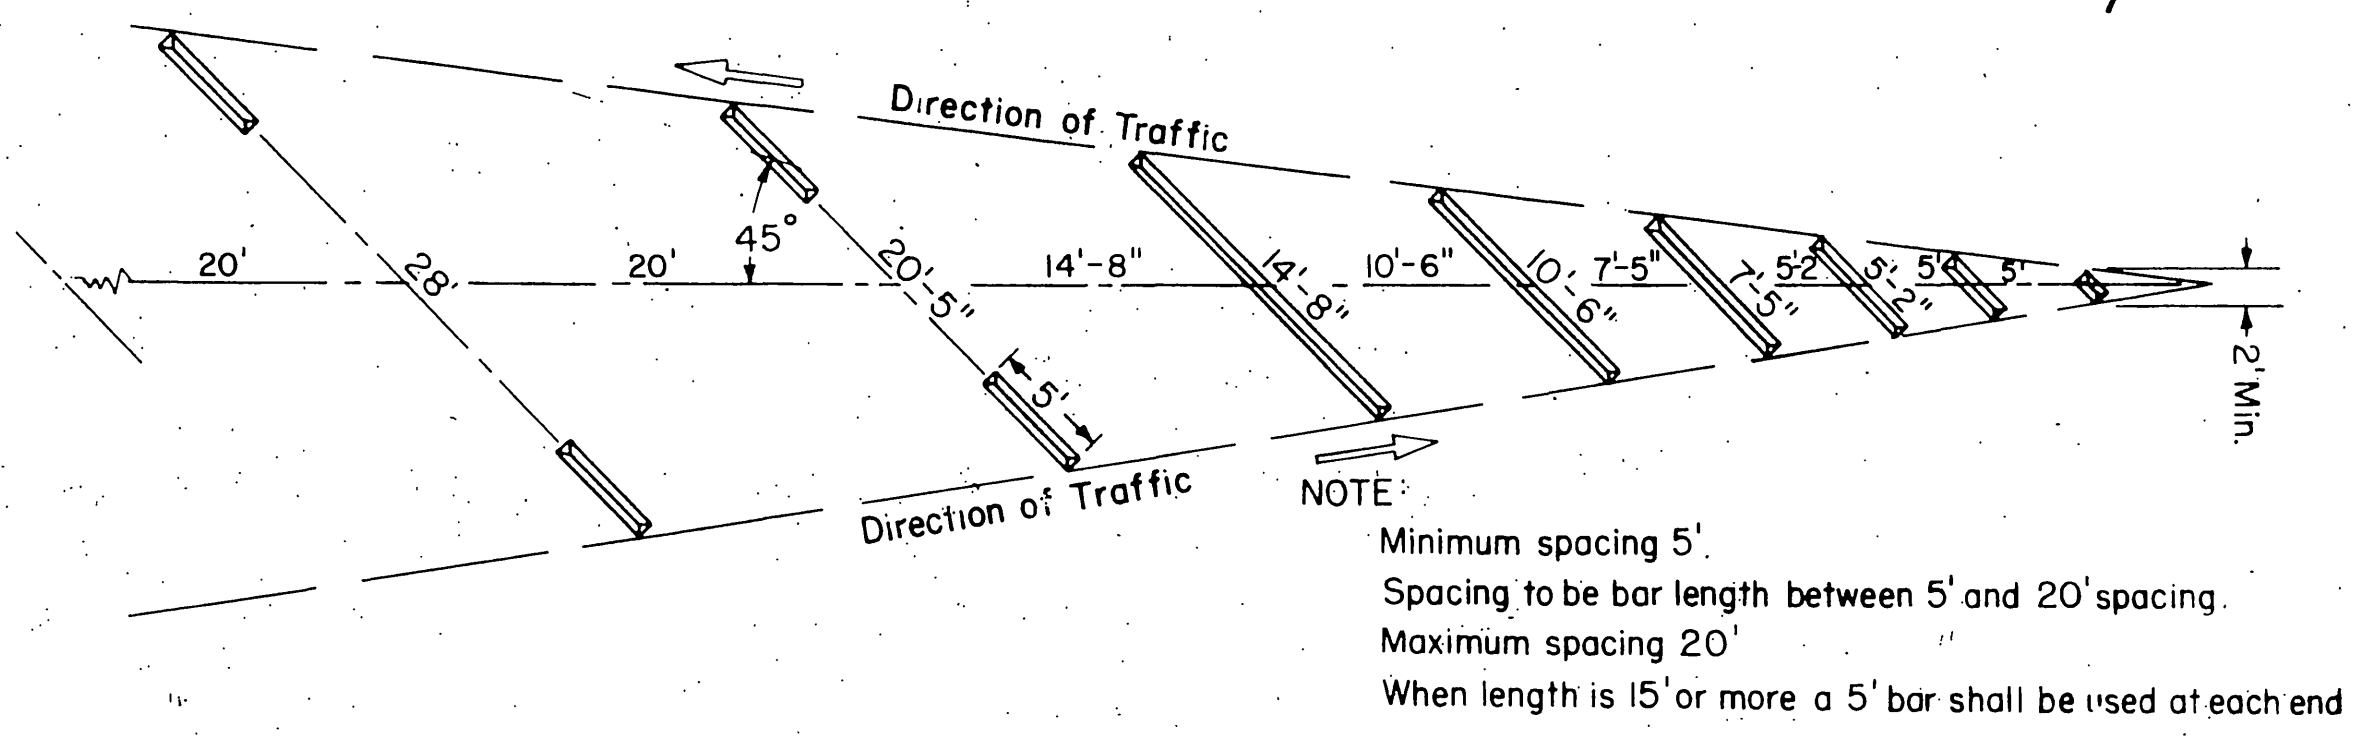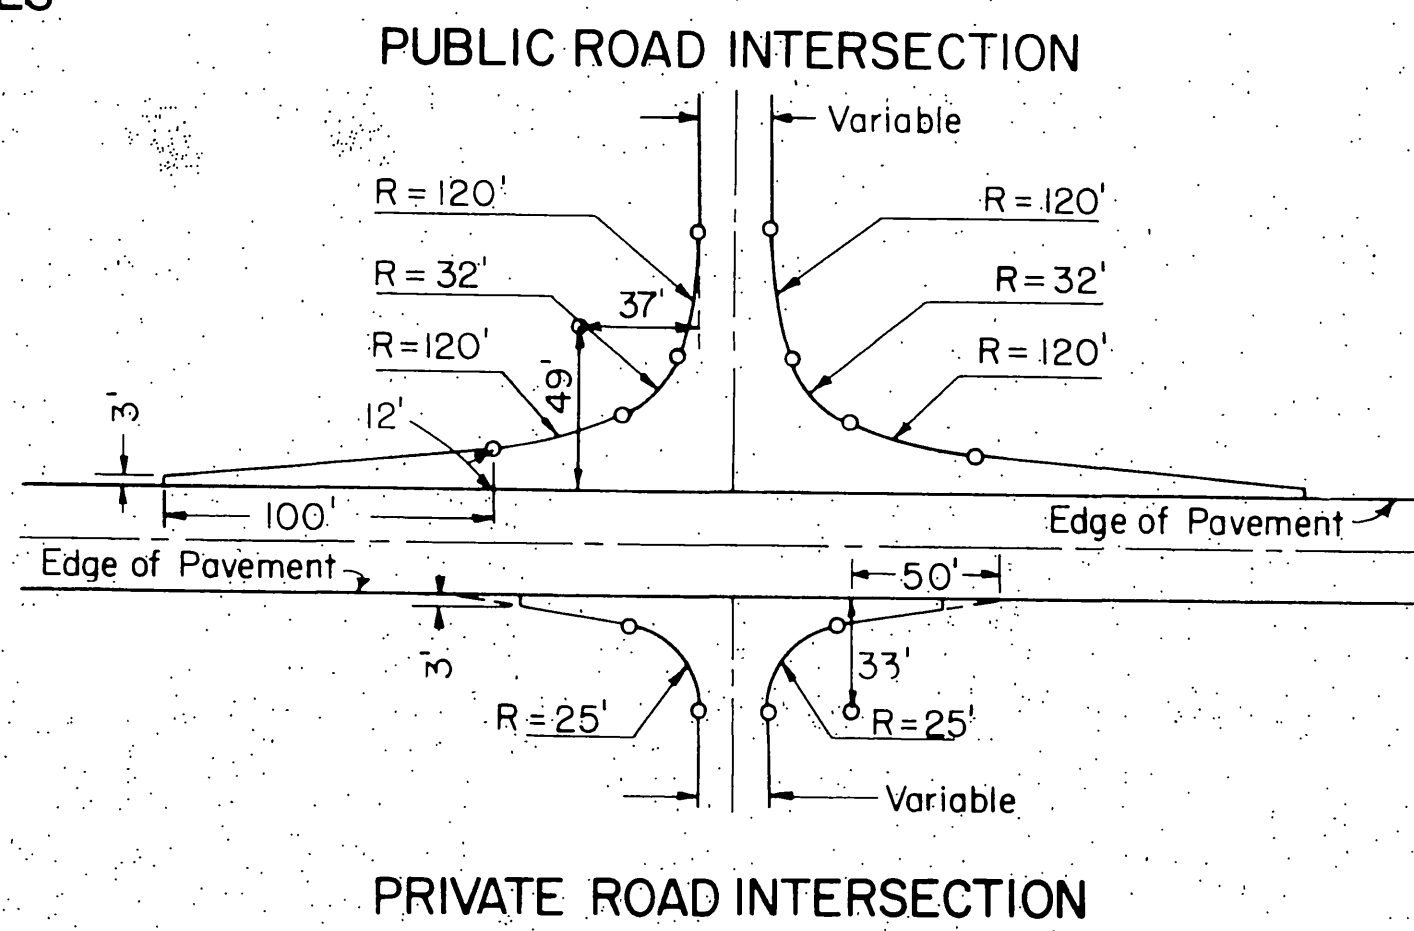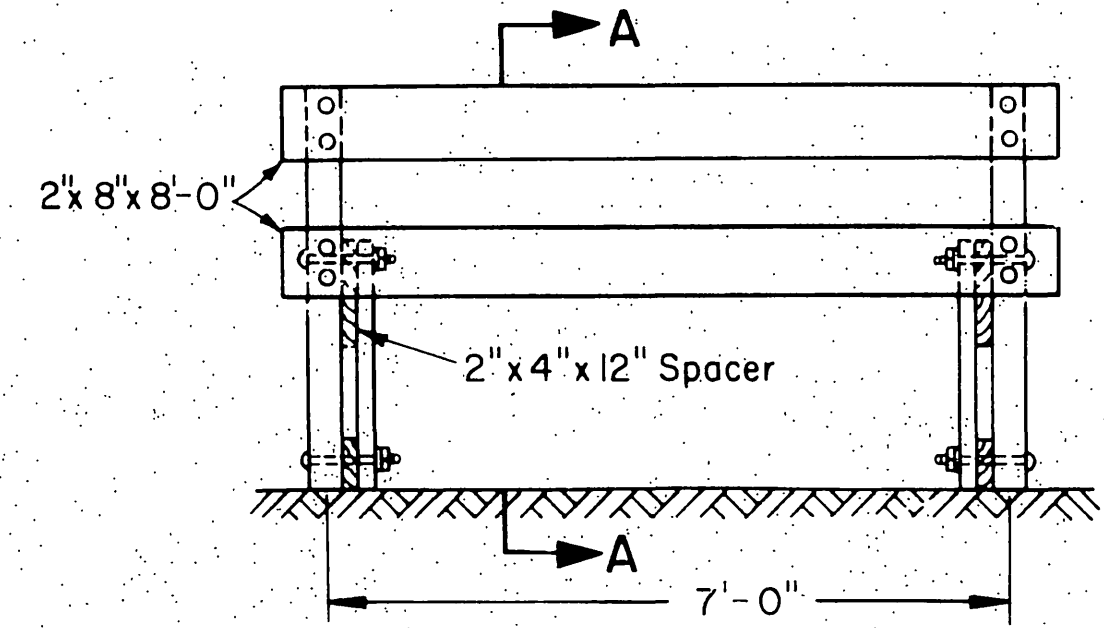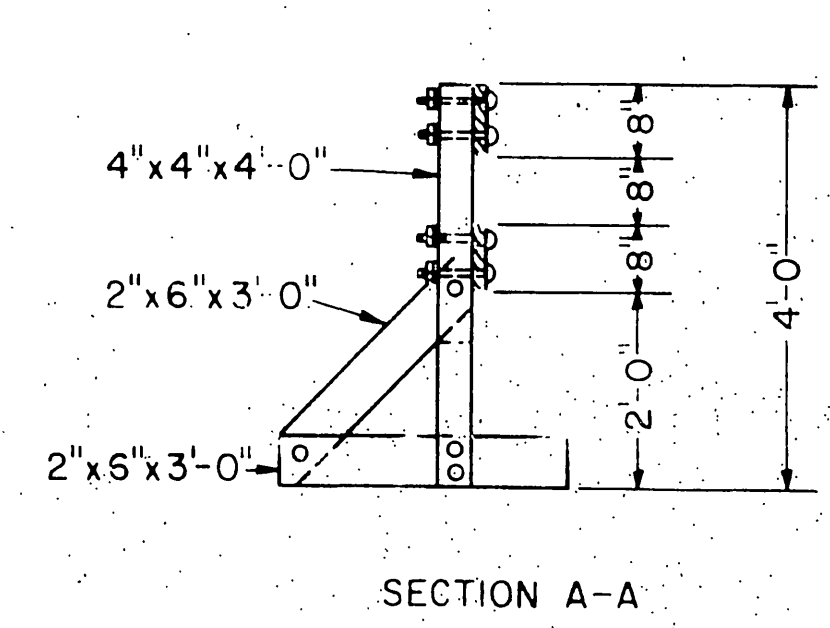

RAISED TRAFFIC BARS

STATE OF CALIFORNIA
 DEPARTMENT OF PUBLIC WORKS
 DIVISION OF HIGHWAYS


To accompany plans dated August 28, 1960

DISTRICT	COUNTY	ROUTE	SECTION	SHEET NO.	TOTAL SHEETS
VIII	Riv.	700 (3)	2.0	21	45


APPROVAL RECOMMENDED *H. J. Haver*
 ENGINEER OF DESIGN
 CIVIL ENGINEER LICENSE NO. 7803

G. M. Mohr
 TRAFFIC ENGINEER
 CIVIL ENGINEER LICENSE NO. 8429


APPROVED *W. J. ...*
 STATE HIGHWAY ENGINEER
 CIVIL ENGINEER LICENSE NO. 8443

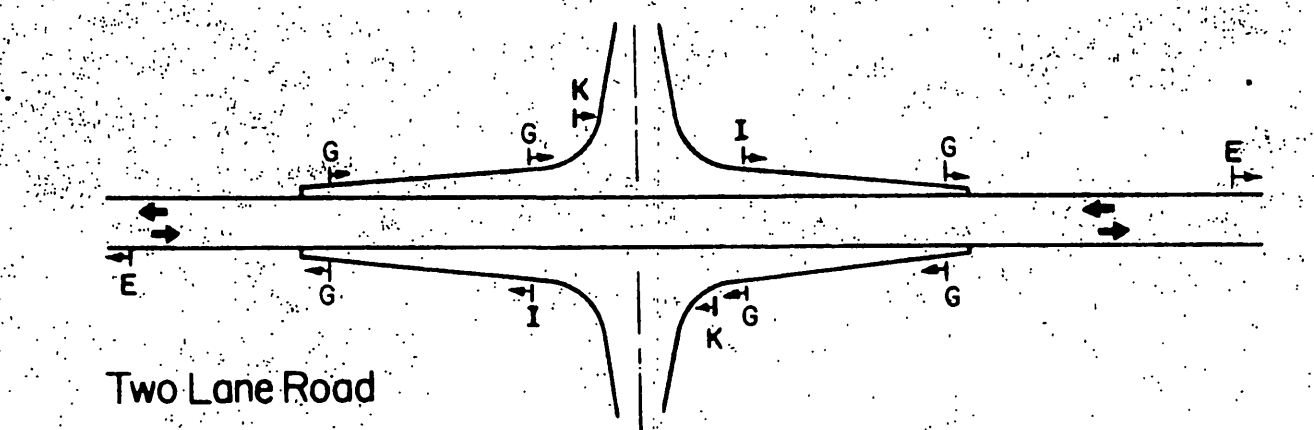


DELINEATION OF ROAD INTERSECTIONS

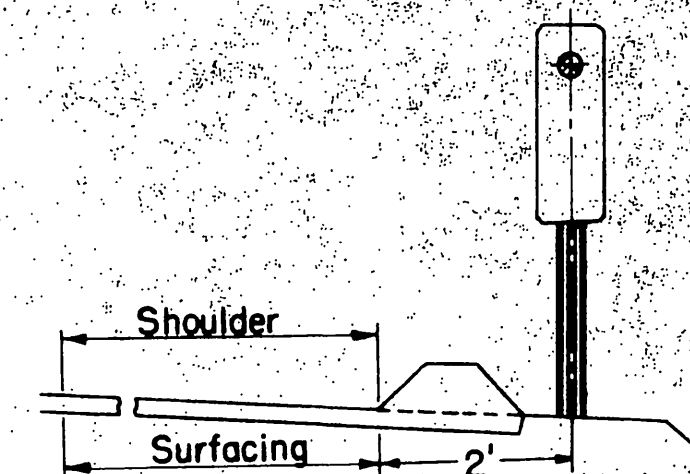


GUIDE MARKER AT DIKE

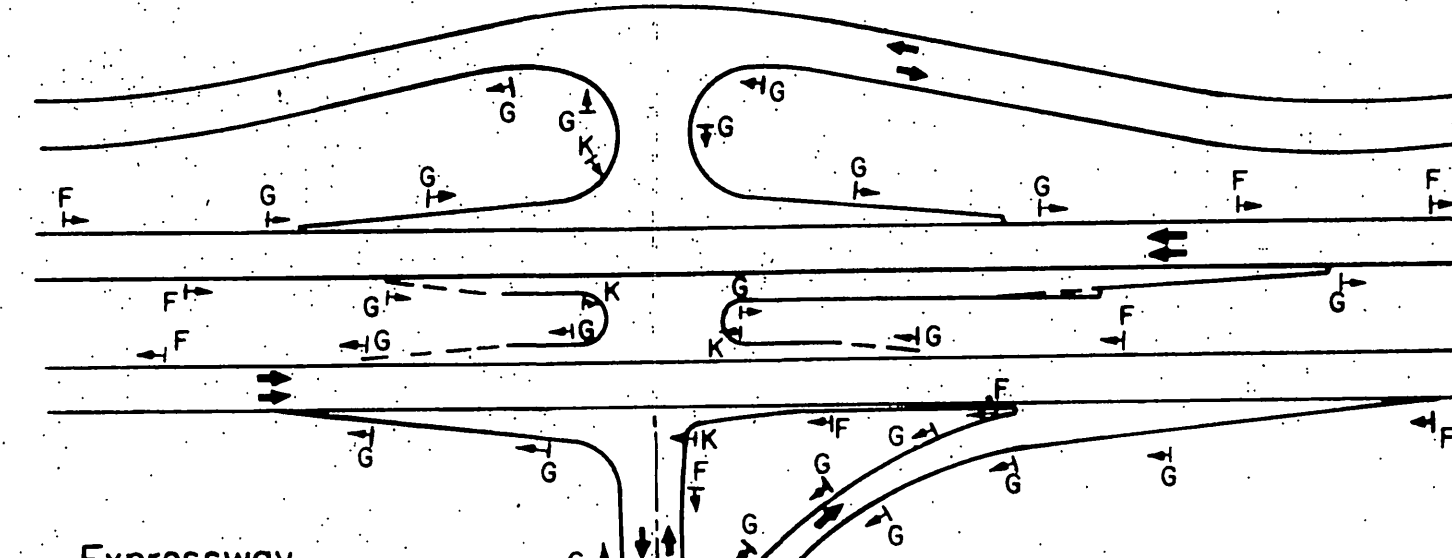


DELINEATION OF TRAFFIC ISLANDS

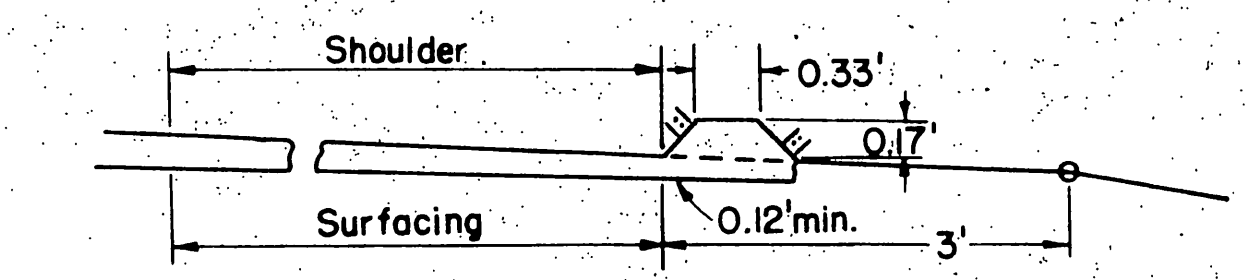


0.17' DIKE

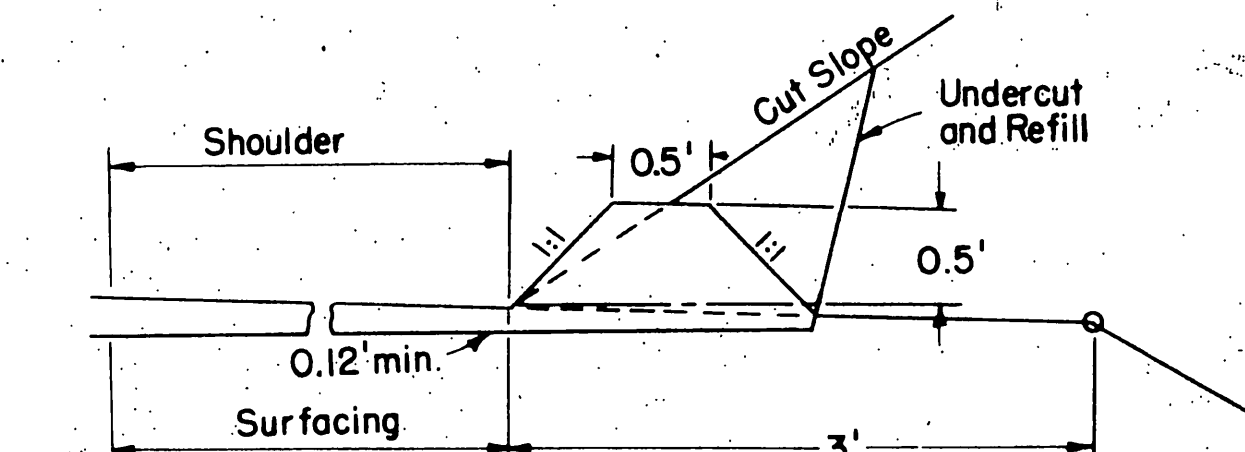

0.5' DIKE

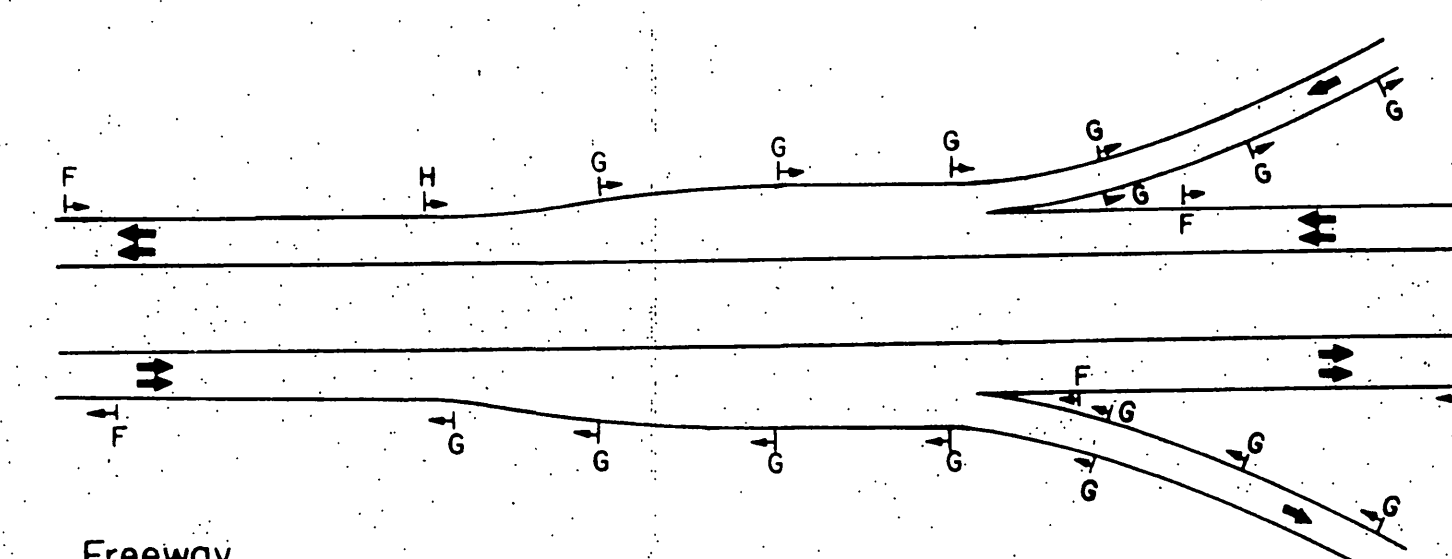


DELINEATION OF RAMPS

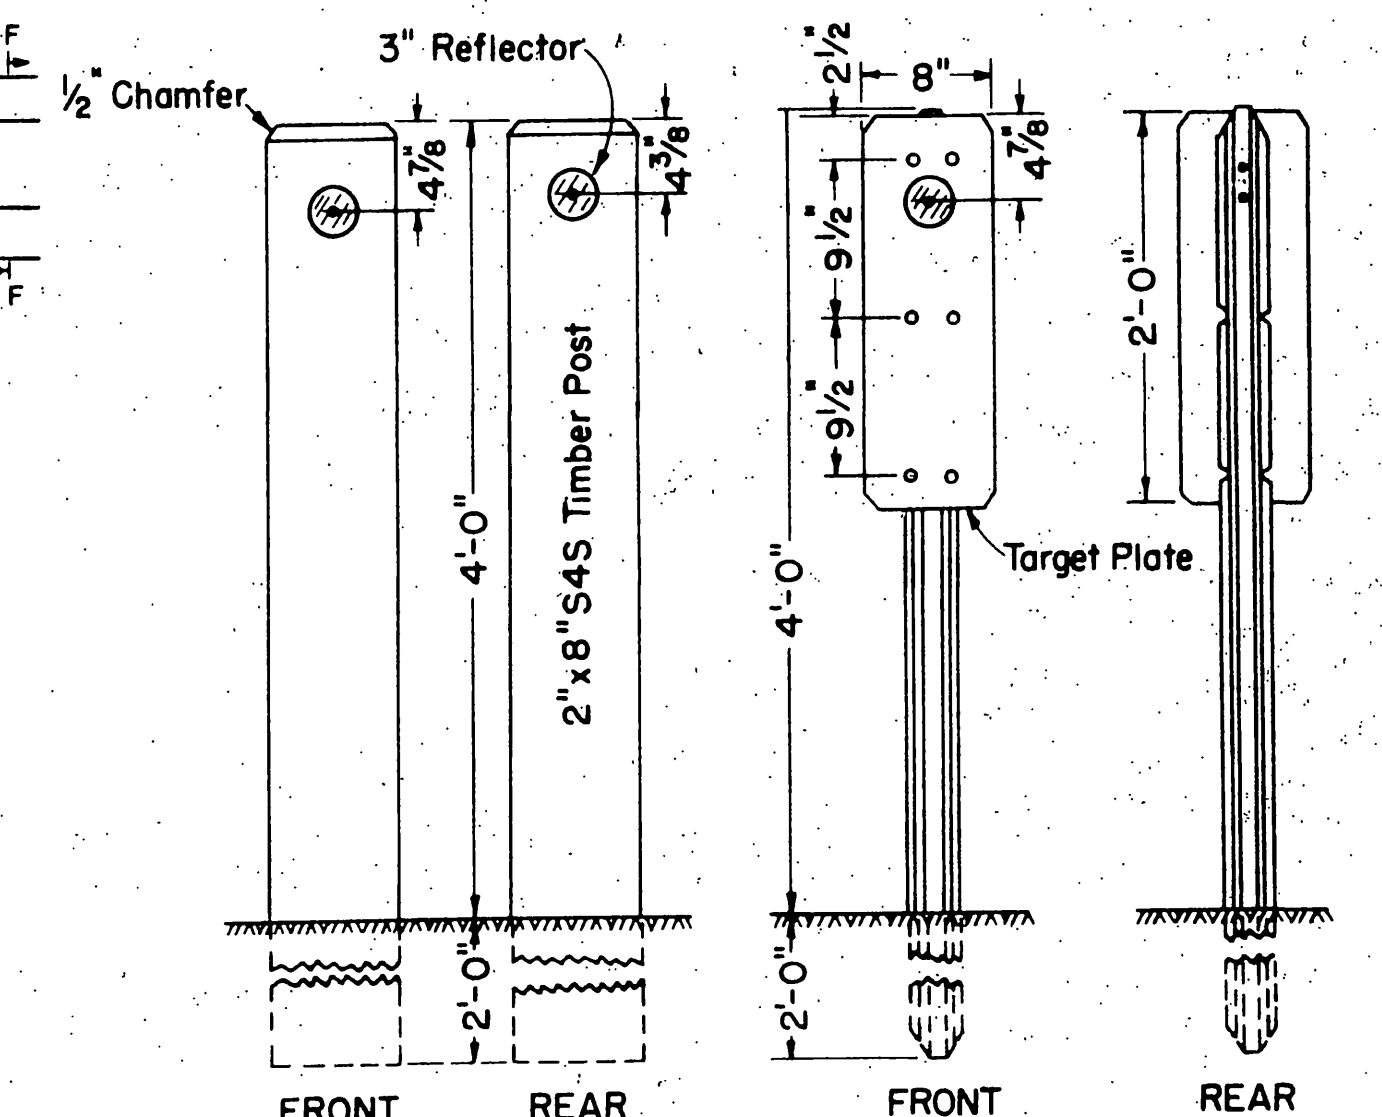

GUIDE MARKERS


Use type specified or as shown on plan summary

Reflector bracket used to mount 3" reflector to back of Guide Marker Post on curves. Brackets and reflectors to be attached with 3/16" blind aluminum rivets.

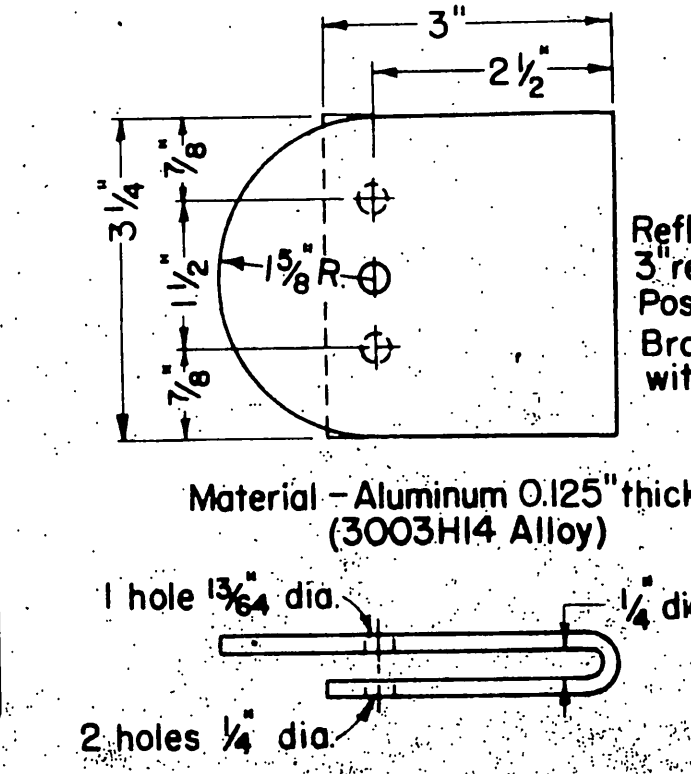


REFLECTOR BRACKET


GUIDE MARKERS REFLECTORS			
Type	Color	Front	Back
A	Clear	None	None
E	Clear	1-3"	1-3"
F	Clear	1-3"	None
G	Yellow	2-3"	None
H	Yellow	3-3"	None
I	Yellow	2-3"	1-3"
Horizontal Reflector Markers W6IR			
K	Yellow	3-3"	None
Clearance Markers			
L	Yellow	3-3"	None

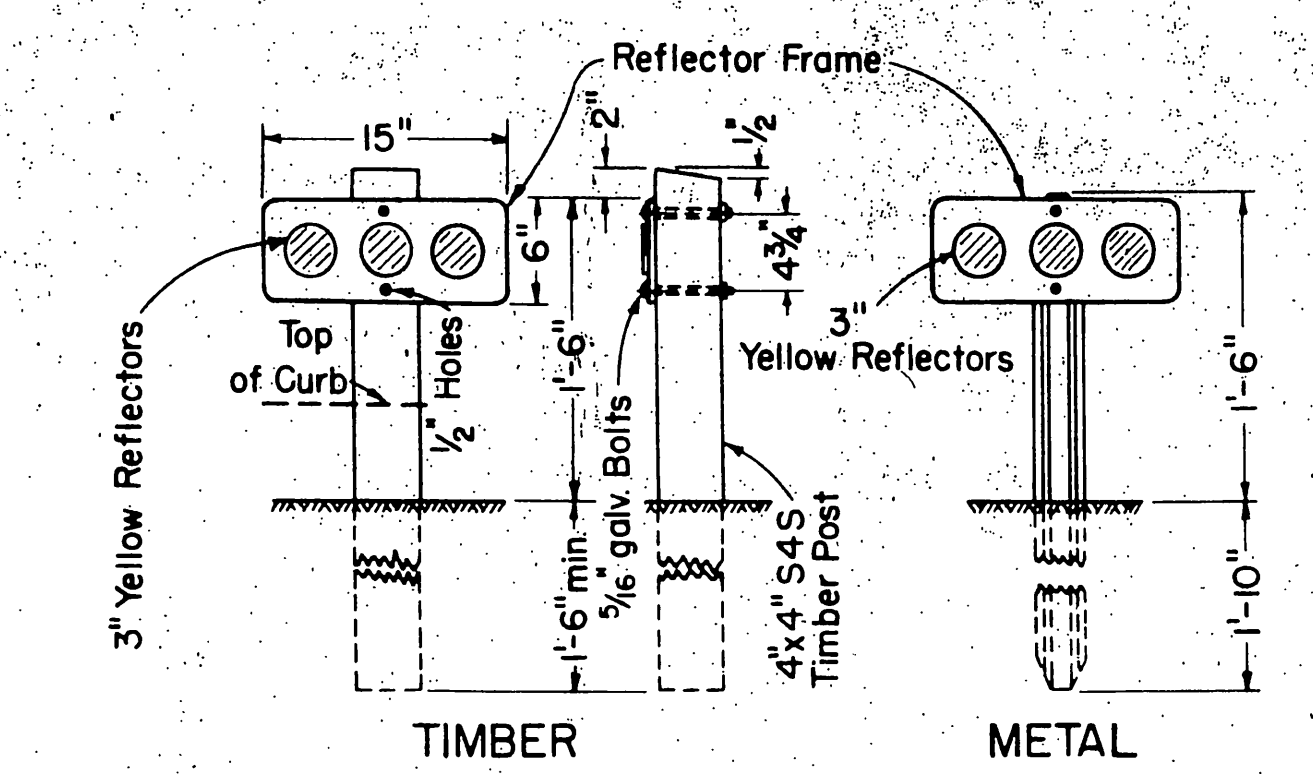

HORIZONTAL REFLECTOR MARKERS W6IR

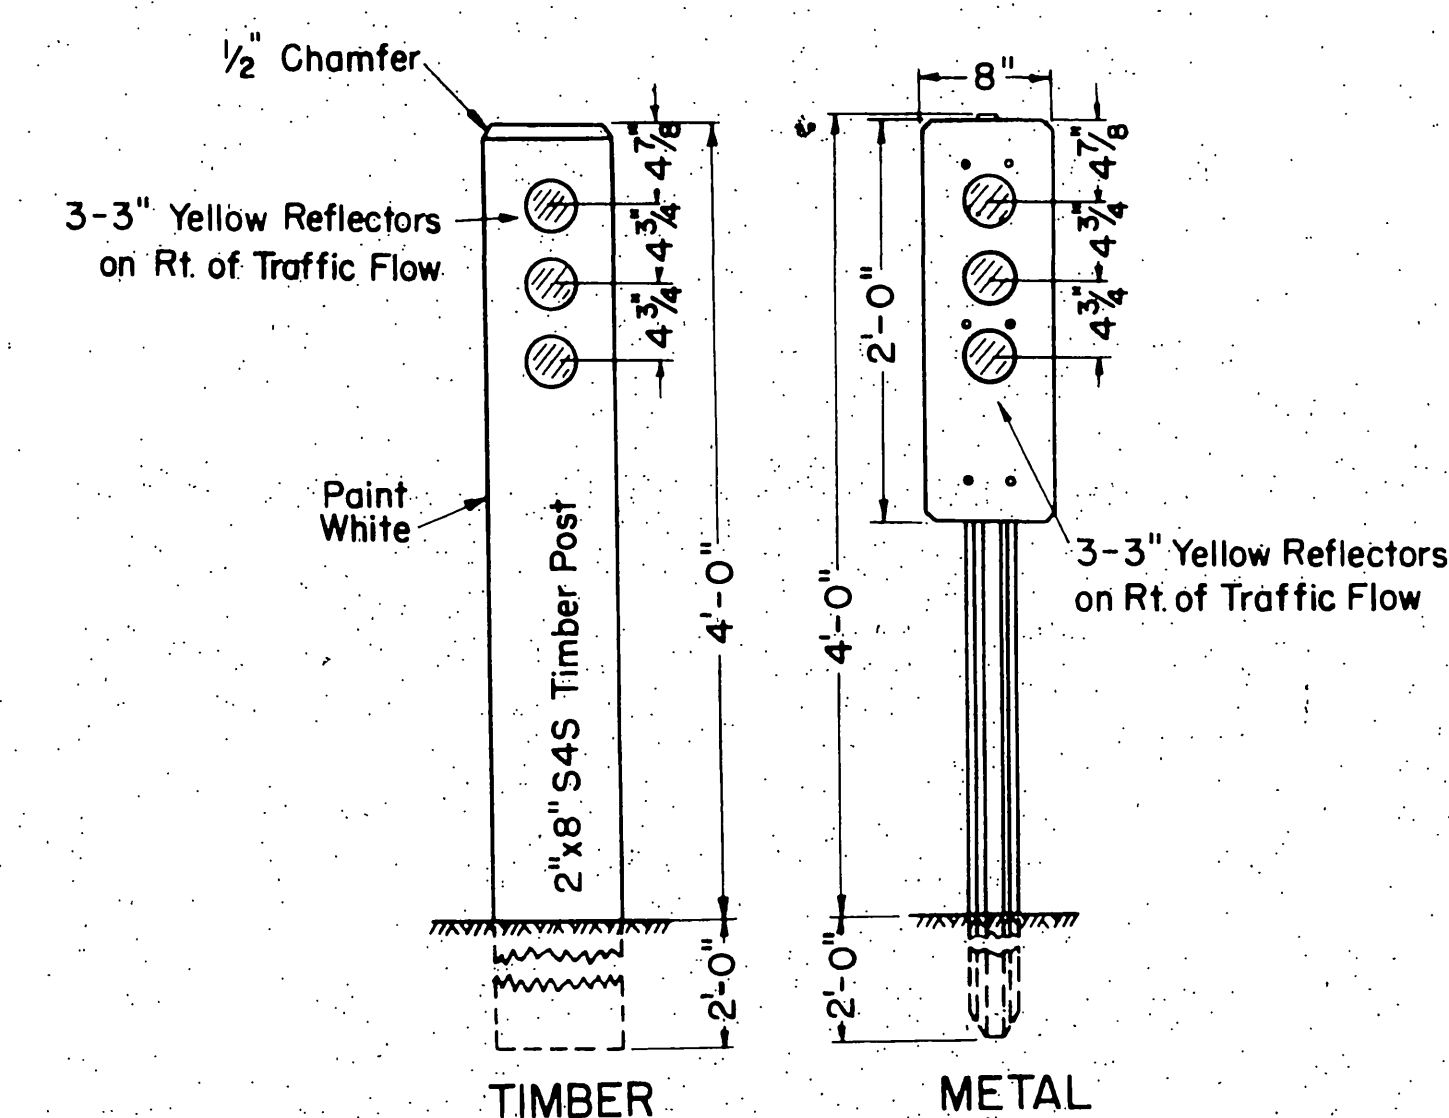


CLEARANCE MARKERS

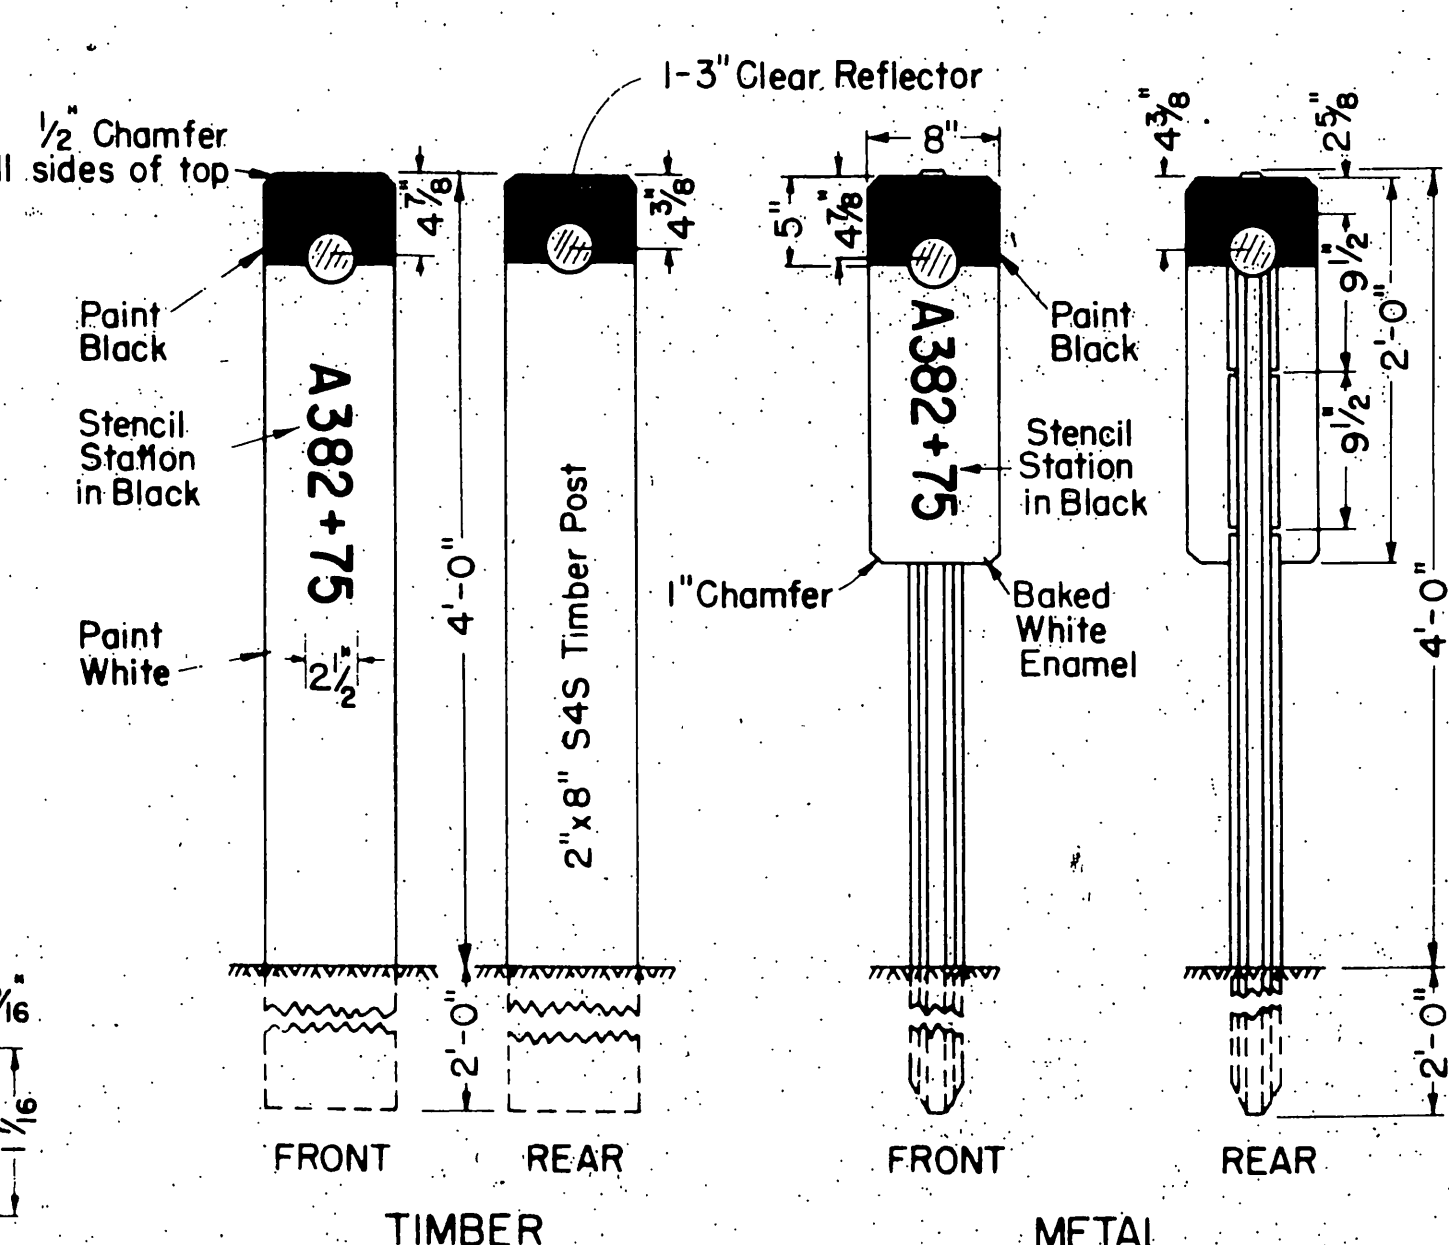


CULVERT MARKERS

To be reflectorized when specified or as shown on culvert list

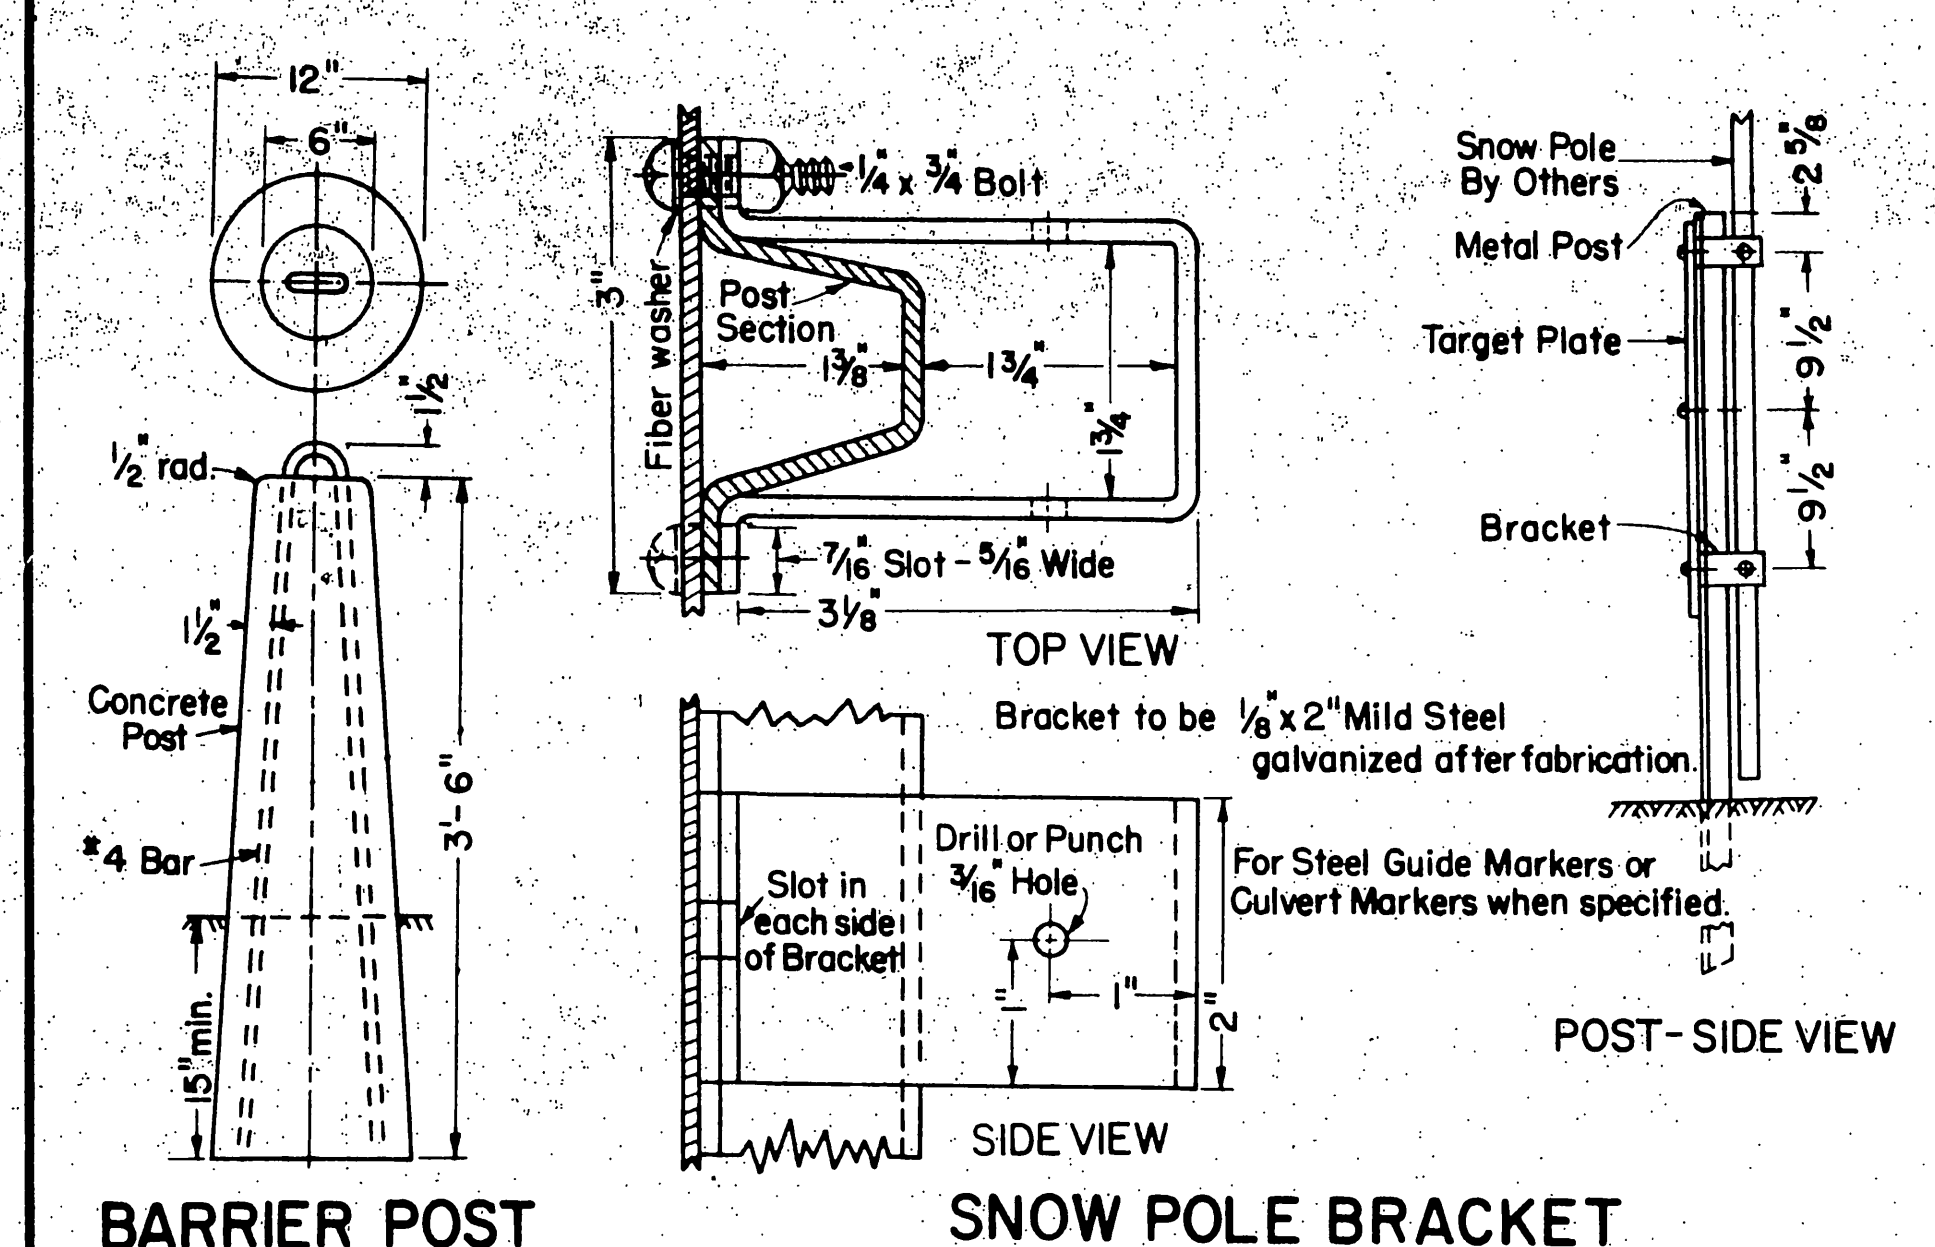


BARRIER POST


SNOW POLE BRACKET

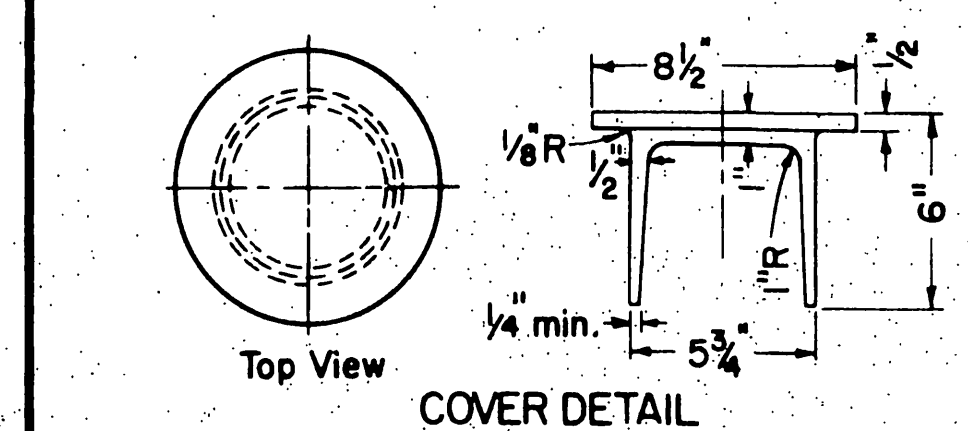


COVER DETAIL

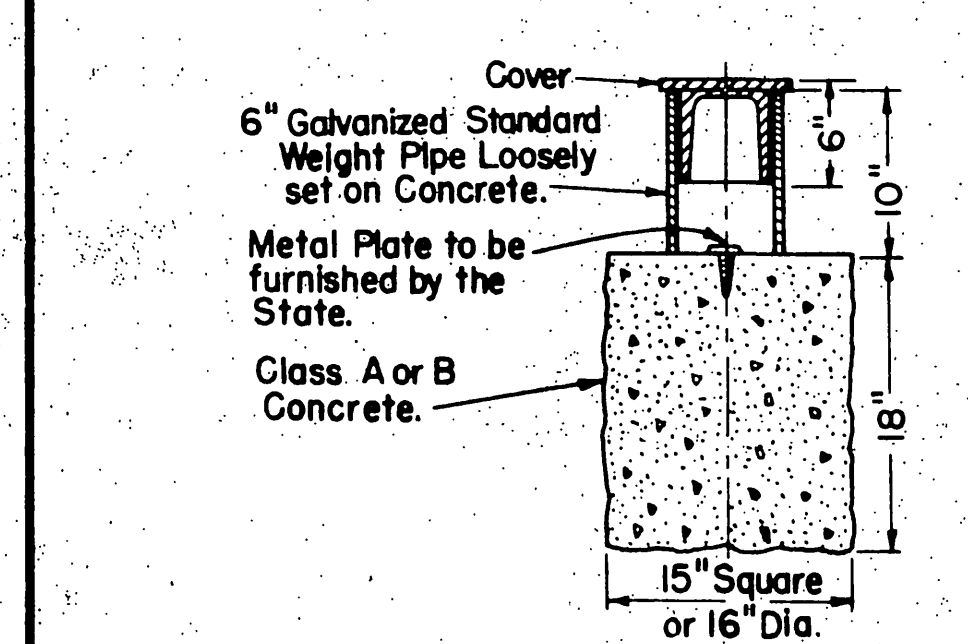


TYPE B

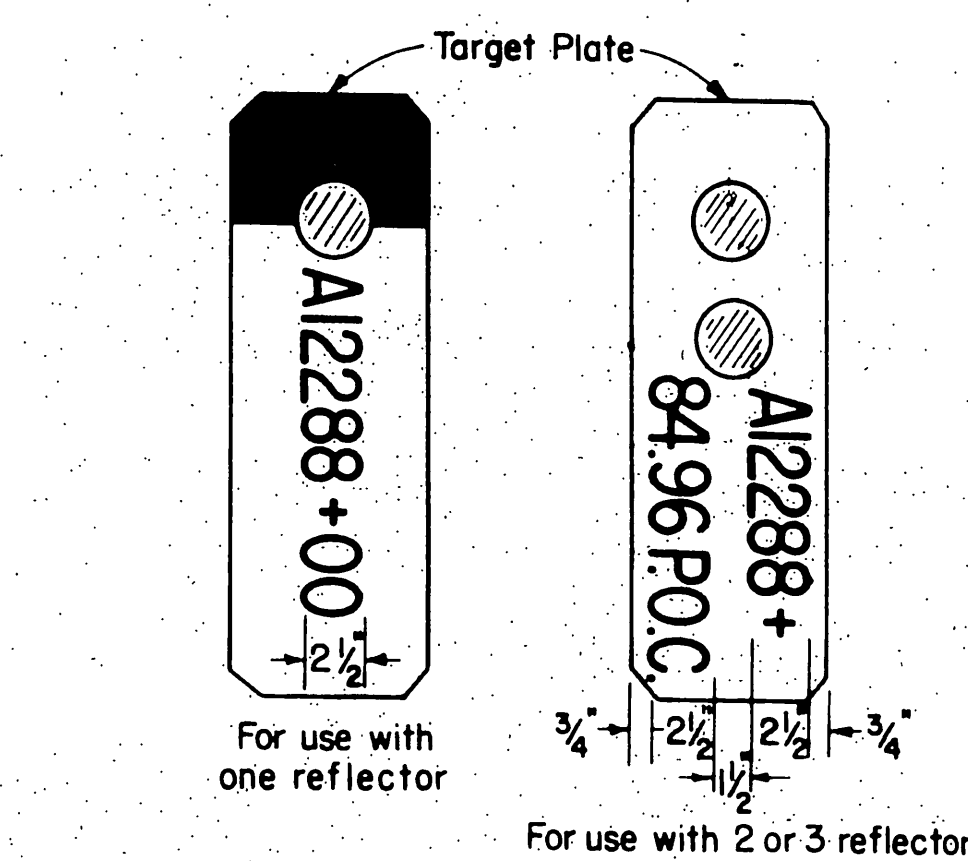


STANDARD STENCILING FOR REFLECTORIZED CULVERT MARKERS

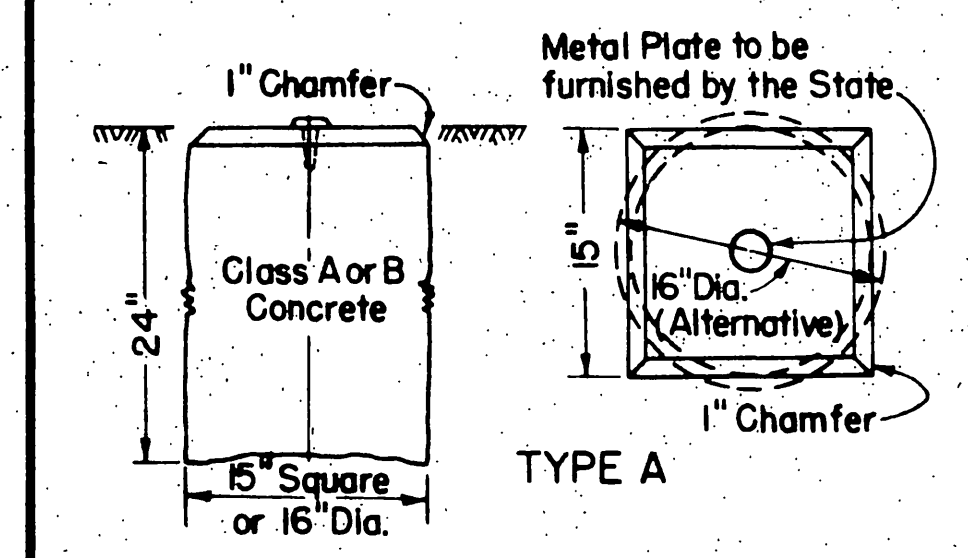


SURVEY MONUMENTS

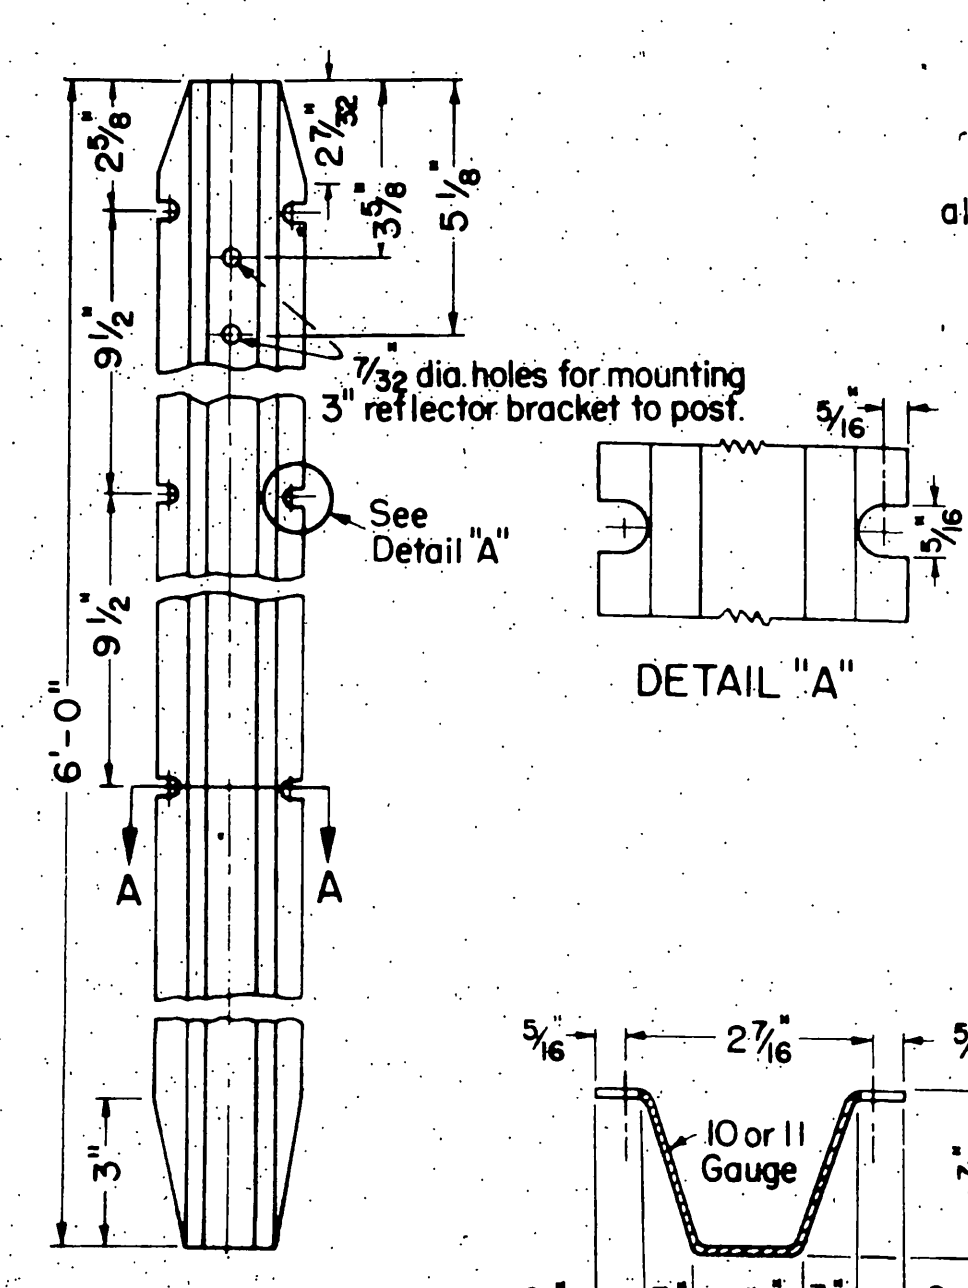

METAL MARKER POST

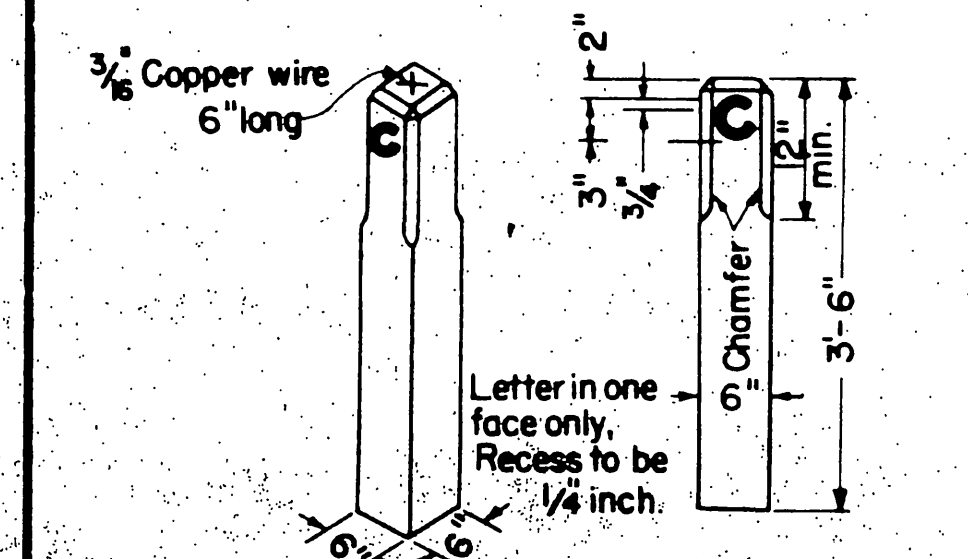

R/W AND ACCESS OPENING MONUMENTS

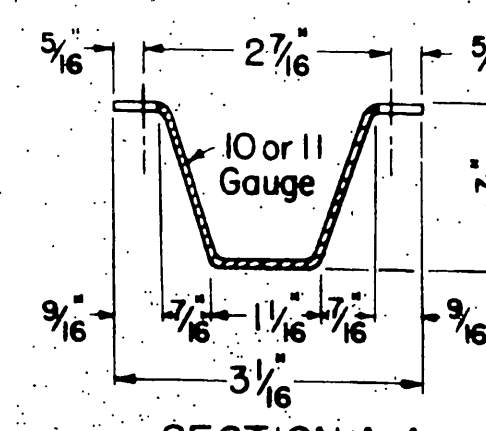

SECTION A-A

STATE OF CALIFORNIA
 DEPARTMENT OF PUBLIC WORKS
 DIVISION OF HIGHWAYS


SH. 20
 R. 897
 A74-3

DIKES AND MARKERS


To accompany plans dated August 28, 1961

DISTRICT	COUNTY	ROUTE	SECTION	SHEET NO.	TOTAL SHEETS
VIII	Riv	700	(3)	21	25


J. Logan
 ENGINEER OF DESIGN
 CIVIL ENGINEER LICENSE NO. 5630
 APPROVED July 1, 1960
[Signature]
 STATE HIGHWAY ENGINEER
 CIVIL ENGINEER LICENSE NO. 5945

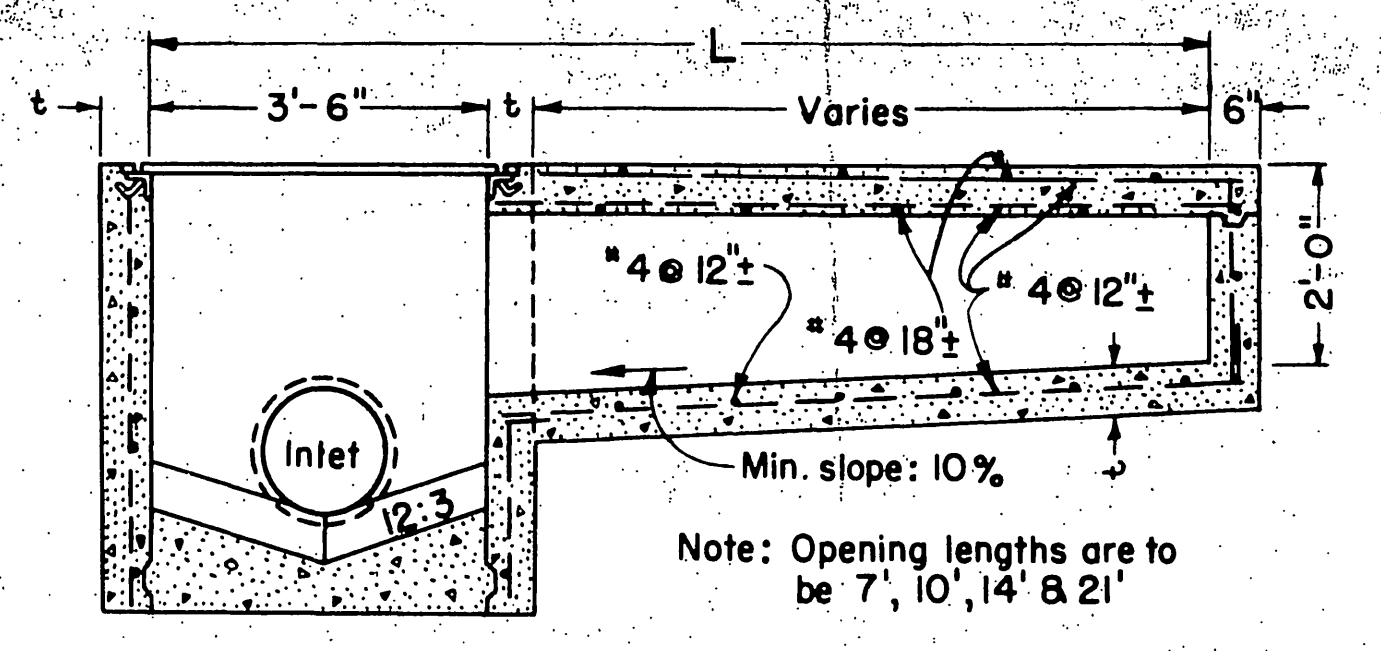


SECTION A-A

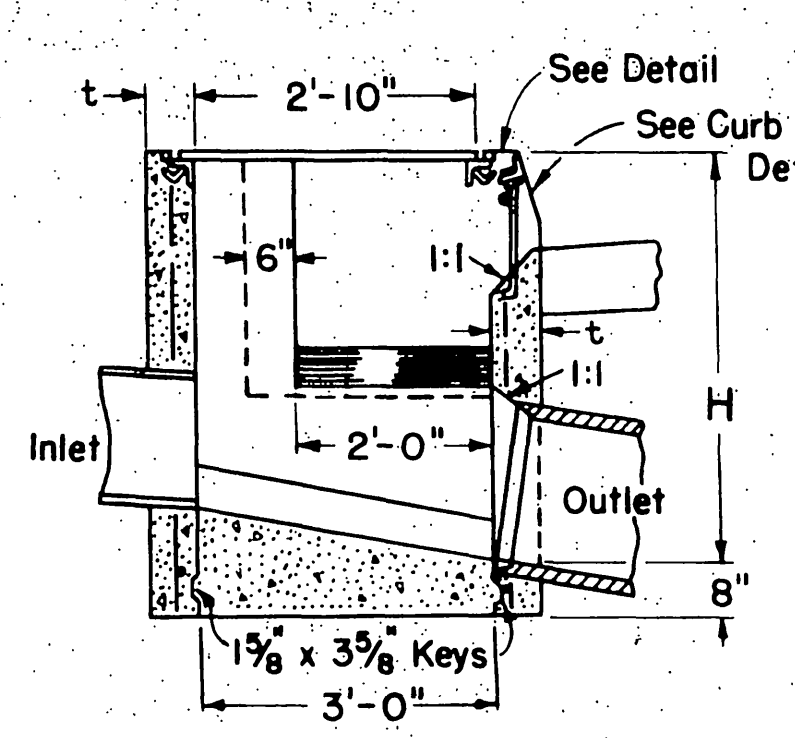


SECTION B-B

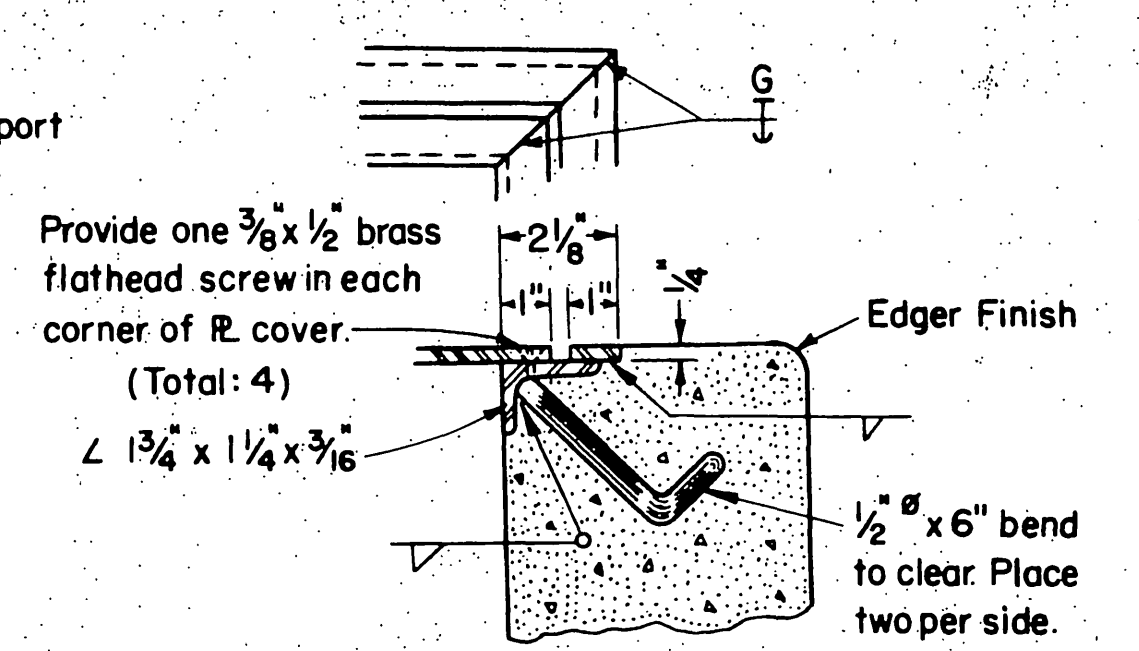


SECTION C-C

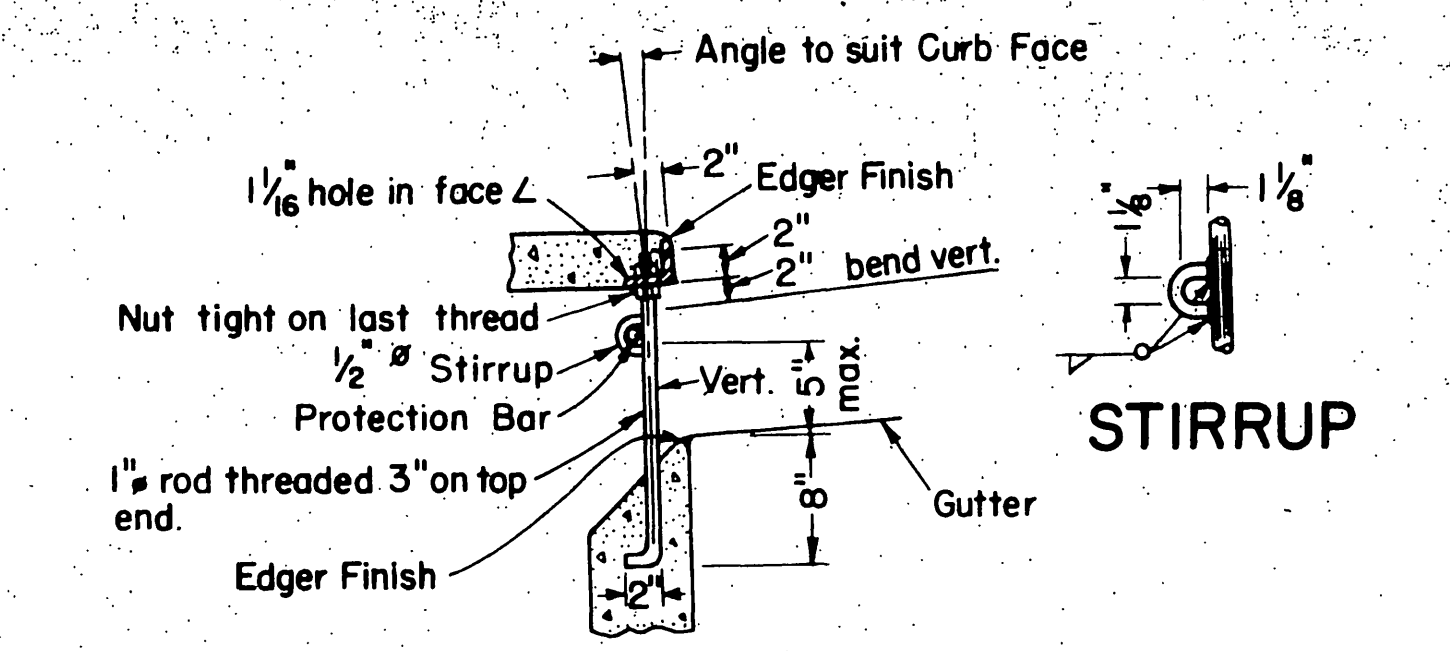


CURB SUPPORT DETAILS

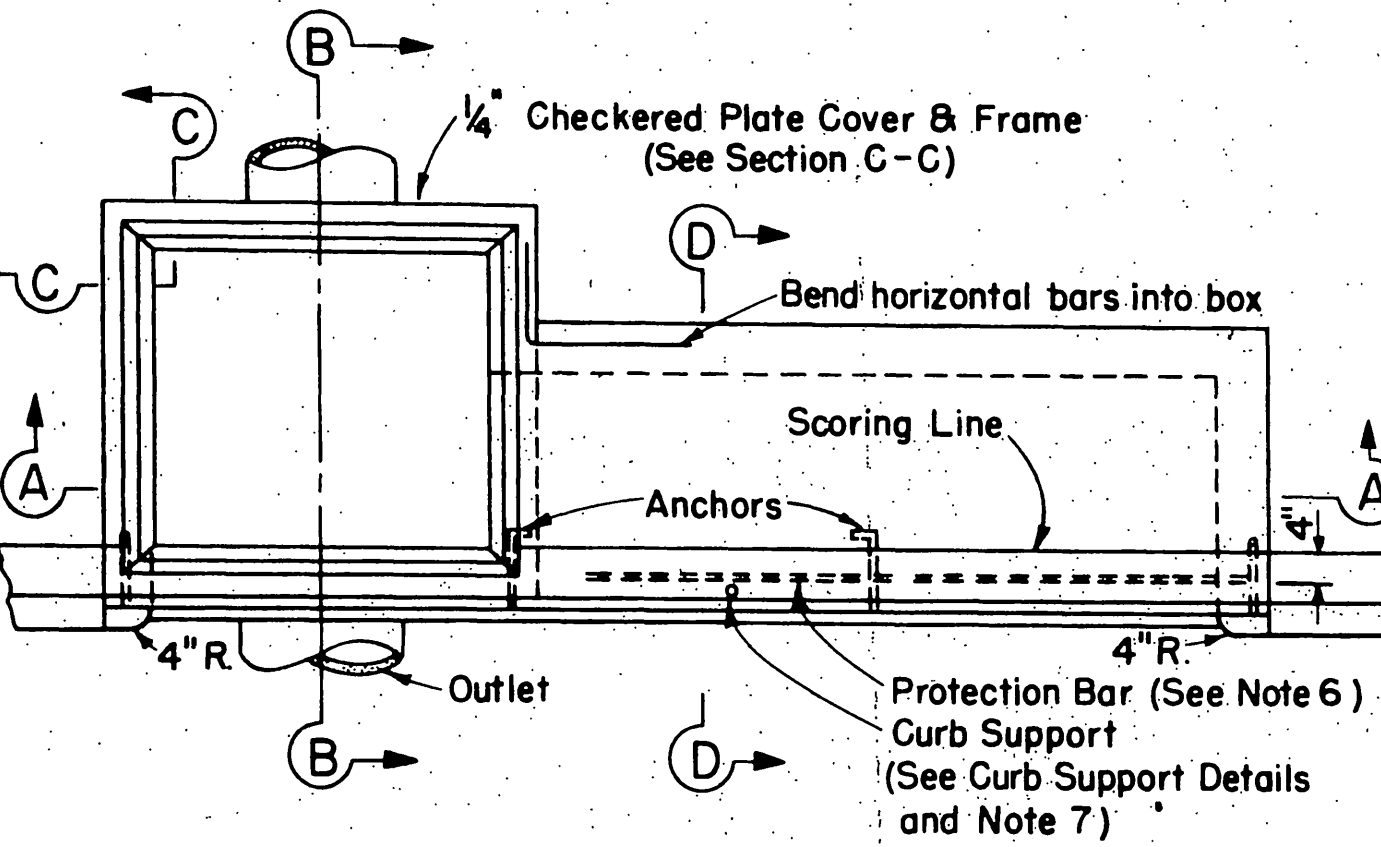


PLAN

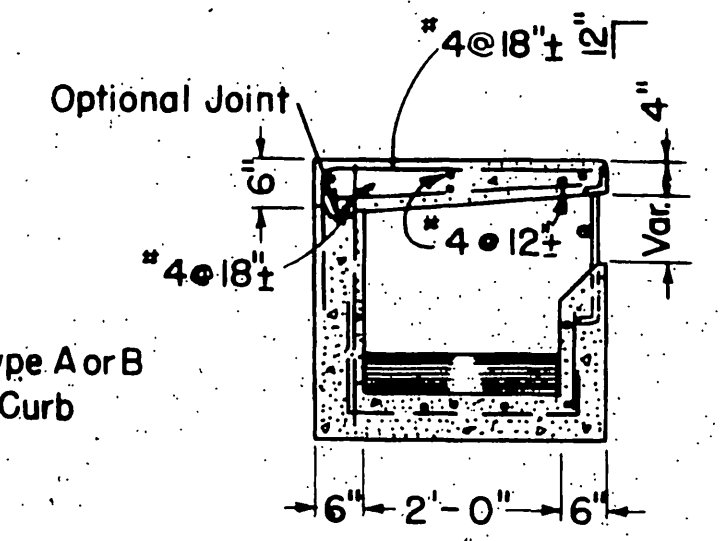

SECTION D-D

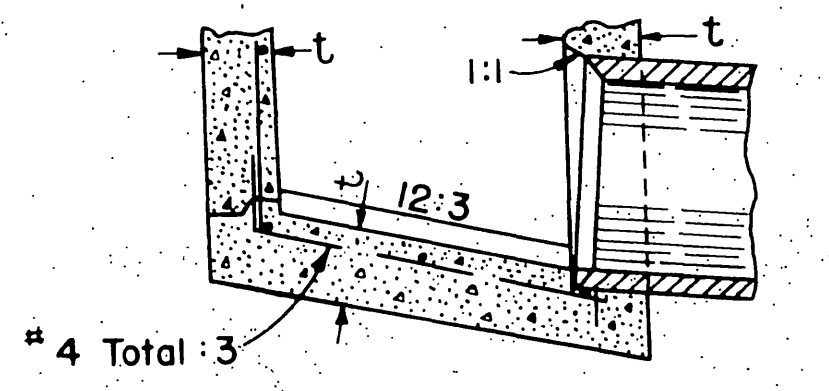


ALTERNATIVE REINFORCED BOTTOM (See Note 11)

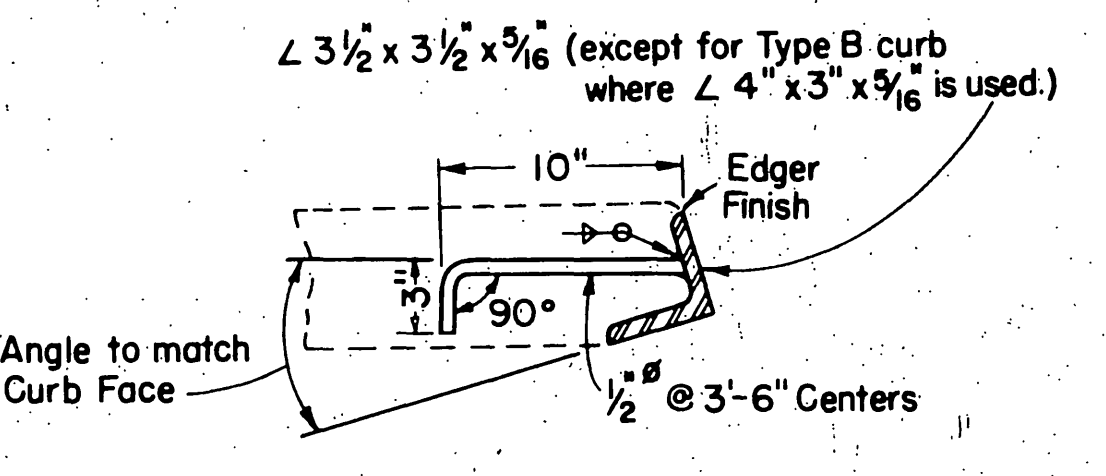

FACE ANGLE ANCHOR DETAIL


GENERAL NOTES

- "H" Depth for all boxes is 3'-6" unless otherwise specified.
- For "t" wall thickness see Table.
- Height of curb opening will vary with the type of curb and the depth of the local depression.
- Reinforcing steel shall be #4 bars @ 18" centers placed 1 1/2" clear to inside of box unless otherwise shown.
- Steps - None required where "H" is 3'-6" or less. Install one step 16" above floor when "H" is more than 3'-6" and less than 5'-0". Where "H" is more than 5'-0", steps shall be evenly spaced @ 16" intervals from 16" above floor to within 12" of the top of the box. Place steps in wall without pipe openings.
- When curb openings are 7" high or more. Place a 3/4" protection bar horizontally across the entire length of the opening and bend back 4" into the inlet wall on each side.
- Curb openings longer than 7' shall have one curb support for each 7' increment or fraction thereof, evenly spaced.
- Pipe (s) can be placed in any wall.
- Curb section shall match adjacent curb.
- Except for inlets used as junction boxes, basin floors shall have a minimum slope of 12:3 from all directions toward outlet pipe and shall have a wood trowel finish.
- Galvanizing: See Standard Specifications or Special Provisions.
- No deduction in structure concrete quantities will be made for pipe wall thickness.
- See "Standard Grate Details" D77 for Grate and Frame details.
- See for Depression Details.

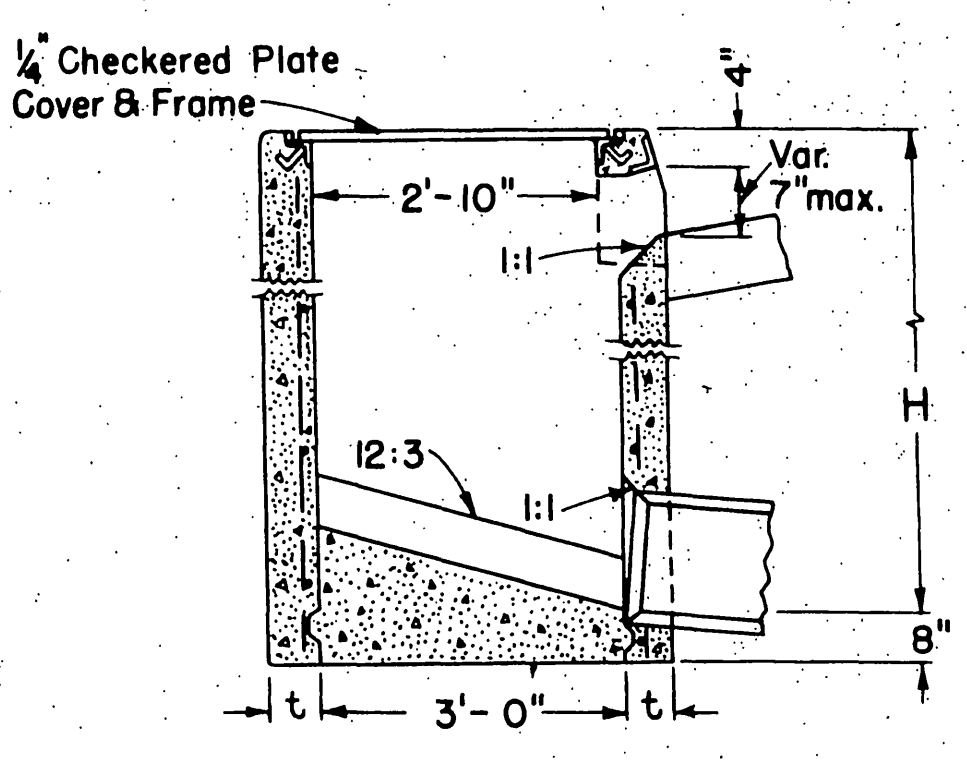


SECTION E-E

INLET TYPE OL

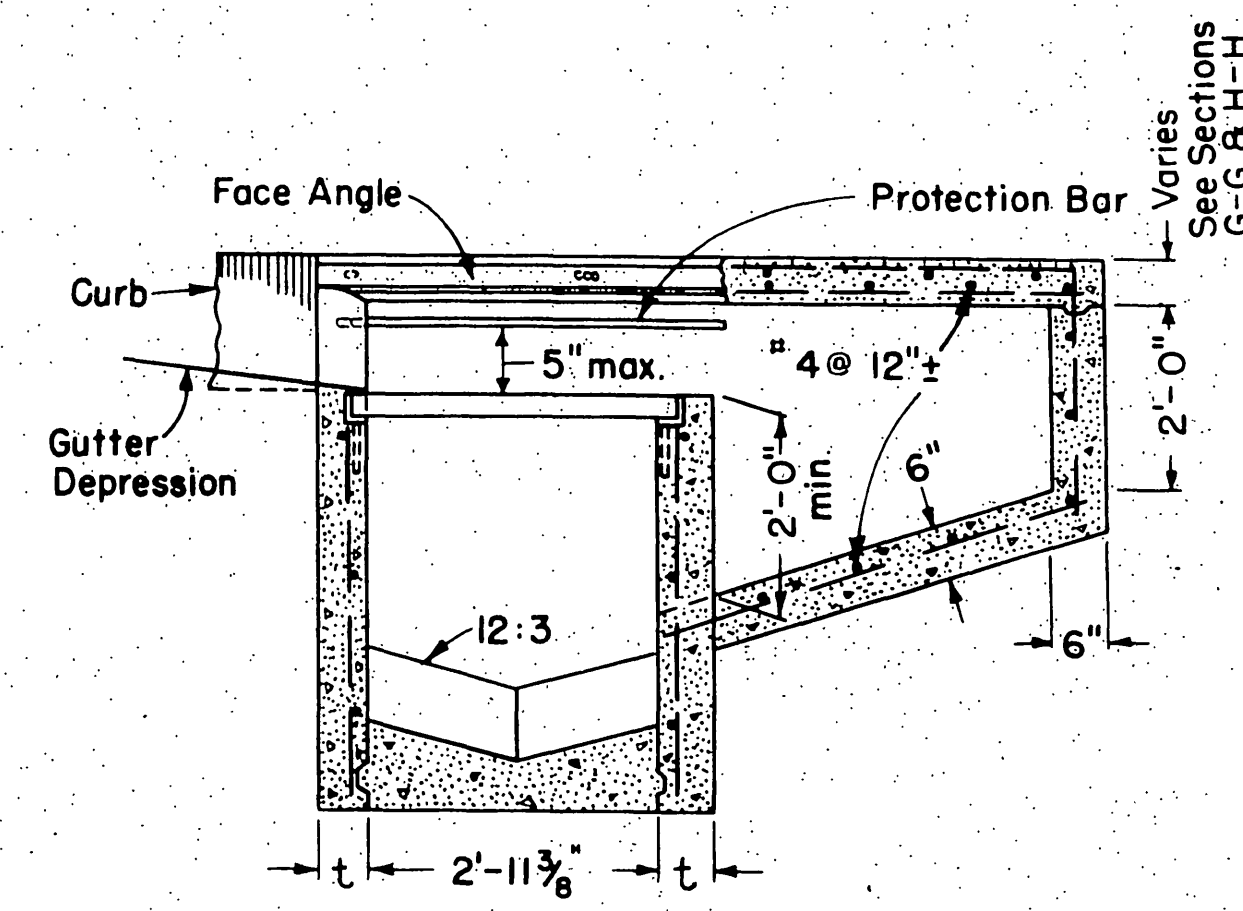


SECTION F-F


H	t
8'-0" or Less	6"
8'-1" to 20'-0"	8"

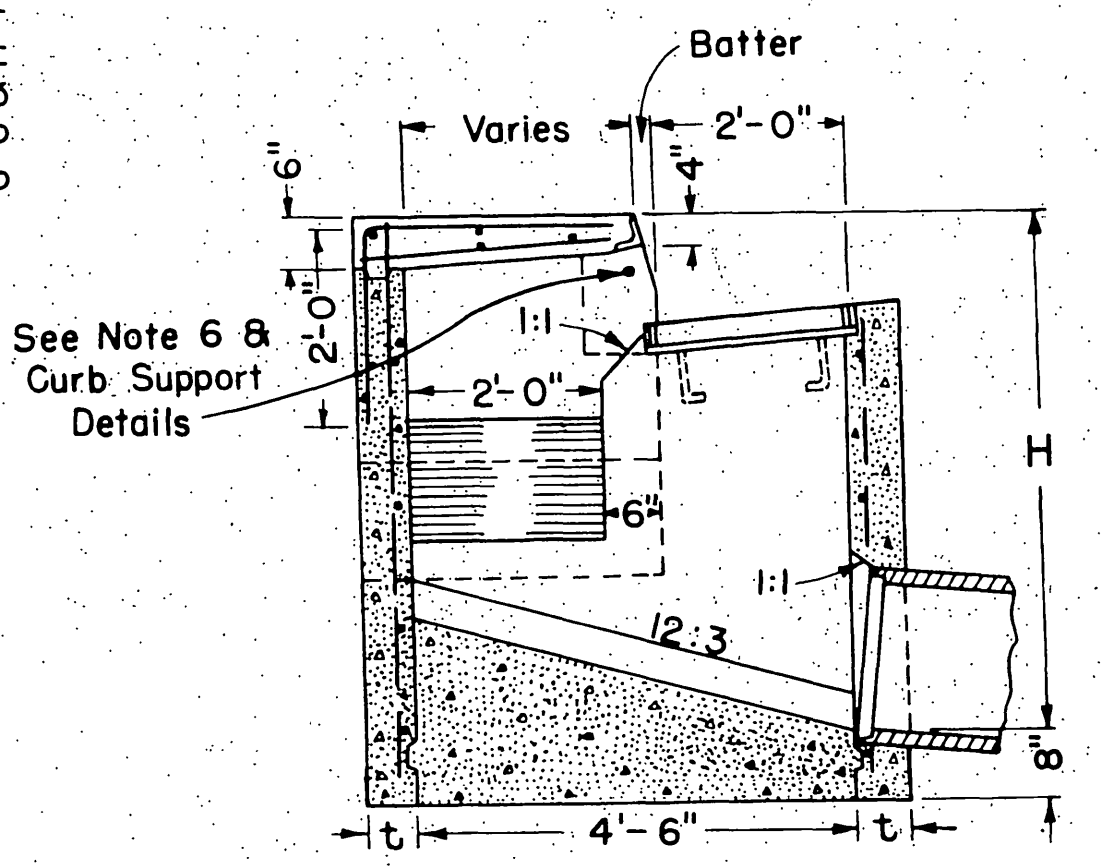


SECTION G-G

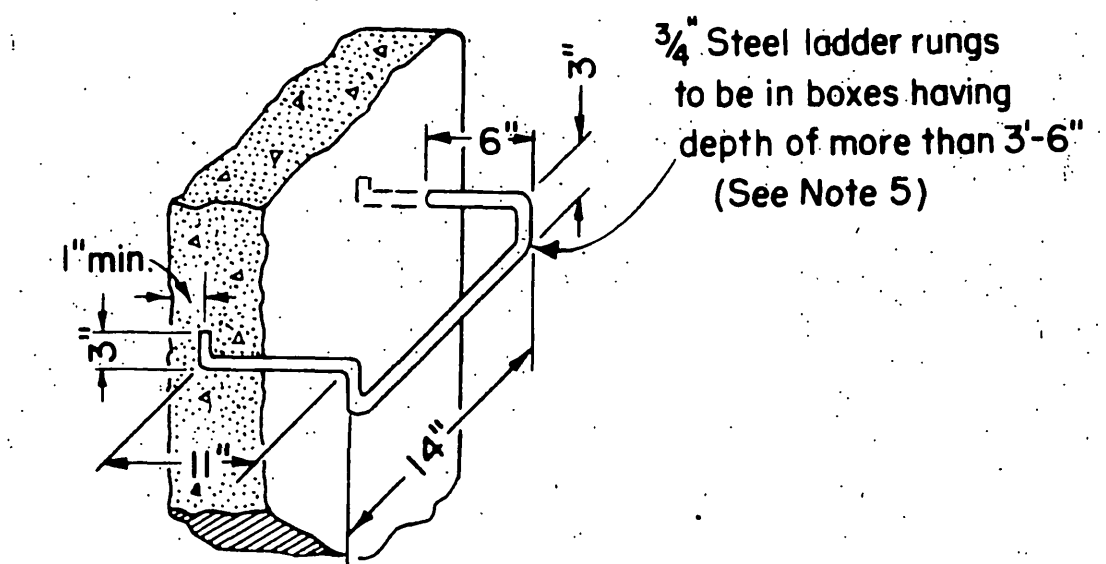

STEP DETAIL

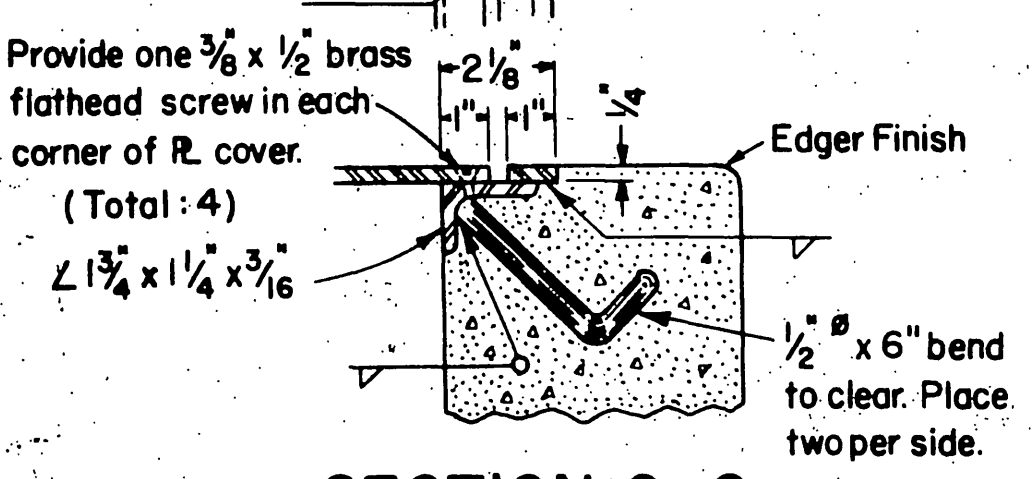


SECTION C-C

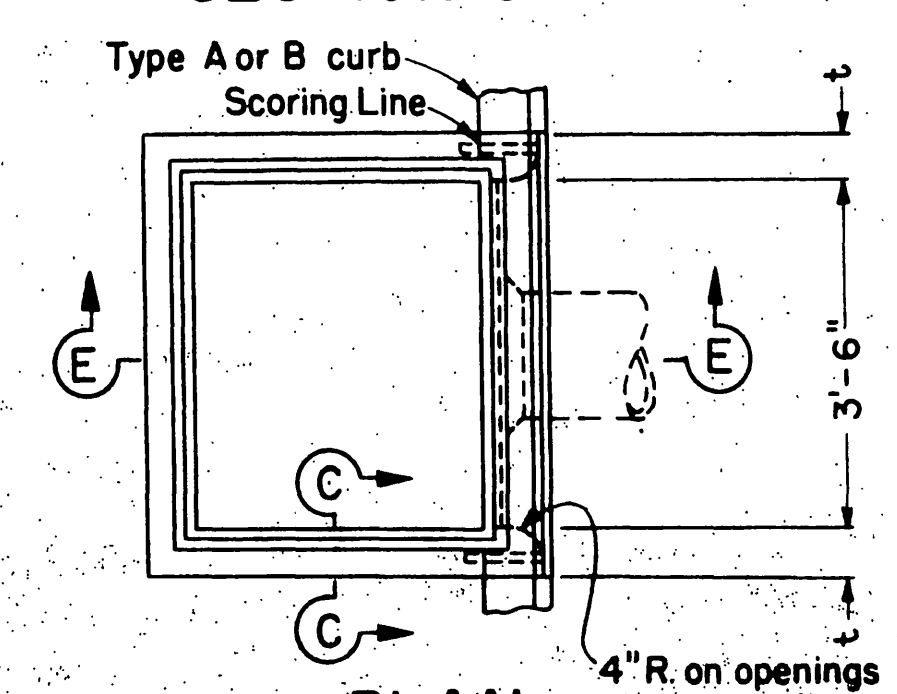


PLAN

INLET TYPE OS

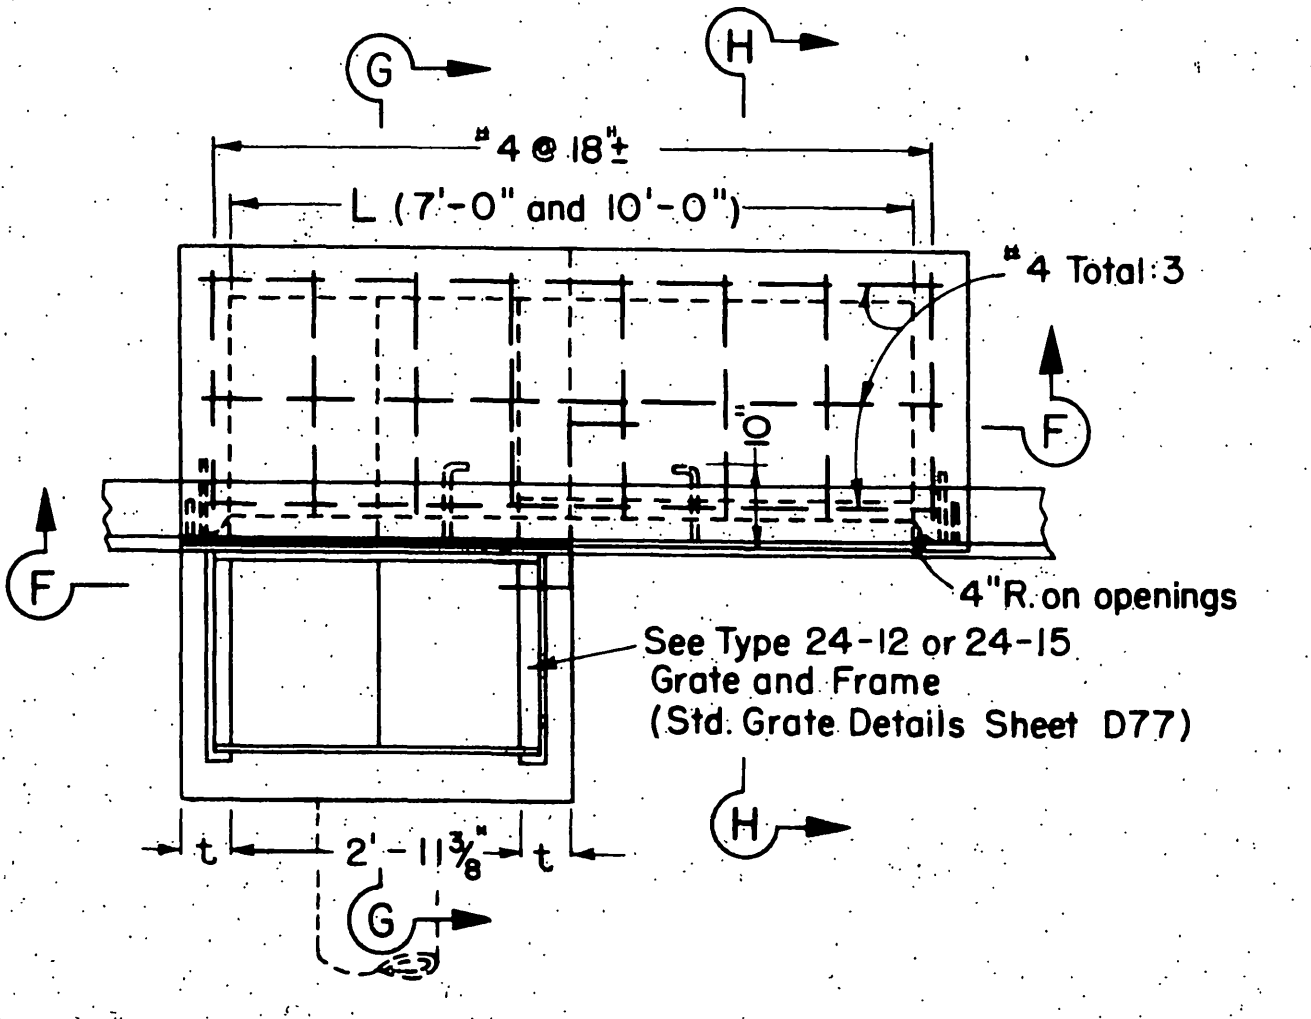


PLAN


INLET TYPE GOL

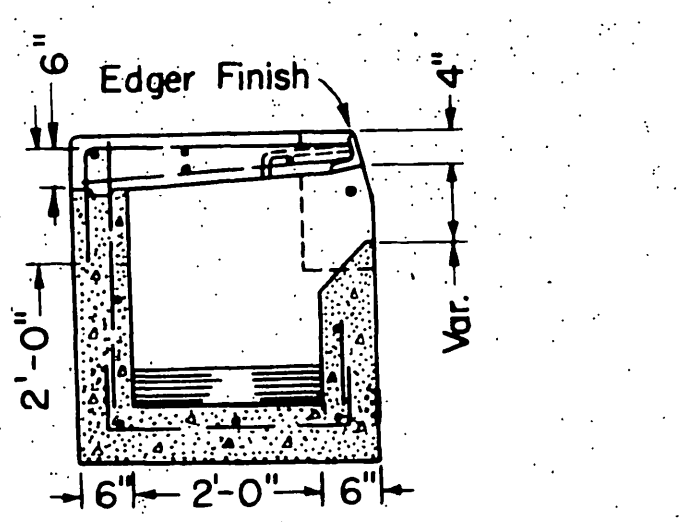

SECTION H-H

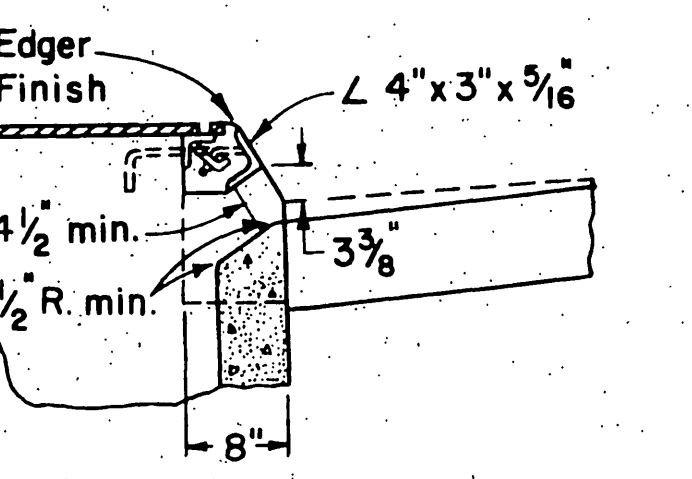

TYPE B CURB

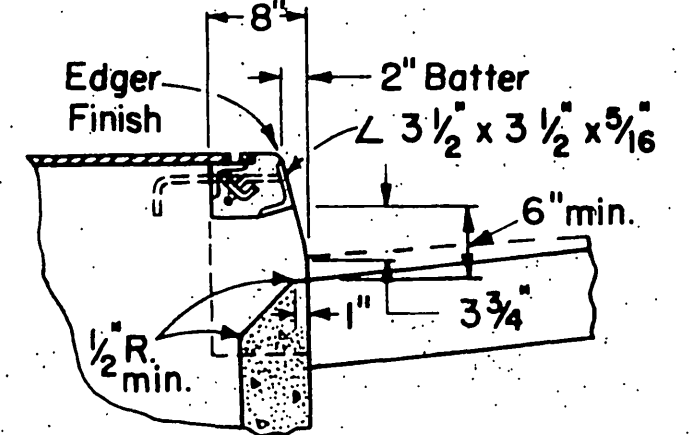

TYPE A CURB

CURB OPENING DETAILS

STATE OF CALIFORNIA
 DEPARTMENT OF PUBLIC WORKS
 DIVISION OF HIGHWAYS

STANDARD STORM DRAIN INLETS D72-1

SH. 21
 R-897

To accompany plans dated August 28, 1961

DISTRICT	COUNTY	ROUTE	SECTION	SHEET NO.	TOTAL SHEETS
VIII	Riv	100	(3)	22	25

APPROVAL RECOMMENDED


H. L. Harner
 Engineer of Design
 Civil Engineer License No. 7603

Approved February 9, 1961

James
 State Highway Engineer
 Civil Engineer License No. 5945

GENERAL NOTES

1. Grate type numbers refer to width of grate in inches and number of bars, respectively.
2. Contractor has the option of using cast nodular iron, cast steel, welded, bolted or cast end block grate.
3. Grates and frames may be galvanized or asphalt dipped. See Standard Specifications or Special Provisions.
4. Rounded top of bars optional on all grates.
5. Pipe drop inlets with a grate shall be placed so that bars parallel direction of principle surface flow.

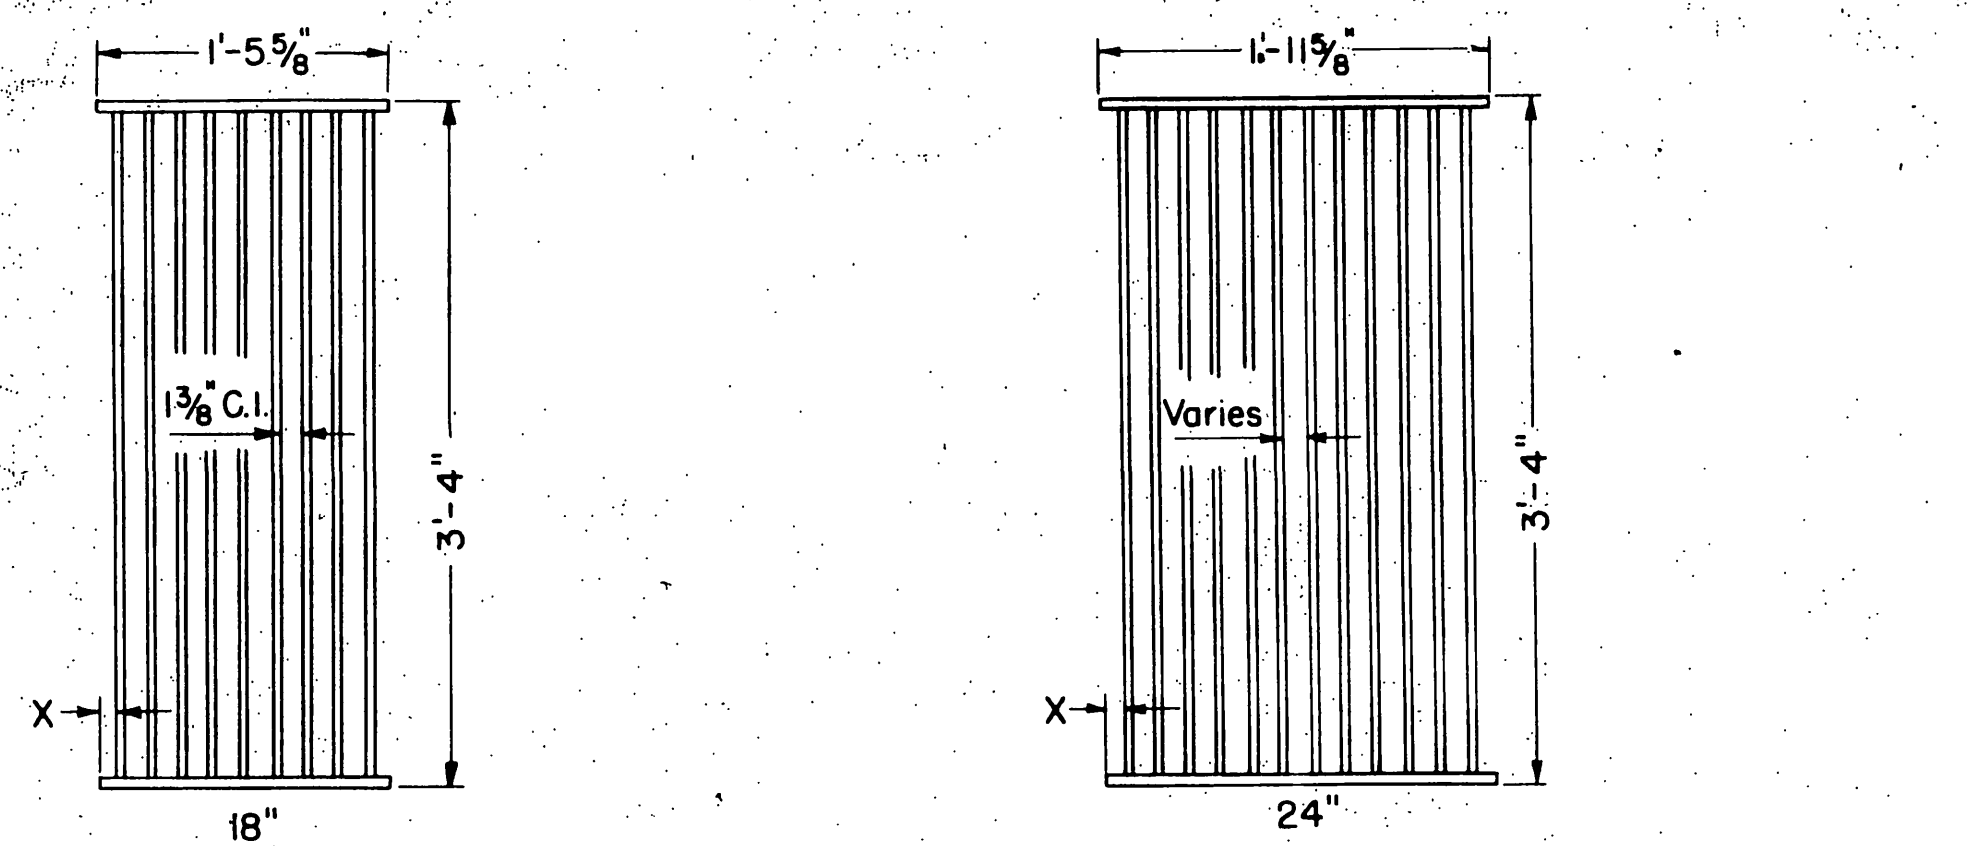


TYPE 18-9
 1 3/8" Clear Spacing
 Use within the roadbed on highways where bicycles and pedestrians are excluded - or for rural conditions.

TYPE 24-15
 1" Clear Spacing
 Use within the roadbed under urban conditions where bicycles and pedestrians are permitted.


TYPE 24-12
 1 3/8" Clear Spacing
 Use within the roadbed on highways where bicycles and pedestrians are excluded - or for rural conditions.

TYPE 24-9
 2" Clear Spacing
 Use in locations off the roadbed on all types of highways.


RECTANGULAR STEEL GRATE DETAILS
 (SEE TABLE BELOW)

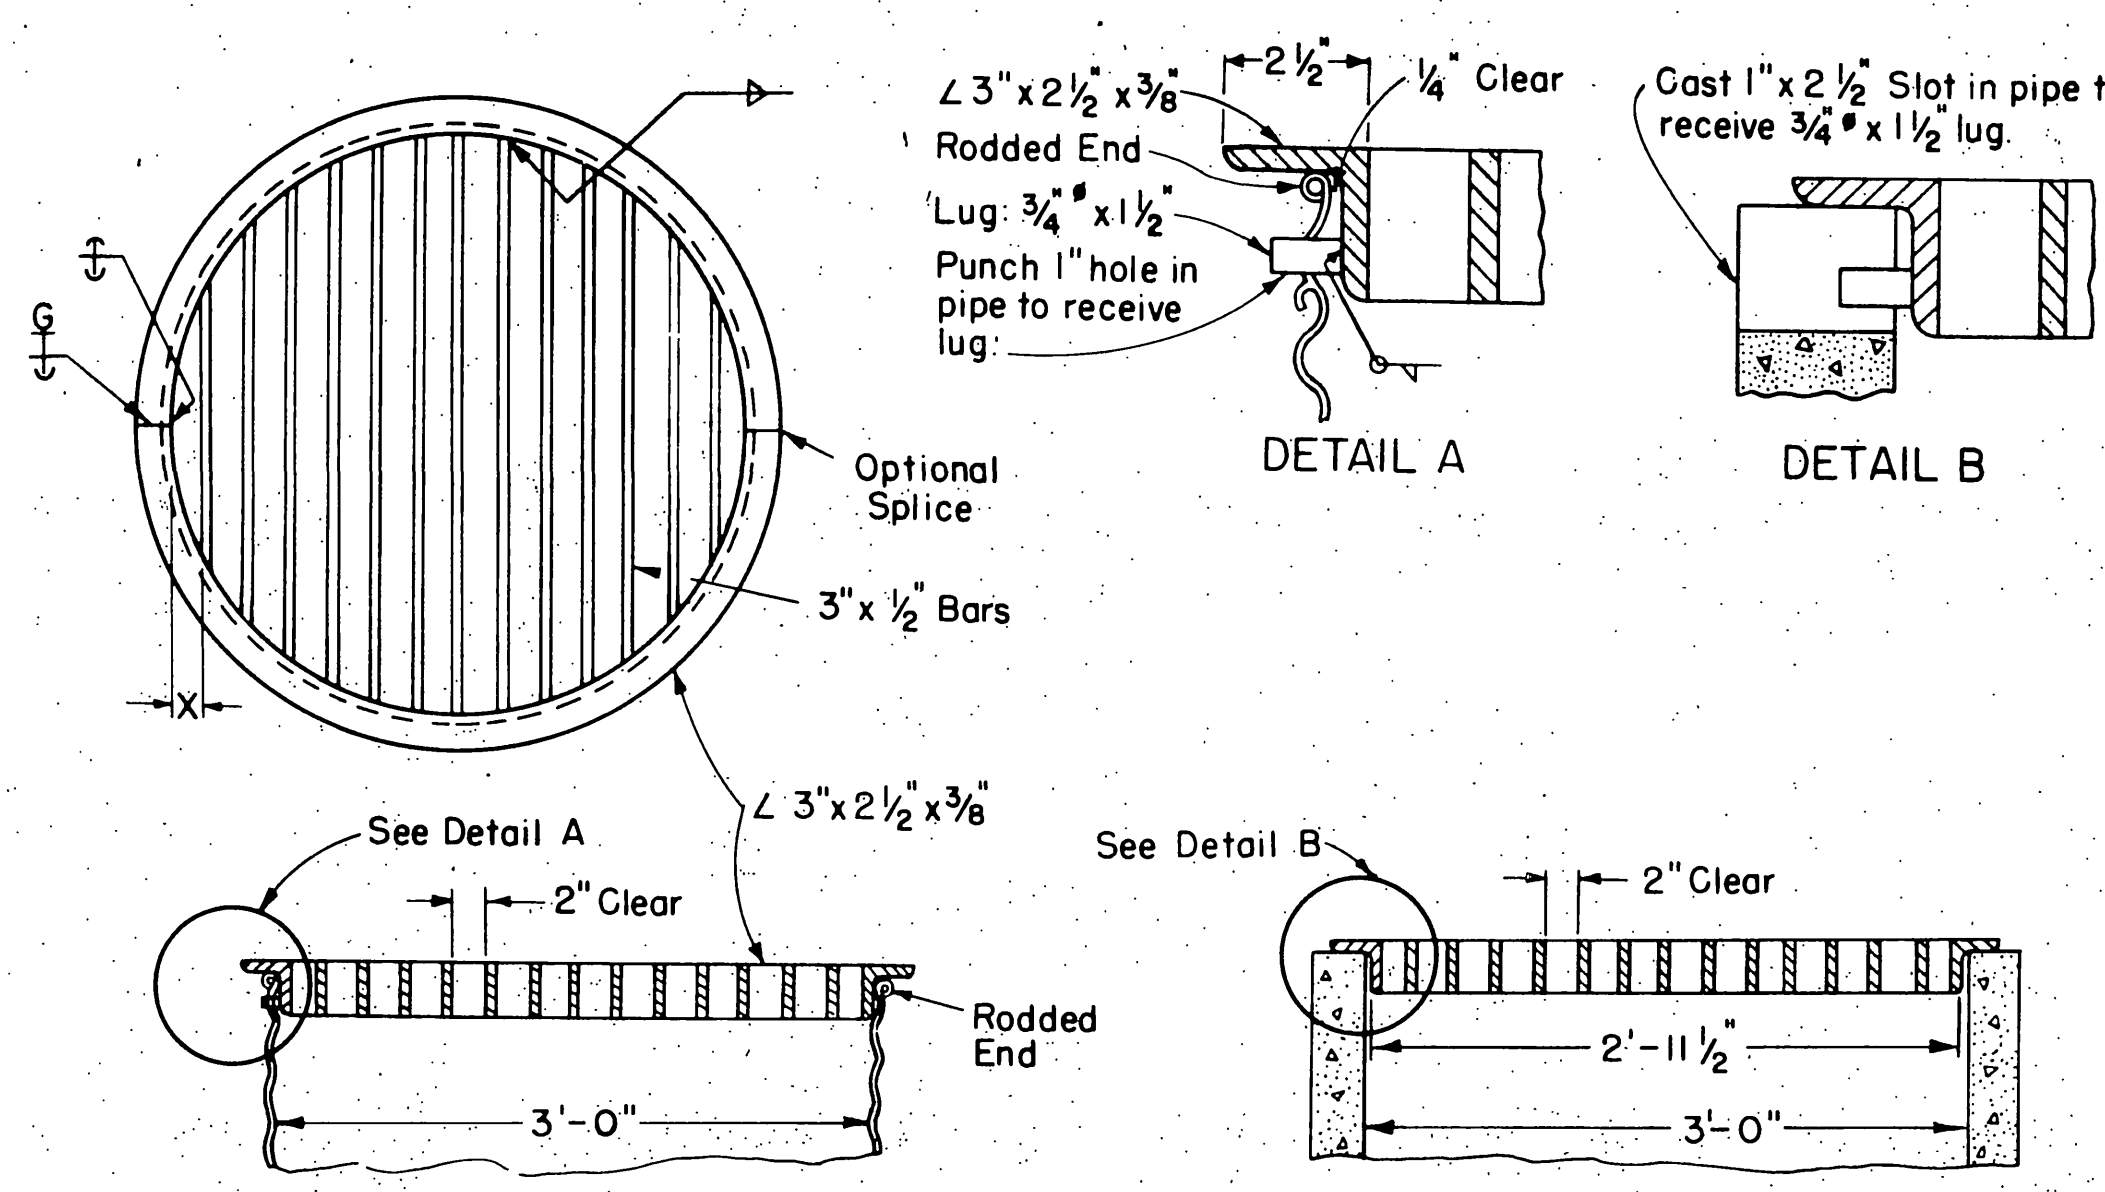


TYPE 36R GRATE DETAILS

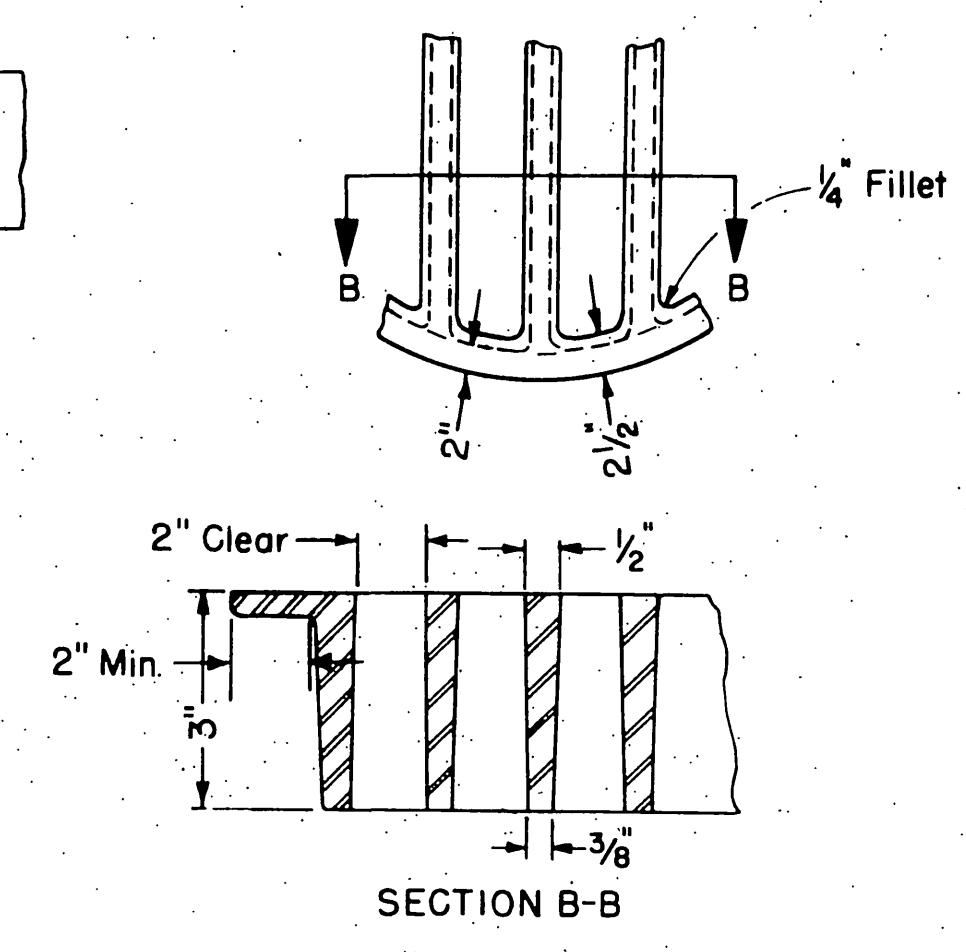


ALTERNATIVE CAST NODULAR IRON GRATE OR CAST STEEL GRATE TYPE 36R

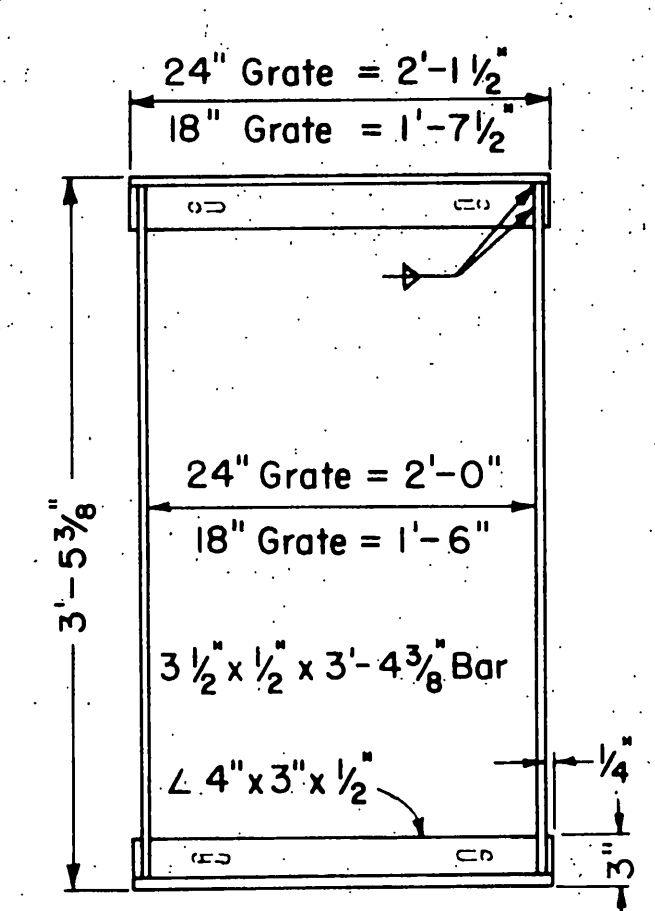

TYPICAL FRAME



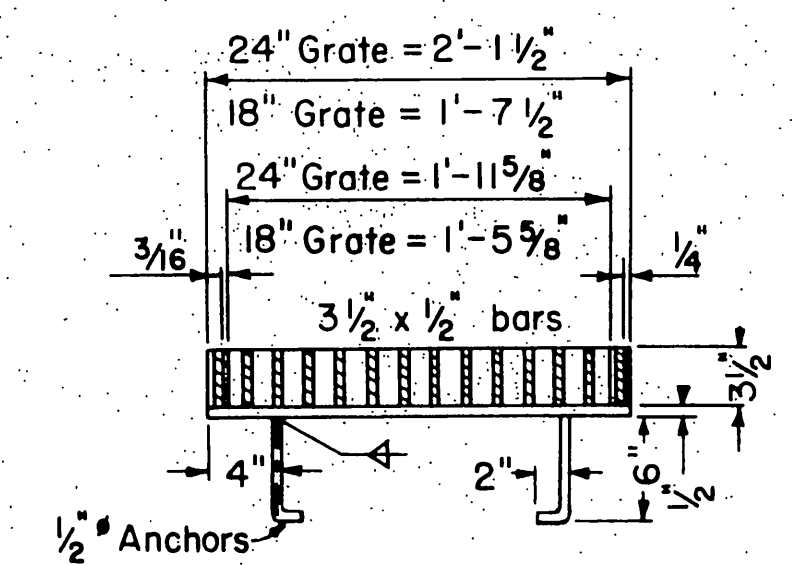


CROSS SECTION (Thru Frame and Grate)

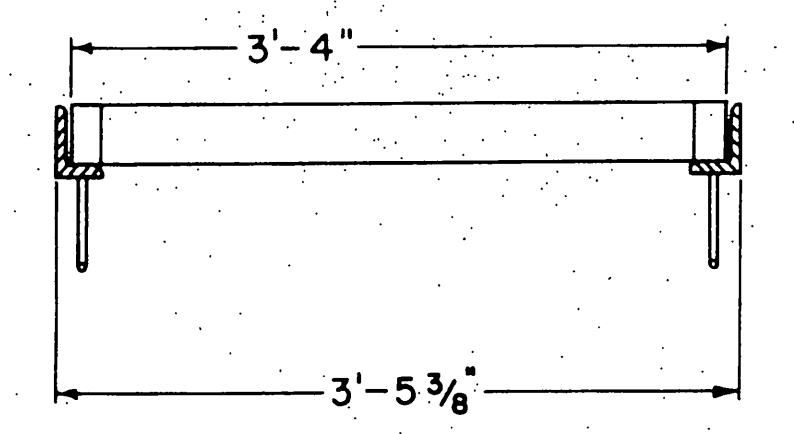



LONGITUDINAL SECTION (Thru Frame and Grate)

RECTANGULAR FRAME DETAILS
 (For all Rectangular Grates)

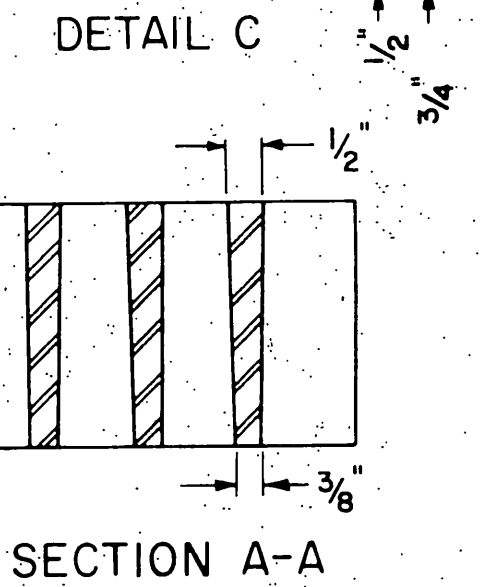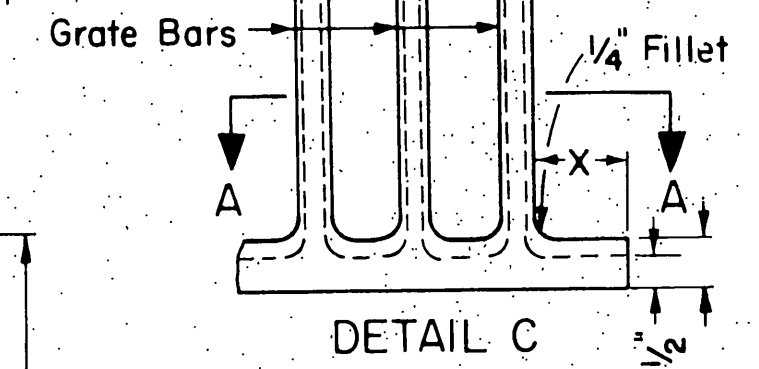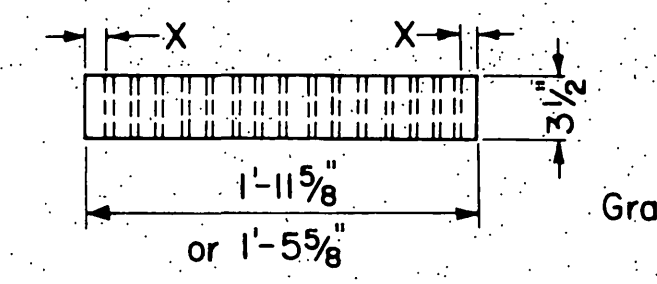


SECTION A-A


ALTERNATIVE CAST NODULAR IRON GRATE OR CAST STEEL GRATE

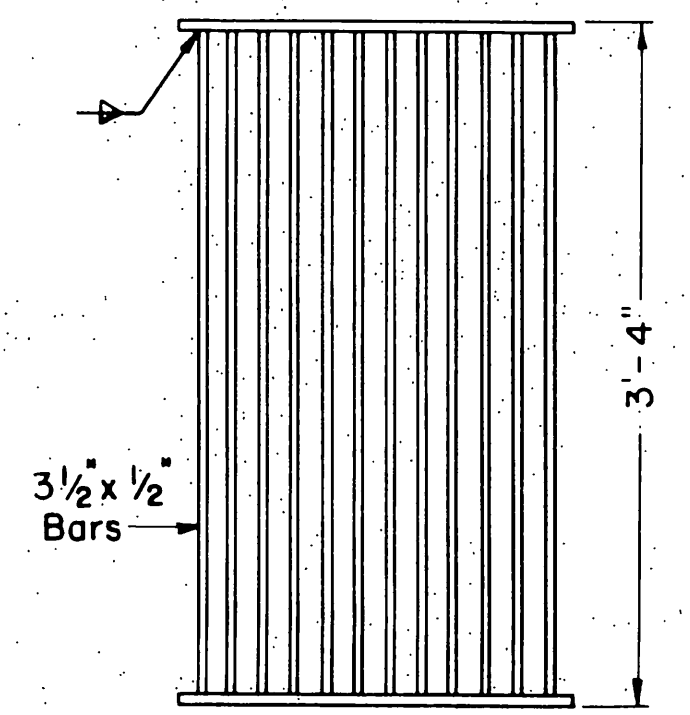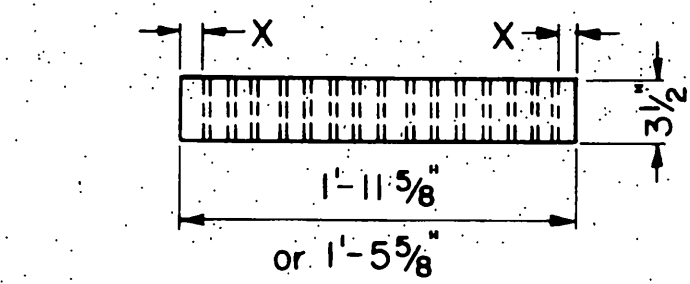

ALTERNATIVE WELDED GRATE

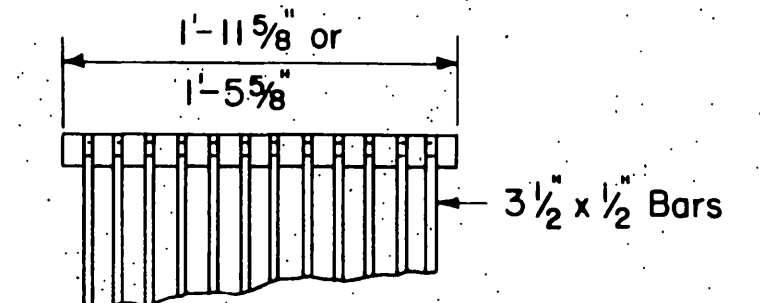


CAST END BLOCK

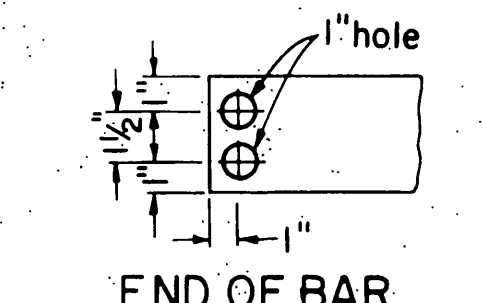


END OF BAR

Spacing same as for welded or bolted grate

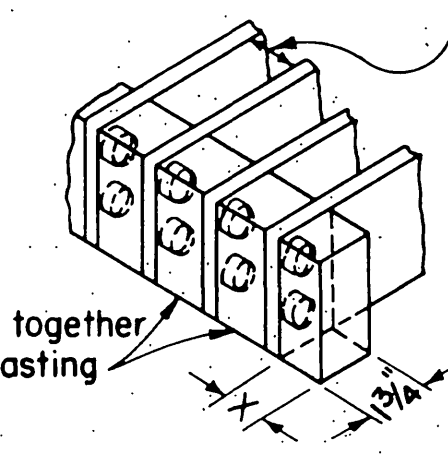


Both ends held together by solid casting

ALTERNATIVE CAST NODULAR IRON OR CAST STEEL END BLOCK GRATE

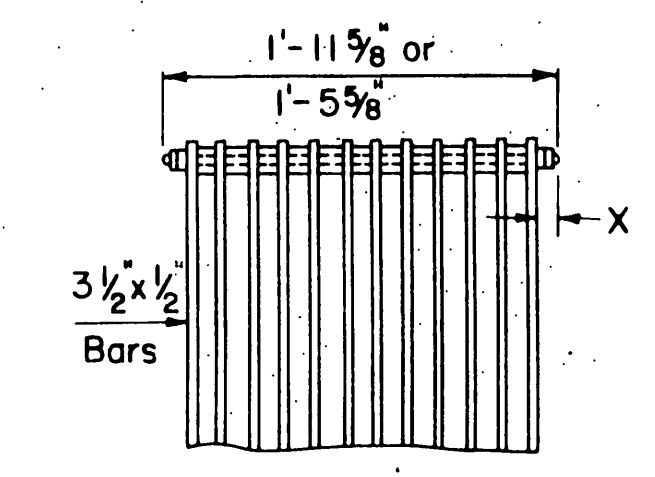

BOLTED END BLOCK

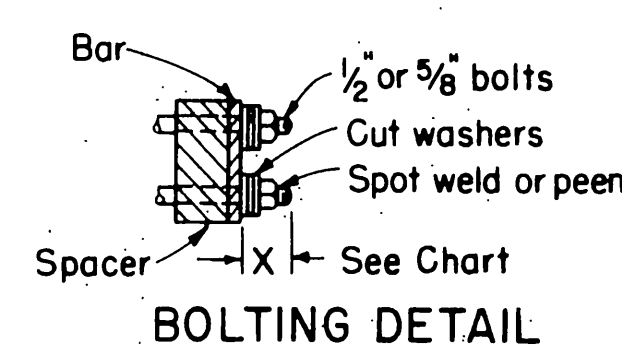

BAR SPACER



ALTERNATIVE SPACER

W = 1", 1 3/8" or 2"

BOLTING DETAIL ALTERNATIVE BOLTED GRATE

GRATE BAR SPACING TABLE

TYPE	NO. BARS	CLEAR BAR SPACING	X
18-9	9	1 3/8"	1 1/16"
24-9	9	2"	1 9/16"
24-12	12	1 3/8"	1 1/4"
24-15	15	1"	1 1/16"
36R	13	2"	2 1/8"

STATE OF CALIFORNIA
 DEPARTMENT OF PUBLIC WORKS
 DIVISION OF HIGHWAYS

SH. 22
 R-897


STANDARD GRATE DETAILS D77-3

J. J. ...
DATE APPROVED: 6-2-61

J. J. ...
State Highway Engineer
Civil Engineer License No. 9945

To accompany plans dated August 28, 1961

CLASSIFICATION	18 - 50K AXLE					50 - 75K AXLE					75 - 110K AXLE					110 - 150K AXLE						
	SPAN	TYPE	MIN. COVER	STRUTS REQ'D	STRUT SIZE & SPACING	SPAN	TYPE	MIN. COVER	STRUTS REQ'D	STRUT SIZE & SPACING	SPAN	TYPE	MIN. COVER	STRUTS REQ'D	STRUT SIZE & SPACING	SPAN	TYPE	MIN. COVER	STRUTS REQ'D	STRUT SIZE & SPACING		
BOX CULVERTS	A	2' to 5'	Single	4'	—	2' to 5'	Single	5'	—	—	2' to 4'	Single	3'	—	—	2' to 4'	Single	4'	—	—		
	A	6'	Single	5'	—	6'	Single	5'	1/2 Pt.	Posts 4x6@3' Sills 4x6, Cont.	5', 6'	Single	5'	1/3 Pts.	Posts 4x6@3' Sills 4x6, Cont.	5' to 6'	Single	5'	1/3 Pts.	Posts 4x6@3' Sills 4x6, Cont.		
	A	7', 8'	Single	5'	—	7', 8'	Single	5'	—	—	7', 8'	Single	5'	—	—	7', 8'	Single	5'	1/4 Pts.	Posts 4x6@3' Sills 4x6, Cont.		
	A	10', 12'	Single	5'	—	10', 12'	Single	5'	—	—	10', 12'	Single	5'	1/3 Pts.	Posts 6x6@3'-6" Sills 6x6, Cont.	10', 12'	Single	5'	1/3 Pts.	Posts 6x6@3' Sills 6x6, Cont.		
	A	14'	Single	3'	—	14'	Single	3'	1/3 Pts.	Posts 6x6@3'-6" Sills 6x8, Cont.	14'	Single	3'	1/3 Pts.	Posts 6x8@3'-6" Sills 6x8, Cont.	14'	Single	4'	1/3 Pts.	Posts 6x8@3'-6" Sills 6x8, Cont.		
	A	4' to 12'	Multiple	5'	—	4' to 12'	Multiple	5'	—	—	4' to 12'	Multiple	5'	—	—	4' to 12'	Multiple	5'	—	—		
	B, C, D, E	All	All	Span 1.75 5' Min.	—	—	All	All	Span 1.75 5' Min.	—	—	All	All	Span 1.75 5' Min.	—	—	All	All	Span 1.75 5' Min.	—	—	
R.C. PIPES	12" to 36"	Min. Cover = 2'					Min. Cover = 3'					Min. Cover = 4'					Min. Cover = 4'					
	48" to 108"	Dia. 1.75 or 4' Min.					Dia. 1.75 or 4' Min.					Dia. 1.75 or 4' Min.					Dia. 1.75 or 4' Min.					
METAL CULVERTS	Pipes	To 120"	Min. Cover = 2'					Min. Cover = 2'					Dia. 3 or 2' Min.					Dia. 3 or 3' Min.				
		Over 120"	Dia. 3 or 2' Min.					Dia. 3 or 2' Min.					Dia. 3 or 4' Min.					Dia. 3 or 4' Min.				
	Arches, Pipe, Arches	All Spans	Span 7 or 2' Min.					Span 7 or 2' Min.					Span 3 or 2' Min.					Span 3 or 3' Min.				
R.C. ARCH CULVERTS	Spans to 14'	Span 2.5 or 4' Min.					Span 2.5 or 4' Min.					Span 2.5 or 4' Min.					Span 2.5 or 4' Min.					
	Spans to 22'	Span 3.5 or 5' Min.					Span 3.5 or 5' Min.					Span 3.5 or 5' Min.					Span 3.5 or 5' Min.					

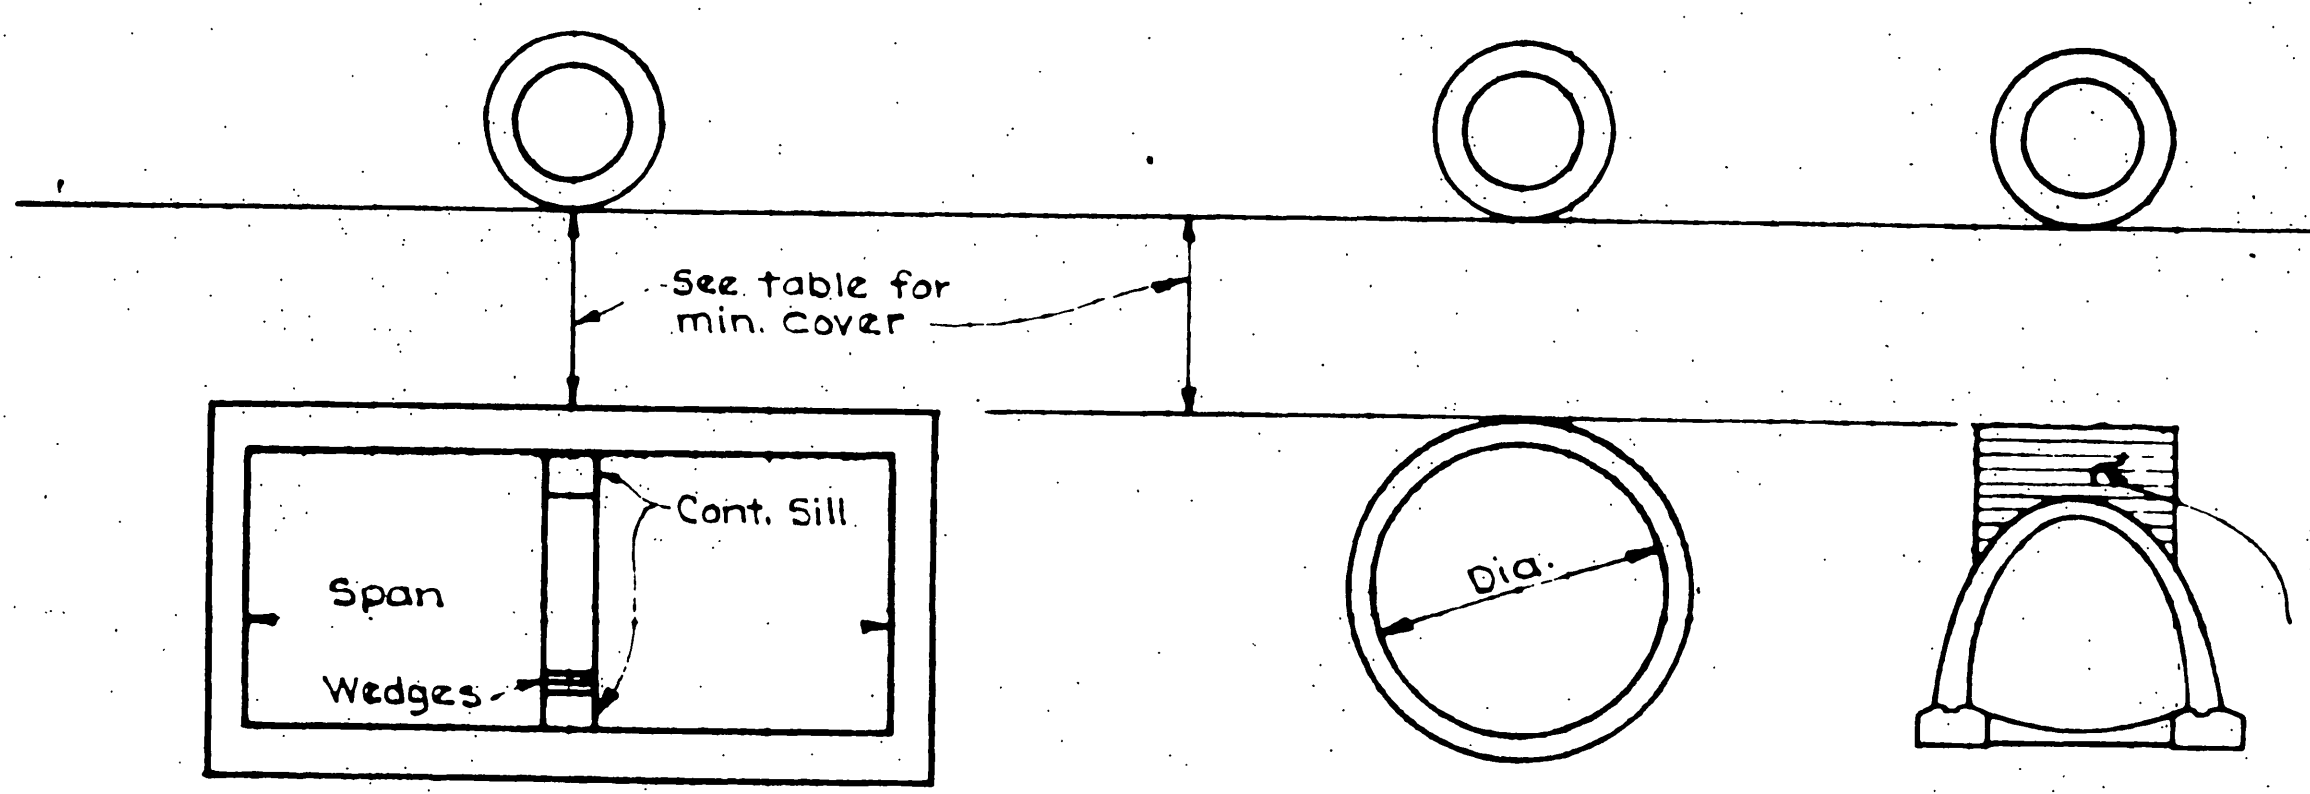

BOX CULVERTS


R.C. PIPES & METAL CULVERTS

R.C. ARCH CULVERTS

Notes: Limits of strutting to be determined by Engineer, but shall not be less than as shown in sketch at right. Reference - Std. Box Culverts dated Oct. 4, 1960. Assumed tire patterns:
 50K Axle 2.0' x 1.5'
 75K Axle 3.0' x 2.0'
 110K Axle 3.0' x 2.5'
 150K Axle 3.0' x 3.0'

Impact = 50%
 Timber sills & posts to be D.F., 1450f. Sills to be glued-laminated or solid timbers.

Strutting of metal culverts, if req'd by Special Provisions, to remain in place until construction loads are taken off.

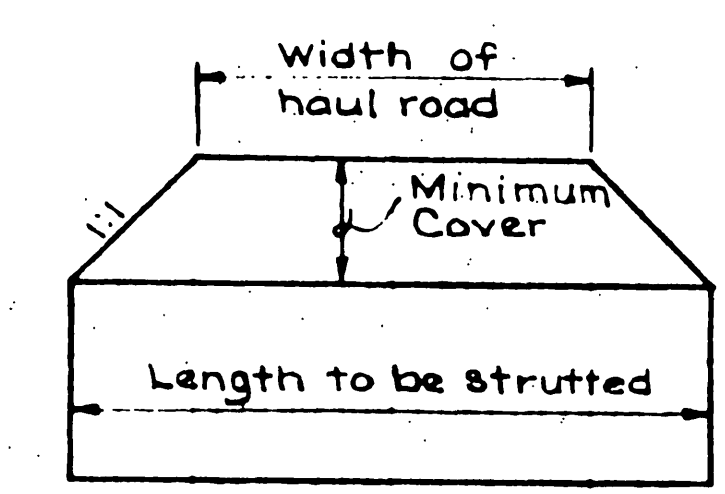

MINIMUM LENGTH OF STRUTTING

BRIDGE DEPARTMENT DESIGN SECTION	
Section Supervisor	
DESIGN	By
	Checked
DETAILS	By
	Checked
QUANTITIES	By
	Checked

STATE OF CALIFORNIA DEPARTMENT OF PUBLIC WORKS DIVISION OF HIGHWAYS			
SH. 23 R-897			
CONSTRUCTION LOADS ON CULVERTS			
SCALE	BRIDGE	FILE	DRAWING D88



To accompany Plans dated August 28, 1961

Note: Types B3, C3 D3 Superimposed on existing pavement

DISTRICT/COUNTY/ROUTE: VIII/RIV/700 SECTION: (3) SHEET: 24 TOTAL SHEETS: 25

Approval Recommended: *H. H. Warren*
 Engineer in Design
 Civil Engineer License No. 1603


Approved: *James*
 January 5, 1961
 State Highway Engineer
 Civil Engineer License No. 5945

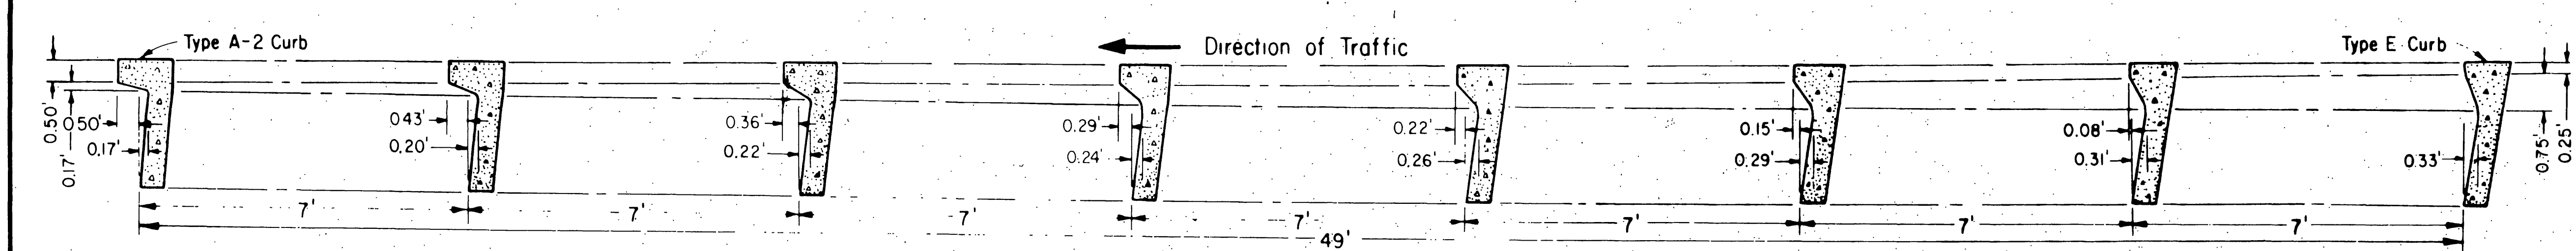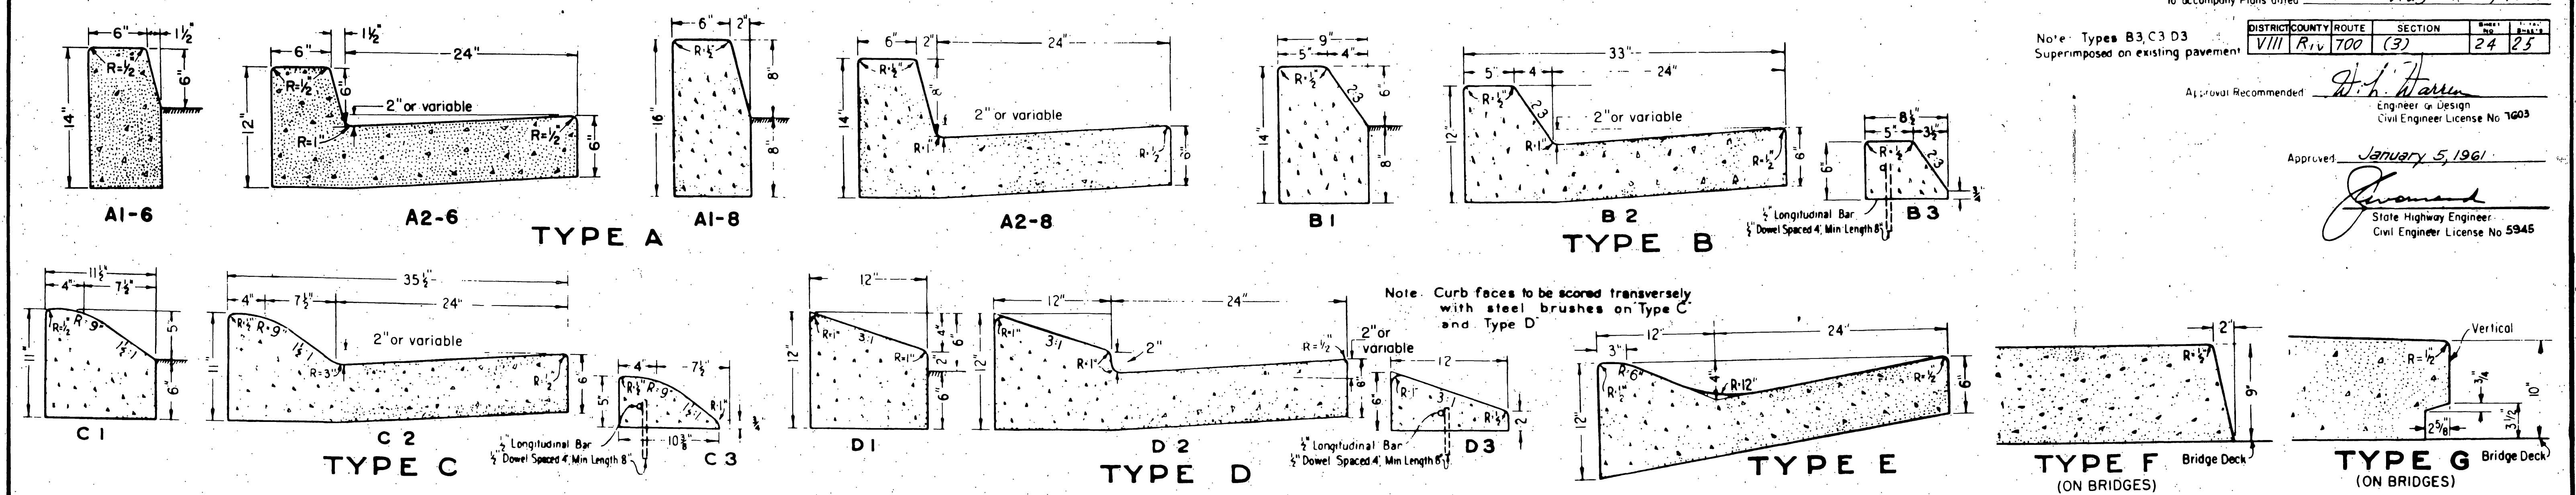


STANDARD CURB TRANSITION - TYPE E TO TYPE A-2

Note: Straight Line Transition in Flow Line and Top of Curb unless otherwise ordered by Engineer


CURB QUANTITIES			
Type	C.Y. Per Lin. Ft.	Type	C.Y. Per Lin. Ft.
A1-6	0.02585	C1	0.02752
A2-6	0.05903	C2	0.06457
A1-8	0.03084	C3	0.00965
A2-8	0.06379	D1	0.03073
B1	0.02930	D2	0.06782
B2	0.06171	D3	0.01223
B3	0.01074	E	0.06661

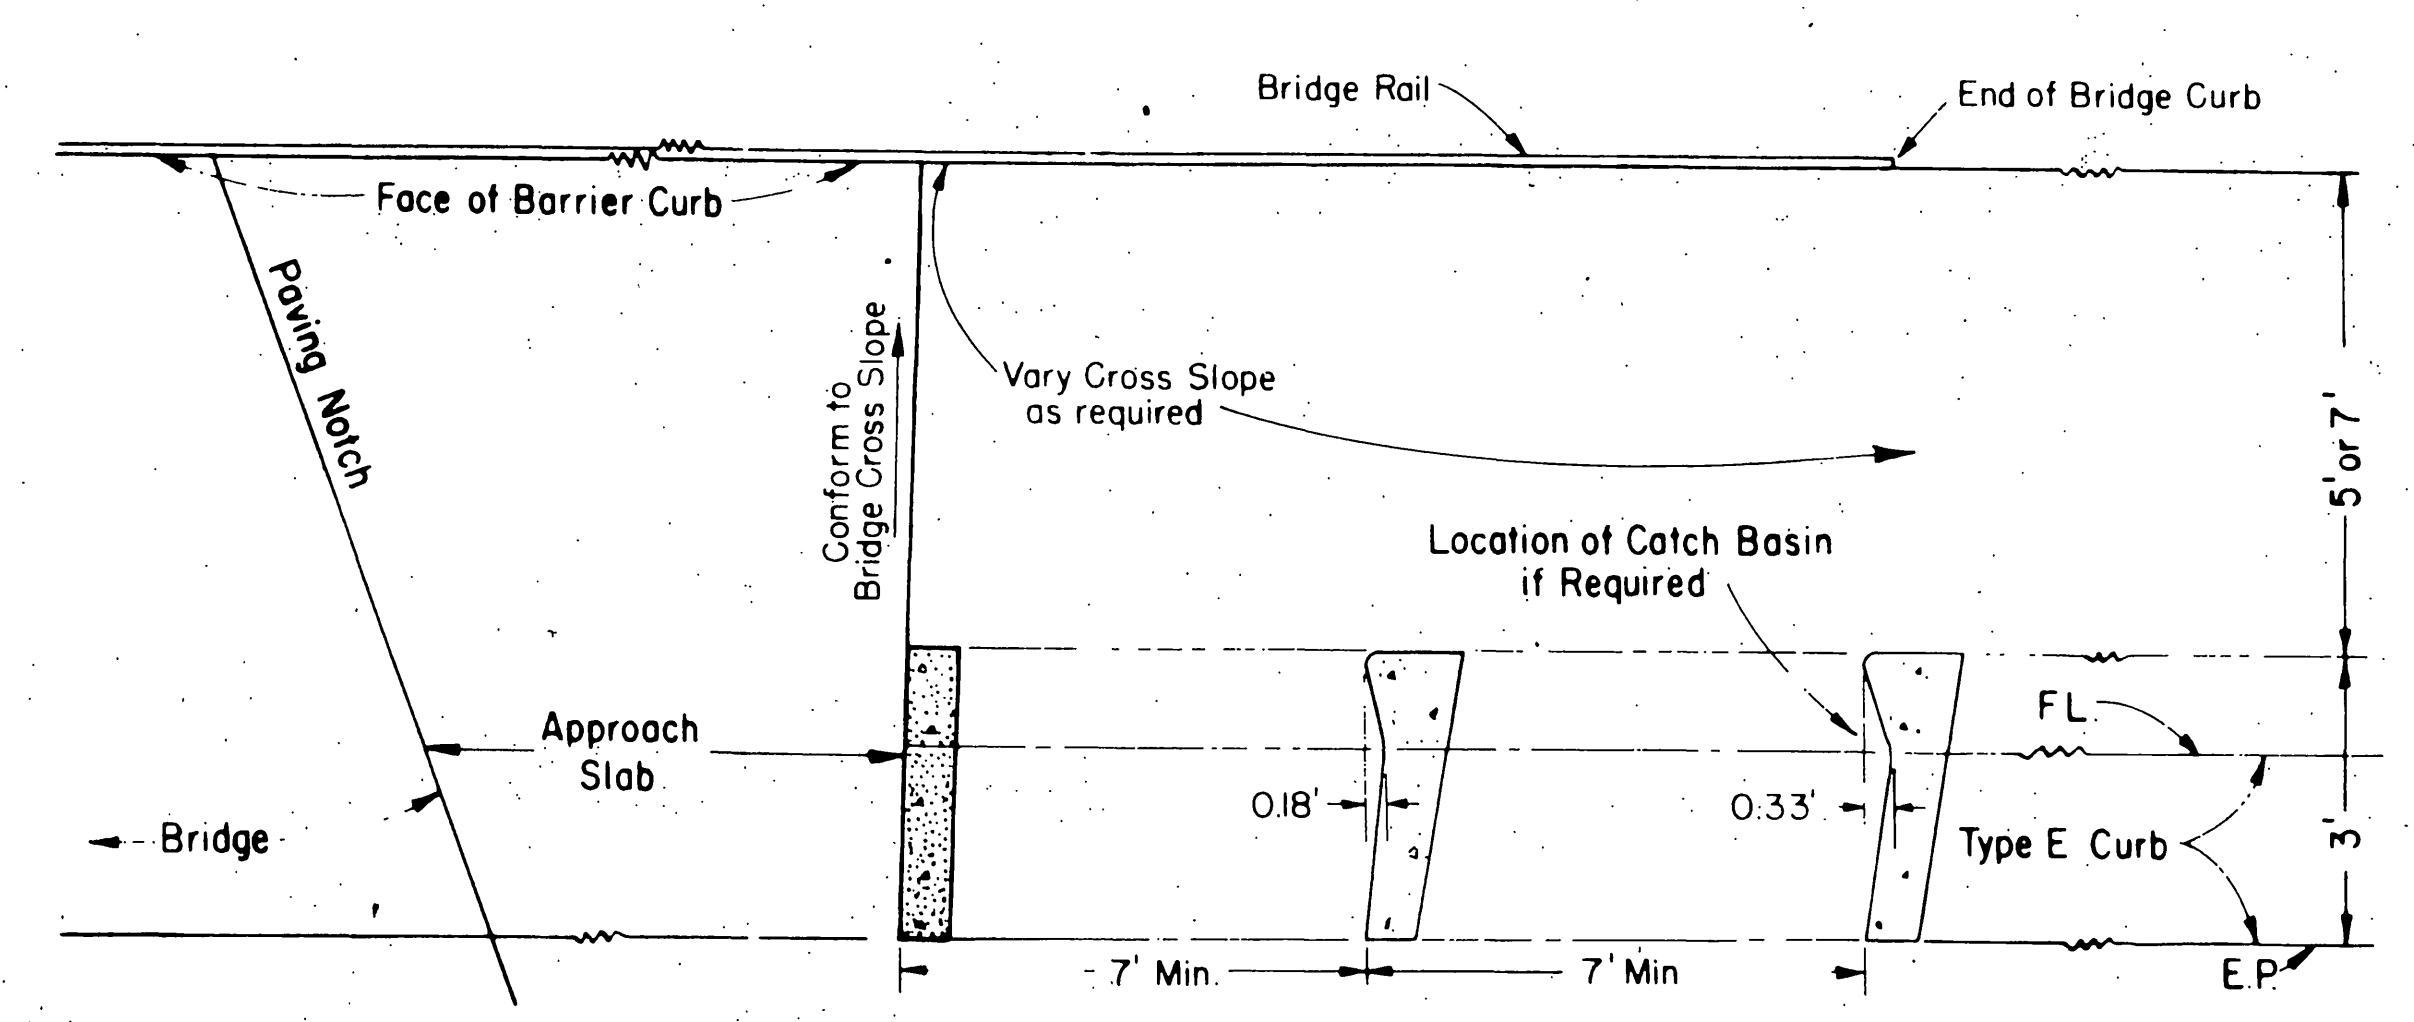


FLOW LINE TRANSITION - TYPE E AT STRUCTURE

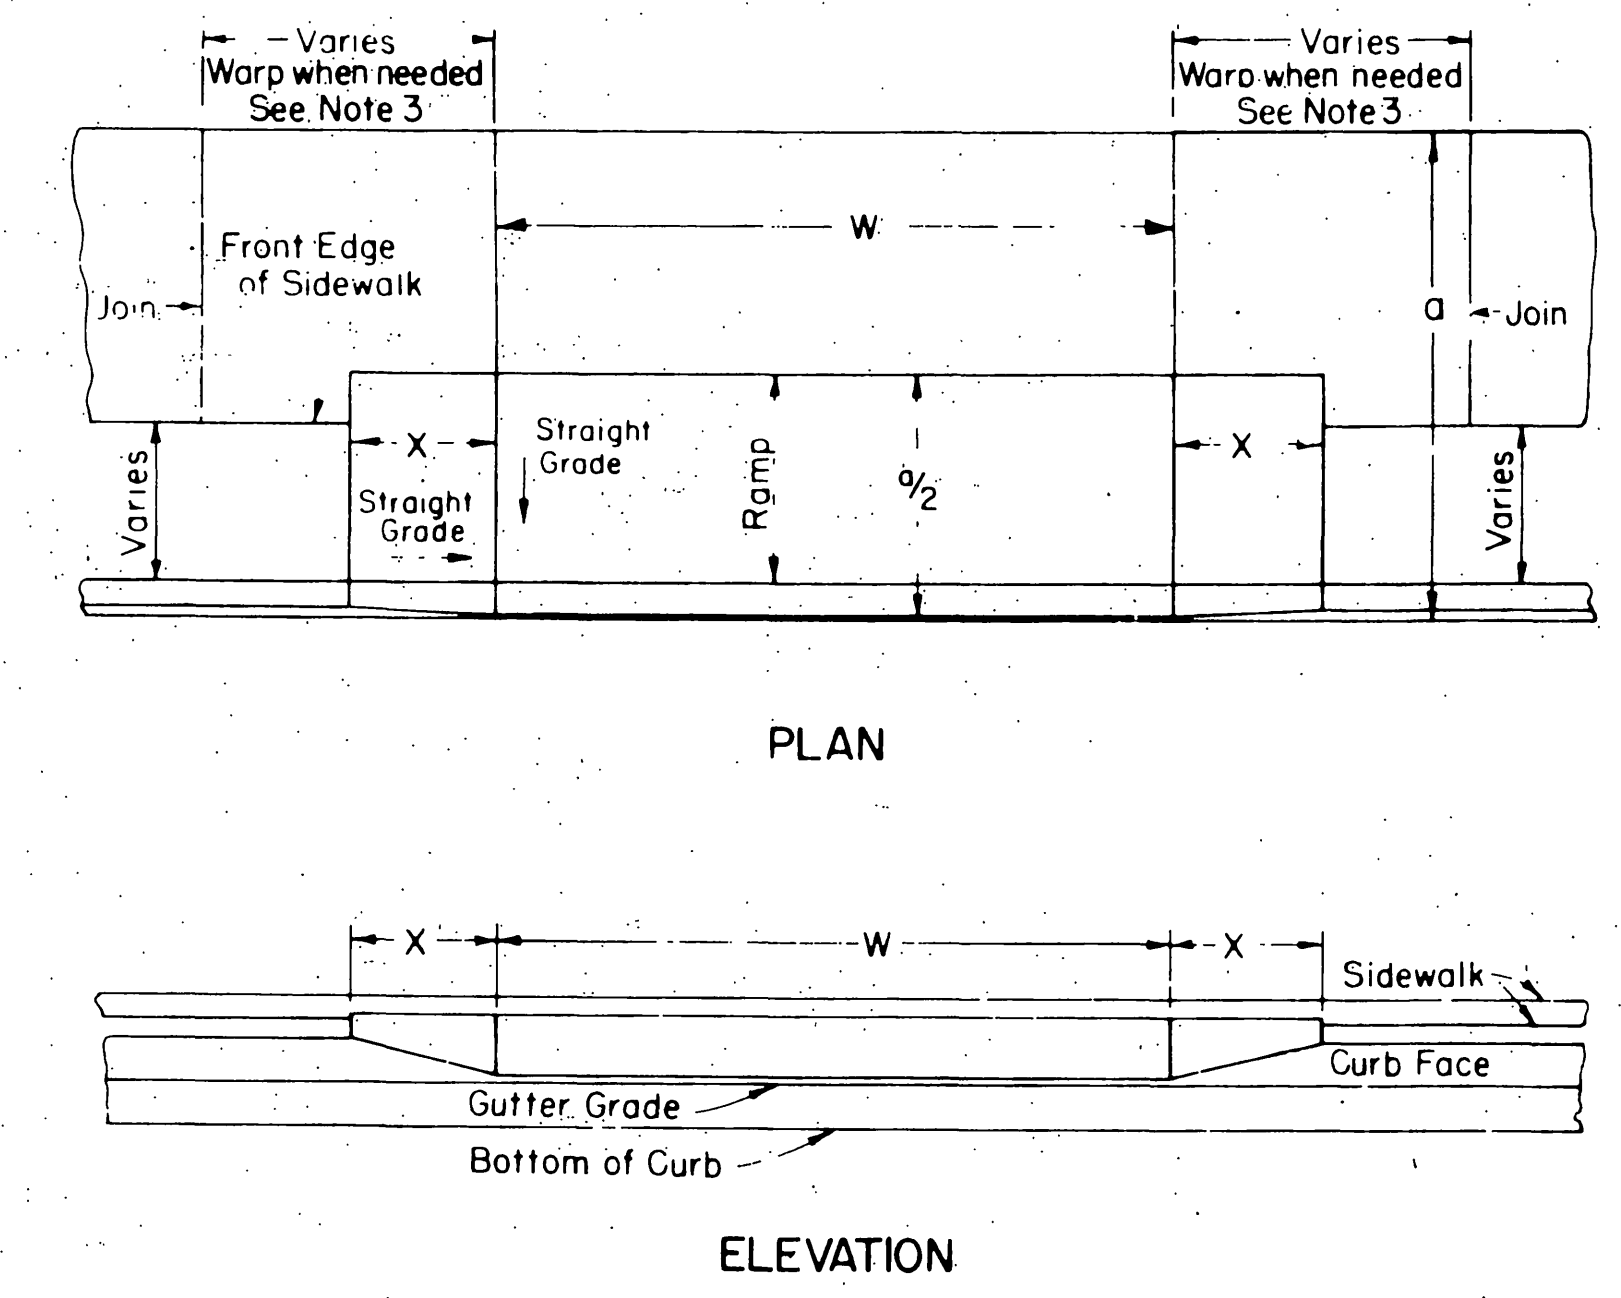


DRIVEWAYS

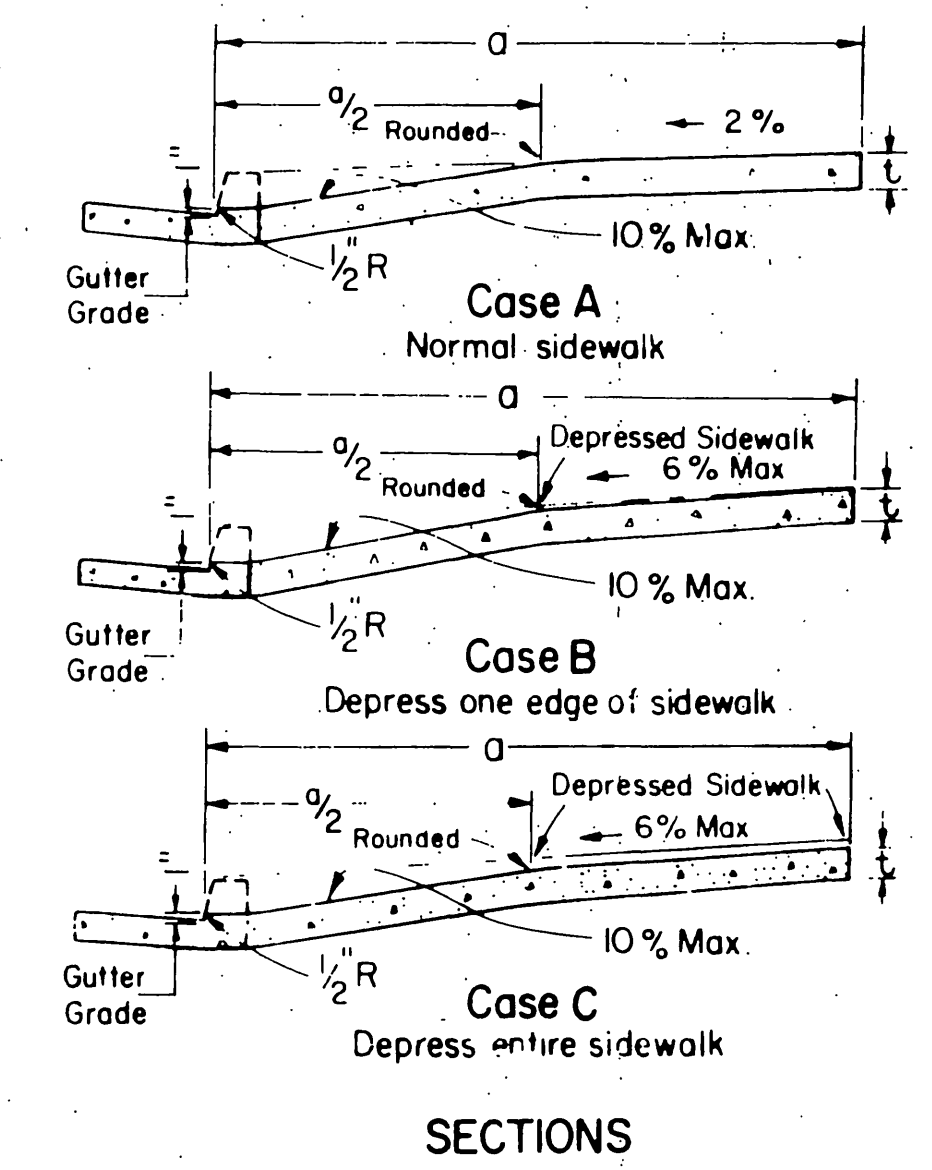

- NOTES:
- Case A normally applies
 - Use Case B when ramp slopes would exceed 10% in Case A.
 - Use Case C when sidewalk slope would exceed 6% in Case B. Longitudinal slope of warped area adjacent to driveway shall not vary more than 6% from the longitudinal grade line of the sidewalk
 - X = 3'-0" except for curb heights over 10" where 4:1 slopes shall be used on curb slope
 - Sidewalk and ramp thickness 't' at driveway shall be 4" for residential and 6" for commercial.
 - Difference in slope of the driveway ramp and the slope of a line between the gutter and a point on the roadway 5 feet from the gutter line shall not exceed 15%. Reduce driveway ramp slope, not gutter slope, where required.

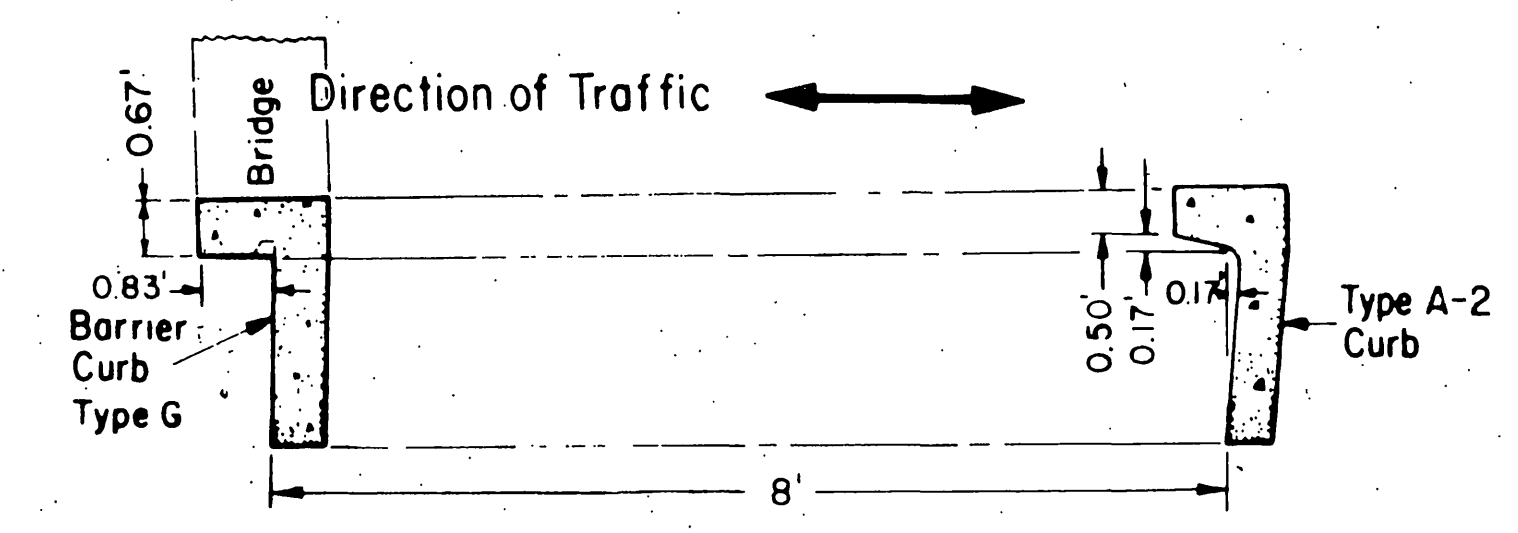

CURB TRANSITION - TYPE A-2 TO TYPE G

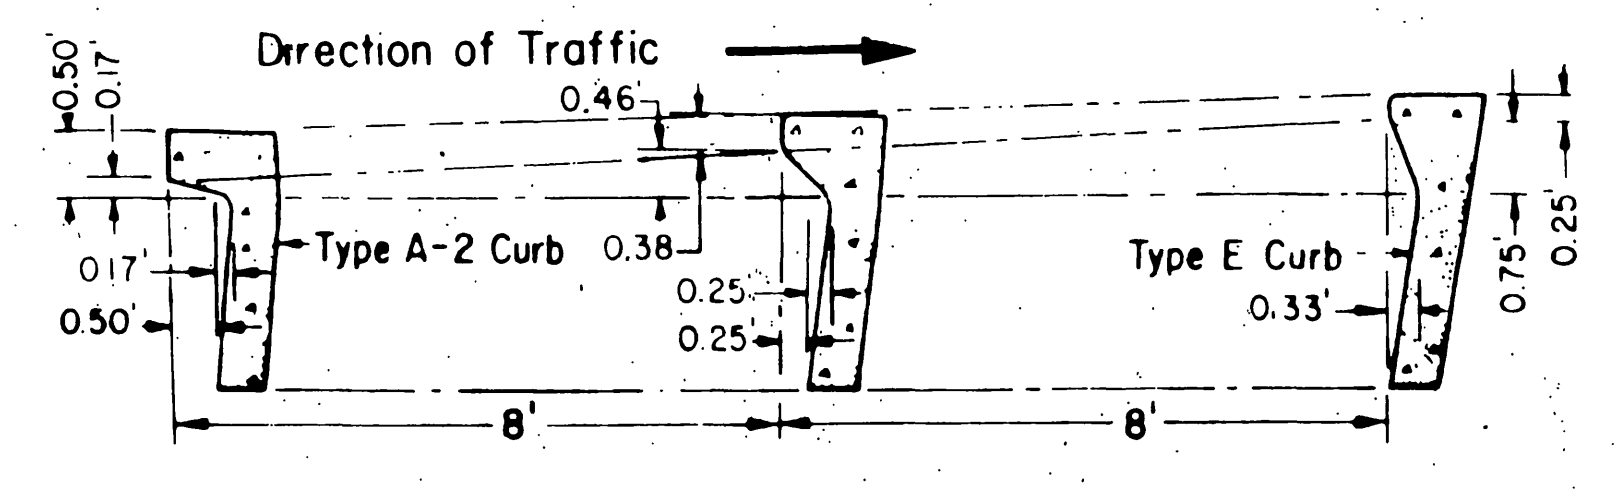


CURB TRANSITION - TYPE A-2 TO TYPE E


(See Note)


To accompany plans dated August 29, 1961





DISTRICT	COUNTY	ROUTE	SECTION	SHEET NO.	TOTAL SHEETS
VIII	Riv.	700	(3)	25	25

APPROVAL RECOMMENDED

 Traffic Engineer Civil Engineer License No. 5429

Approved October 31, 1960


 State Highway Engineer Civil Engineer License No. 5945

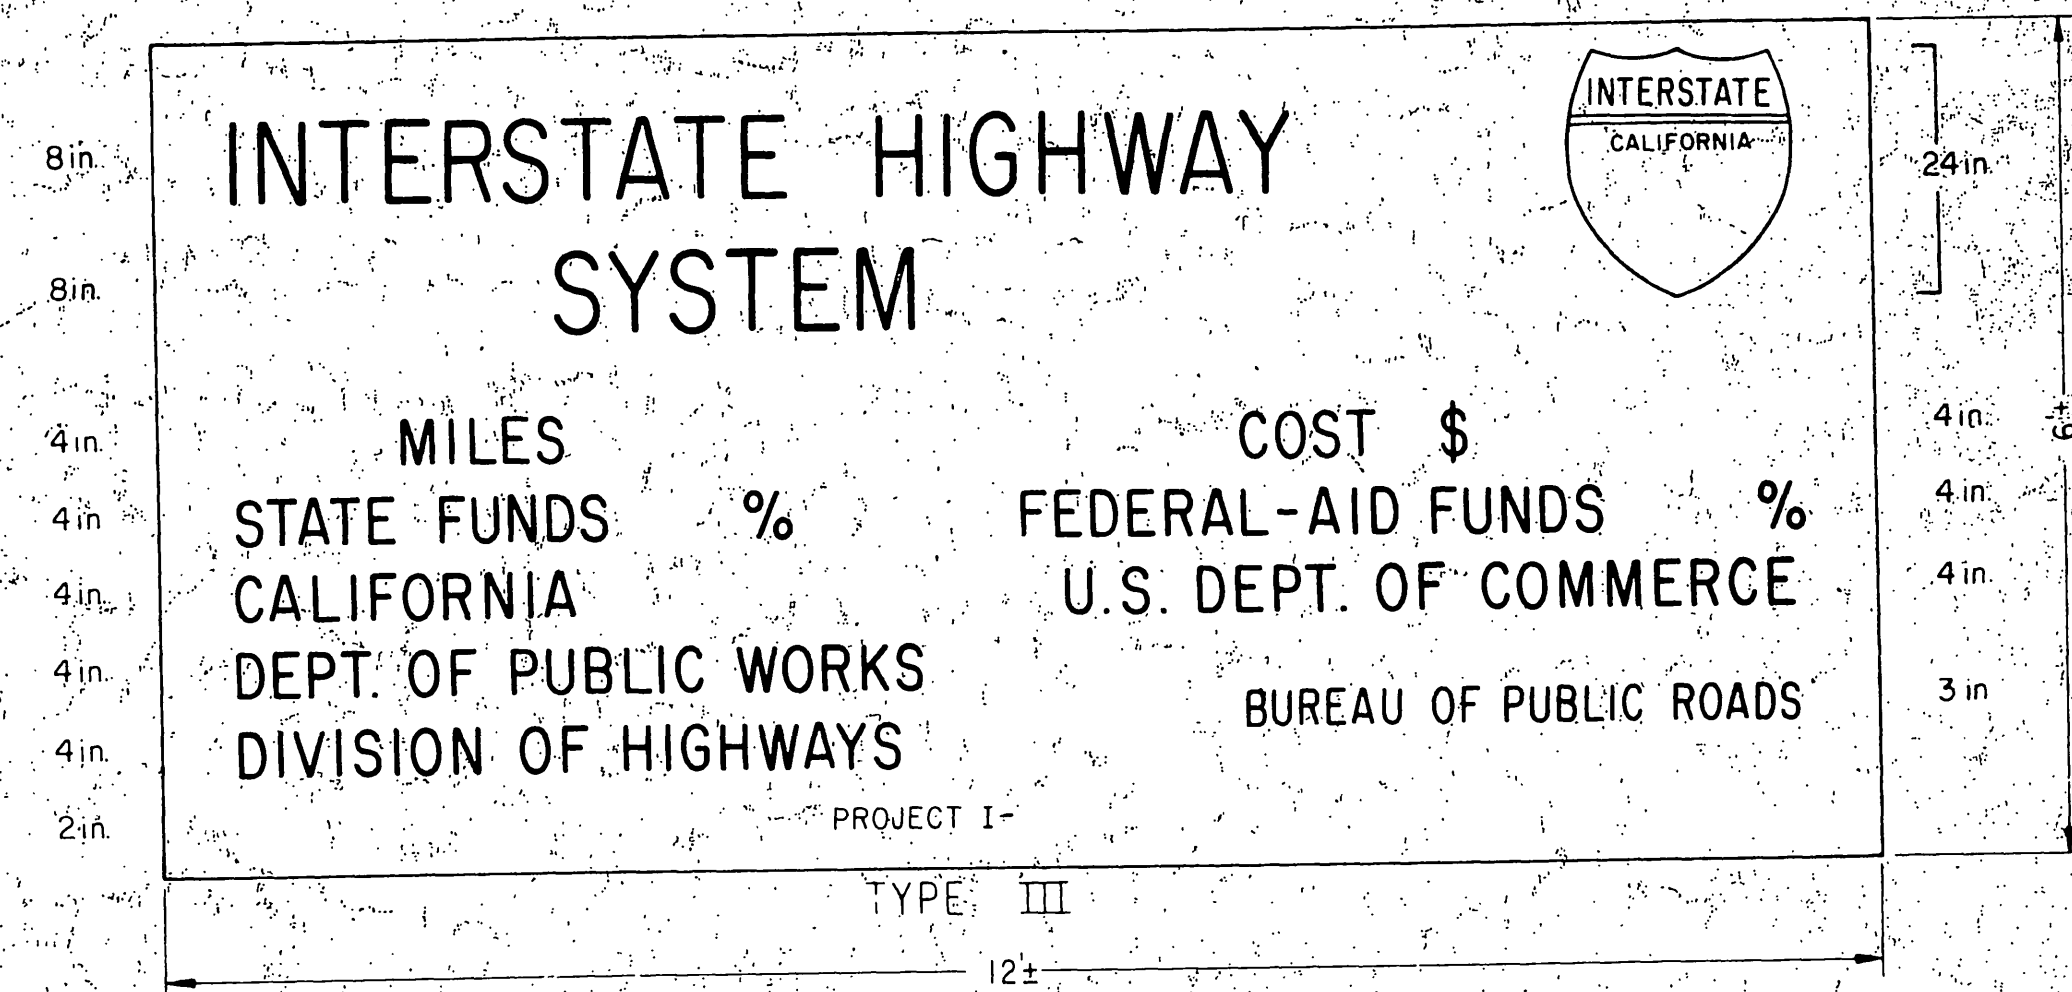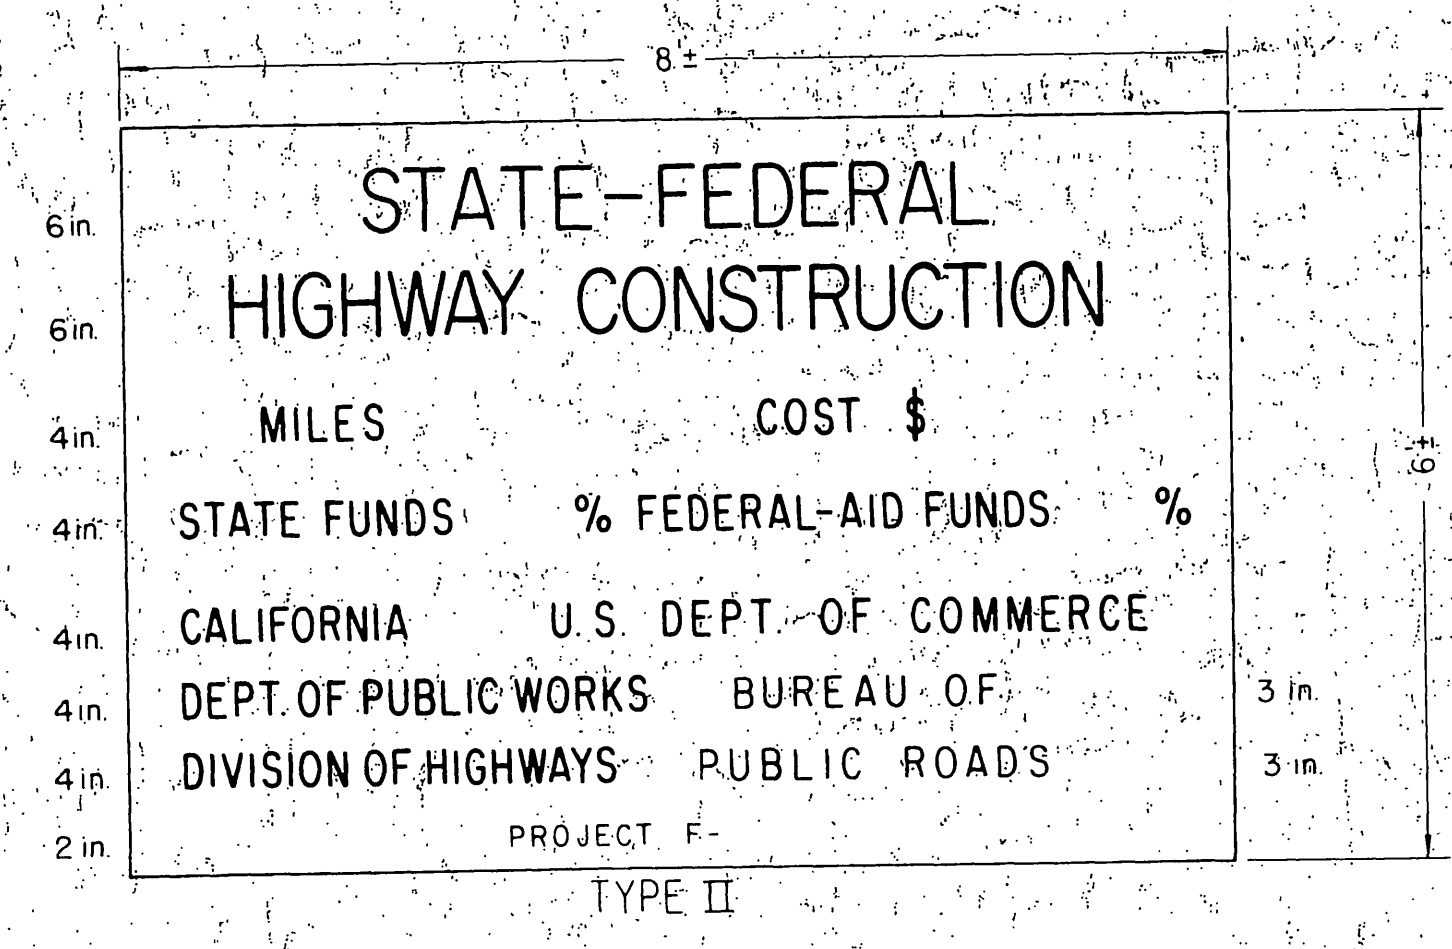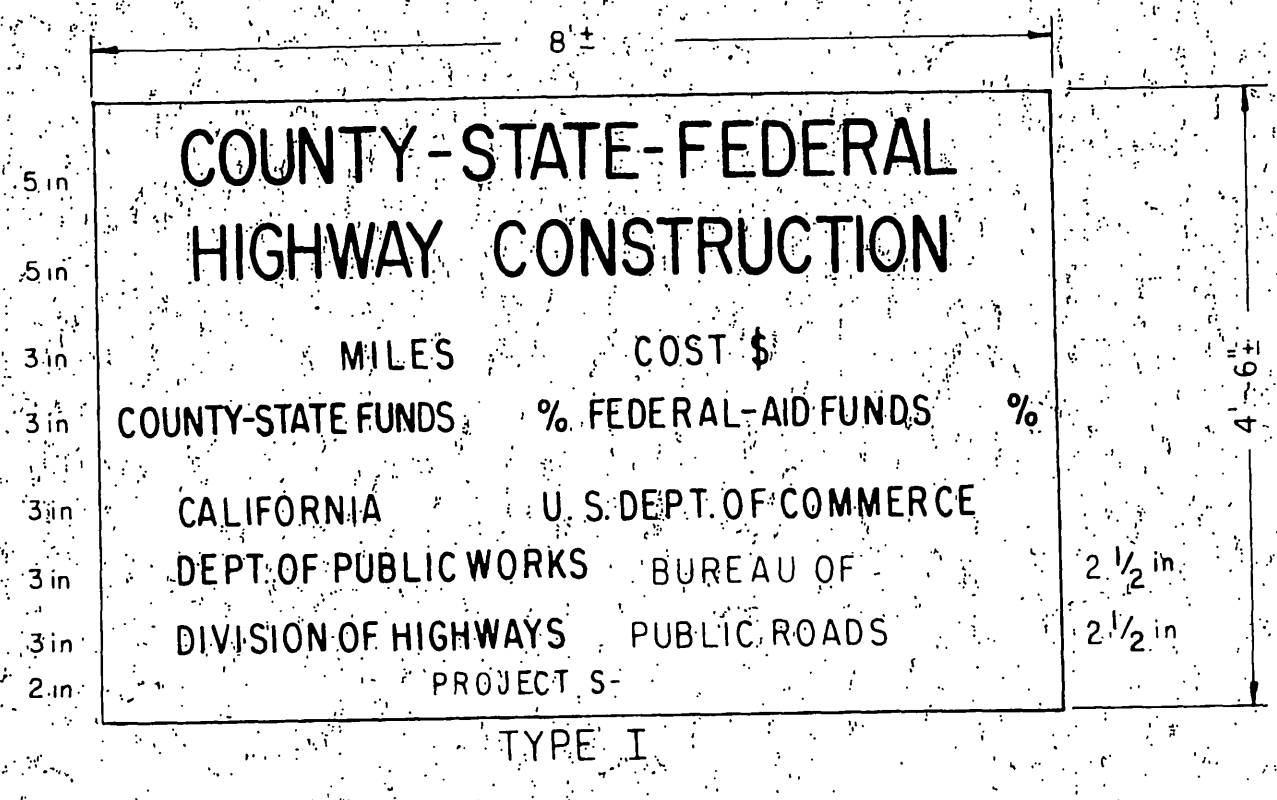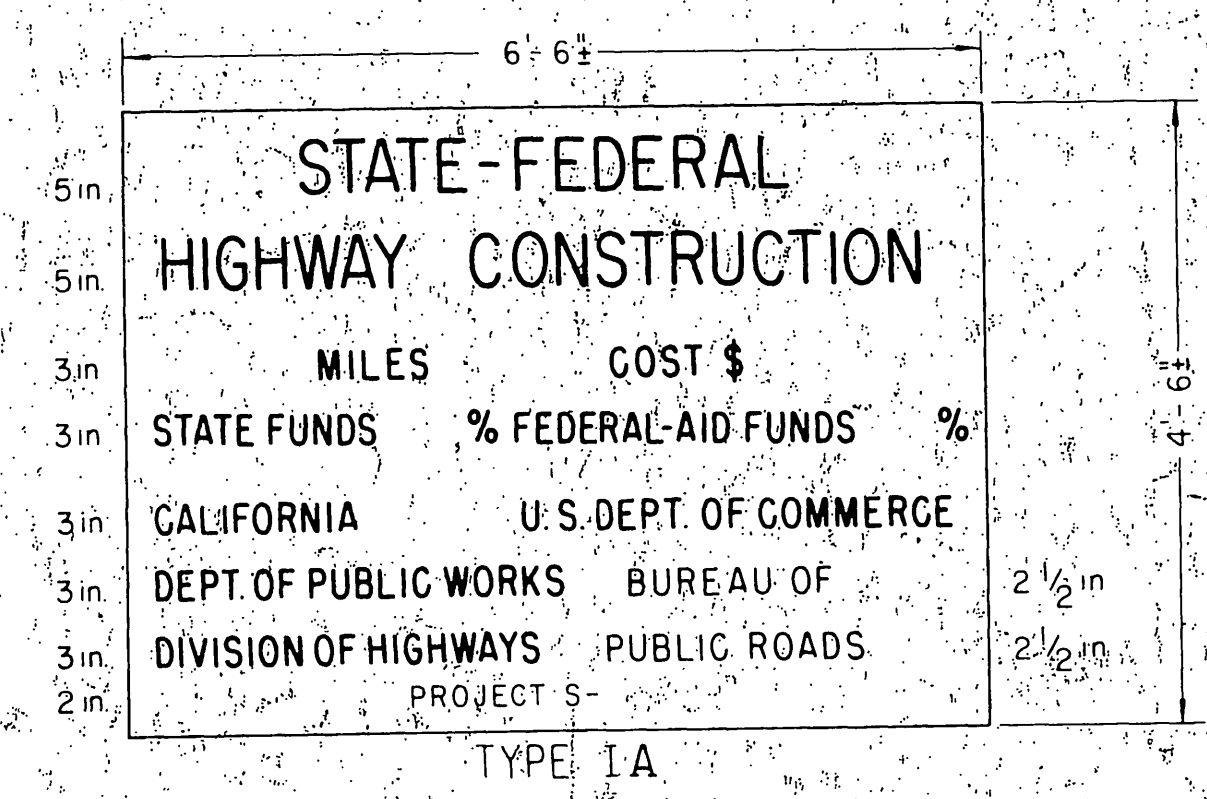AS BUILT

 NO CORRECTIONS THIS SHEET



Notes: Name of Structure may be shown in lieu of mileage.
 U.S. Standard capital "C" Letters.
 Stroke width 0.16" per inch of letter height.
 Miles, Cost, State Funds %, Federal-Aid Funds %, and
 Federal Aid Project Number to be furnished by the
 Engineer and pointed on the sign by the Contractor.